


TECH. REVISED 11/28/97
 FILE NO. 93327701
 DRAWING NO. 93327701-01
 PROJECT NO. 93-3277-01
 SCALE: 40,000/000

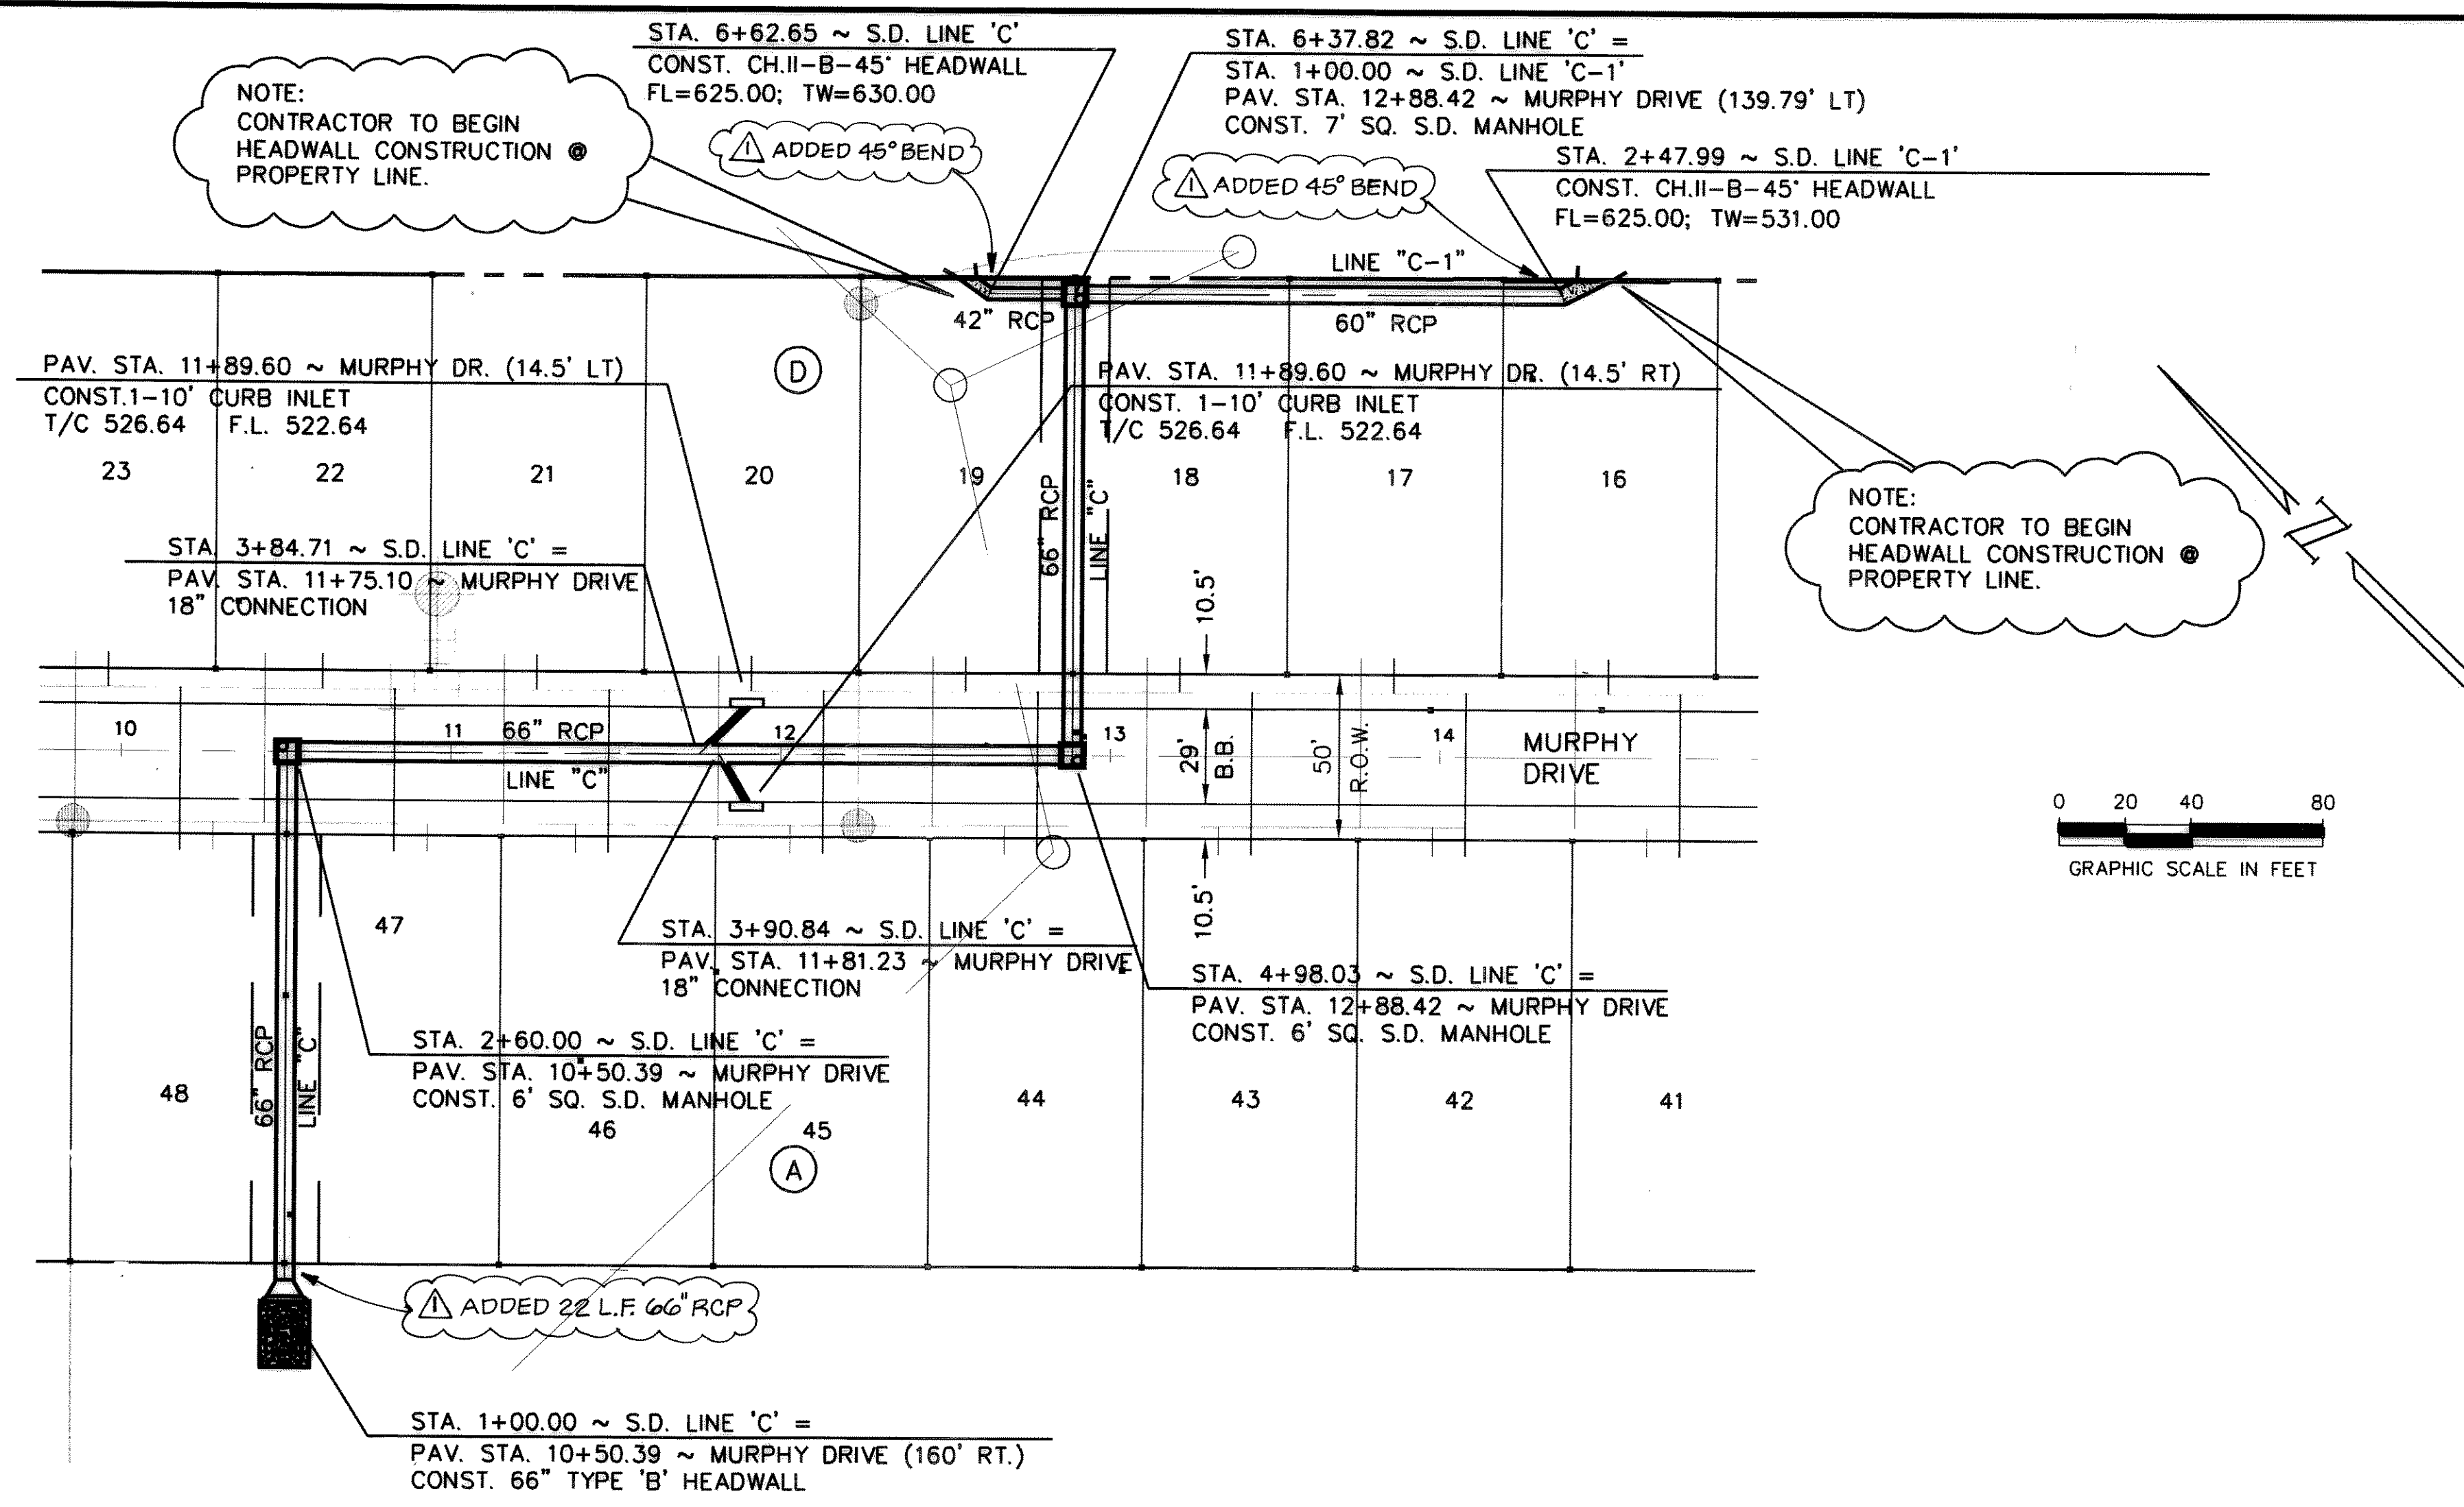

STORM DRAIN LINE 'C'

STORM DRAIN LINE 'C-1'

- BENCHMARKS:
- CARTER & BURGESS CAP ON NORTH SIDE OF YELLOW JACKET LANE 75' WEST OF FAR WEST ENTRANCE TO CANYON RIDGE APARTMENTS. ELEV.= 574.71
 - CUT IN NOSE OF MEDIAN ON YELLOW JACKET LANE 25' EAST OF SOUTHEAST PROPERTY CORNER OF PROJECT. ELEV.= 573.48
 - TOP OF CONCRETE R.O.W. MARKER AT FENCE CORNER IN THE SOUTHEAST QUADRANT AT THE INTERSECTION OF FM 276 AND HIGH SCHOOL DRIVE. ELEV.= 542.98

