



NOTE: ALL WATER LINES TO BE
C-300 PVC CLASS 200

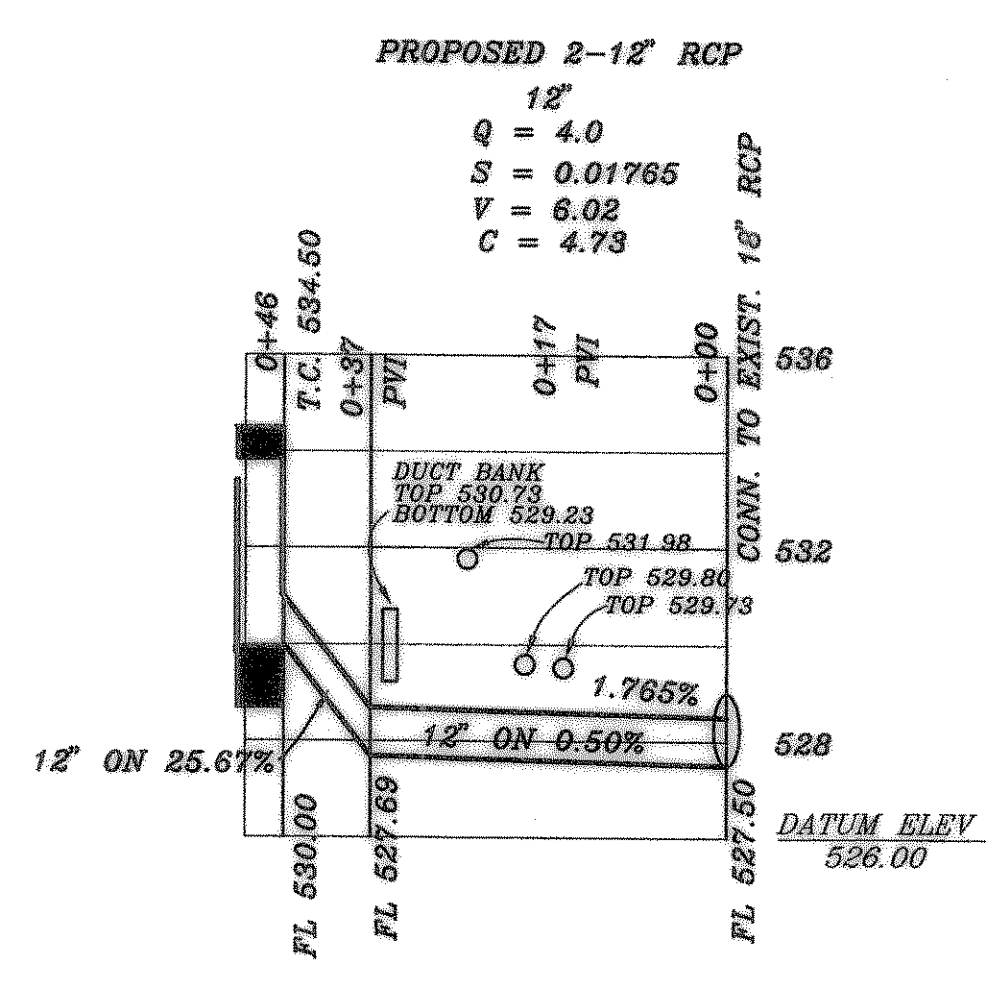

AS BUILT

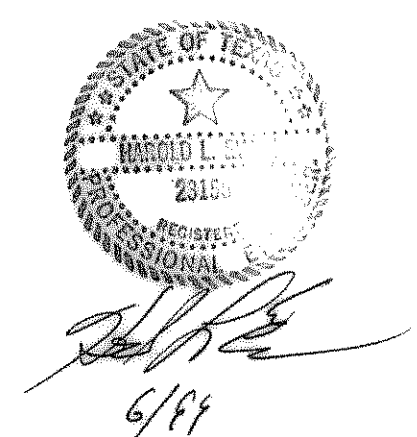

HAROLD L. EVANS CONSULTING ENGINEER P.O. BOX 28355 2331 GUS THOMASSON ROAD, SUITE 102 DALLAS, TEXAS 75228, (214) 328-8133		PROPOSED UTILITIES WHITE HILLS OFFICE CITY OF ROCKWALL		SHEET NO. JOB NO. 97100
REV. 6/7/99 REV. 5/11/99 REV. 5/10/99	DATE 9/24/99 SCALE 1" = 20' 1" = 4'	DESIGN H.L.E. DRAWN	REVISION DESCRIPTION	