


# CIVIL ENGINEERING CONSTRUCTION PLANS FOR

## THE WHITMORE MANUFACTURING COMPANY (INST. NO. 2008-00403192)

LOT1, BLOCK A

CITY OF ROCKWALL, TEXAS

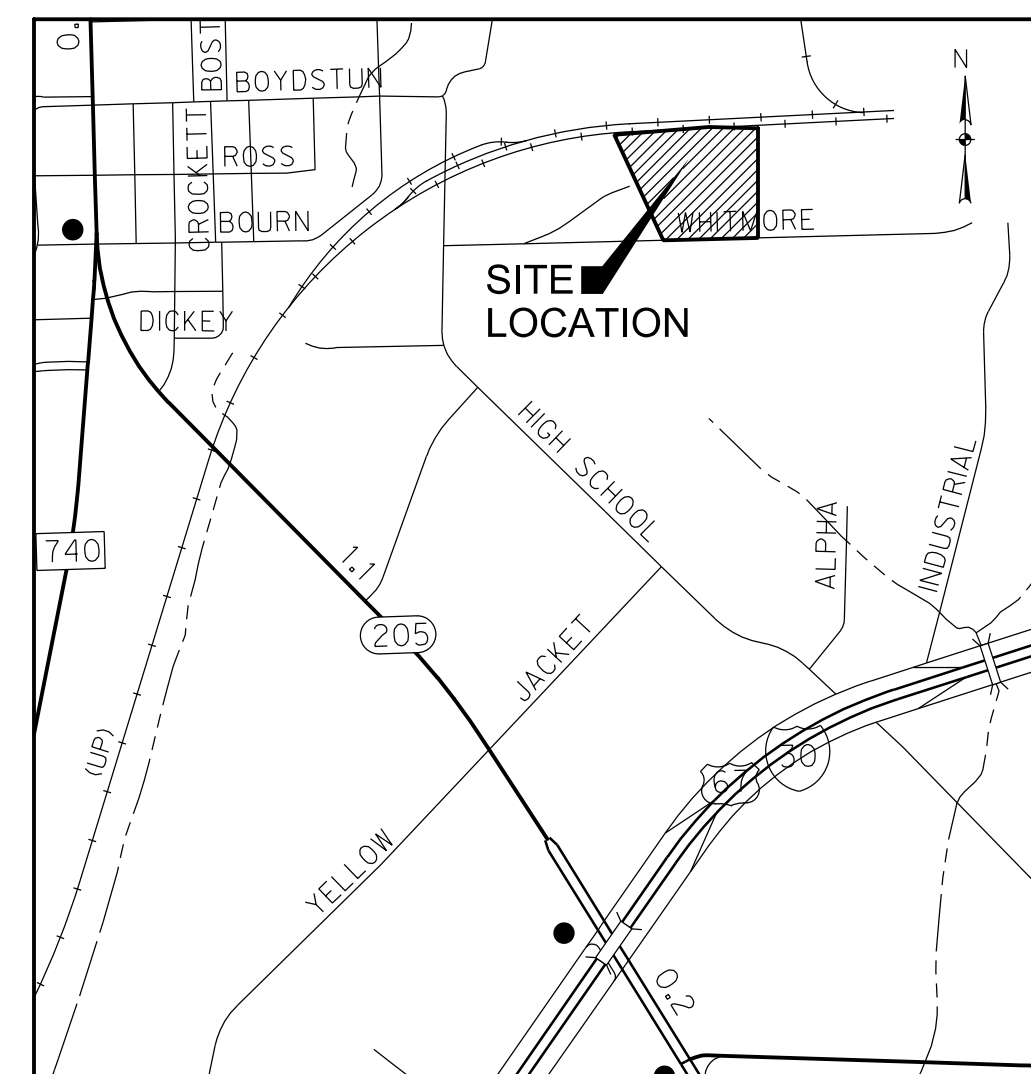

### SHEET INDEX

C0.00	COVER SHEET REPLAT
C0.01	GENERAL NOTES
C1.01	OVERALL SITE PLAN & DRAINAGE AREA MAP
C1.02	EROSION CONTROL PLAN
C1.03	EROSION CONTROL NOTES & DETAILS
C2.01	GRADING & PAVING PLAN
C3.01	STORM DRAINAGE IMPROVEMENT PLAN
C3.02	STORM DRAINAGE PROFILES
C3.03	STORM DRAINAGE CALCULATIONS
C3.04	DETAILS

### OWNER

WHITMORE MANUFACTURING COMPANY  
930 WHITMORE DRIVE  
ROCKWALL, TX. 75087  
CONTACT: DAVID BLANKENSHIP  
TEL: (469) 402-2753  
EMAIL: DBLANKENSHIP@WHITMORES.COM

### ENGINEER

HALFF ASSOCIATES, INC.  
1201 NORTH BOWSER ROAD  
RICHARDSON, TX. 75081  
CONTACT: B. DAVID LITTLETON, P.E.  
EMAIL: DLITTLETON@HALFF.COM  
TEL: (214) 346-6200  
FAX: (214) 739-0095  
TBPE FIRM# F-312



1201 NORTH BOWSER ROAD  
RICHARDSON, TEXAS 75081-2275  
TEL (214) 346-6200  
FAX (214) 739-0095  
TBPE FIRM# F-312

AVO 29023    APRIL, 2013

PROBABLE START OF PROJECT CONSTRUCTION    APRIL, 2013

### RECORD DRAWING SUBMITTAL

NOV. 04, 2013

This Record Drawing is based upon information provided by Hill & Wilkinson General Contractors, Halff Associates, Inc. survey dated 9-12-2013 and final visual observation. Texas Board of Professional Engineers-Firm #F-312.

B. DAVID LITTLETON    62128  
NAME    P.E. NO.  
DATE    NOV.04, 2013  
TBPE FIRM# F-312

ALL RESPONSIBILITY FOR ADEQUACY OF DESIGN REMAINS WITH THE DESIGN ENGINEER. THE CITY OF ROCKWALL, IN REVIEWING AND RELEASING PLANS FOR CONSTRUCTION, ASSUMES NO RESPONSIBILITY FOR ADEQUACY OR ACCURACY OF DESIGN.