


CITY OF ROCKWALL, TEXAS
 A NEW FACILITY FOR A
INWOOD NATIONAL BANK

LOT 4 CARLISLE PLAZA VOL. B PG. 136 RPRCT
 2830 RIDGE ROAD

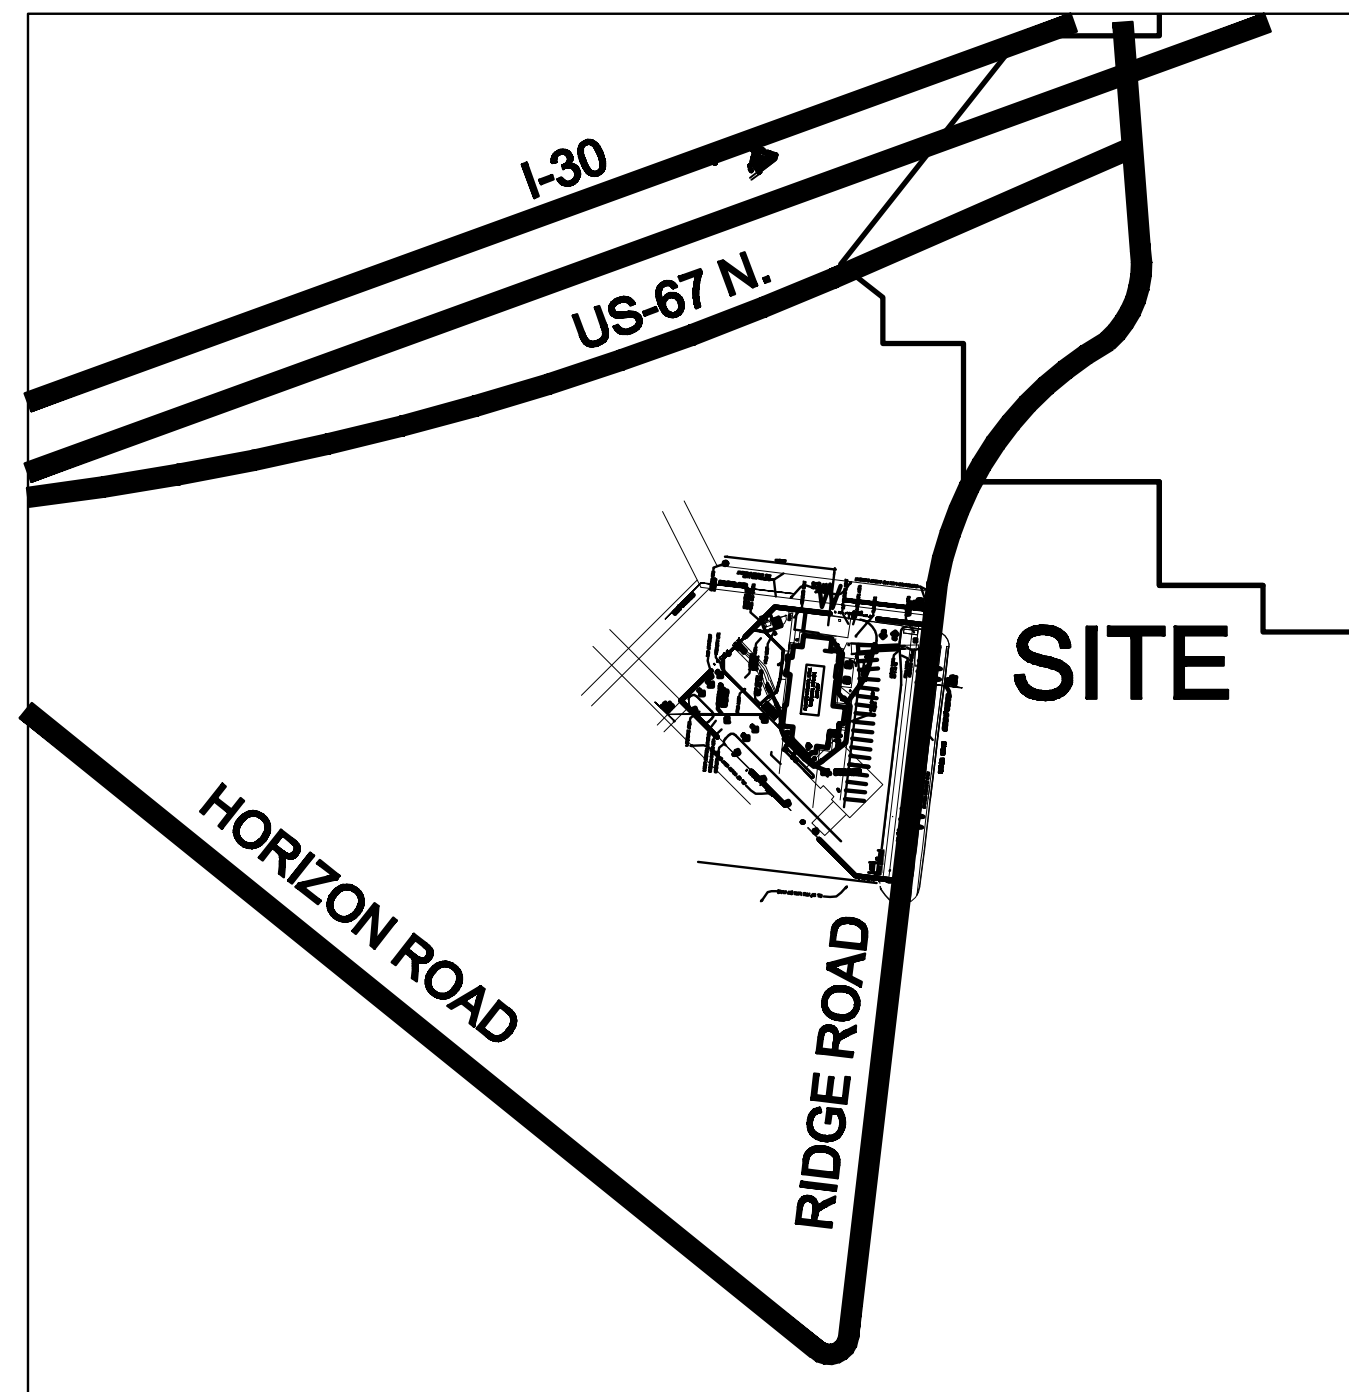

vicinity map

- DEMO
 FINAL PLAT
 DIMENSION CONTROL PLAN
 GRADING PLAN
 PAVING PLAN AND DETAILS
 UTILITY SERVICE PLAN
 DRAINAGE AREA MAP
 EROSION CONTROL PLAN AND DETAILS
 LANDSCAPE PLAN AND DETAILS

- CE-1
 CE-2
 CE-3
 CE-4
 DA-1
 EC-1
 LS-1

PRIOR TO ANY WORK
 LOCATE EX. SEWER STUB OUT AND
 DETERMINE EX. FLOW LINE. IF FLOW
 LINES AS SHOWN ON THE UTILITY
 PLAN (ELEV. 563.00) OR LOWER
 PROCEED WITH CONSTRUCTION, IF
 HIGHER NOTIFY THE ENGINEER.

RECORD DRAWINGS



NO.	DATE	REVISION	BY
		REFLECTS CITY COMMENTS THROUGH 12-11-12	MNP
RECORD DRAWINGS 12-19-13			
COVER SHEET			
INWOOD NATIONAL BANK			
CITY OF ROCKWALL, TEXAS			
MP MICHAEL PEEPLES Engineers and Planners Firm Number: F-3754		1930 E. Rosemeade Suite 205 Carrollton, Texas 75007 (214) 731-9948	
DATE PLOTTED: 12/23/2013 DRAWING NO.	DRAWN BY: MNP SCALE: AS SHOWN	COVER	