

**LEGEND**

- W — PROPOSED WATER LINE
- SS — PROPOSED SS LINE
- G — PROPOSED GATE VALVE
- FH — PROPOSED FIRE HYDRANT
- - - - - EXISTING WATER LINE
- - - - - EXISTING SS LINE
- - - - - EXISTING GATE VALVE
- M — EXISTING MANHOLE
- FH — EXISTING FIRE HYDRANT
- X XXX.XX EXISTING SPOT ELEVATION
- PROPOSED 0.1' CONTOURS
- 579 PROPOSED 1' CONTOUR
- 579 EXISTING 1' CONTOUR

**PROPOSED SPOT ELEVATIONS**

- X XXX.X TP TOP OF PAVEMENT
- X XXX.X TC TOP OF CURB
- X XXX.X TL TOP OF LANDING
- X XXX.X BL BOTTOM OF LANDING
- X XXX.X HC HANDICAP RAMP SPOT SHOTS


**AS-BUILT SPOT ELEVATIONS**

- X XXX.X

**NOTE:**  
SIGNIFICANT VERTICAL DIFFERENCES IN THE DESIGN PLANS WERE INDICATED IN THE FIELD DURING CONSTRUCTION. THE RECORD DRAWINGS WILL NOT HAVE CONTOURS TO REFLECT AS CONSTRUCTED CONDITIONS. ELEVATIONS SHOWN HERE ON REFLECT ELEVATIONS AT THE COMPLETION OF CONSTRUCTION OF THE POINTS INDICATED.


**CAUTION !!!**  
**UNDERGROUND UTILITIES**

EXISTING UTILITIES AND UNDERGROUND FACILITIES INDICATED ON THESE PLANS HAVE BEEN LOCATED FROM REFERENCE INFORMATION SUPPLIED BY VARIOUS OWNERS OF THE FACILITIES. THE ENGINEER DOES NOT ACCEPT THE RESPONSIBILITY FOR THE UTILITY LOCATIONS SHOWN. IT SHALL BE THE RESPONSIBILITY OF THE CONTRACTOR TO VERIFY BOTH HORIZONTALLY AND VERTICALLY THE LOCATION OF ALL EXISTING UTILITIES AND UNDERGROUND FACILITIES PRIOR TO CONSTRUCTION, TO TAKE NECESSARY PRECAUTIONS IN ORDER TO PROTECT ALL FACILITIES ENCOUNTERED, AND TO NOTIFY THE ENGINEER PROMPTLY OF ALL CONFLICTS OF THE WORK WITH EXISTING FACILITIES. THE CONTRACTOR SHALL PRESERVE AND PROTECT ALL EXISTING UTILITIES FROM DAMAGE DURING CONSTRUCTION. ANY DAMAGE BY THE CONTRACTOR TO EXISTING UTILITIES SHALL BE REPAIRED BY THE CONTRACTOR AT HIS EXPENSE.

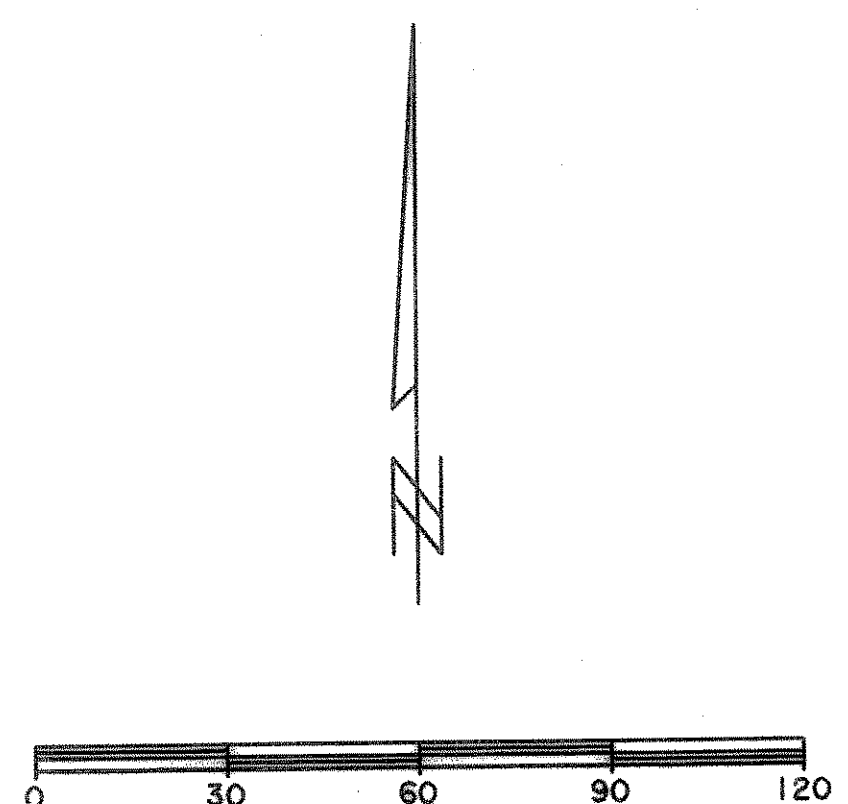

**RECORD DRAWING**  
**03/13/07**

PREPARED BY:  
**WIA WIER & ASSOCIATES, INC.**  
ENGINEERS SURVEYORS LAND PLANNERS  
4300 BELLEVUE PLACE SUITE 130 ARLINGTON, TEXAS 76018 METRO (817)467-7700  
1380 U.S. HIGHWAY 287 N. SUITE 101 WANSFORD, TEXAS 76063 METRO (817)477-6000  
6849 ELM STREET FRISSO, TEXAS 75034 METRO (214)387-8000  
www.wiaassociates.com

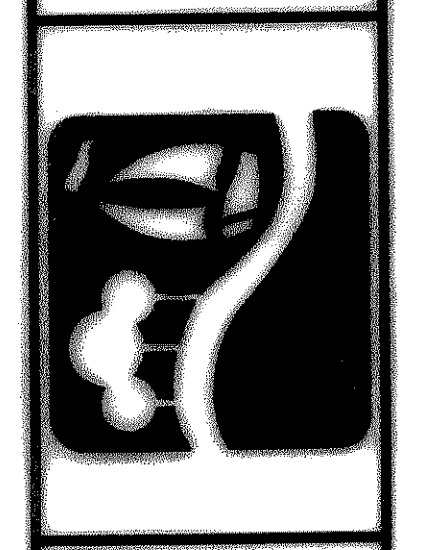

**CITY OF ROCKWALL**  
**WHITMORE'S EXPANSION**

**GRADING PLAN**

STATE OF TEXAS  
RONALD RAMIREZ  
REGISTERED PROFESSIONAL ENGINEER  
81821

Copyright © Wier & Associates, Inc.  
LAST SHEET EDIT  
DATE 8-08-05  
WAW 04124.02  
**SHEET NO. 0001**

FILE: Grading\_overall plan.dwg  
TIME: 14.02