


BUTTON DETAIL FOR CENTER OF STREET PAVEMENT


SCALE: NTS

NOTES: 0.50 1. DENOTES DISTANCE IN DECIMAL FEET ABOVE PROFILE GRADE LT. & RT.

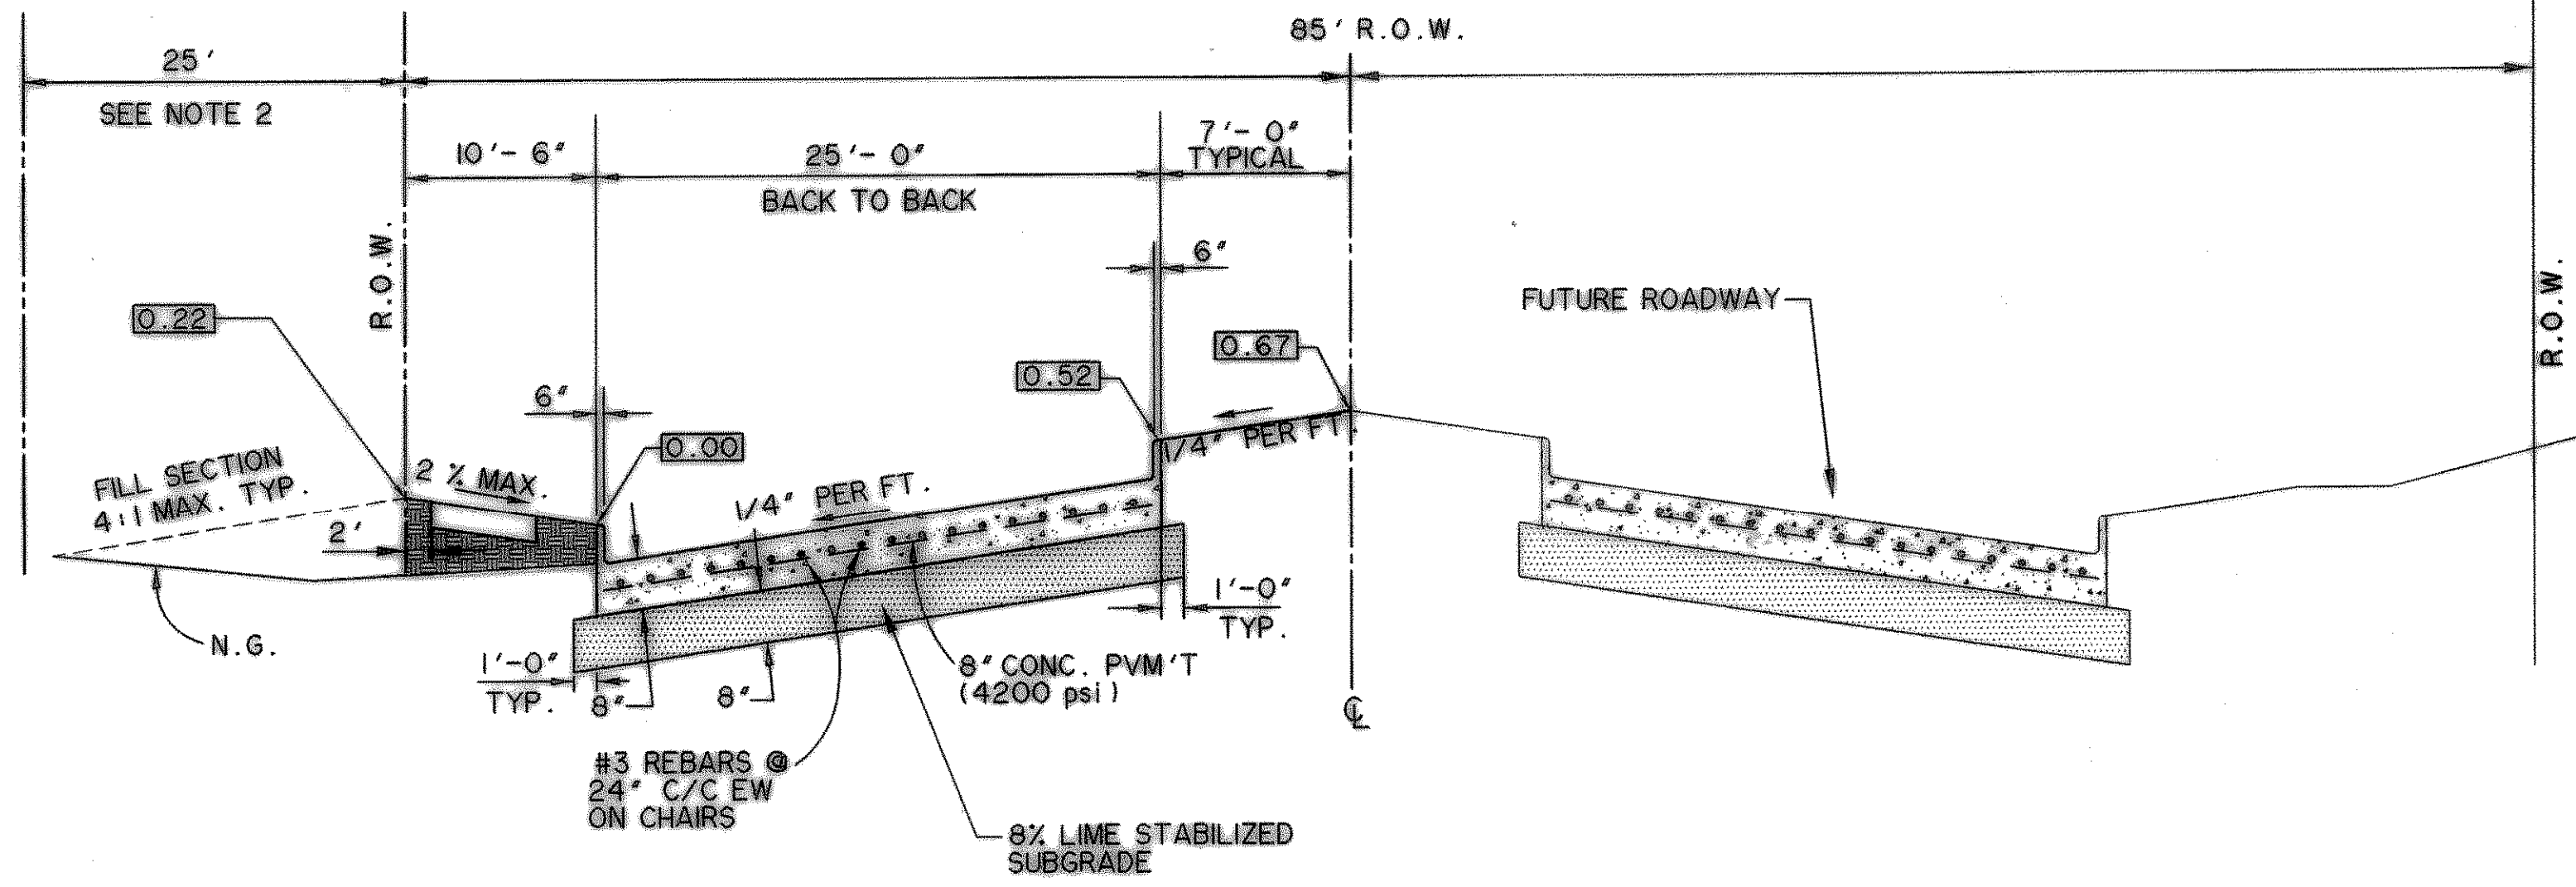

WHITMORE DRIVE DIVIDED SECTION

MAJOR DIVIDED COLLECTOR
SCALE: NTS

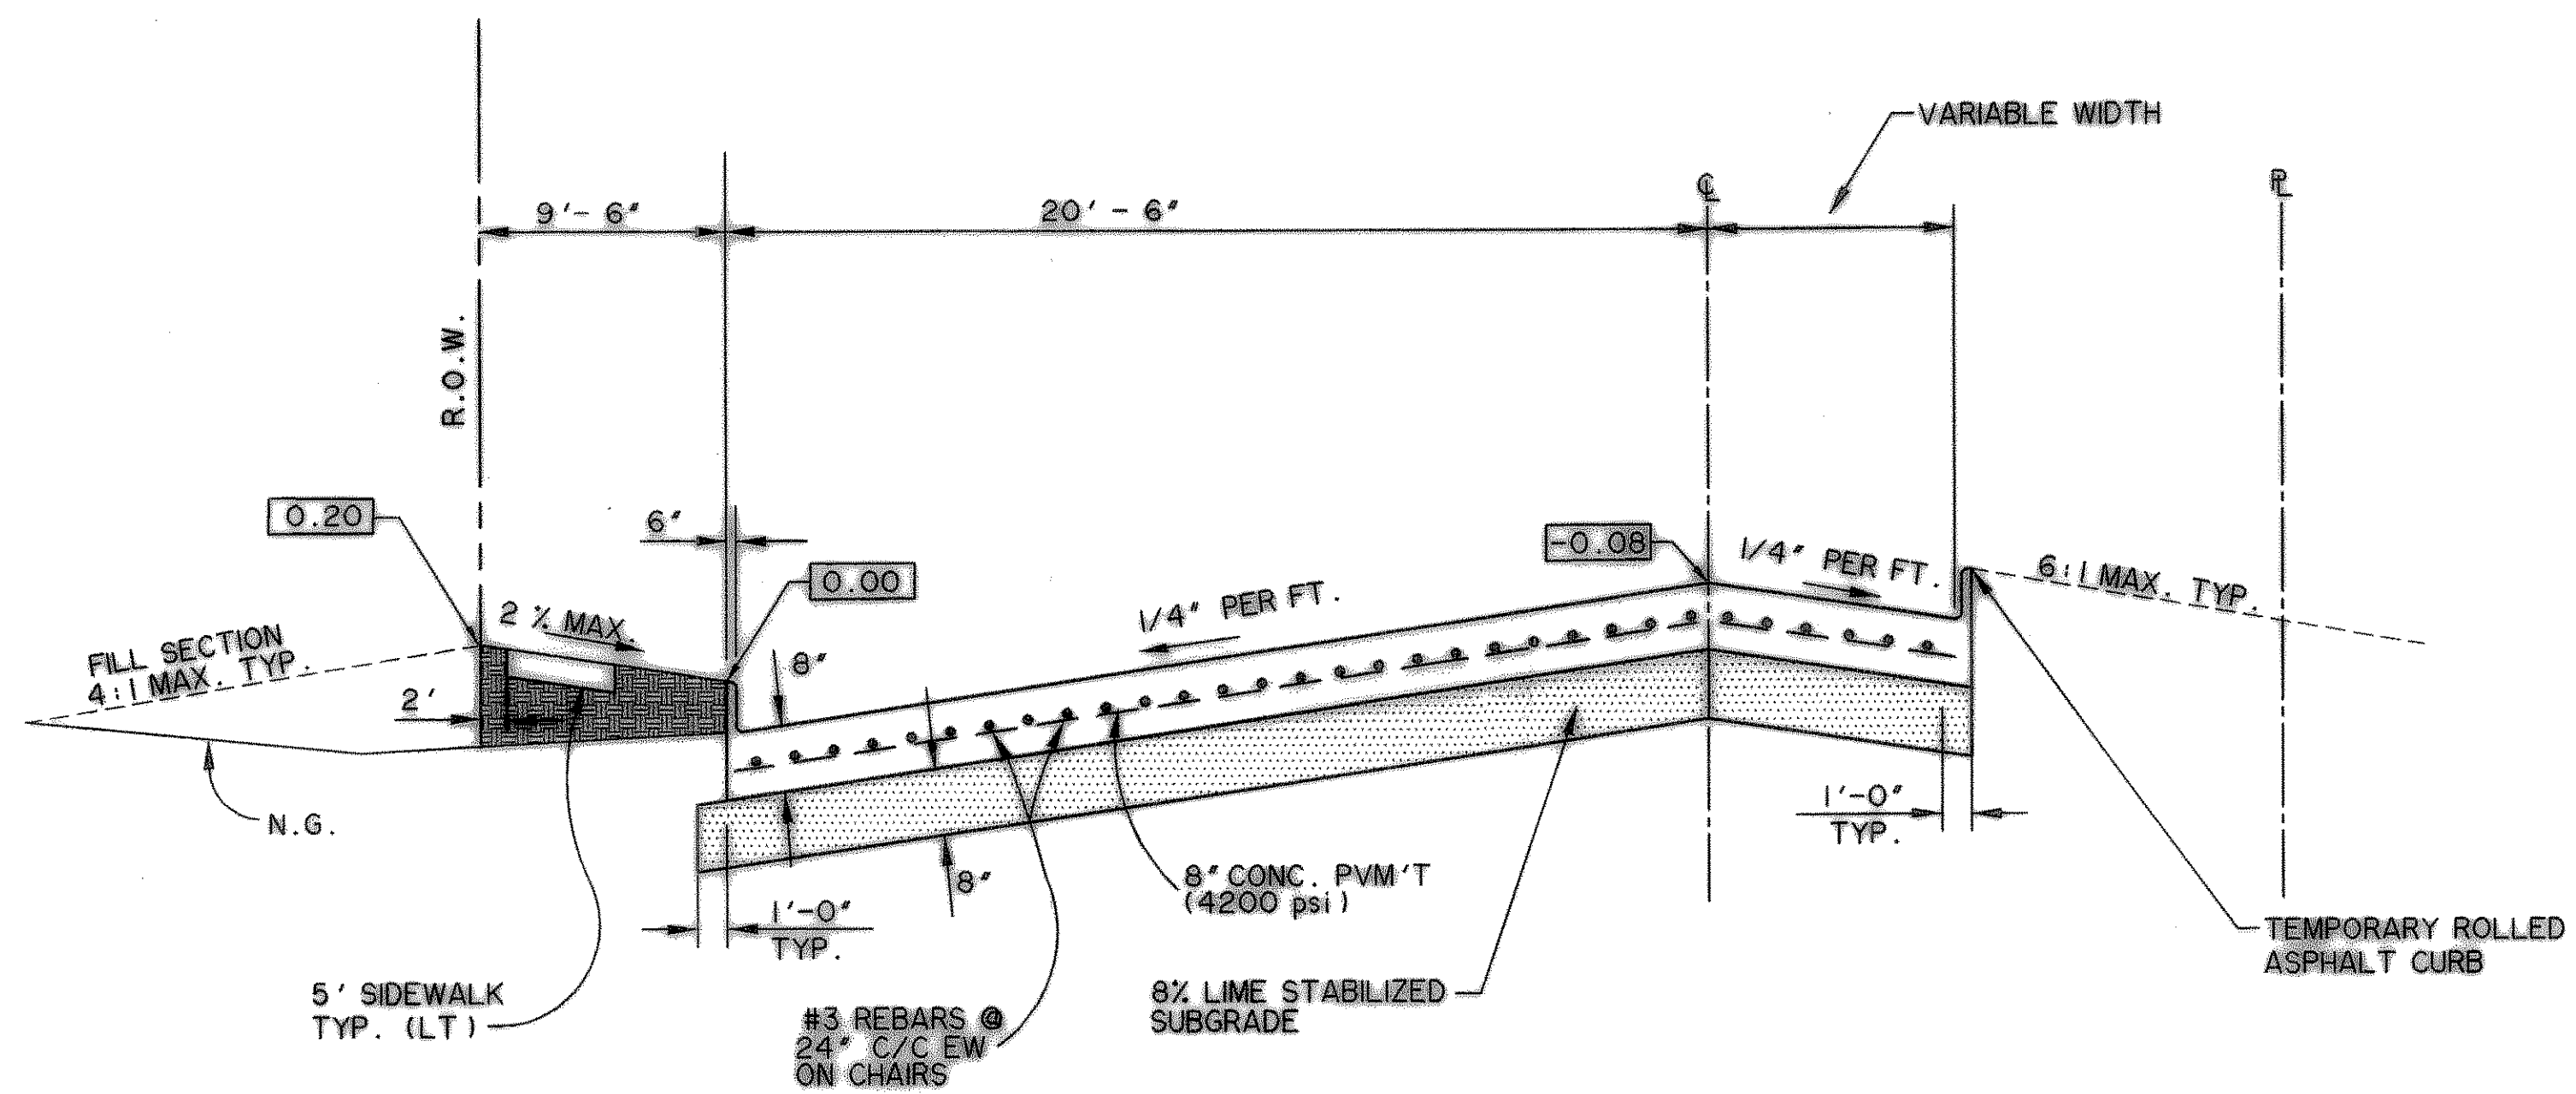


WHITMORE DRIVE UNDIVIDED SECTION

MINOR UNDIVIDED COLLECTOR
SCALE: NTS

RECORD DRAWING
03/13/07

- NOTES:
1. ALL CONSTRUCTION SHALL CONFORM TO THE CITY OR ROCKWALL STANDARD CONSTRUCTION DETAIL. TYPICAL SECTIONS ARE REPLACED BY THOSE SHOWN ON THIS SHEET.
 2. PLACE MIN. 4" TOPSOIL FROM ON SITE SOURCE IN PARK WAYS, SLOPES, AND DISTURBED AREAS. SOD PARK WAYS PER CITY STANDARDS.
 3. ALL FILLS SHALL BE COMPACTED TO 95% MIN. PROCTOR DENSITY. FILLS SHALL BE PLACED IN 8" MAXIMUM LIFTS, AND COMPACTION SHALL BE ACCOMPLISHED BY THE USE OF A SHEEPS-FOOT ROLLER.
 4. REFER TO SHEET P002 FOR JOINT DETAILS, SPACING AND JOINT MATERIALS
 5. REFER TO SHEET P002 AND P003 FOR CURB, SIDEWALK AND CURB RAMP DETAILS.

PREPARED BY:
VIA WIER & ASSOCIATES, INC.
ENGINEERS SURVEYORS LAND PLANNERS
4300 BELTWAY PLACE SUITE 130 ARLINGTON, TEXAS 76018 METRO (817)467-7700
1800 U.S. HIGHWAY 287 N. SUITE 101 MARSHFIELD, TEXAS 76663 METRO (817)477-8700
6849 ELM STREET FRISCO, TEXAS 75034 METRO (214)397-8800
www.viawier.com

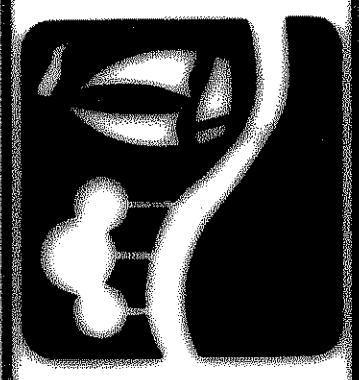

CITY OF
ROCKWALL
WHITMORE'S
EXPANSION

TYPICAL SECTIONS



Ronald Ramirez

COPYRIGHT ©
VIA WIER & ASSOCIATES, INC.
LAST SHEET EDIT
DATE: 03/13/2007
WA# 04124.02
SHEET NO. P001

FILE: hyspac-dfj-04124_02.dwg

TIME: 114.01