



TIME 14:01 FILE: WATERSEWER PROFILE-04124_02.dwg

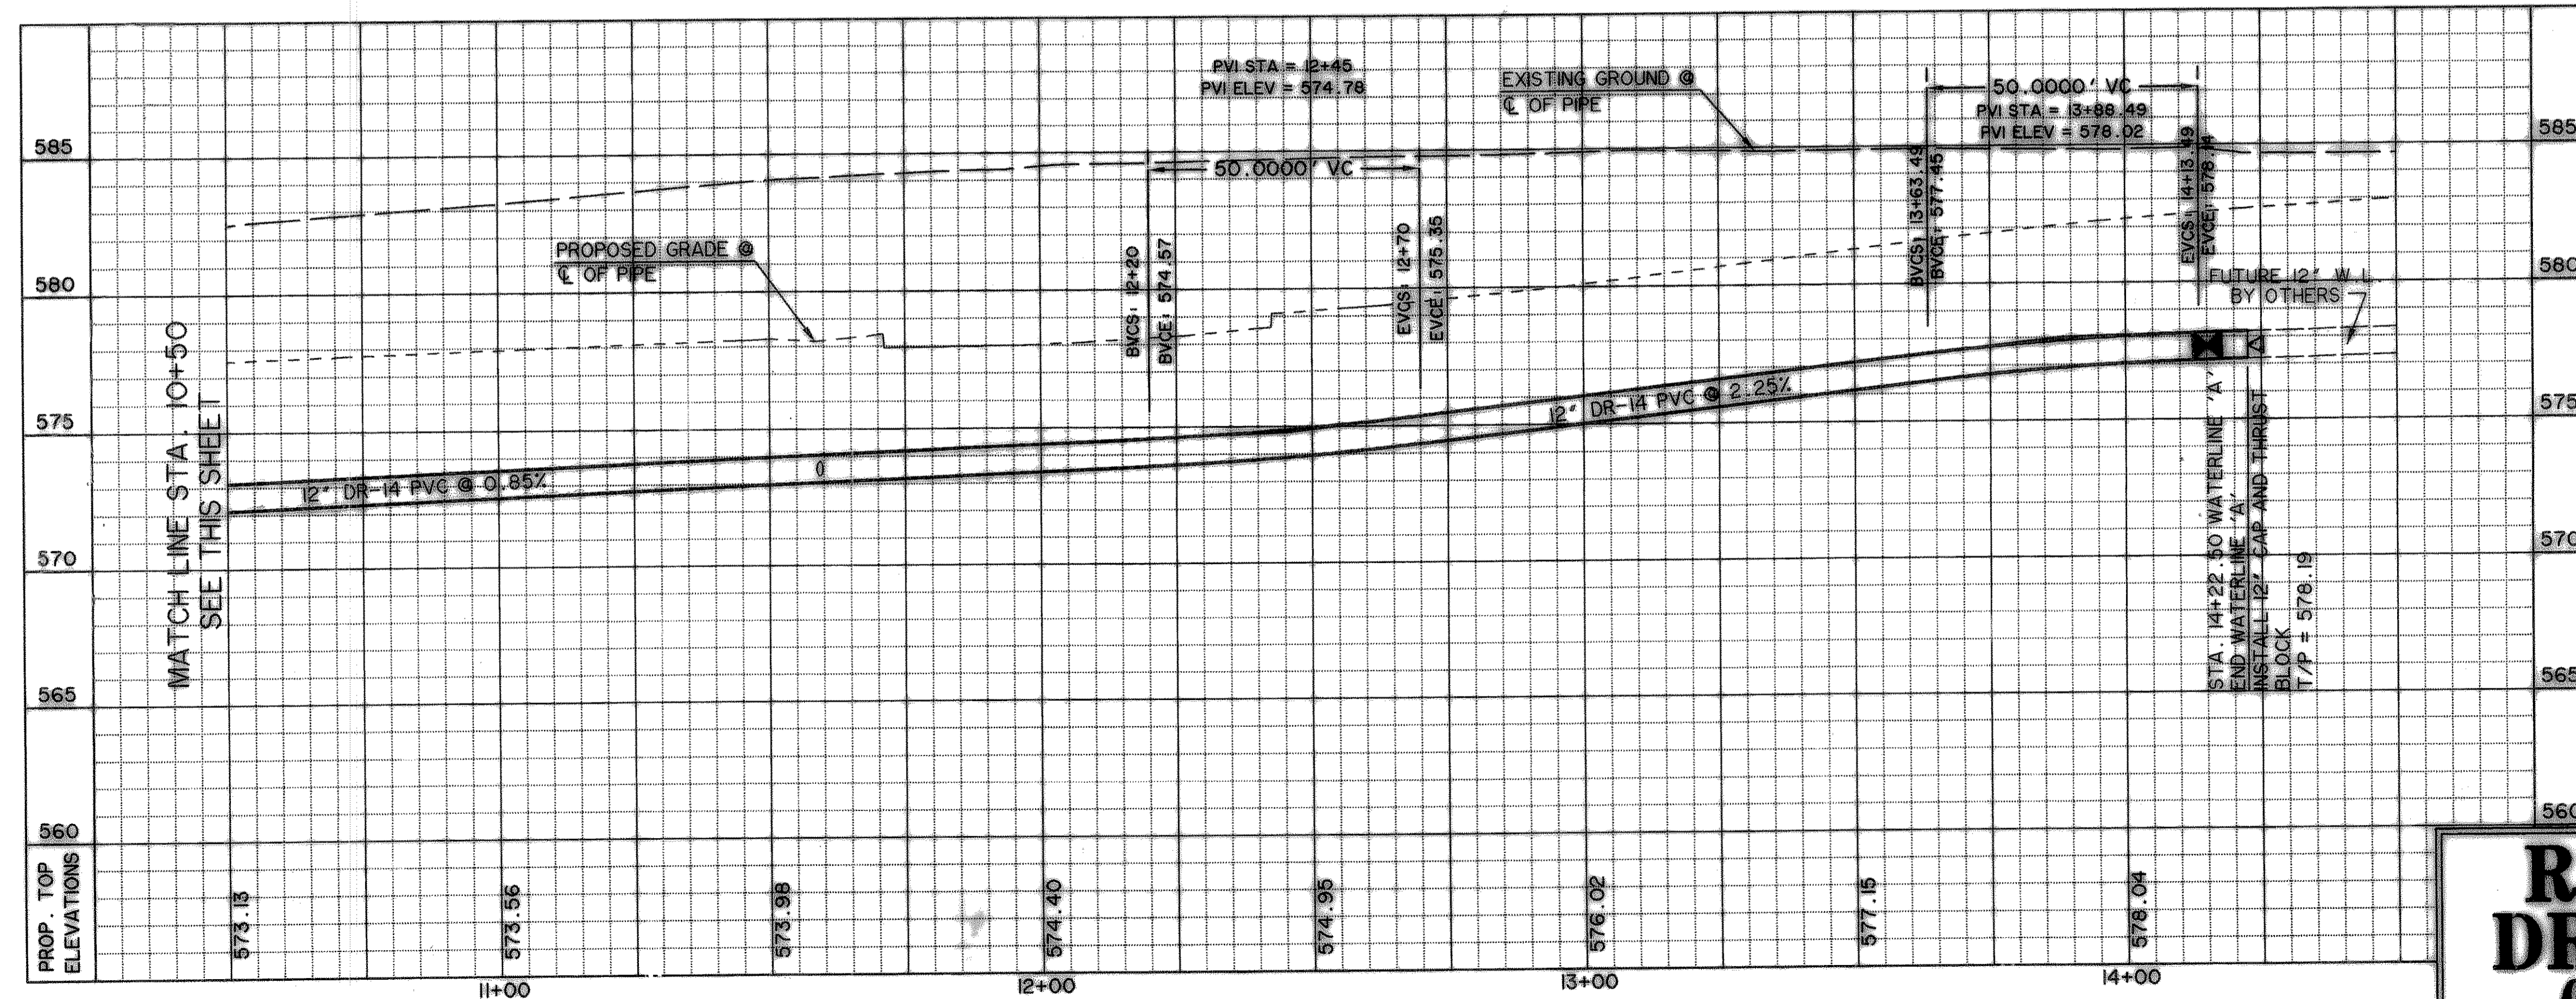

12" WATERLINE 'A'

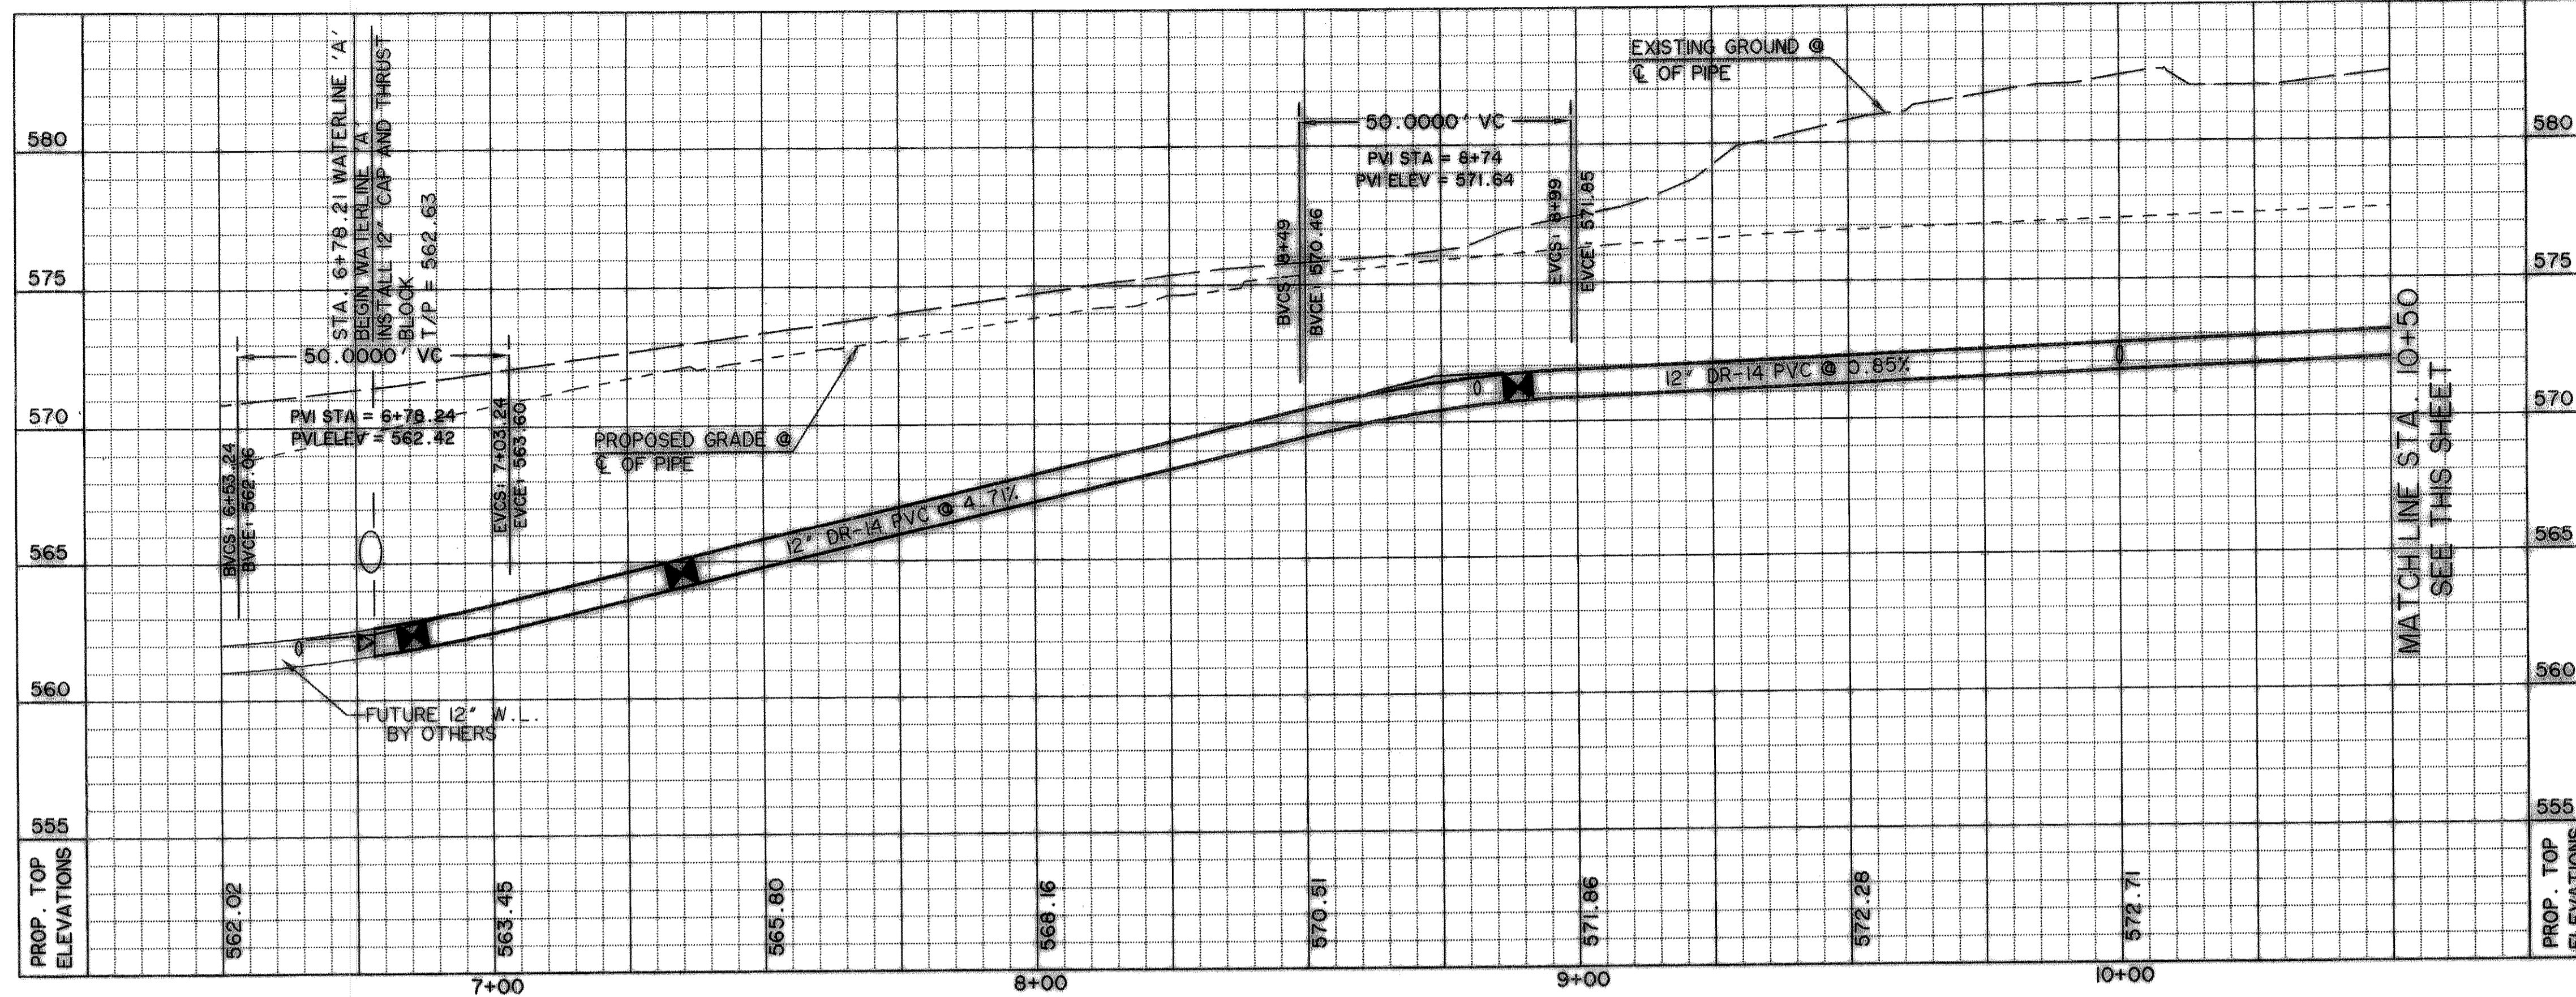

**RECORD
DRAWING**
03/13/07




PREPARED BY:
VIA WIER & ASSOCIATES, INC.
ENGINEERS SURVEYORS LAND PLANNERS
4300 BELWAY PLACE SUITE 100 ARLINGTON, TEXAS 76016 METRO (817)467-7700
1360 U.S. HIGHWAY 287 N. SUITE 101 WAXFORD, TEXAS 76063 METRO (817)477-0700
6849 ELM STREET FORT WORTH, TEXAS 76104 METRO (214)387-8000
www.viawier.com

Copyright ©
VIA WIER & ASSOCIATES, INC.
LAST SHEET EDIT
DATE 03/13/2007
WA# 04124_02

SHEET NO.
U102

CITY OF
ROCKWALL
WHITMORE'S
EXPANSION

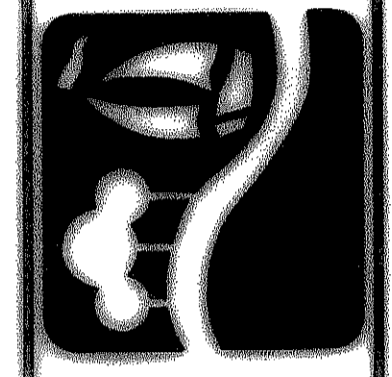

PREPARED BY:
VIA WIER & ASSOCIATES, INC.
ENGINEERS SURVEYORS LAND PLANNERS
4300 BELWAY PLACE SUITE 100 ARLINGTON, TEXAS 76016 METRO (817)467-7700
1360 U.S. HIGHWAY 287 N. SUITE 101 WAXFORD, TEXAS 76063 METRO (817)477-0700
6849 ELM STREET FORT WORTH, TEXAS 76104 METRO (214)387-8000
www.viawier.com