


-1+00 0+00 1+00 2+00 3+00 4+00 5+00


STORM SEWER LINE "A"

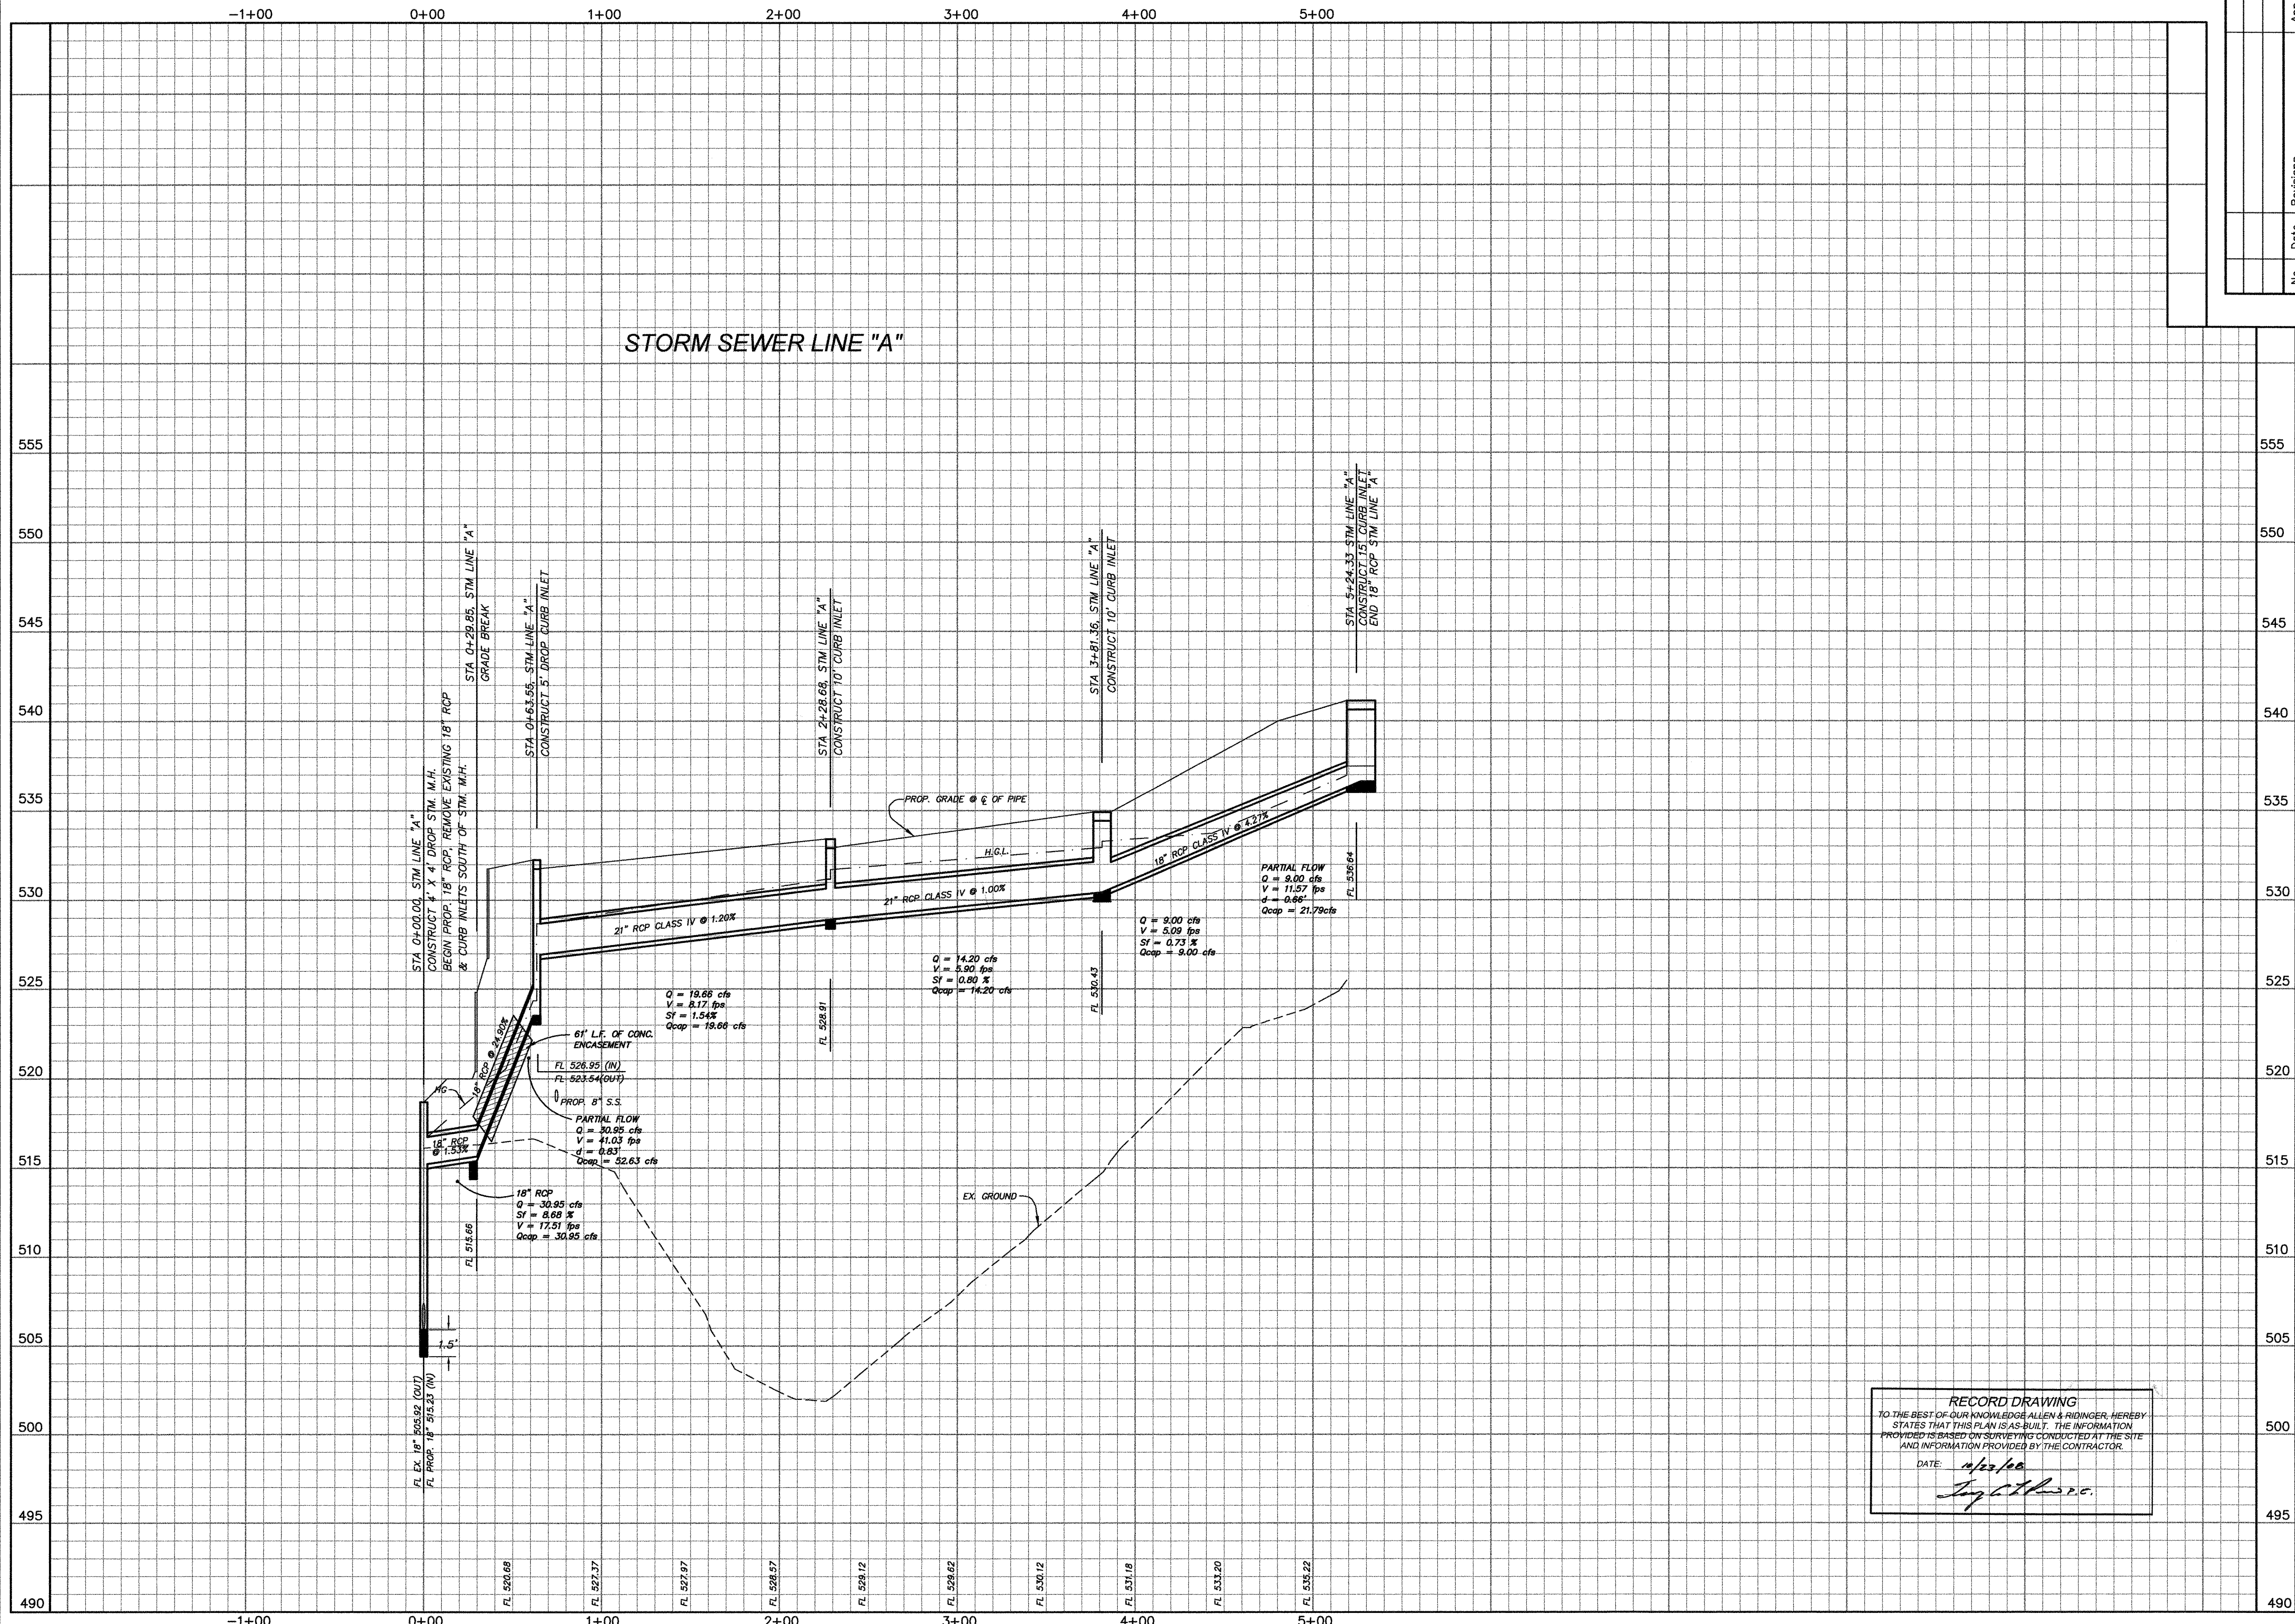

RECORD DRAWING
 TO THE BEST OF OUR KNOWLEDGE ALLEN & RIDINGER, HEREBY STATES THAT THIS PLAN IS AS-BUILT. THE INFORMATION PROVIDED IS BASED ON SURVEYING CONDUCTED AT THE SITE AND INFORMATION PROVIDED BY THE CONTRACTOR.
 DATE: 5/31/07
 J. S. Allen

No.	Date	Revisions	App.

Allen & Ridinger Consulting, Inc.
 285 W. Southwest Pkwy
 Lewisville, Texas 75067
 Tel. No. (972) 353-8000
 Fax No. (972) 353-8011

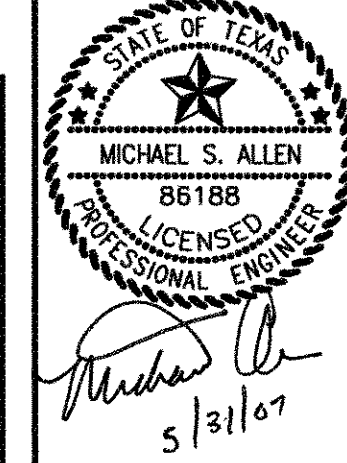

Wilkinson Commons
 ROCKWALL, TEXAS

STORM SEWER
 PROFILE LINE "A"

Scale: 1" = 40' HORZ., 1" = 4' VERT.
 Designed by: LHR
 Drawn by: JWH
 Checked by: MSA
 Date: MAY 29, 2007
 Project No. 070-001