

 DENOTES AREAS & LIMITS OF DEMOLITION
 DENOTES ESMT.'S TO BE ABANDONED BY SEPARATE INSTRUMENT

RECORD DRAWING
 TO THE BEST OF OUR KNOWLEDGE ALLEN & RIDINGER, HEREBY STATES THAT THIS PLAN IS AS-BUILT. THE INFORMATION PROVIDED IS BASED ON SURVEYING CONDUCTED AT THE SITE AND INFORMATION PROVIDED BY THE CONTRACTOR.
 DATE: 10/23/08
Signatures

EXISTING DRIVES TO BE REMOVED AND REPLACED WITH COMMON DRIVE. SEE GRADING AND DIMENSION CONTROL PLANS.

PROPOSED STORM MANHOLE TO BE CONSTRUCTED AT STORM LINE "A" STA. 0+00.00. EXISTING CURB INLETS AND PIPS TO SOUTH OF PROPOSED MANHOLE TO BE REMOVED.

No.	Date	Revisions	App.

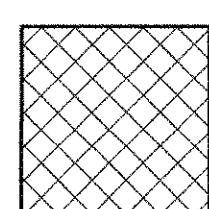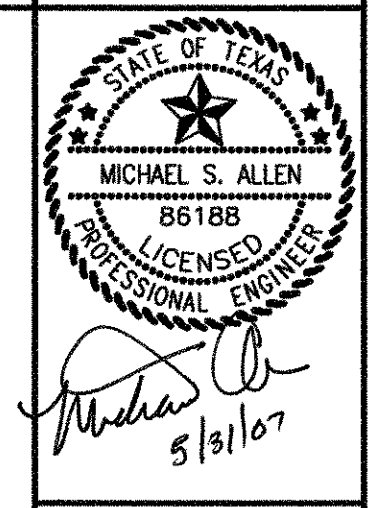

Wilkinson Commons
ROCKWALL, TEXAS

DEMOLITION PLAN

Scale: 1"=40' HOR., 1"=4' VERT.
 Designed by: LHR
 Drawn by: LHR
 Checked by: MSA
 Date: MAY 29, 2007
 Project No. 070-001

SHEET
C-10
 OF 10

Allen & Ridinger Consulting, Inc.
 Tel. No. (972) 353-8000
 Fax No. (972) 353-8011
 285 W. Southwest Pkwy
 Lewisville, Texas 75067