




LOCATION OF WALL HAS BEEN MOVED FROM 11' TO 13' AS DISCUSSED WITH THE CIVIL ENGINEER. VERIFICATION REQUIRED BEFORE INSTALLATION.

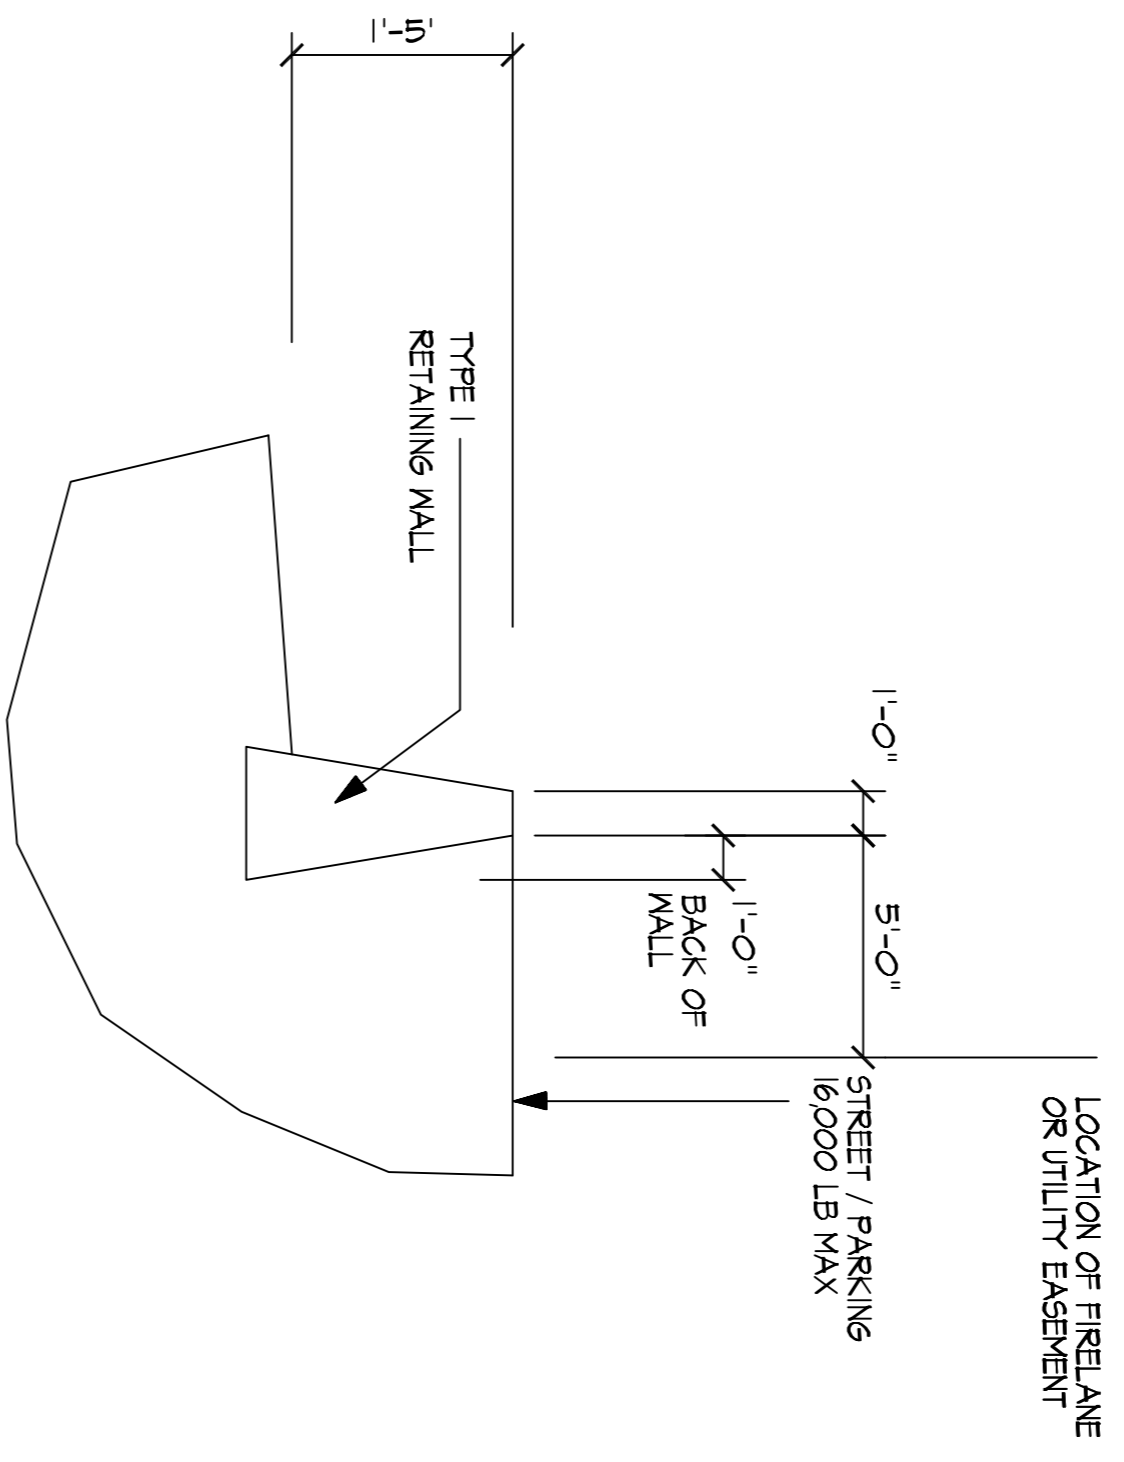

A WALL SECTIONS
NO SCALE

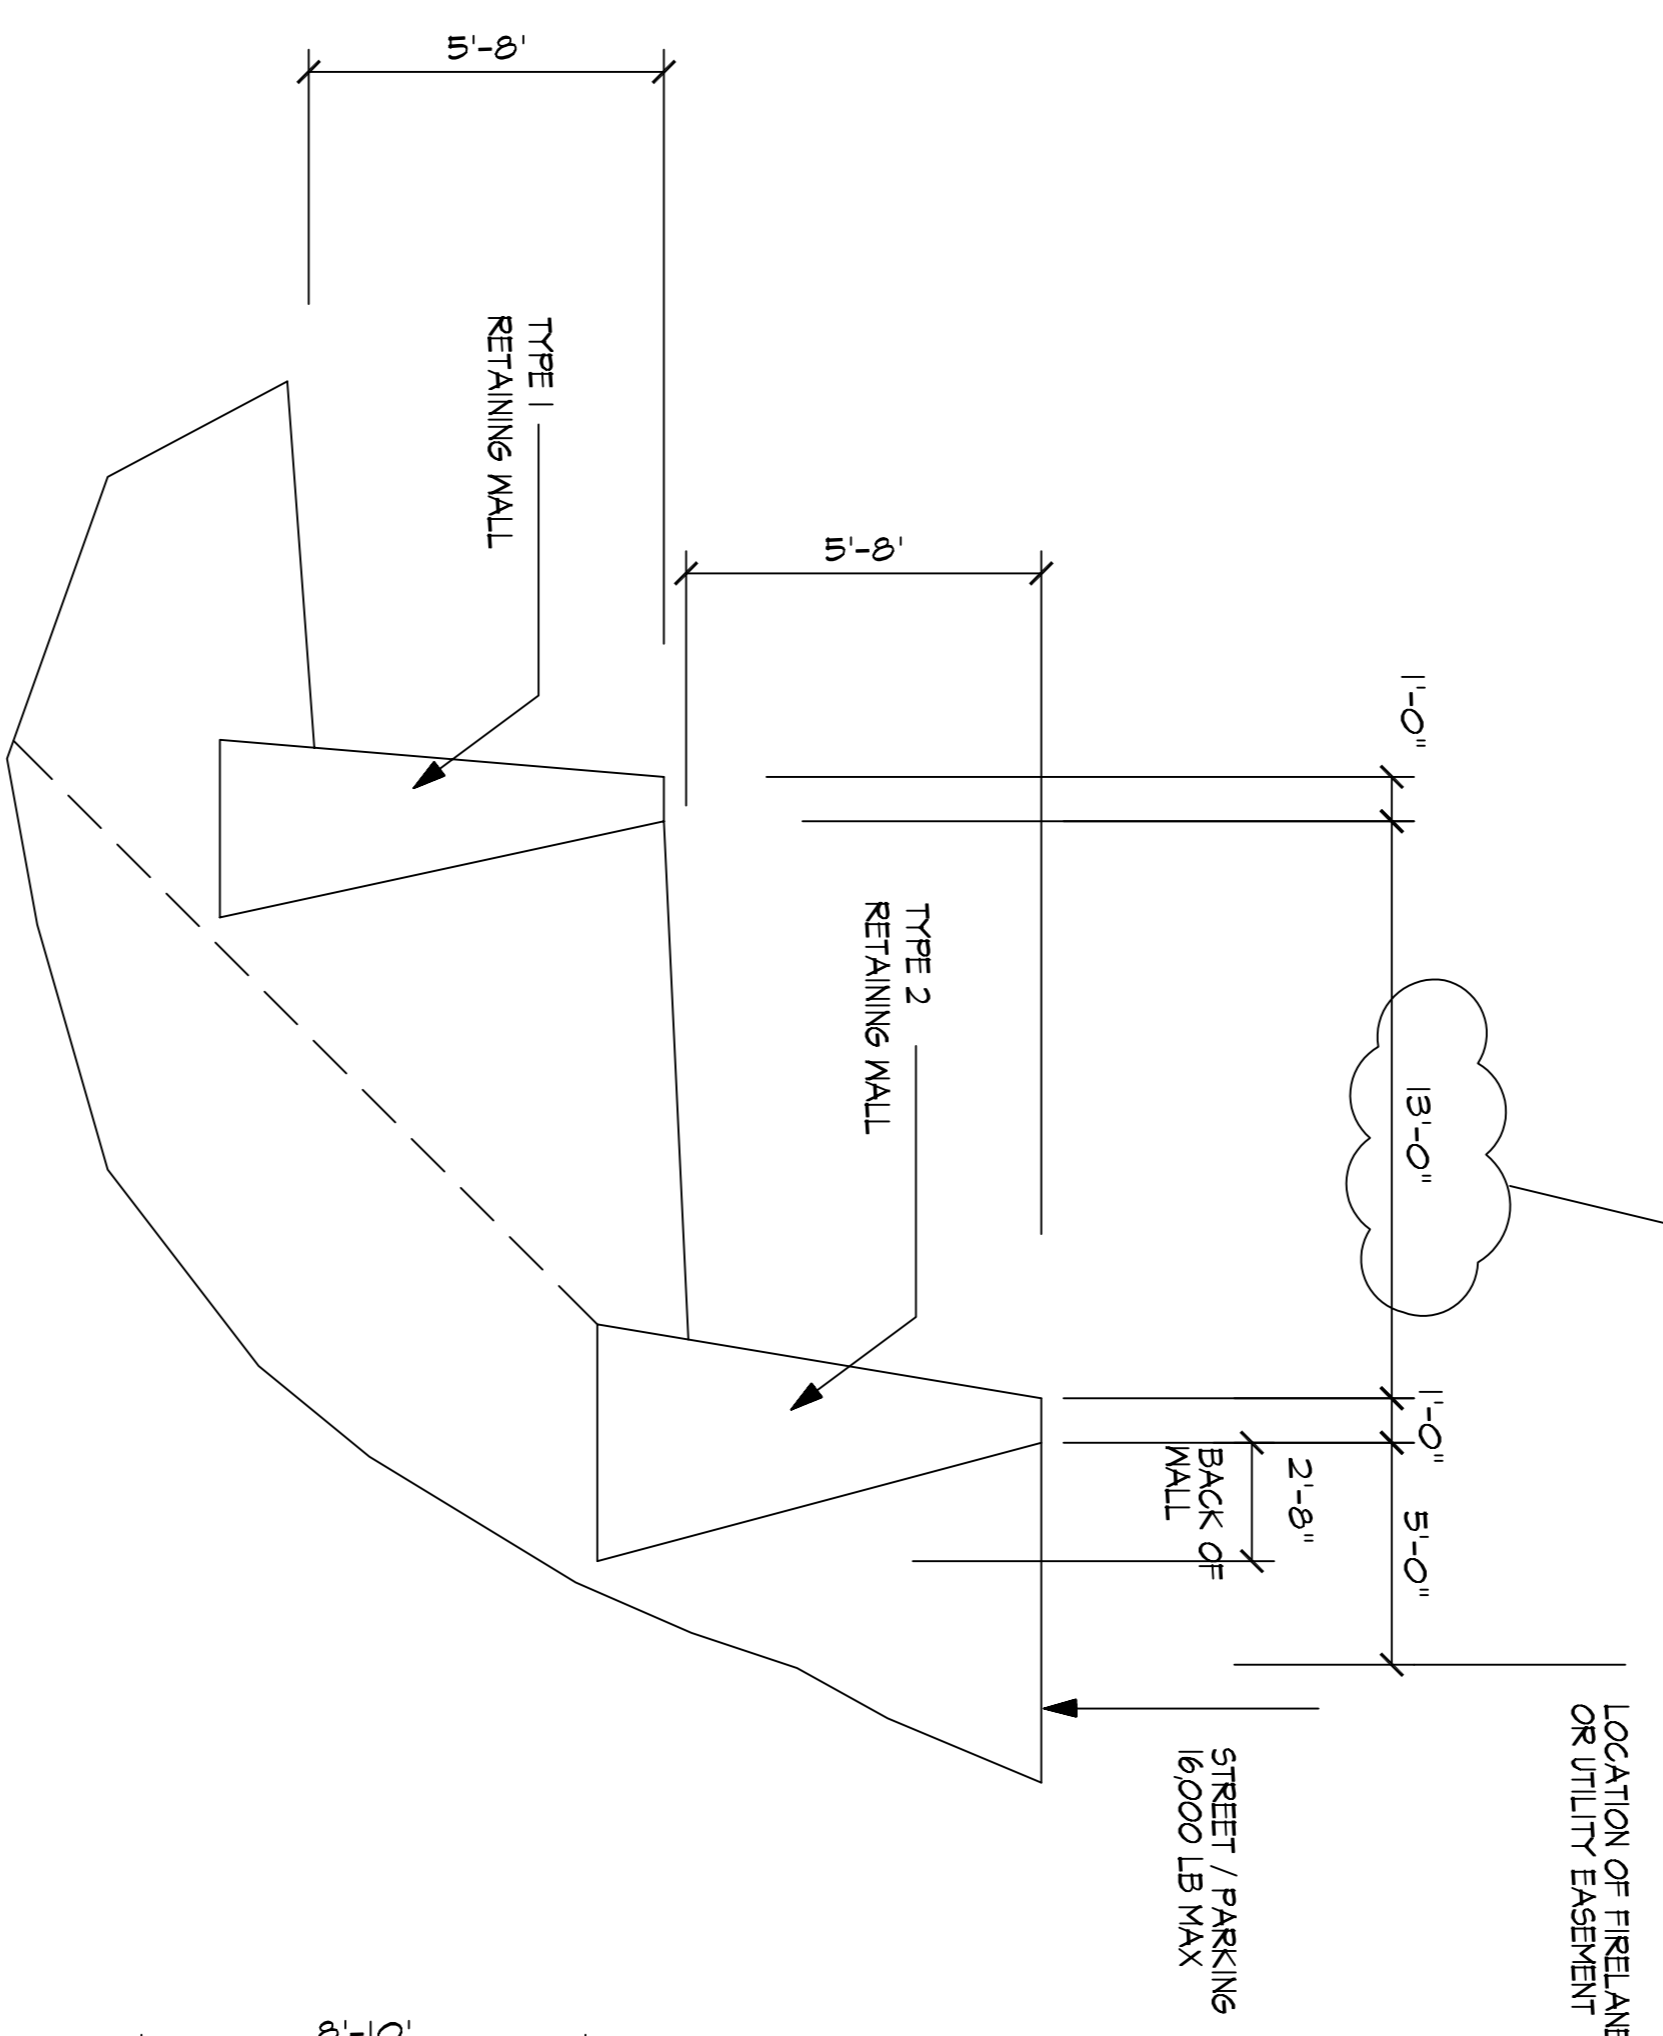

B WALL SECTIONS
NO SCALE

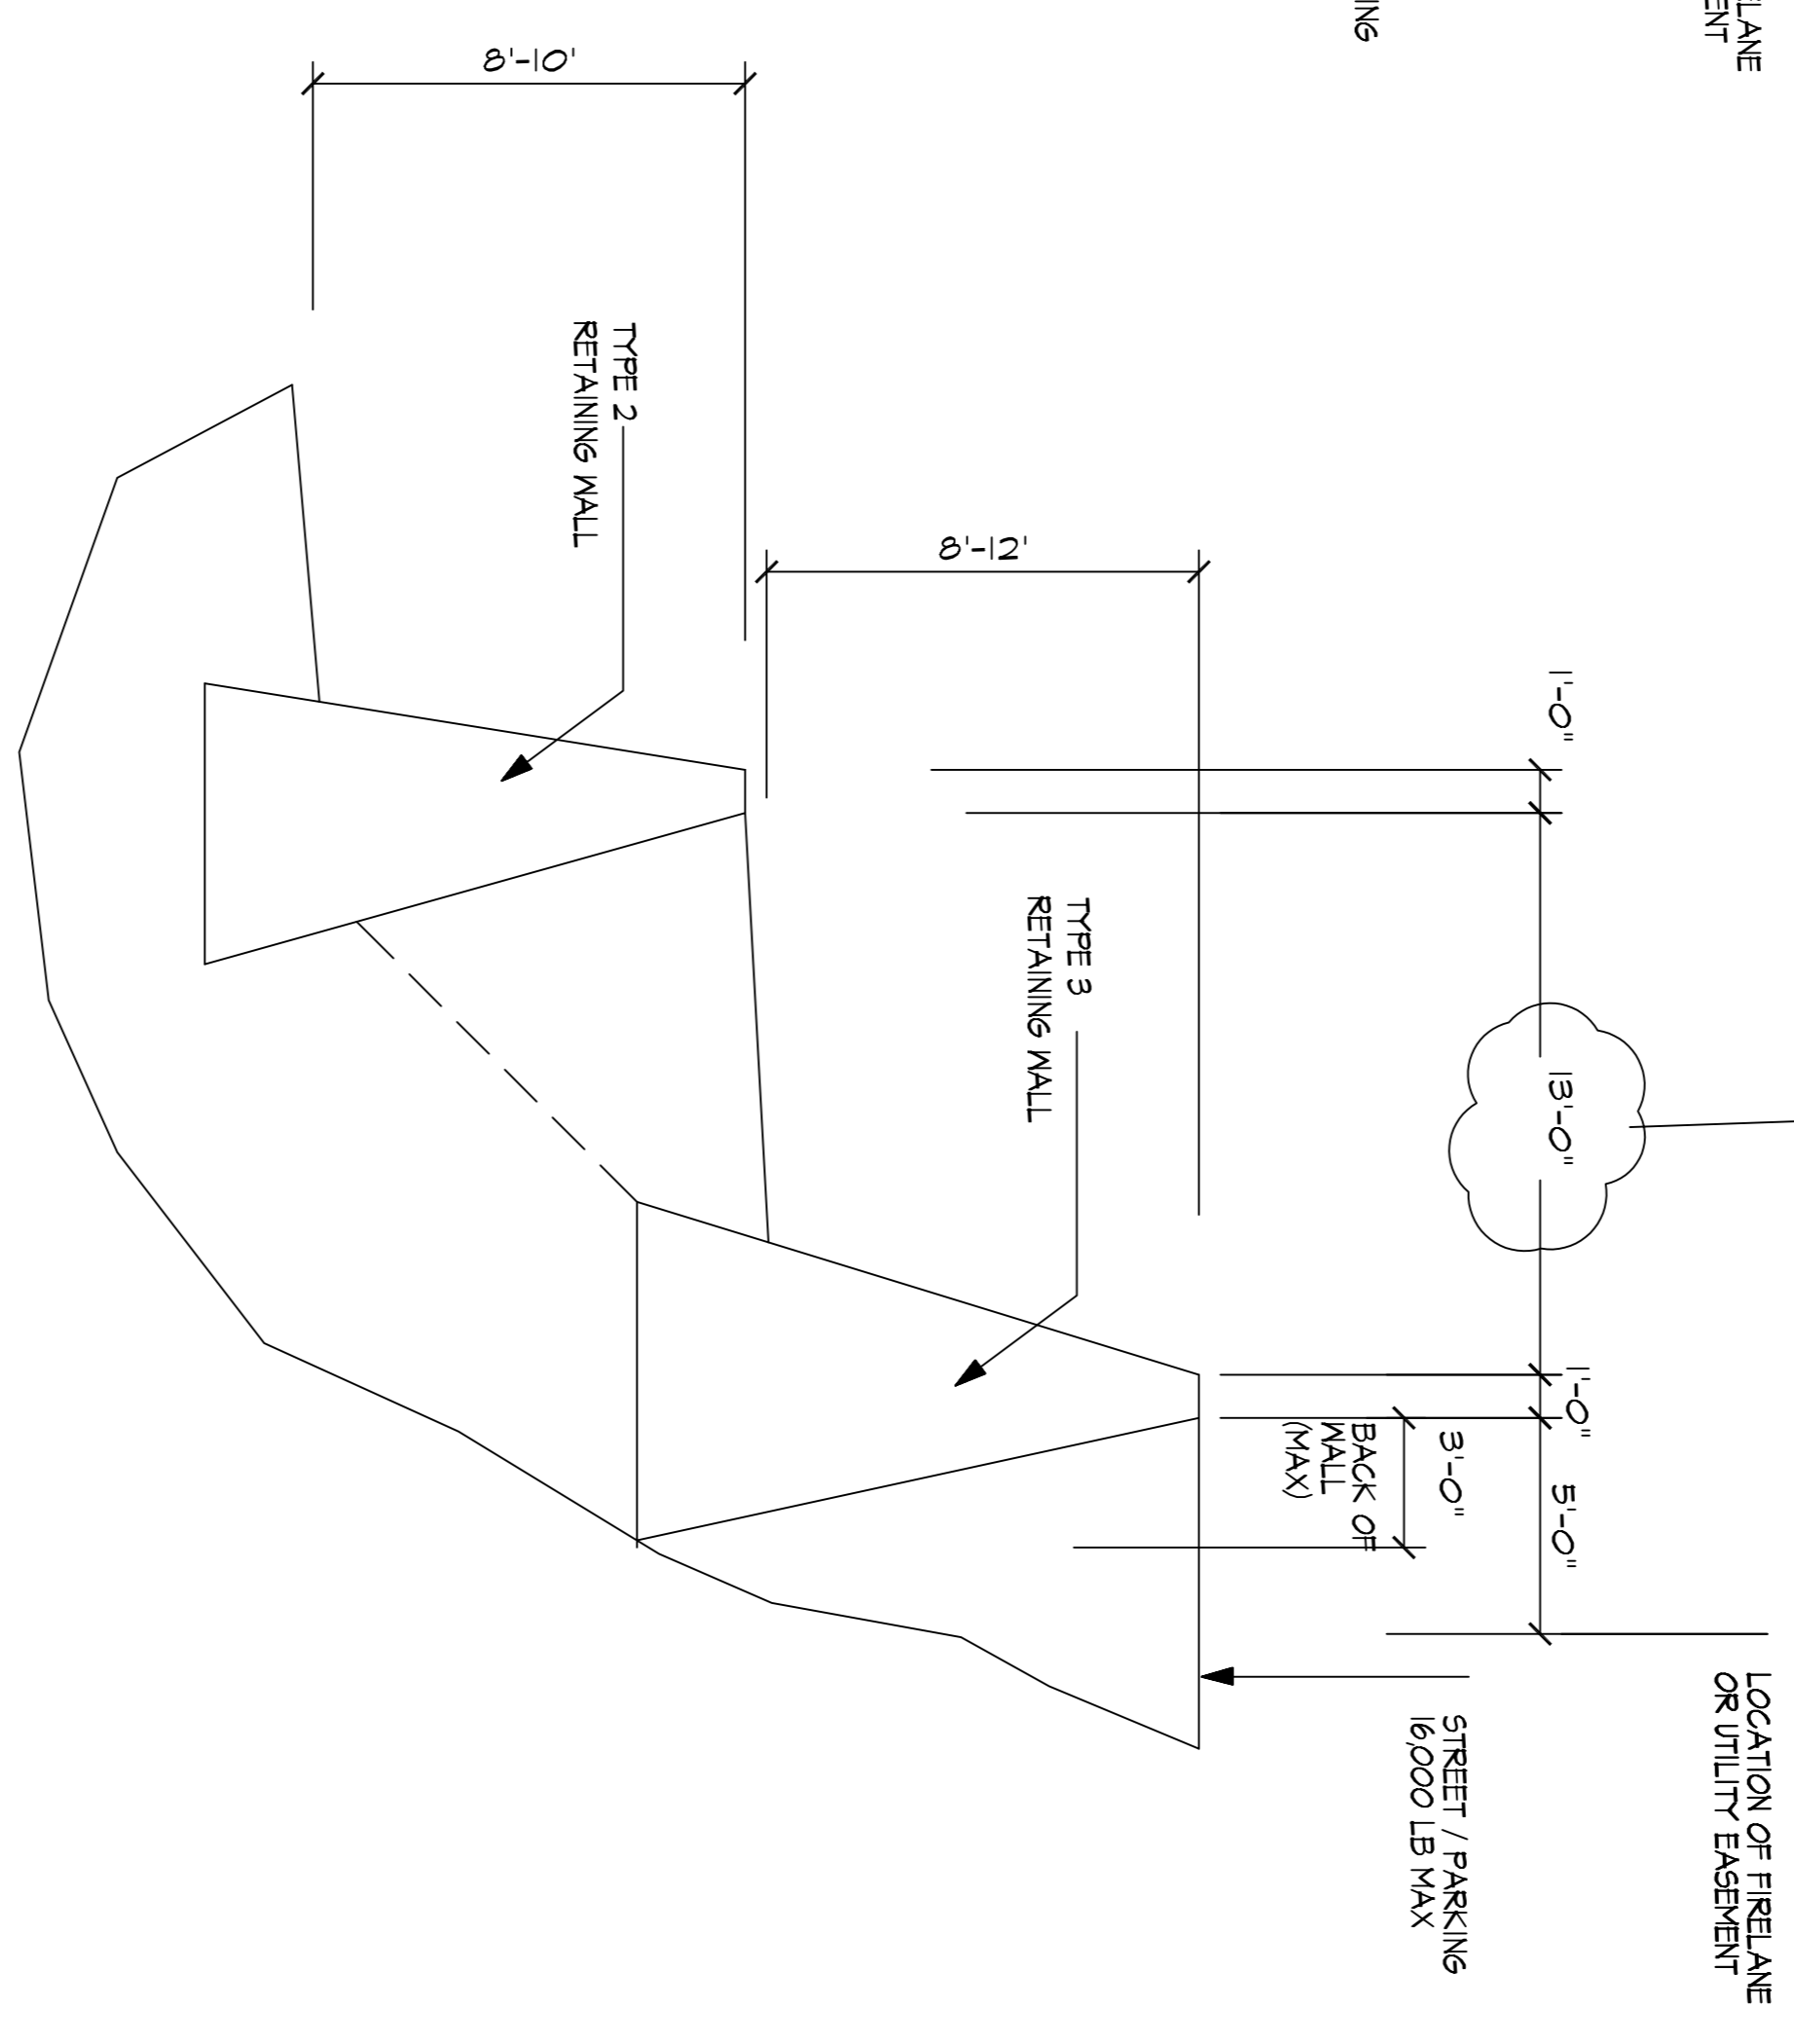

C WALL SECTIONS
NO SCALE

The seal appearing on this document was authorized by Tony H. Childress, P.E. #72029 on 08/20/07. (Record copy on file)



This document may not be changed from Tony H. Childress, P.E.

REV	BY	DATE	DESCRIPTION
1	THC	08/11/07	REVISED WALL DESIGN



Childress Engineering Services, Inc.
2505 North Plano Road, Suite 1200
Richardson, Texas 75082
Office: (214) 451-6630 Fax: (214) 451-6631

WILKINSON COMMONS
LA JOLLA POINTE DRIVE AND I-30
ROCKWALL, TEXAS
RETAINING WALLS

PROJECT NO.:
DRAWN BY: THC
DATE: 08-04-07
SCALE: 1/4" = 1'-0"
DRAWING NO.:
SHEET: 6 OF 8