


LOCATION OF WALL HAS BEEN MOVED FROM 11' TO 13' AS DISCUSSED WITH THE CIVIL ENGINEER. VERIFICATION REQUIRED BEFORE INSTALLATION.

CIVIL ENGINEER TO VERIFY SIZE OF INLET AND CLEARANCE REQUIRED FOR INSTALLATION.

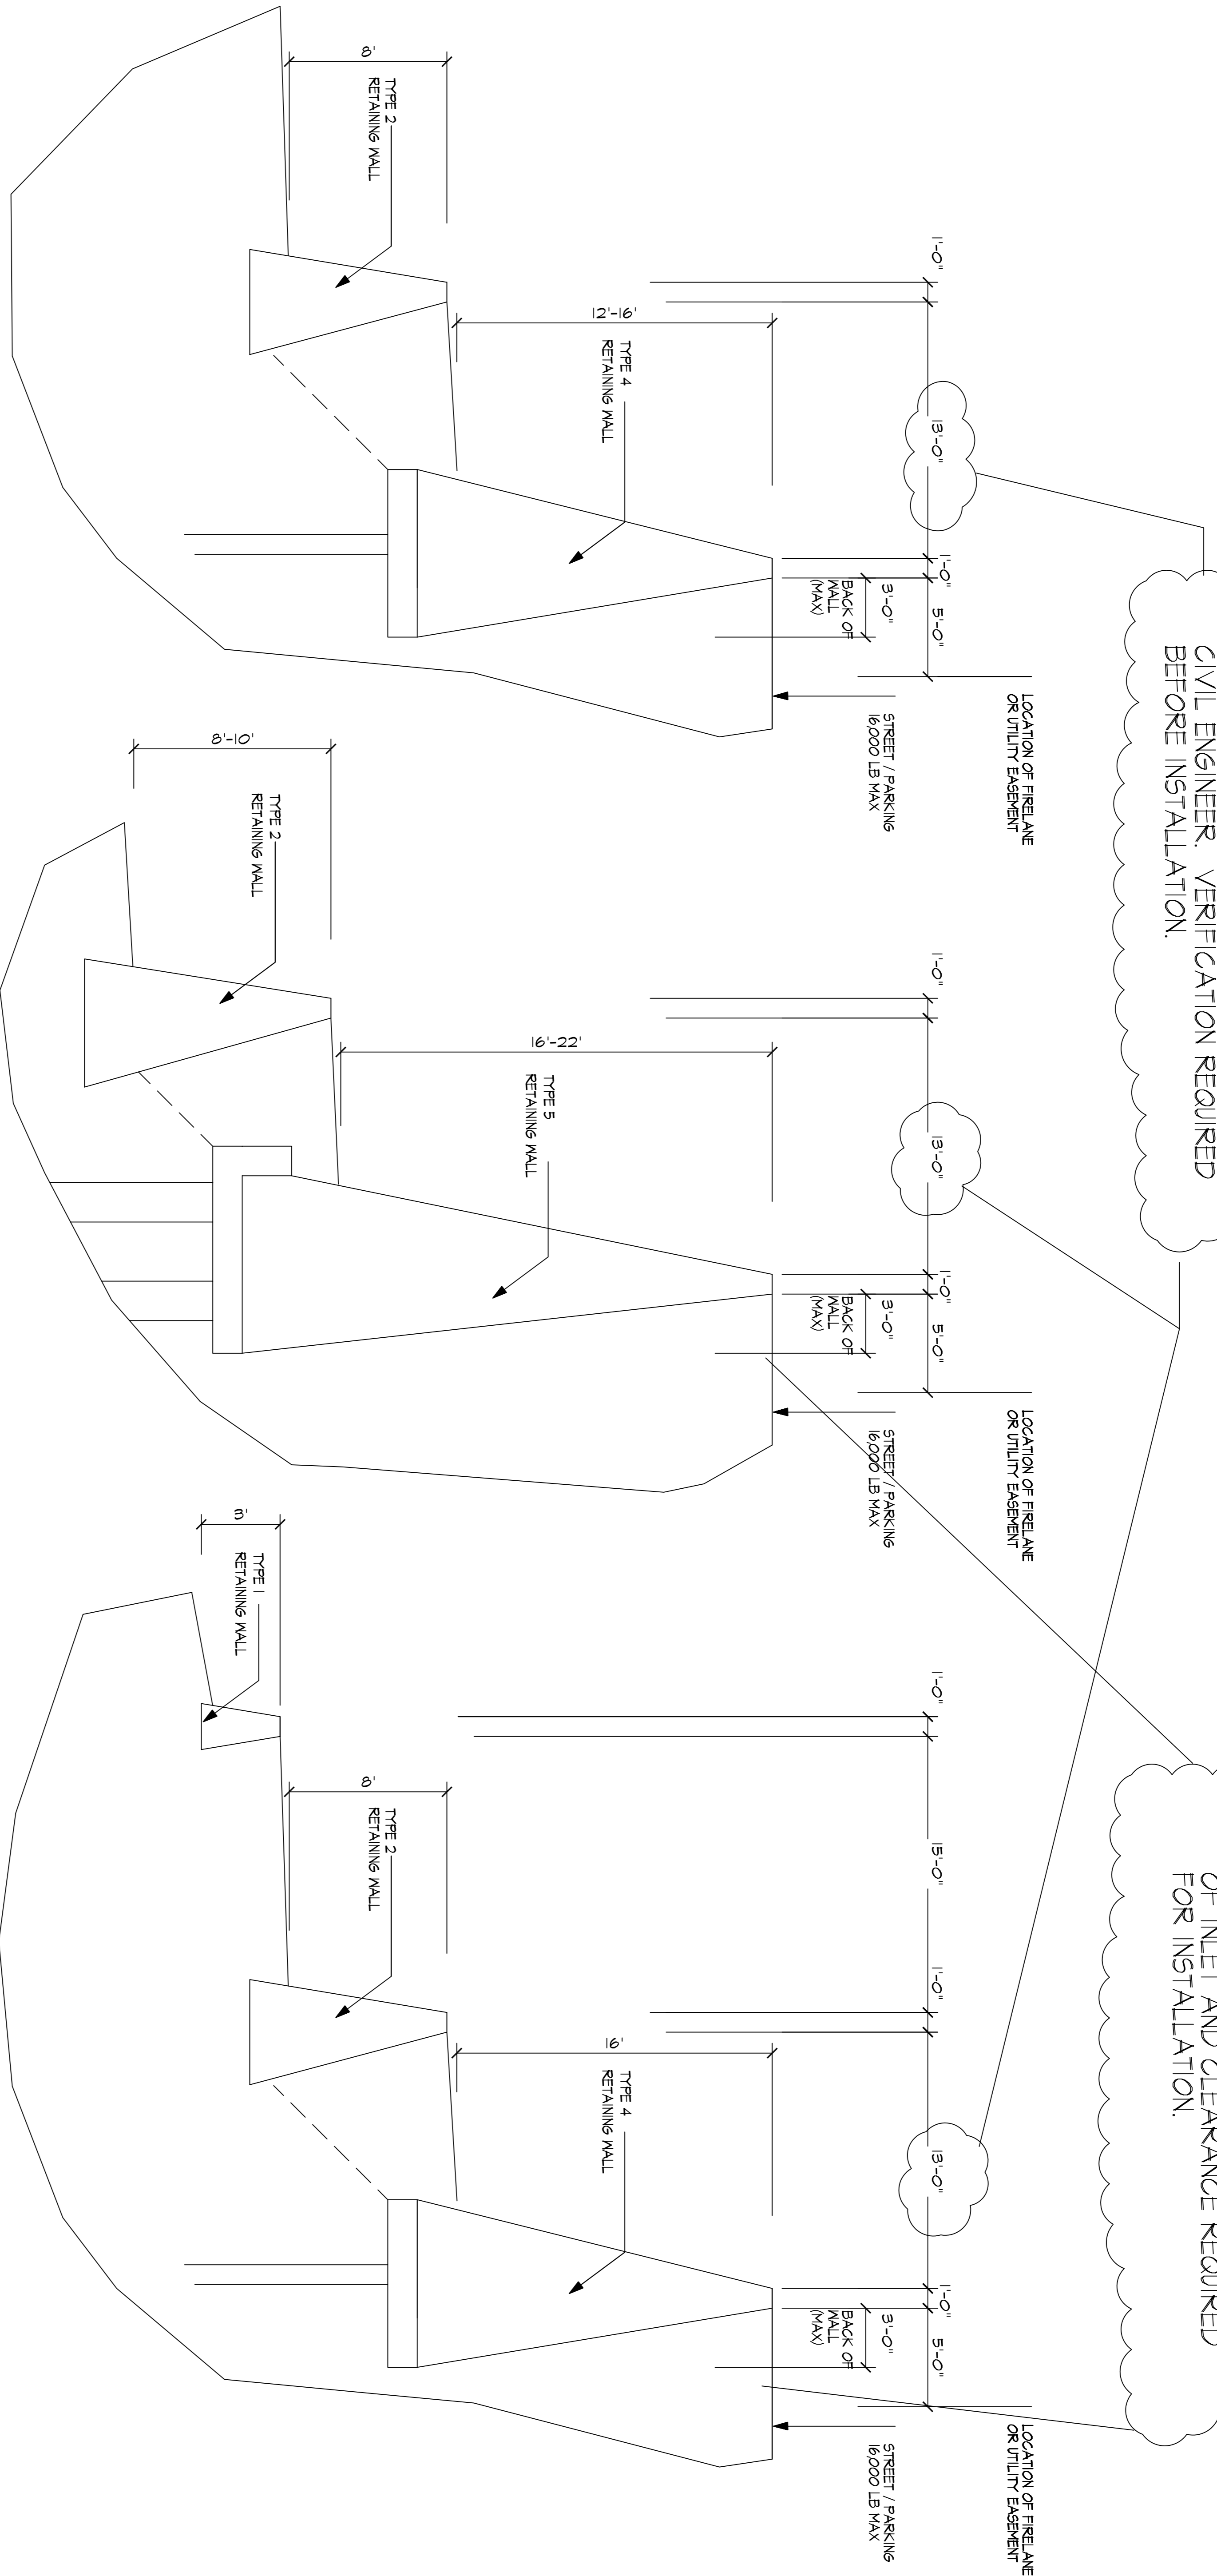

D WALL SECTIONS

NO SCALE

E WALL SECTIONS

NO SCALE

F WALL SECTIONS

NO SCALE

The seal appearing on this document was authorized by Tony H. Childress, P.E. #72029 on 08-16-07 (Record Copy on file)



This document may not be changed from Tony H. Childress, P.E.

WILKINSON COMMONS LA JOLLA POINTE DRIVE AND I-30 ROCKWALL, TEXAS RETAINING WALLS		 Childress Engineering Services, Inc. 2505 North Plano Road, Suite 1200 Richardson, Texas 75082 Office:(214) 451-6630 Fax:(214) 451-6631 CESGLOBAL.COM		MANUAL COMP 1 THC 08/11/07 REVISED WALL DESIGN REV BY DATE DESCRIPTION
---	--	---	--	---