


LOCATION OF WALL HAS BEEN MOVED FROM 11' TO 13' AS DISCUSSED WITH THE CIVIL ENGINEER. VERIFICATION REQUIRED BEFORE INSTALLATION.

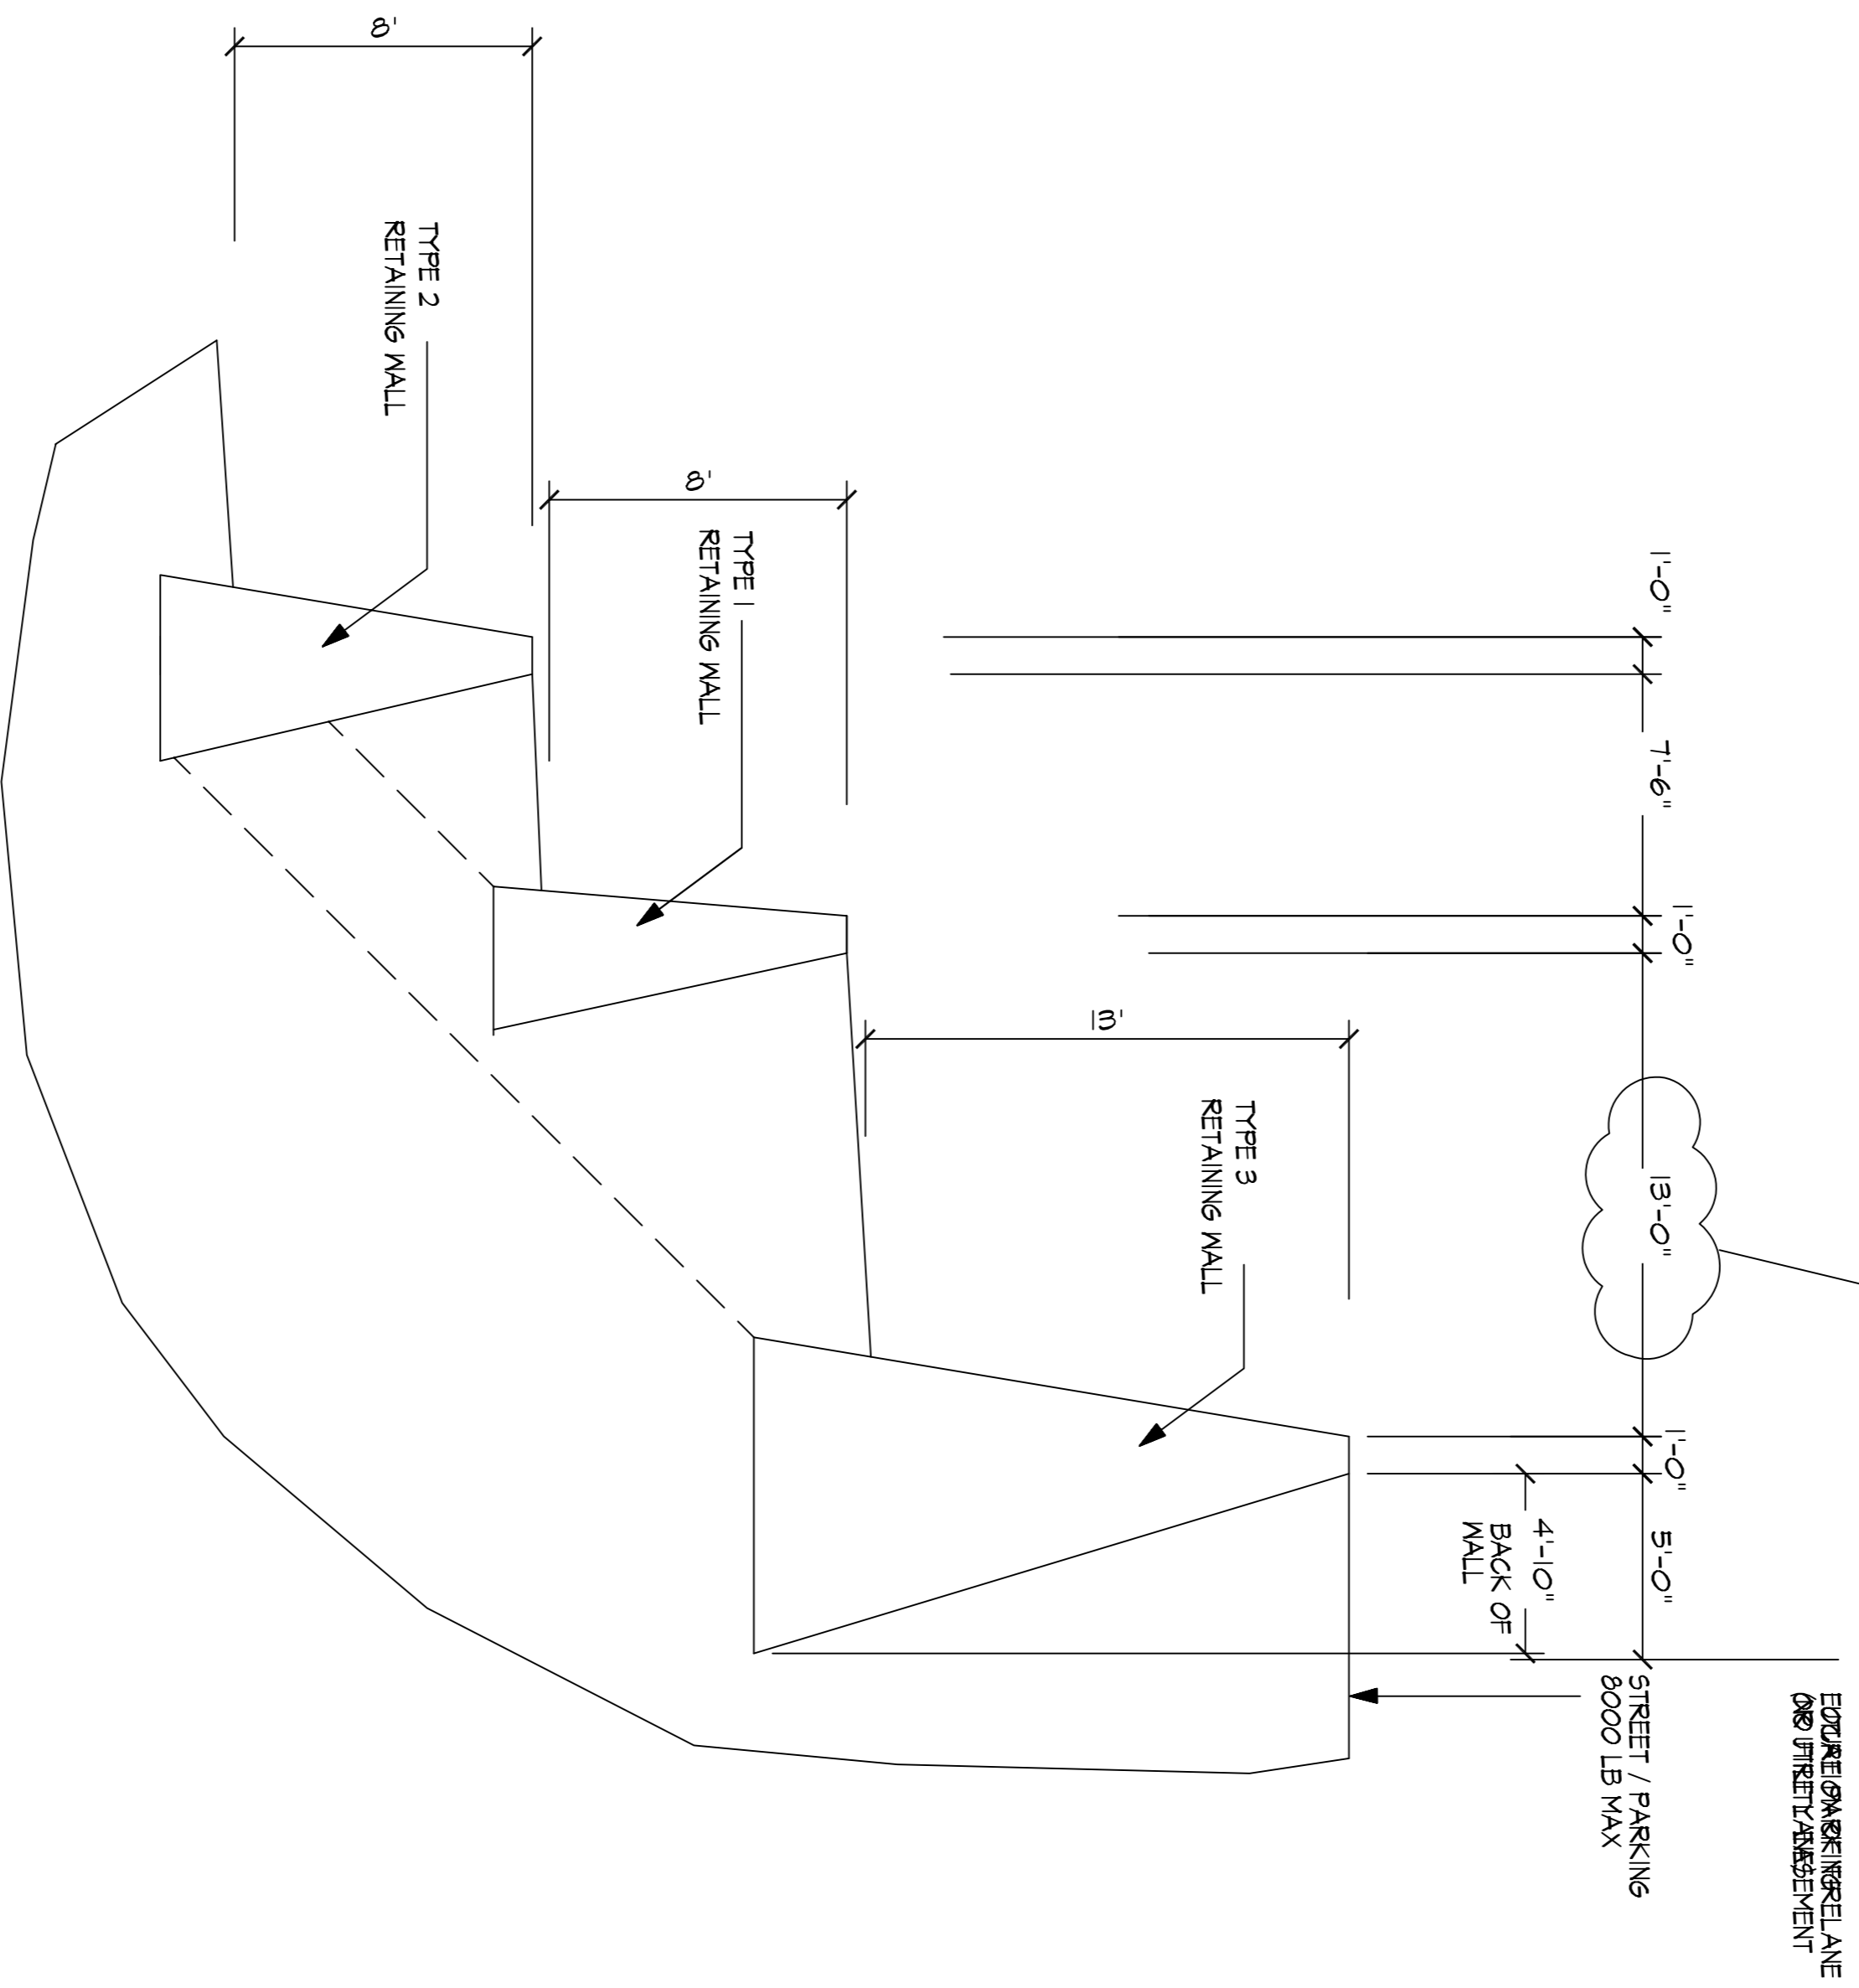


EDGE OF DRIVEWAY OR UTILITY EASEMENT

STREET / PARKING 8000 LB MAX

## H WALL SECTIONS

NO SCALE

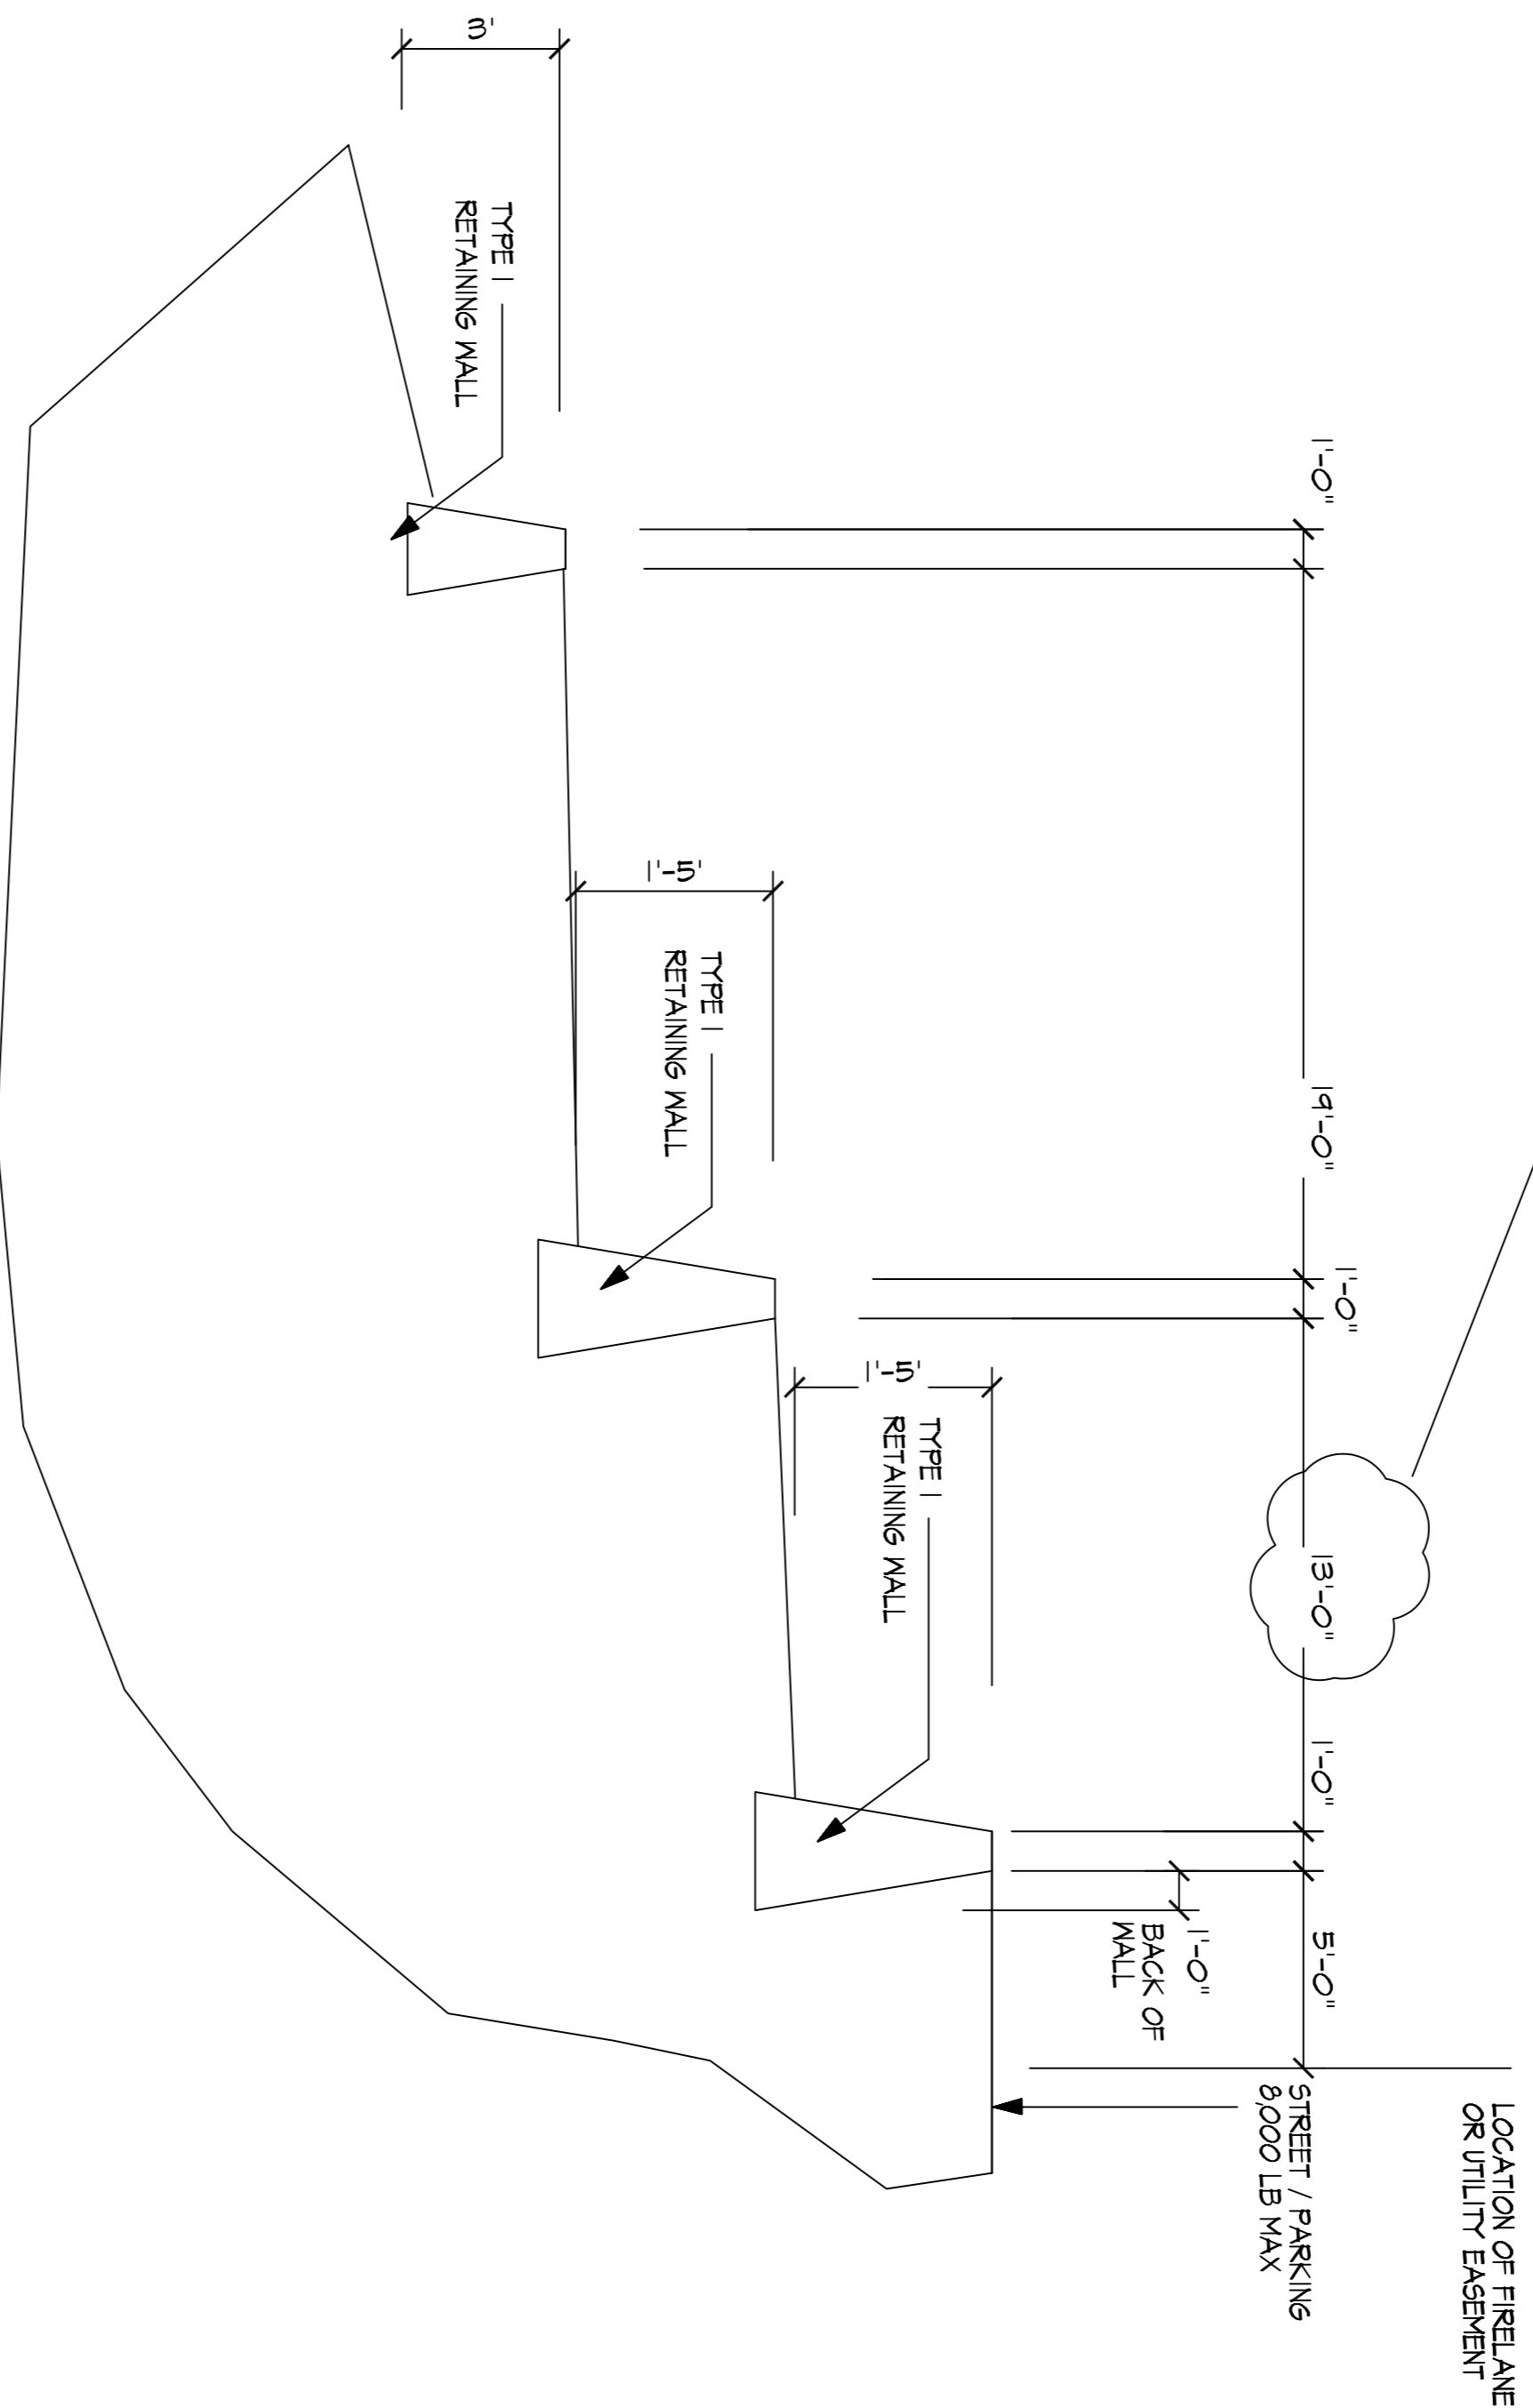

LOCATION OF FIRELANE OR UTILITY EASEMENT

STREET / PARKING 8000 LB MAX

## G WALL SECTIONS

NO SCALE

The seal appearing on this document was authorized by Tony H. Childress, P.E. #12029 on 08/20/07. (Record Copy on file)

This document may not be changed from Tony H. Childress, P.E.



Childress Engineering Services, Inc.

2505 North Plano Road, Suite 1200  
Richardson, Texas 75082  
Office:(214) 451-6630 Fax:(214) 451-6631

CESGLOBAL.COM

REV	BY	DATE	DESCRIPTION
1	THC	08/17/07	REVISED WALL DESIGN

WILKINSON COMMONS  
LA JOLLA POINTE DRIVE AND I-30  
ROCKWALL, TEXAS  
RETAINING WALLS

PROJECT NO:  
DRAWN: TFC  
DATE: 08-04-07  
SCALE: 1/4" = 1'-0"  
DRAWING NO: