


CONSTRUCTION PLANS
WILLIS SEALOCK ADDITION
 CITY OF ROCKWALL, TEXAS

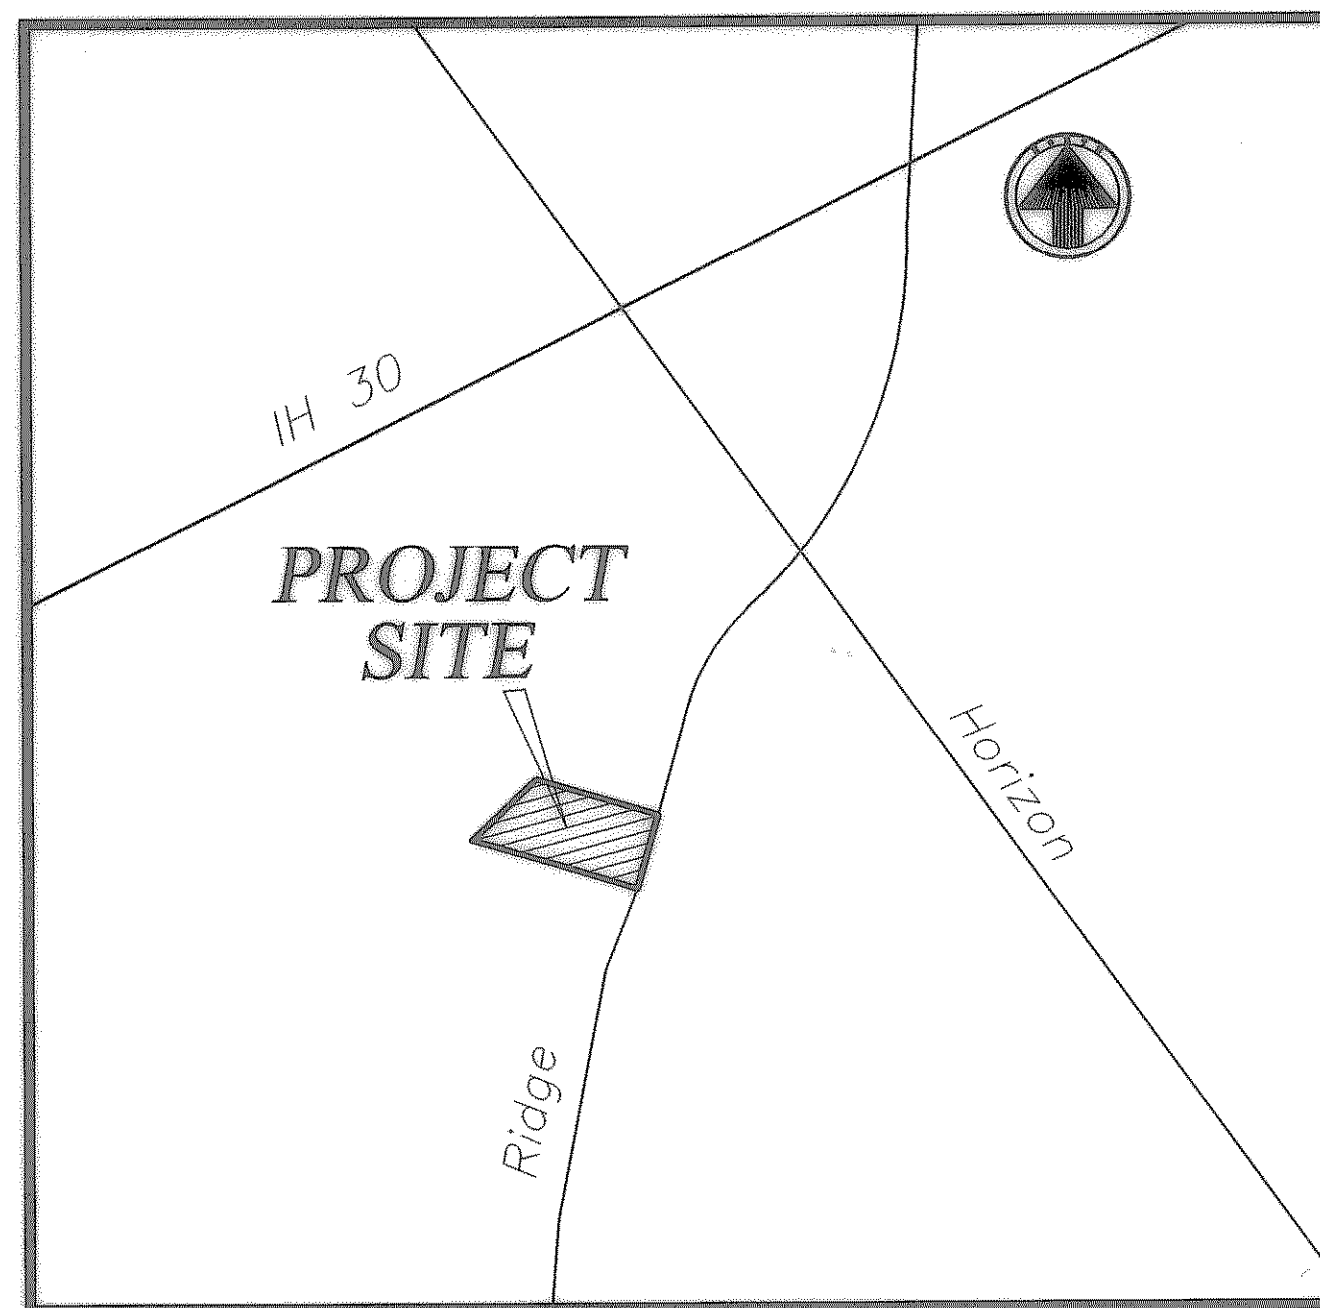


LOCATION MAP

INDEX of SHEETS

Sheet No.	Title
1	Cover Sheet
2	Re-Plat
3	Water & Sewer Plan
4	Paving Plan & Profile
5	Drainage Plan
6	Detention Pond
7	Grading Plan
8	S.W.P.P.P.
9	Treescape Plan
10	Landscape Plan

THE SEAL APPEARING ON THIS DOCUMENT WAS AUTHORIZED BY CHRISTOPHER R. CUNY, P.E. 65642

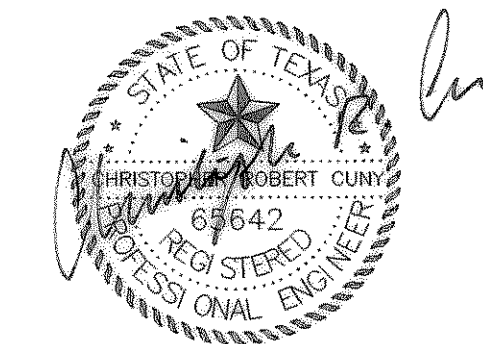

1-30-2003

Owner ~ Developer:
MICHAEL WILLIS
 2235 Ridge Road
 Rockwall, Texas 75087
 (972) 722-1846

CONSTRUCTION RECORD DRAWING

Engineer ~ Surveyor:

F.C. CUNY CORPORATION

4222 Rosehill Rd, Suite 7 • Garland, Texas 75043 • (972) 240-7700

JANUARY, 2003