

NOTE: MAINTENANCE OF DETENTION POND SHALL BE THE RESPONSIBILITY OF THE WILLIS SEALOCK ADDITION PROPERTY OWNER'S ASSOCIATION.

0+74.93 LINE "A"  
CONST. 10' CURB INLET  
T.C. 545.20  
F.L. 541.20


0+36.80 LINE "A"  
CONST. 45' ELBOW

0+00 LINE "A"  
CONST. TYPE "B" HDWL  
BEGIN 18" R.C.P.

0+00  
CONN. TO EX. INLET  
BEGIN 15" R.C.P.  
F.L. 15" 513.00

0+15.30  
CONN. 15" R.C.P. TO POND WALL  
W/RESTRICTOR PLATE  
OPENING IN WALL  
F.L. 15" 520.48

SSMH  
Top=540.90'  
FL=530.20'

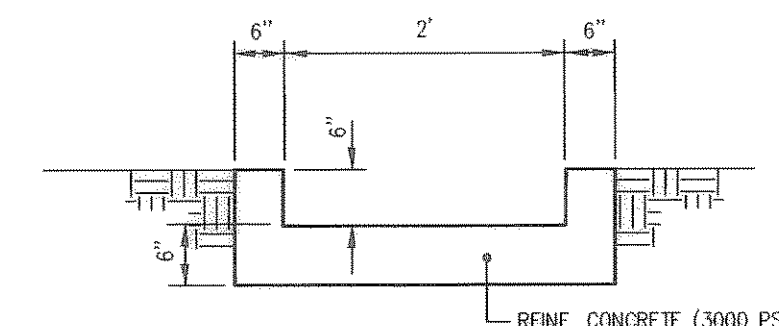

Flume Detail  
n.t.s.

LEGEND

- PROP. DRAINAGE AREA ID
- PROP. RUNOFF, Q CFS
- FLOW DIRECTION
- PROP. STORM SEWER W/ INLET
- EX. CONTOURS
- DRAINAGE DIVIDE

0+00 LINE "A"  
CONST. TYPE "B" HDWL  
BEGIN 18" R.C.P.

0+00  
CONN. TO EX. INLET  
BEGIN 15" R.C.P.  
F.L. 15" 513.00

0+15.30  
CONN. 15" R.C.P. TO POND WALL  
W/RESTRICTOR PLATE  
OPENING IN WALL  
F.L. 15" 520.48

0+74.93 LINE "A"  
CONST. 10' CURB INLET  
T.C. 545.20  
F.L. 541.20

0+36.80 LINE "A"  
CONST. 45' ELBOW

0+00 LINE "A"  
CONST. TYPE "B" HDWL  
BEGIN 18" R.C.P.

0+00  
CONN. TO EX. INLET  
BEGIN 15" R.C.P.  
F.L. 15" 513.00


0+15.30  
CONN. 15" R.C.P. TO POND WALL  
W/RESTRICTOR PLATE  
OPENING IN WALL  
F.L. 15" 520.48

0+74.93 LINE "A"  
CONST. 10' CURB INLET  
T.C. 545.20  
F.L. 541.20

0+36.80 LINE "A"  
CONST. 45' ELBOW

0+00 LINE "A"  
CONST. TYPE "B" HDWL  
BEGIN 18" R.C.P.

0+00  
CONN. TO EX. INLET  
BEGIN 15" R.C.P.  
F.L. 15" 513.00

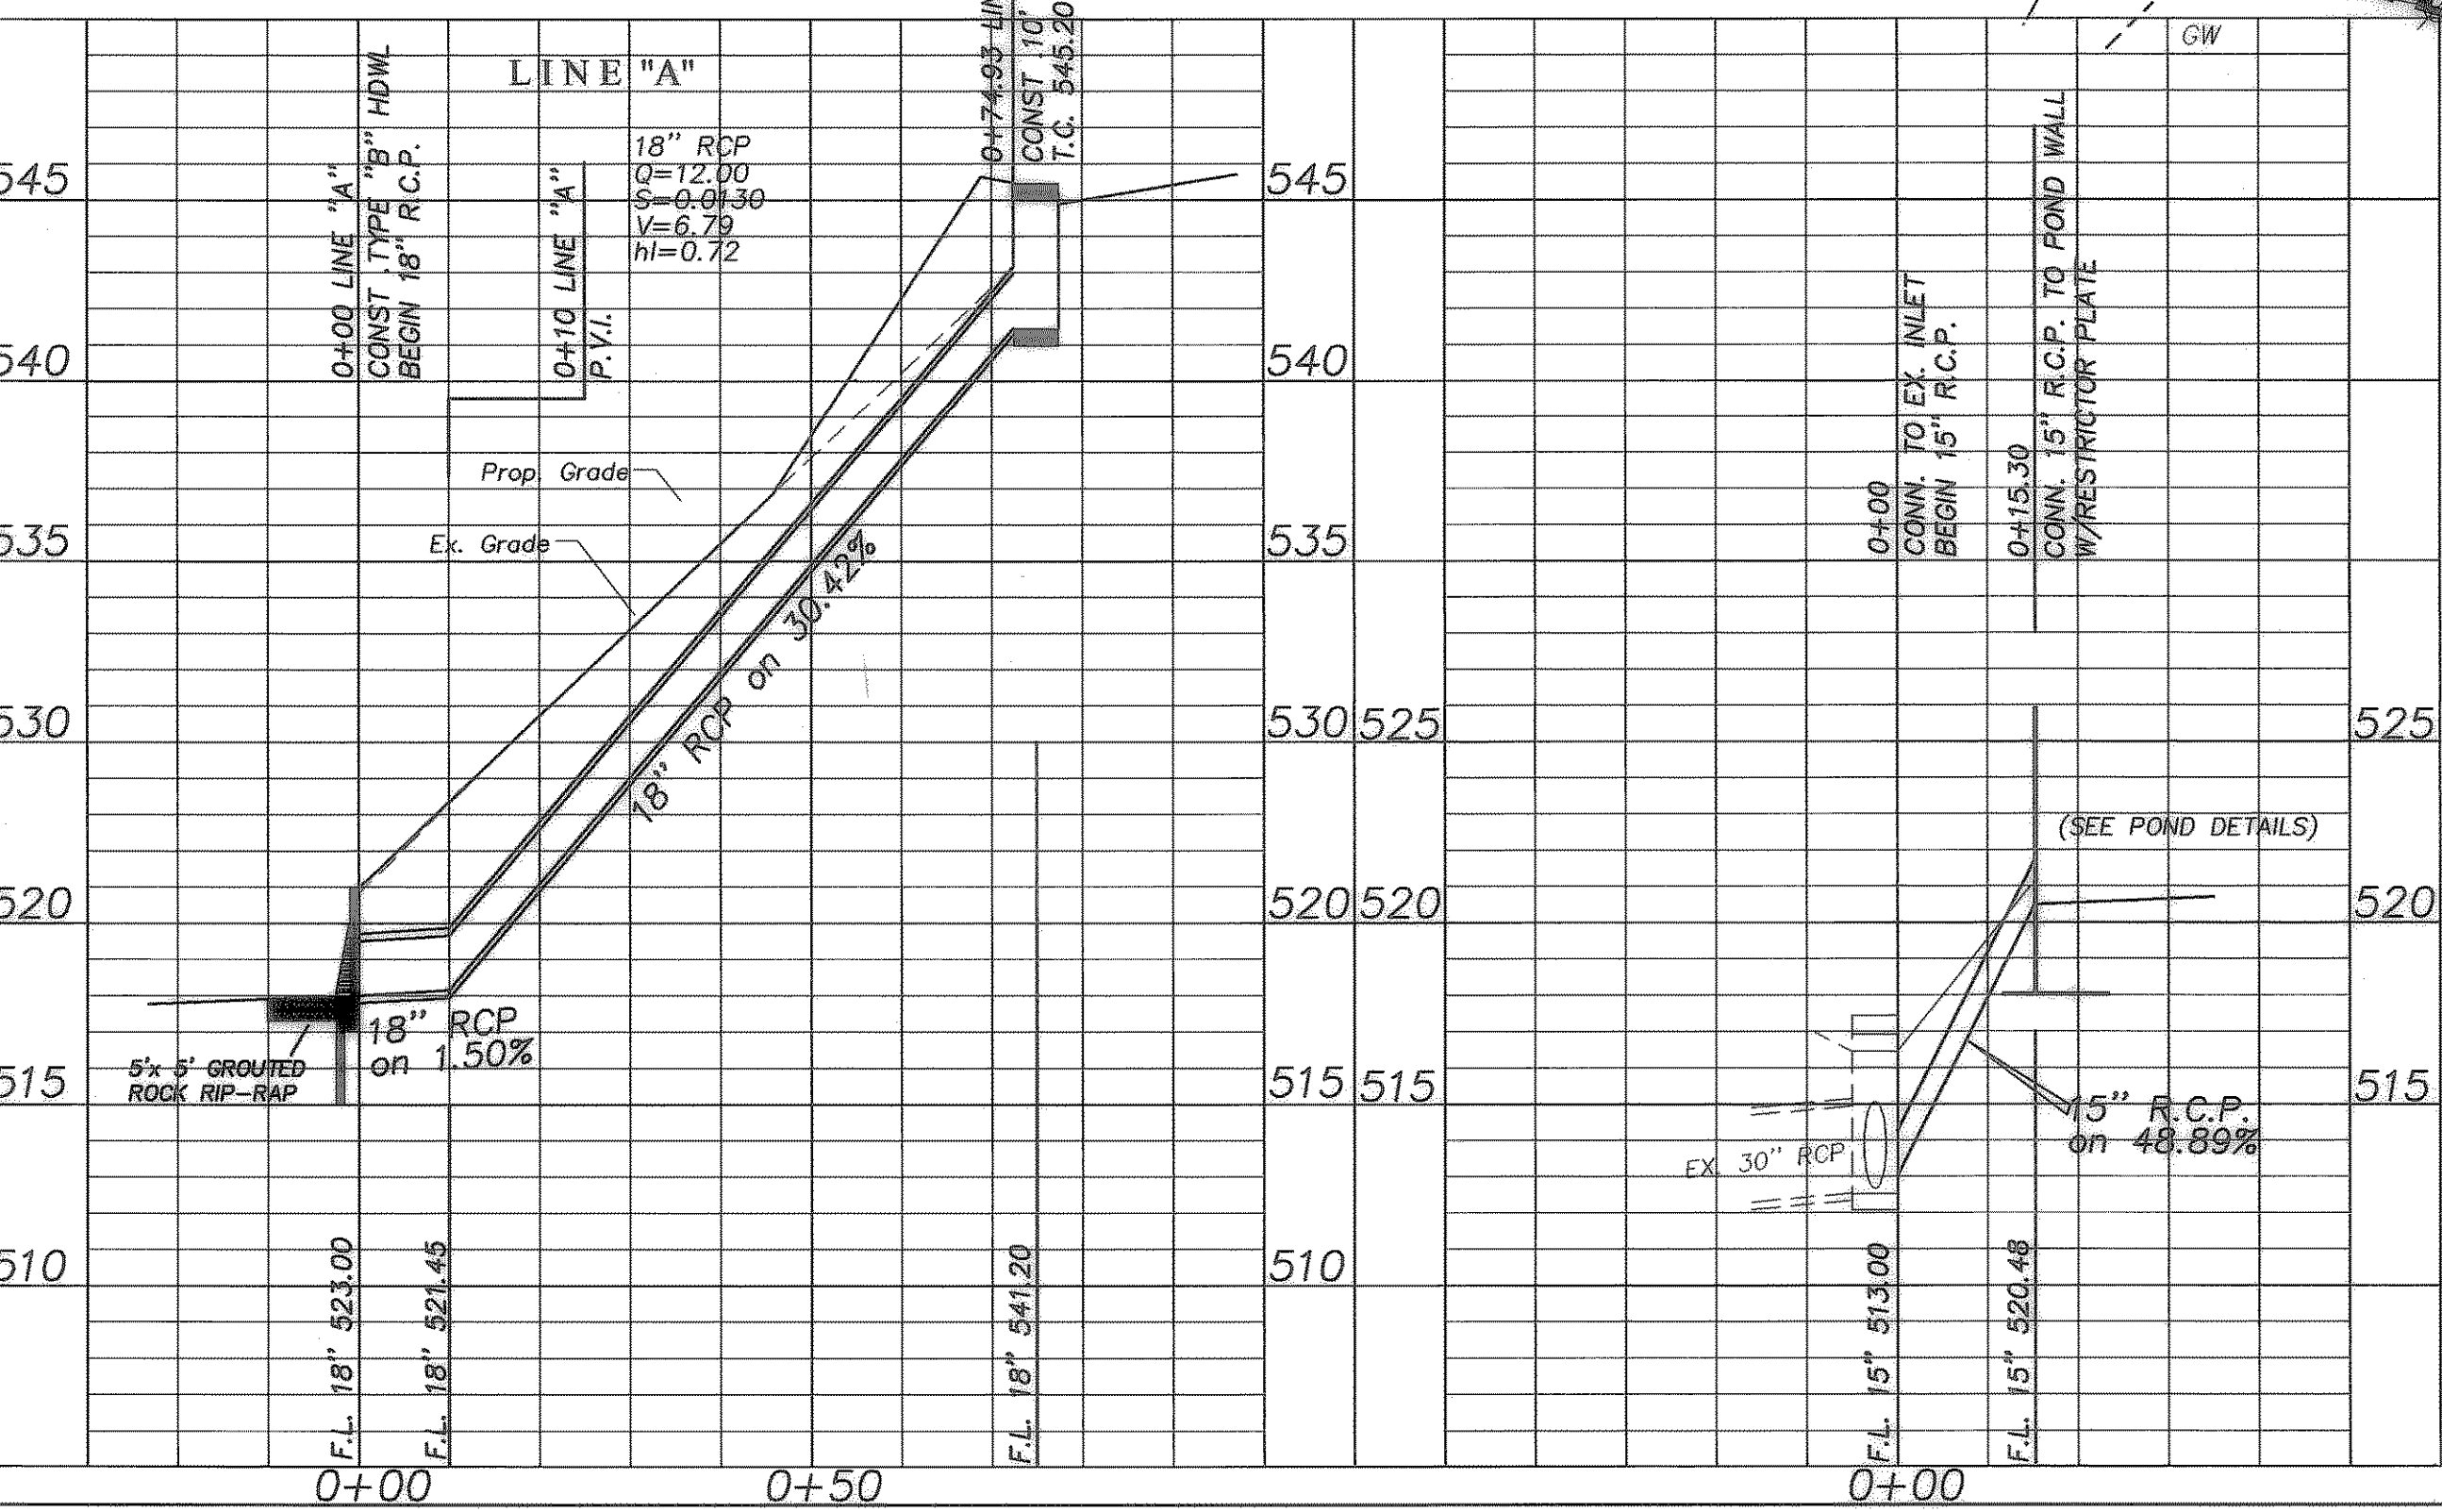

NOTE: SITE PLAN FOR LOT 3 NOT APPROVED AT THIS TIME.


NOTE: DRAINAGE AREAS "C" & "D" WERE DESIGNED TO REMAIN AS UNDEVELOPED AREAS. PROPERTY OWNER AGREES THAT NO DEVELOPMENT IN THIS AREA IS TO BE DONE WITHOUT MODIFICATIONS TO OR ADDITION OF DETENTION FACILITIES.

PROP. DRAINAGE AREA CALCULATIONS

Area ID	Acres	Intensity	INTENSITY <sub>Dev</sub>	C <sub>Ex</sub>	C <sub>Dev</sub>	Q <sub>100 Ex</sub>	Q <sub>100 Dev</sub>
A	1.11	8.30	9.80	0.35	0.90	3.22	4.79
B	0.34	9.80	9.80	0.90	0.90	3.00	3.00
C	0.26	8.30	8.30	0.35	0.35	0.76	0.76
D	0.23	8.30	8.30	0.35	0.35	0.67	0.67

BENCHMARK:  
RAILROAD SPIKE EMBEDDED IN THE EAST SIDE OF POWER POLE LOCATED AT THE NORTHWEST CORNER OF CEMETERY ROAD AND F.M. 740 (RIDGE ROAD)

THE SEAL APPEARING ON THIS DOCUMENT WAS AUTHORIZED BY CHRISTOPHER R. CUNY, P.E. 65642

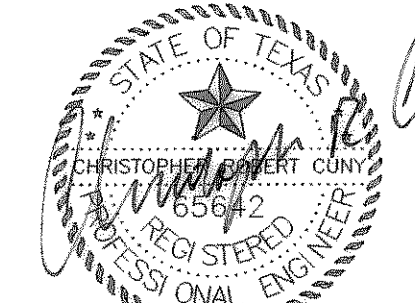

1-30-2003

CONSTRUCTION RECORD DRAWING

REVISIONS		REVISED CUL-DE-SAC 8-22-02	
DRAINAGE PLAN			
<b>WILLIS SEALOCK ADDITION</b>			
CITY OF ROCKWALL, ROCKWALL COUNTY, TEXAS			
Michael Willis			
2235 Ridge Road • Rockwall, Texas 75087 • (972) 722-1846			
<b>F.C. CUNY CORPORATION</b>			
4222 Rosehill Rd, Suite 7 • Garland, Texas 75043 • (972) 240-7700			
Drawn By:	Checked By:	Date:	Scale:
DM	C.C.	01/03	H: 1"=20' V: 1"=5'
Project No.:	Sheet No.:		
01-000	5 of 10		