

SSMP  
Top = 540.90'  
FL = 530.20'

GUT 544.70

CEMETERY ROAD


RIDGE ROAD  
(F.M. HIGHWAY NO. 740)

NOTE: SITE PLAN FOR LOT 3  
NOT APPROVED AT  
THIS TIME.

- LEGEND**
- EXIST. CONTOUR
  - PROP. CONTOUR
  - SPOT ELEVATION
  - FLOW DIRECTION

BENCHMARK:  
RAILROAD SPIKE EMBEDDED IN THE EAST SIDE  
OF POWER POLE LOCATED AT THE NORTHWEST CORNER  
OF CEMETERY ROAD AND F.M. 740 (RIDGE ROAD)

THE SEAL APPEARING ON THIS  
DOCUMENT WAS AUTHORIZED BY  
CHRISTOPHER R. CUNY, P.E. 65642

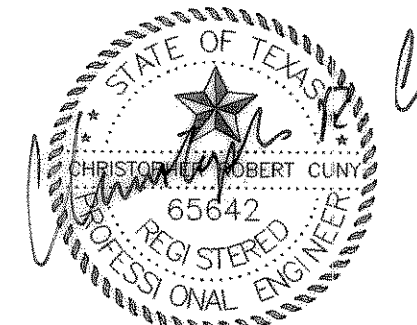

1-30-2003

**CONSTRUCTION RECORD DRAWING**

REVISIONS		REVISED CUL-DE-SAC 8-22-02	
GRADING PLAN			
<b>WILLIS SEALOCK ADDITION</b>			
CITY OF ROCKWALL, ROCKWALL COUNTY, TEXAS			
Michael Willis 2235 Ridge Road • Rockwall, Texas 75087 • (972) 722-1846			
<b>F.C. CUNY CORPORATION</b>			
4222 Rosehill Rd, Suite 7 • Garland, Texas 75043 • (972) 240-7700			
Drawn By:	Checked By:	Date:	Scale:
DM	C.C.	07/03	H:1"=20'
Project No.:	Sheet No.:		
01-000	7 of 10		