




DRAINAGE TABLE

DRAINAGE AREA NO.	ACRES	T.C.	C	Q 100 YR.	Q 100 YR.	SUM Q 100 YR.
1	8.39	10	0.35	9.8	28.78	28.78
2	5.52	10	0.35	9.8	18.93	18.93

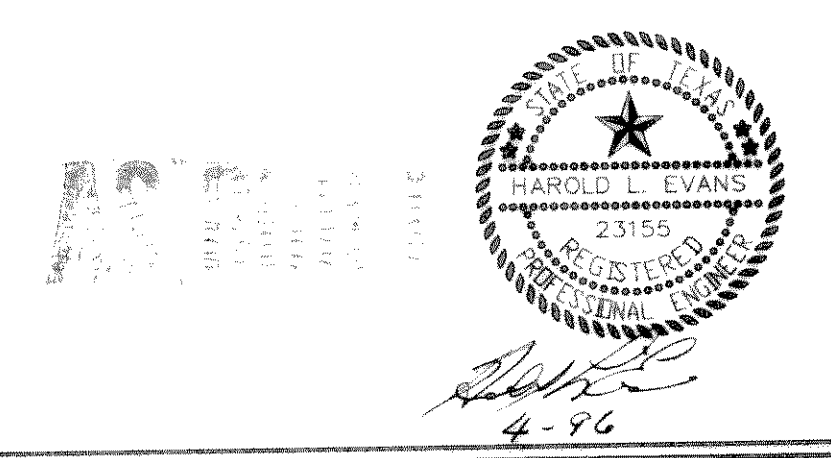

REVISION DESCRIPTION	DATE	SCALE	DESIGN	DRAWN
	4/29/96	1" = 100'	H.L.E.	

**HAROLD L. EVANS**  
CONSULTING ENGINEER  
P.O. BOX 28355  
2331 GUS THOMASSON ROAD, SUITE 102  
DALLAS, TEXAS 75228, (214) 328-8133

**DRAINAGE AREA MAP**

---

**WILLOWCREST ESTATES**  
**COUNTY OF ROCKWALL**

SHEET NO.  
4  
5  
JOB NO.  
9624