


RECORD DRAWING

B.M. "a" Cut on Top of Curb N.W. Corner of Windmill Ridge Dr. & Holland Court. ELEV. = 530.71

B.M. "d" Iron pin set in 10" dia. cottonwood tree 134' S.N.E. of Fear E on lot 19, 81K F of this Add'n. ELEV. = 520.75

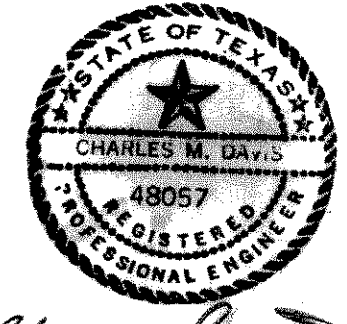

Revised 5-21-84 by GM

**SANI. SEWER PROFILES**  
**WINDMILL RIDGE ESTATES NO. 2A**  
**ROCKWALL, TEXAS**

John C. Gibson Co., Inc. - Consulting Engineers  
 9510 Military Parkway - Dallas, Texas 75227

DESIGN	DRAWN	DATE	SCALE	NOTES	FILE	NO.
J.C.G. Co. Inc.	G.M.	Nov. 1983	1" = 100'	G.M.	Windmill Ridge Estates No. 2A	9