


Connection Detail

Note: Exist. 6" A.C. Line is to be removed from Sta. 0+00 to Sta. 4+57.

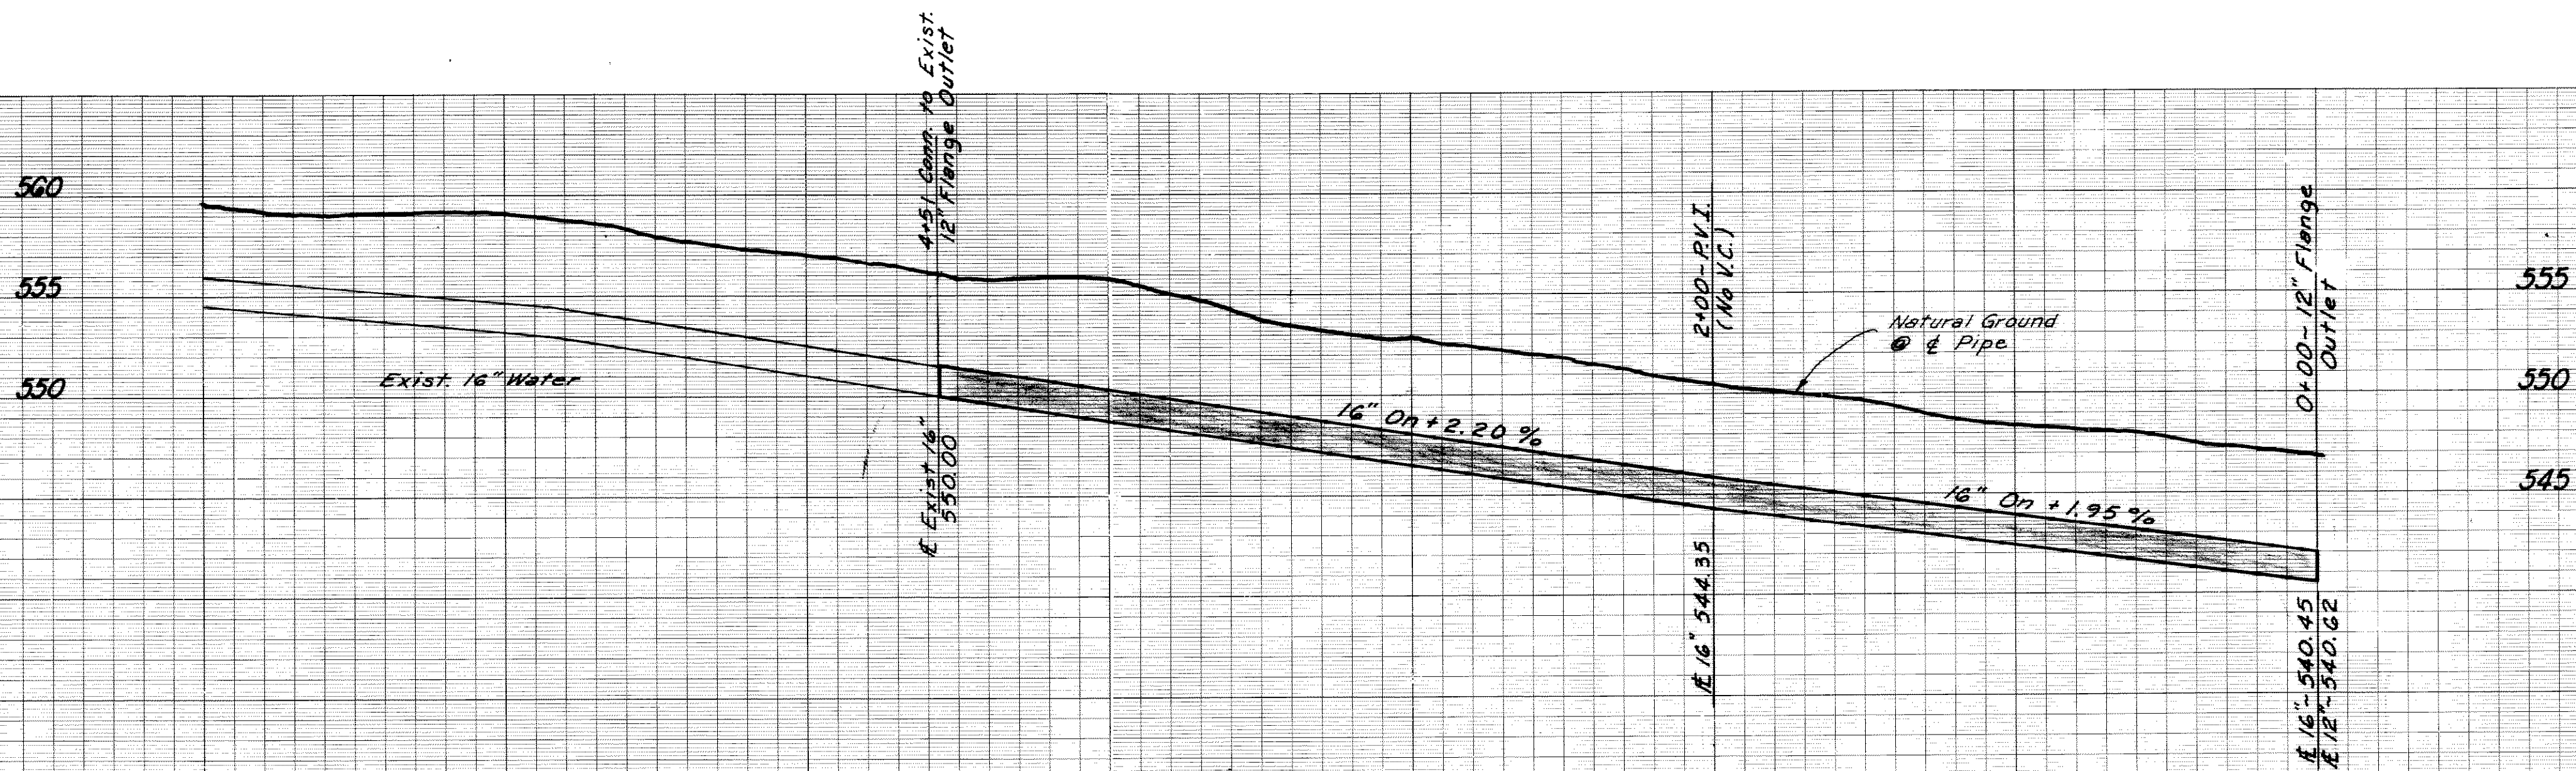


RECORD DRAWING

OFFSITE WATER PLAN
WINDMILL RIDGE ESTATES NO. 2A
ROCKWALL, TEXAS

John C. Gibson Co Inc. - Consulting Engineers
 9510 Military Parkway Dallas, Texas 75227

DESIGN	DRAWN	DATE	SCALE	NOTES	FILE	NO.
J.C.G. Co Inc.	Bev		H:1"=40' V:1"=6'	Windmill Ridge Estates No. 2A	3	3

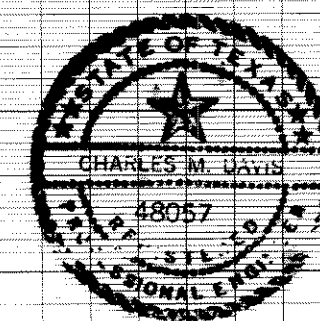

Charles M. Wain