


RECORD DRAWING

Revised Grade 4-22-86

SANI SEWER PROFILES						
WINDMILL RIDGE ESTATES NO. 3A						
ROCKWALL, TEXAS						
John C. Gibson Co. Inc. Consulting Engineers						
9510 Military Parkway Dallas, Texas 75227						
DESIGN	DRAWN	DATE	SCALE	NOTES	FILE	NO.
J.C.G.Co. Inc.	R.J.H.		H:1"=100' V:1"=6'	R.D.	Windmill Ridge	21

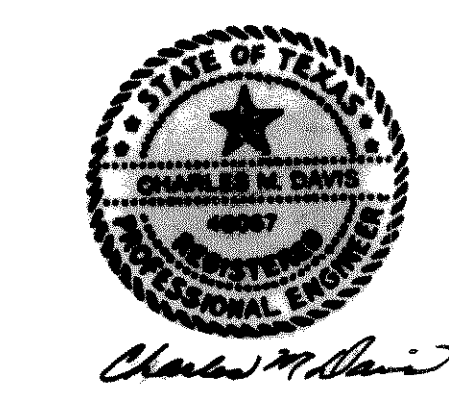

Charles H. Davis