


B.M.
SQUARE ON TOP OF 10" INLET ON N.W. SIDE
ROCKWALL PARKWAY, 85' S.W. OF CENTERLINE
OF AUTUMN TRAIL.
ELEVATION = 535.21

B.M.
CENTERLINE OF TOP OF 15" INLET ON N.W. SIDE
OF ROCKWALL PARKWAY, 140' N.E. OF WOODCREEK
DRIVE.
ELEVATION = 527.25

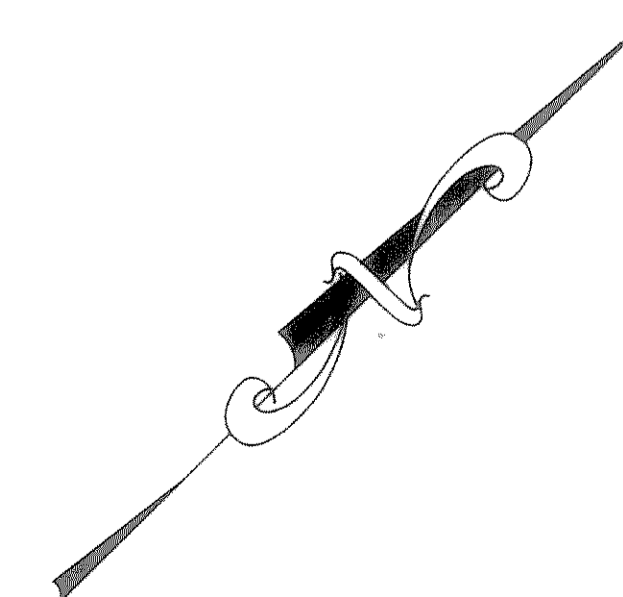

AS-BUILT

HAROLD L. EVANS CONSULTING ENGINEER P.O. BOX 28355 2331 GUS THOMASSON ROAD, SUITE 102 DALLAS, TEXAS 75228. (214) 328-8133				GRADING PLAN		SHEET NO. 10	
				WINDMILL RIDGE NO. 3B CITY OF ROCKWALL ROCKWALL COUNTY, TEXAS		JOB NO. 9375	
REVISION DESCRIPTION		DATE 8/12/84	SCALE 1" = 40'	DESIGN H.L.E.	DRAWN E.B.B.		