




PARKWAY COURT

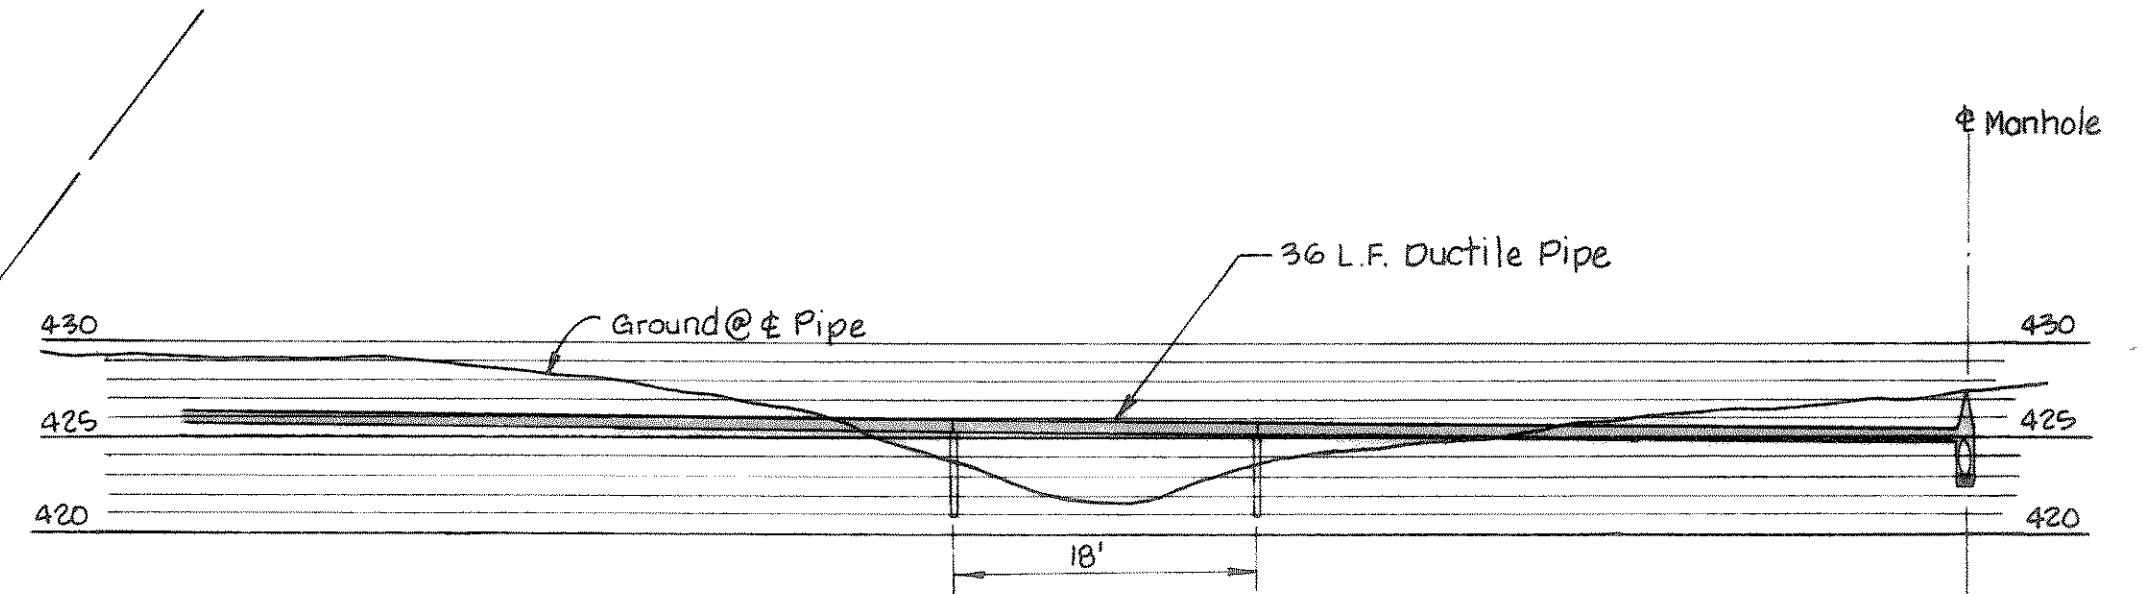


PROPOSED AERIAL CROSSING PROFILE

1" = 10' Horiz.
1" = 10' Vert.

Monhole
E. 424.98
E. 423.75

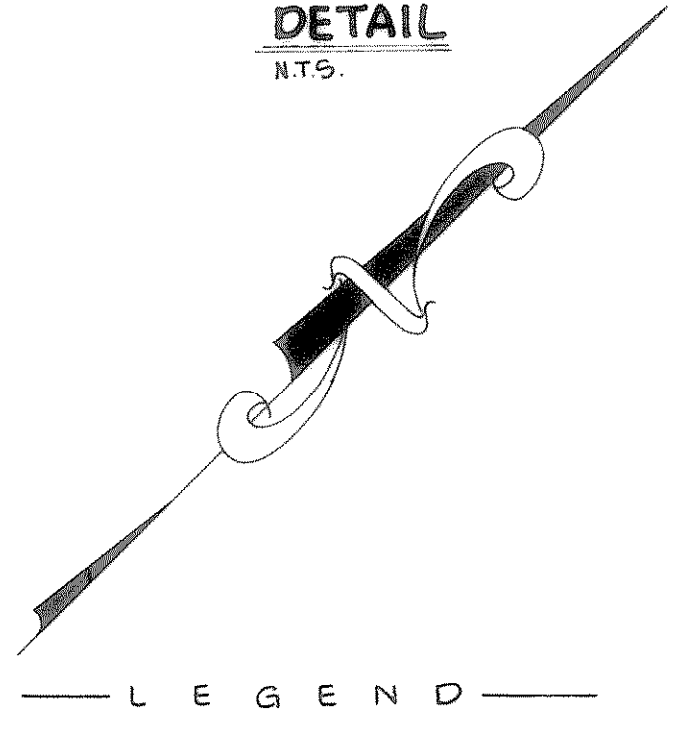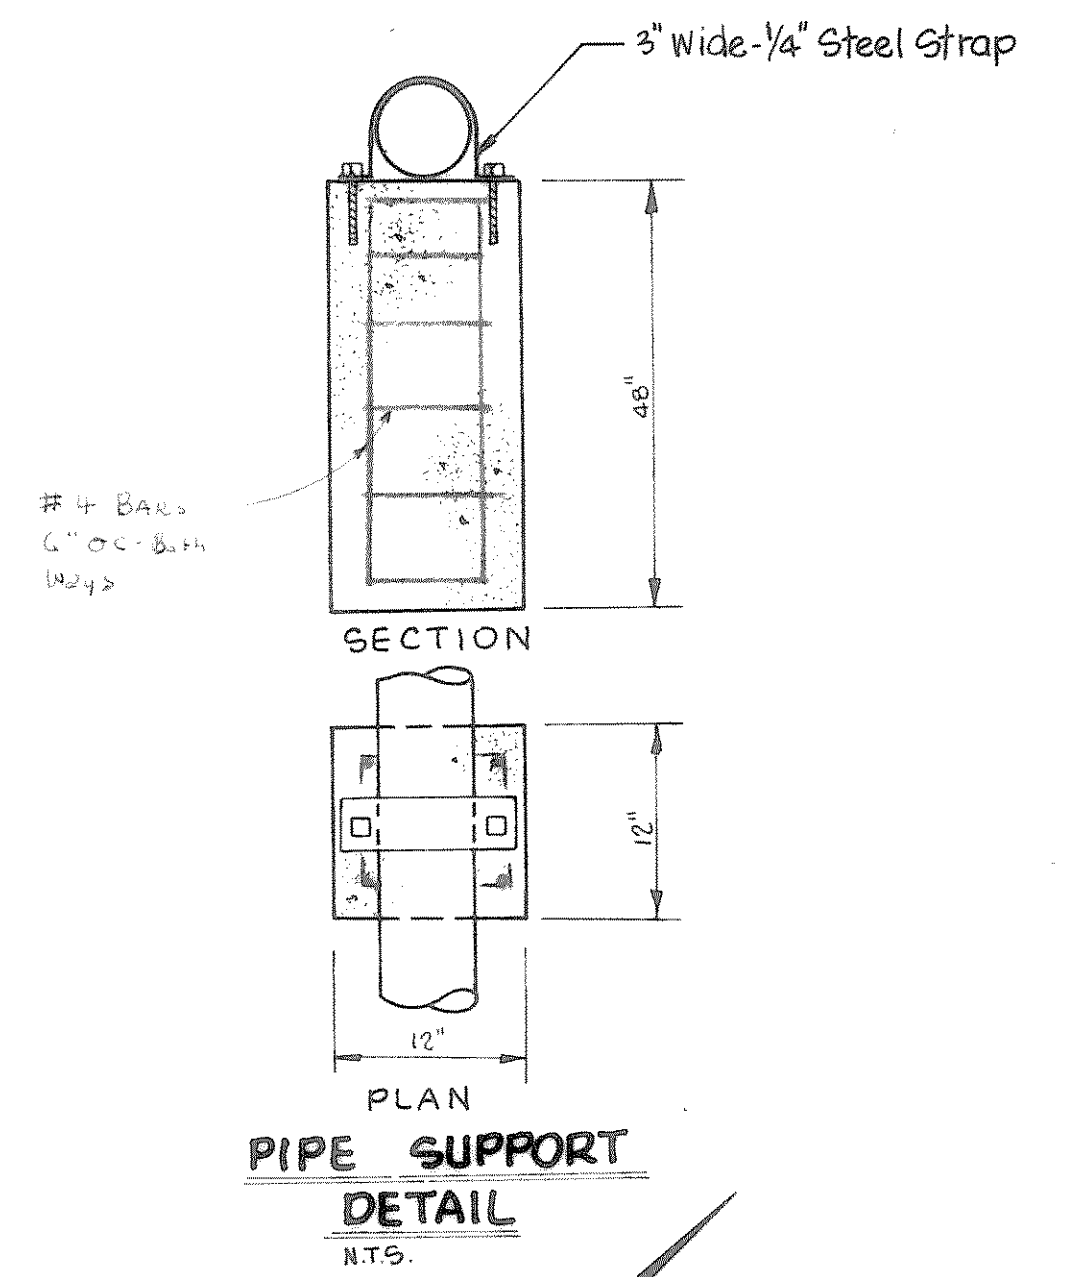

AS-BUILT

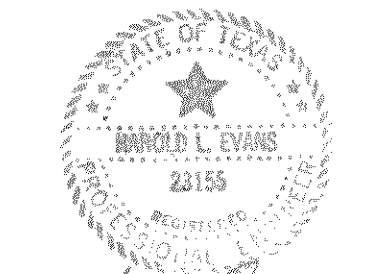

HAROLD L. EVANS CONSULTING ENGINEER 2331 GUS THOMASSON ROAD, SUITE 102 DALLAS, TEXAS 75228. (214) 328-8133				SHEET NO. 11/0 11/14	
GRADING PLAN WINDMILL RIDGE NO. 3B CITY OF ROCKWALL ROCKWALL COUNTY, TEXAS					
REVISION DESCRIPTION	DATE 4/6/94	SCALE 1" = 10'	DESIGN H.L.E.	DRAWN	JOB NO. 9375