

F:\dms\20129\AS-BUILT\129\129.dwg Tue Sep 25 11:09:49 2001 B. Johnson
 HP Designer: 1050C Hewlett-Packard HP-GL/2 devices, ADI 4.3 (v4.5) - 19990922

CONTRACTOR SHALL VERIFY DEPTH OF EX. SAN. SWR FORCE MAINS PRIOR TO BEGINNING DIRT WORK

SEE NTMWD GENERAL NOTES ON COVER SHEET


NO CURB @ STREET CONNECTION CONSTRUCT KEYWAY JOINT FOR FUTURE CURB CONSTRUCTION

CAUTION!!!!!!
EXISTING UTILITIES
 EXISTING UTILITIES AND UNDERGROUND FACILITIES INDICATED ON THESE PLANS HAVE BEEN LOCATED FROM REFERENCE INFORMATION. IT SHALL BE THE RESPONSIBILITY OF THE CONTRACTOR TO VERIFY BOTH HORIZONTALLY AND VERTICALLY THE LOCATION OF ALL EXISTING UTILITIES AND UNDERGROUND FACILITIES PRIOR TO CONSTRUCTION. TO TAKE NECESSARY PRECAUTIONS IN ORDER TO PROTECT ALL FACILITIES ENCOUNTERED, THE CONTRACTOR SHALL PRESERVE AND PROTECT ALL EXISTING UTILITIES FROM DAMAGE DURING CONSTRUCTION.

NOTE:
 CONSTRUCT BARRIER FREE RAMPS AT ALL INTERSECTIONS AS PER CITY STANDARDS.

BENCH MARK #1
 BRONZE DISC AT SOUTHEAST CORNER OF SERVICE ROAD OF I.H. 30 AND MIMS ROAD.
 ELEV. = 566.25

BENCH MARK #1
 R.R. SPIKE IN POWER POLE 50'± NORTH OF TUBBS ROAD AND 300'± EAST OF TEXAS AVE.
 ELEV. = 531.57

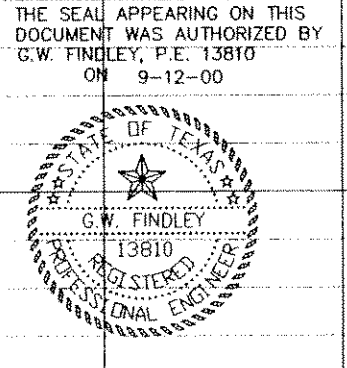

AS-BUILT
 ACCORDING TO CONTRACTORS RECORDS
C.W. Finley
 DATED: 9-25-01

PLAN & PROFILE - TUBBS ROAD					
WINDMILL RIDGE ESTATES PH. IV-B					
City of Rockwall, Rockwall County, Texas					
KPA CONSULTING, INC.					
14800 Quorum Drive ~ Suite 500 ~ Dallas, Texas 75248					
DESIGN	DRAWN	DATE	SCALE	NOTES	FILE
G.W.F.	B.J.	12/14/00	1"=4' V 1"=40' H	K.P.A.	20129
					NO.
					4