
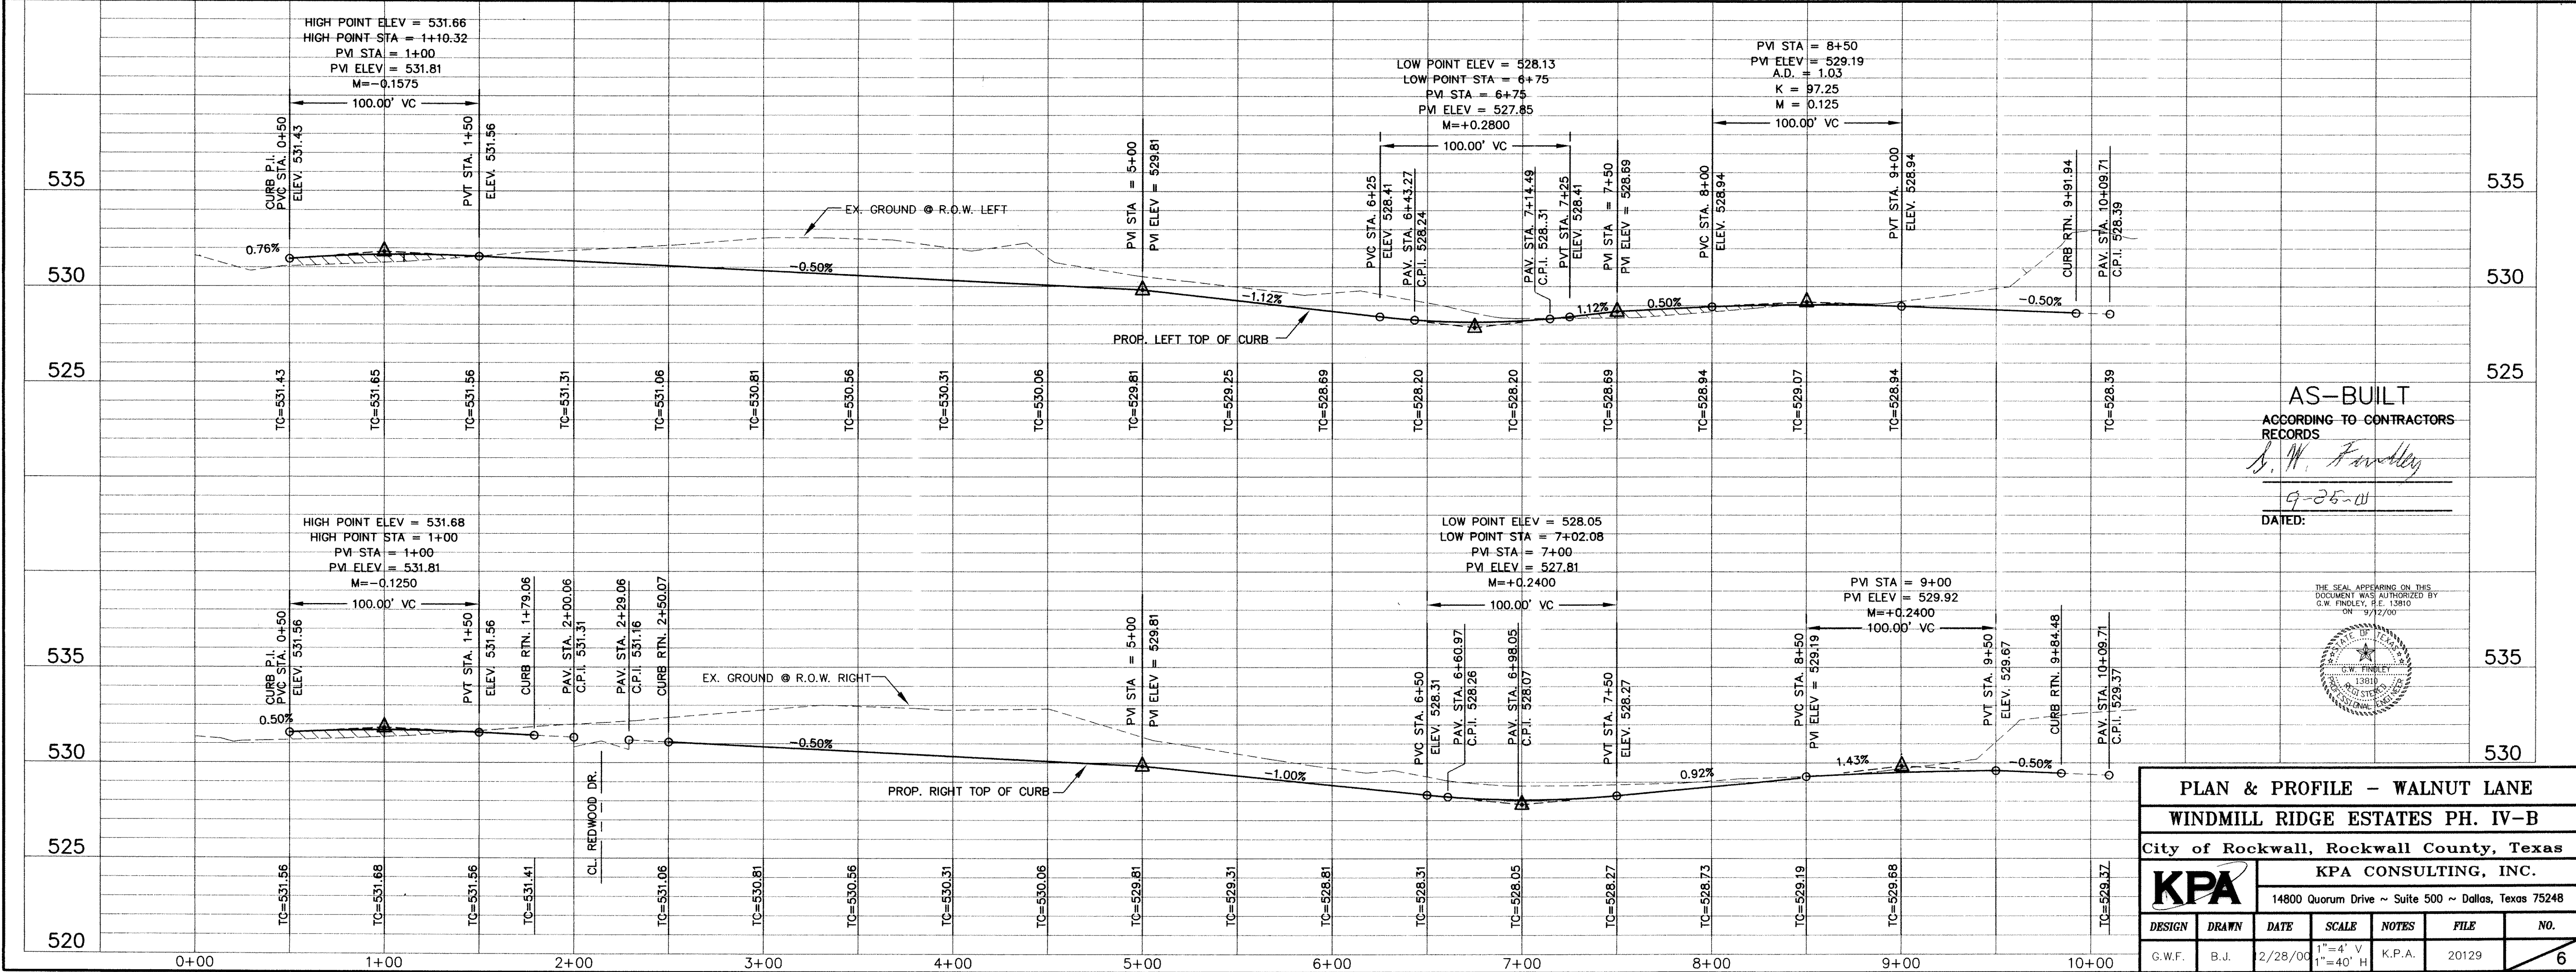



CAUTION!!!!
EXISTING UTILITIES

EXISTING UTILITIES AND UNDERGROUND FACILITIES INDICATED ON THESE PLANS HAVE BEEN LOCATED FROM REFERENCE INFORMATION. IT SHALL BE THE RESPONSIBILITY OF THE CONTRACTOR TO VERIFY BOTH HORIZONTALLY AND VERTICALLY THE LOCATION OF ALL EXISTING UTILITIES AND UNDERGROUND FACILITIES PRIOR TO CONSTRUCTION. TO TAKE NECESSARY PRECAUTIONS IN ORDER TO PROTECT ALL FACILITIES ENCOUNTERED. THE CONTRACTOR SHALL PRESERVE AND PROTECT ALL EXISTING UTILITIES FROM DAMAGE DURING CONSTRUCTION.

- BENCH MARK #1**
BRONZE DISC AT SOUTHEAST CORNER OF SERVICE ROAD OF I.H. 30 AND MIMS ROAD.
ELEV. = 566.25
- BENCH MARK #1**
R.R. SPIKE IN POWER POLE 50'± NORTH OF TUBBS ROAD AND 300'± EAST OF TEXAS AVE.
ELEV. = 531.37

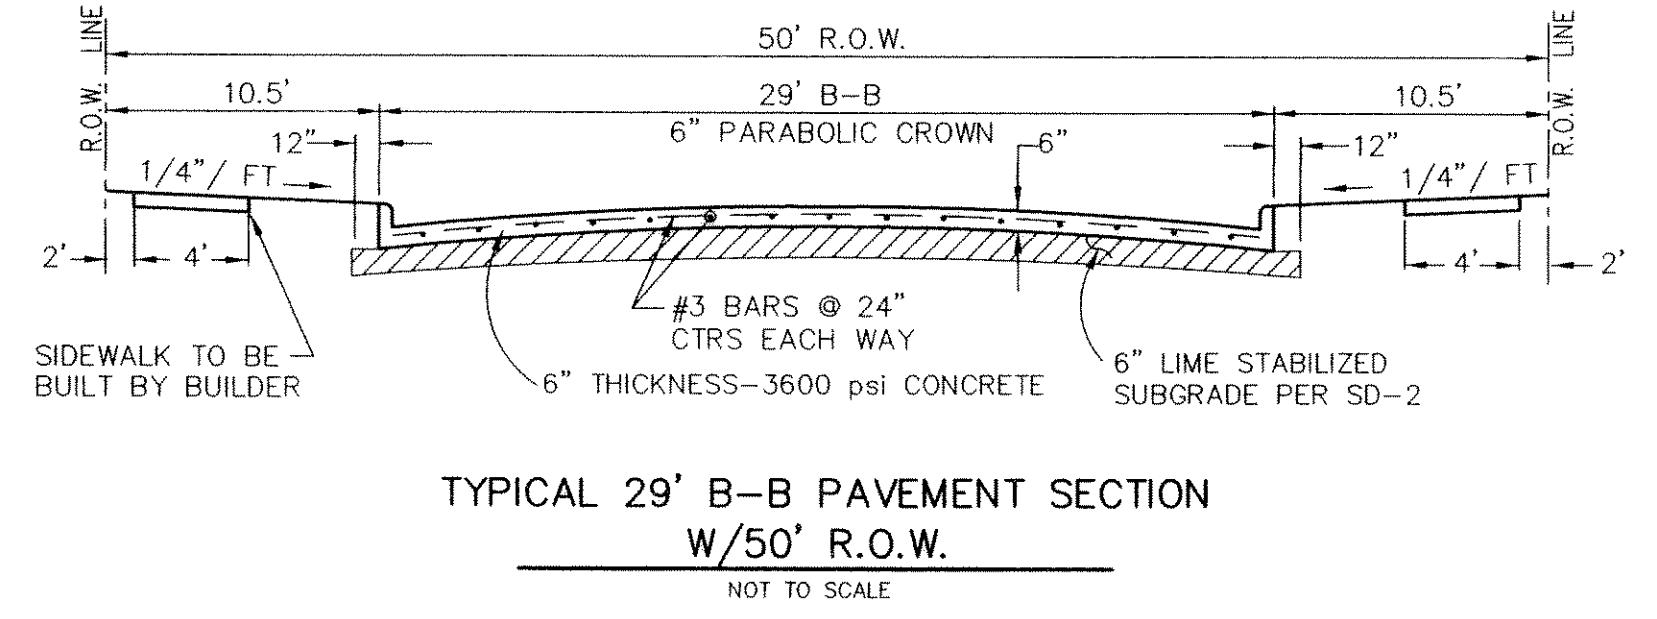

AS-BUILT
ACCORDING TO CONTRACTORS RECORDS
S. W. Finley
9-25-01
DATED:

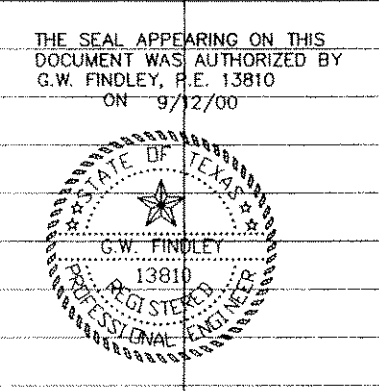

PLAN & PROFILE - WALNUT LANE
WINDMILL RIDGE ESTATES PH. IV-B
City of Rockwall, Rockwall County, Texas

KPA CONSULTING, INC.
14800 Quorum Drive ~ Suite 500 ~ Dallas, Texas 75248

DESIGN	DRAWN	DATE	SCALE	NOTES	FILE	NO.
G.W.F.	B.J.	2/28/00	1"=4' V 1"=40' H	K.P.A.	20129	6

F:\dwg\20129\MS_BILL\15\Perung\129_Pay_C.dwg Tue Sep 25 13:29:46 2001. B. Johnson
HP Designer: 1050C Hewlett-Packard HP-GL/2 devices. ADI 4 3 (V4.5) - 13990922