
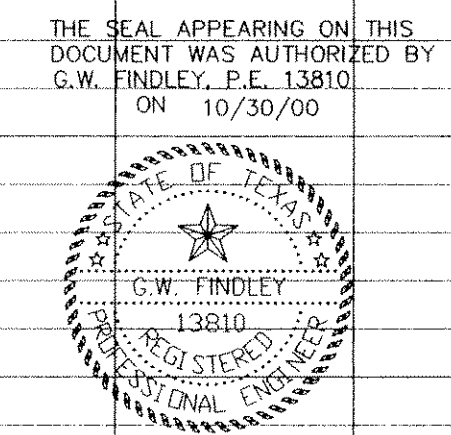
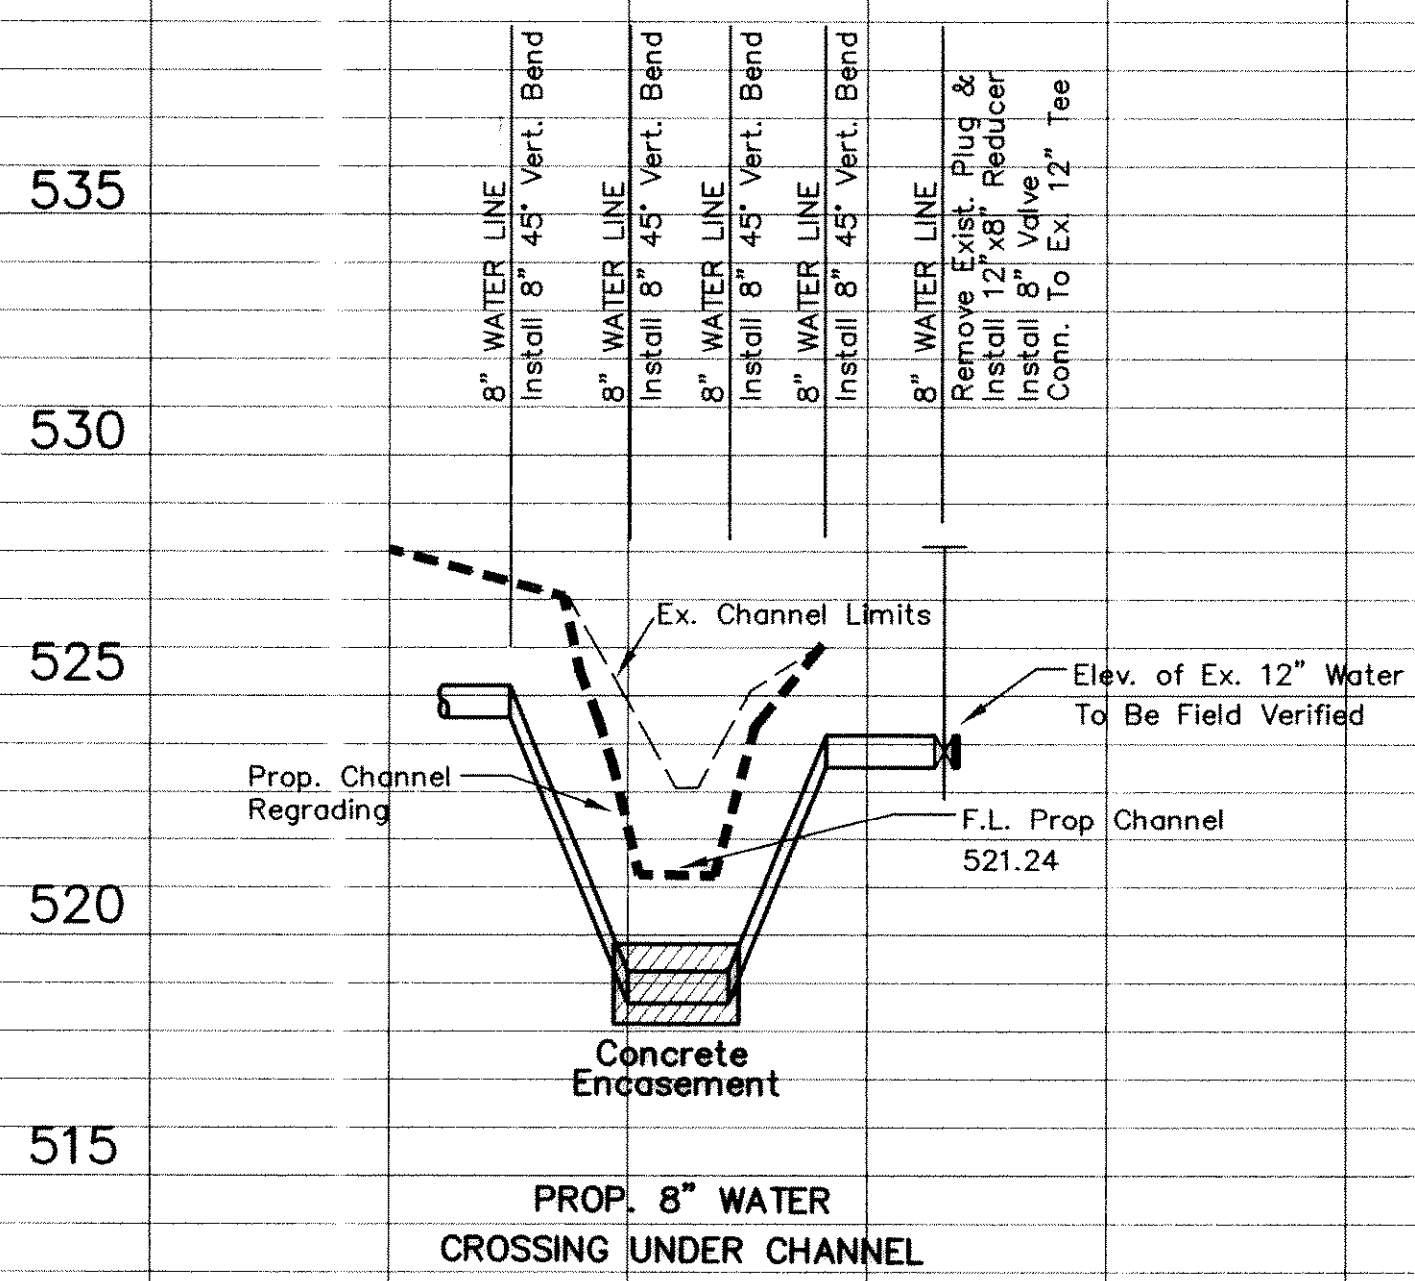


F:\0905\2012\AS-BUILT\ISWTR & SAN\125\_WAT\_PROF.dwg Tue Sep 25 14:37:54 2001 B. Johnson  
 HP DesignJet 1050C Hewlett-Packard HP-GL/2 devices, A01, 4.3 (1/4.5) - 15990922

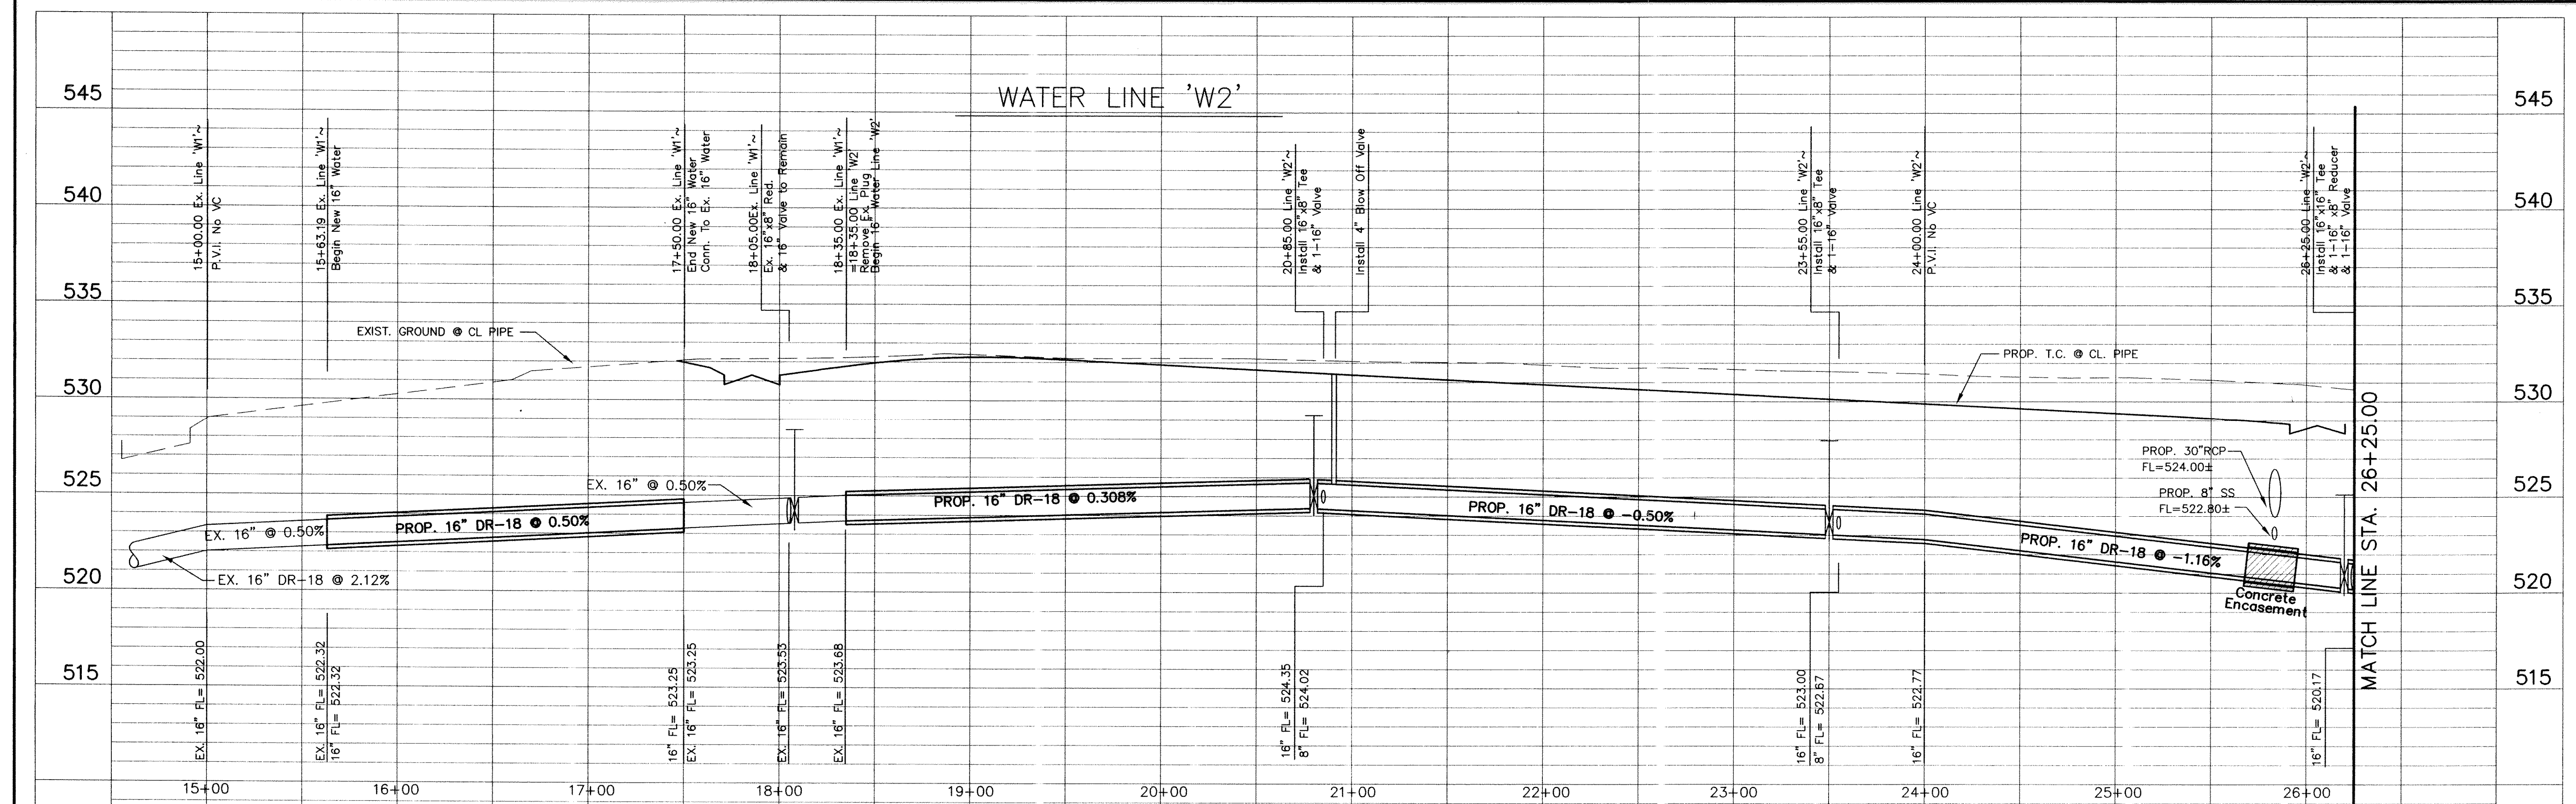

**AS-BUILT**  
 ACCORDING TO CONTRACTORS RECORDS  
*G.W. Findley*  
 DATED: 9-25-01

WATER PROFILES						
WINDMILL RIDGE ESTATES PHASE IV-B						
City Of Rockwall, Rockwall County, Texas						
KPA CONSULTING, INC.						
14800 Quorum Drive ~ Suite 500 ~ Dallas, Texas 75248						
DESIGN	DRAWN	DATE	SCALE	NOTES	FILE	NO.
G.W.F.	B.J.	01/09/01	1"=4' V 1"=40' H	K.P.A.	20129	24