


THE SEAL APPEARING ON THIS DOCUMENT WAS AUTHORIZED BY G.W. FINLEY, P.E. 13810 ON 9/25/01

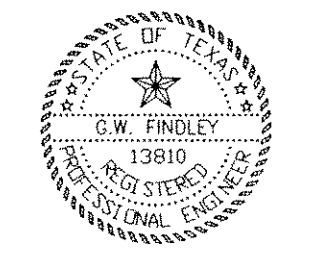

FLOOD STUDY CROSS-SECTIONS						
WINDMILL RIDGE ESTATES PH. IV-B						
City of Rockwall, Rockwall County, Texas						
KPA CONSULTING, INC.						
14800 Quorum Drive ~ Suite 500 ~ Dallas, Texas 75248						
DESIGN	DRAWN	DATE	SCALE	NOTES	FILE	NO.
G.W.F.	B.J.	2/12/00		K.P.A.	20129	28

AS-BUILT  
 ACCORDING TO CONTRACTORS RECORDS  
*G.W. Finley*  
 9-25-01  
 DATED: