


NOTE: WATER SERVICES ARE TO BE SINGLE SERVICES LOCATED IN CENTER OF LOT.


SEWER "LINE-B"  
 $\Delta = 45^\circ$   
 $R = 243.00'$   
 $L = 100.65'$   
 $C = 185.98'$

INSTALL 320 L.P.  
 8" PVC SEWER

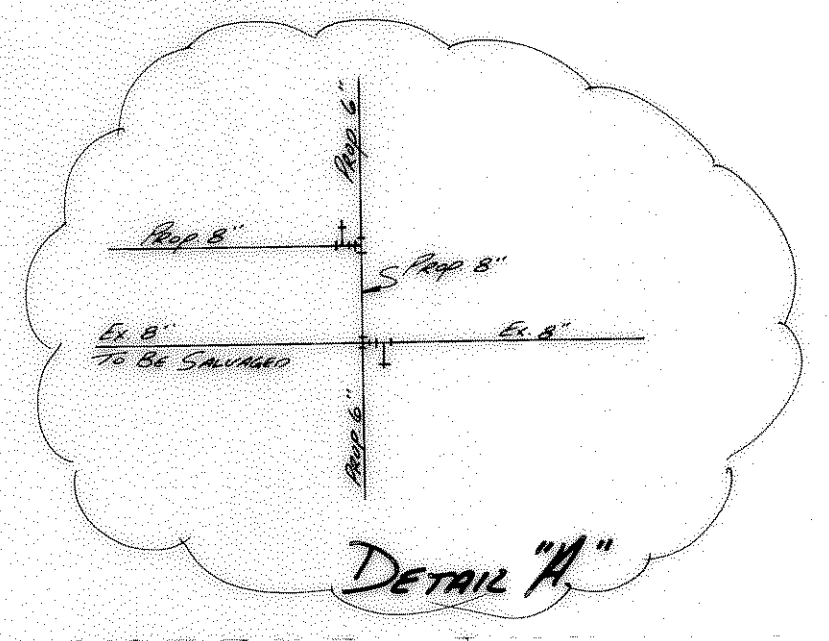

NORTH  
 SCALE 1" = 40'

PLANS REVISED BY HAROLD L. EVANS CONSULTING ENGINEER, 12-15-82

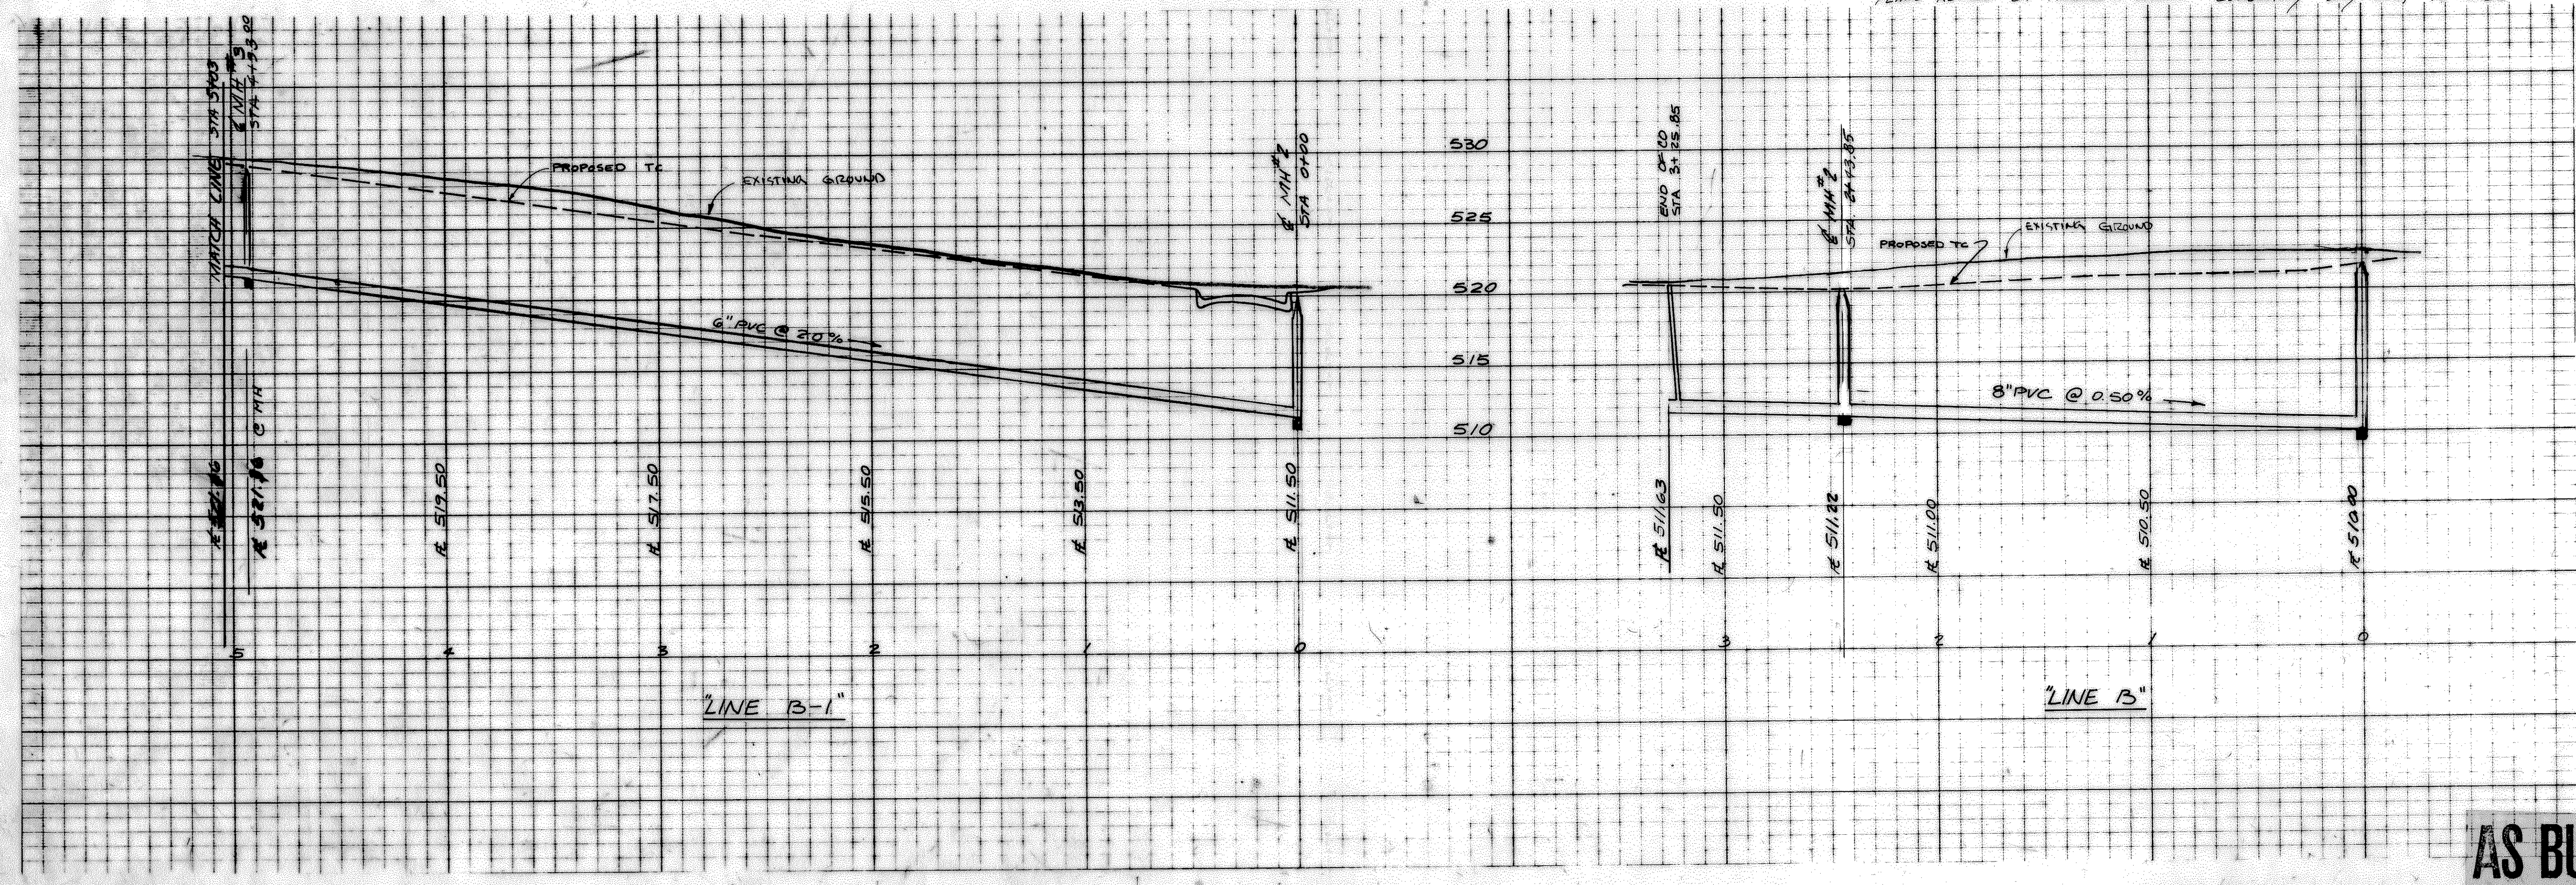

AS BUILT