



PLANS REVISED BY HAROLD L. EVANS CONSULTING ENGINEER, 12-15-82

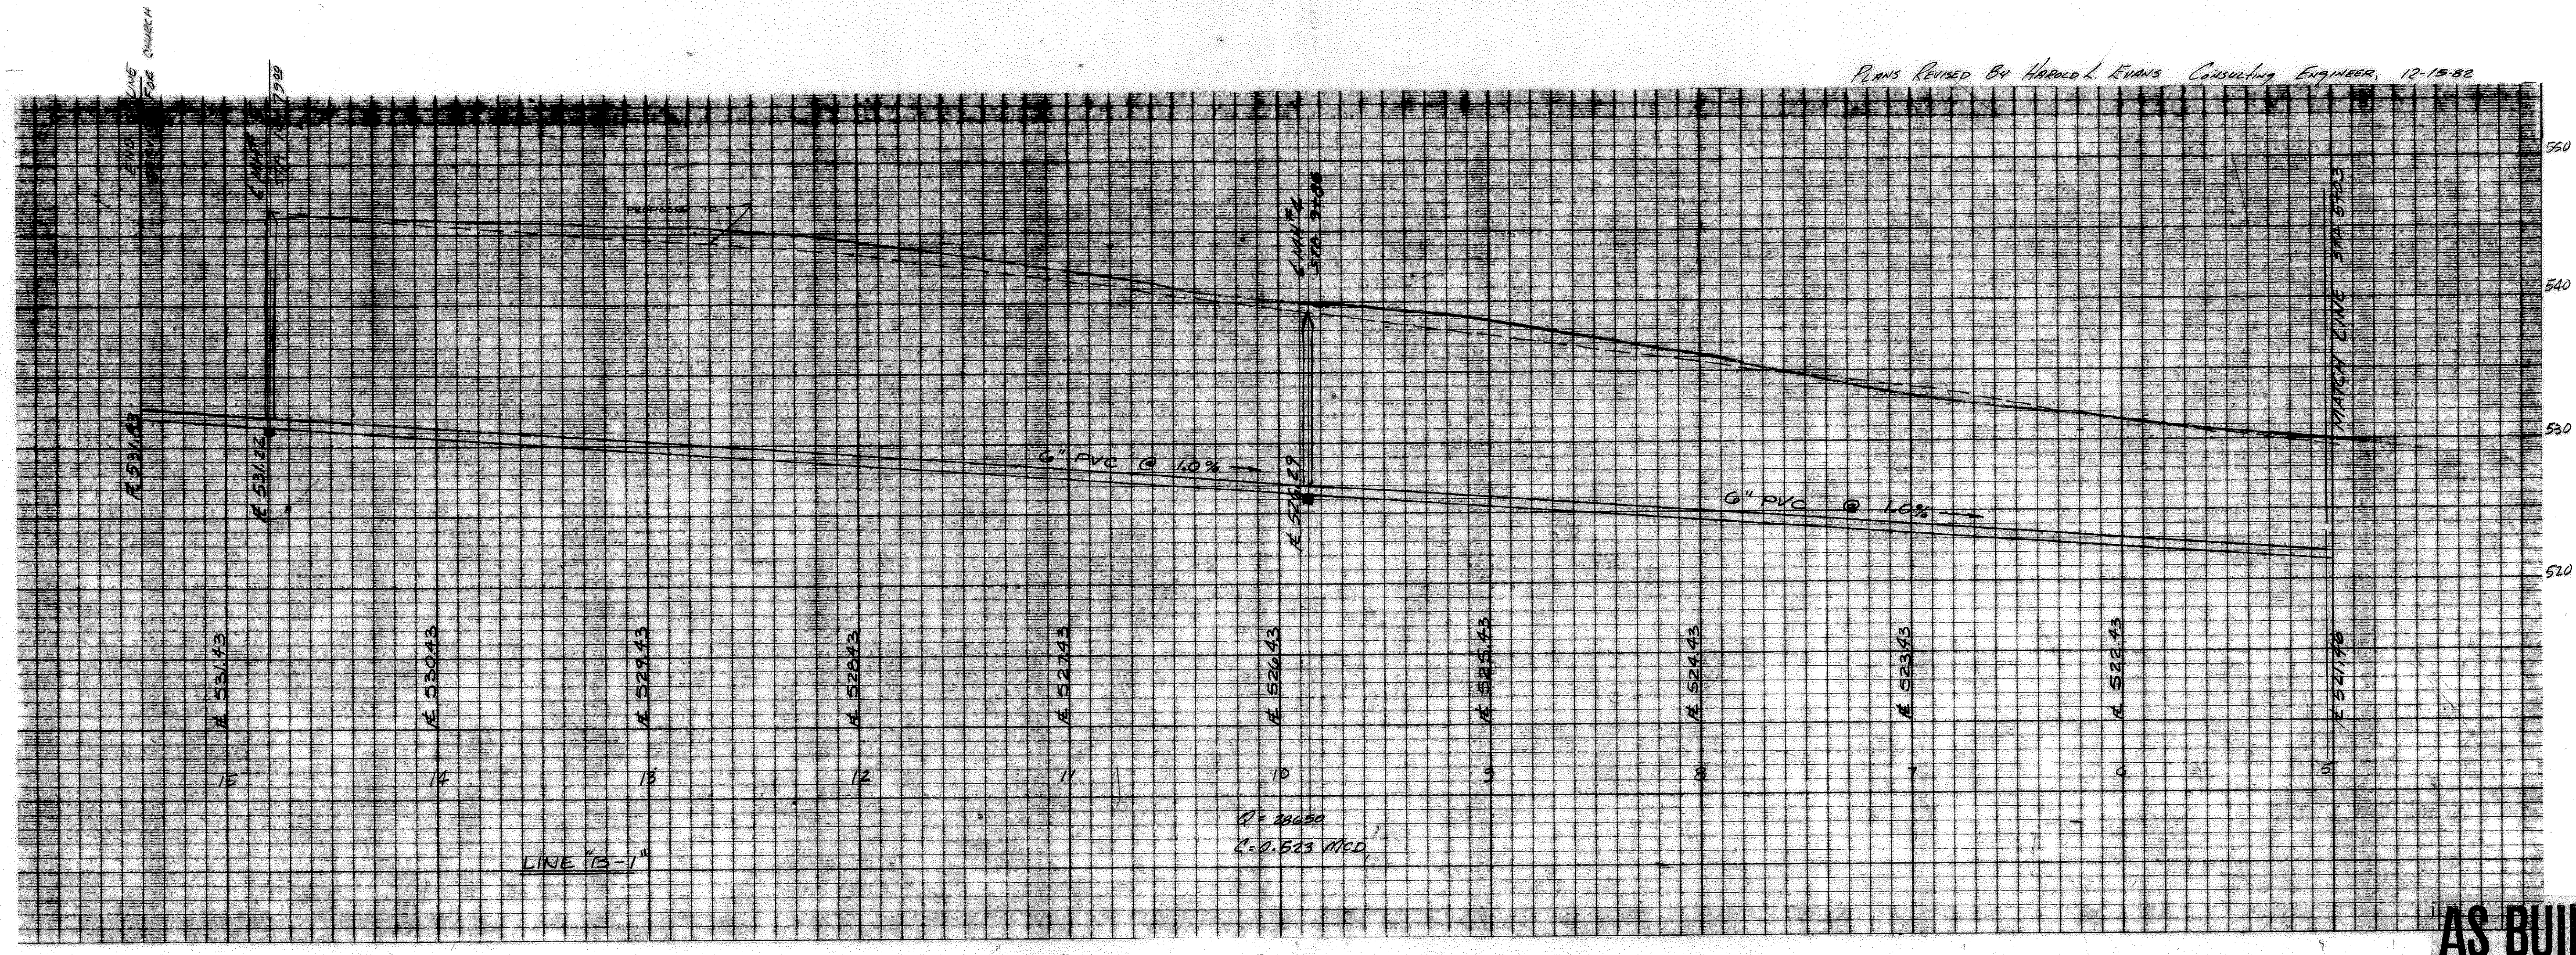

AS BUILT

a development of **WATER AND SANITARY SEWER IMPROVEMENTS**
WINDMILL RIDGE ESTATES
 SECTION "A" INSTALLMENT ONE
 ROCKWALL, TEXAS

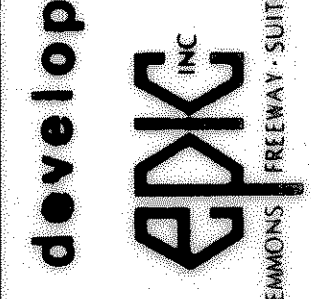

5955 STEWARTSON FREEMWAY SUITE 816 DALLAS, TEXAS 75247 214/630-1303