



**YELLOW JACKET CROSSING - AS BUILT PLANS**  
**INTERSECTION OF YELLOW JACKET LANE AND FM 740 (RIDGE RD.)**  
**ROCKWALL, TEXAS 75087**  
**LOT 1, BLOCK A**  
**1.129 AC**

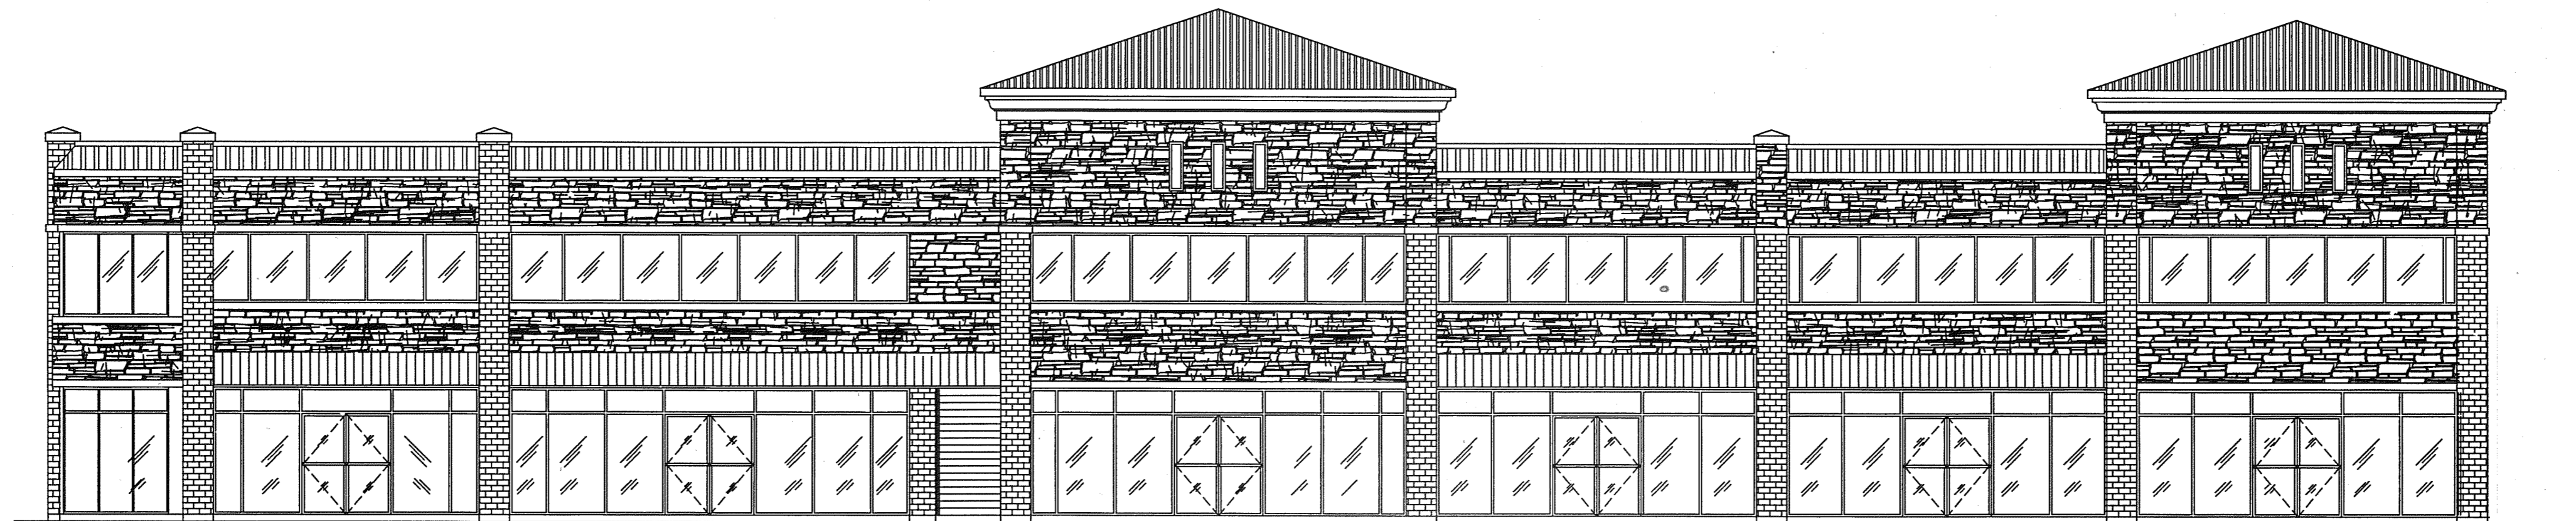

**OWNER/DEVELOPER:**

**IN KYUNG HWAN / CHUNG OH SOON**  
**512 SUNSTONE DRIVE,**  
**IRVING, TEXAS 75060**


**CONTACT PERSONS:**  
**CECIL UNRUH 972-771-3862**  
**ERIC CHUNG 214-718-4900**

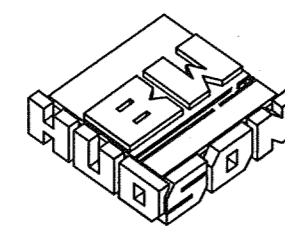


132 E. Main Street, Suite 200  
 Grand Prairie, Texas 75050  
 www.bwhudsonengineers.com  
 Bhudson911@aol.com

**BW HUDSON**  
**ENGINEERS AND ASSOCIATES**  
 BUILDING DESIGN-RENDERING  
 BLUE PRINTING-SCANNING  
 SCALE MODELS-ANIMATIONS

Tel. No. : (972) 264-4408  
 Fax No. : (972) 264-4416

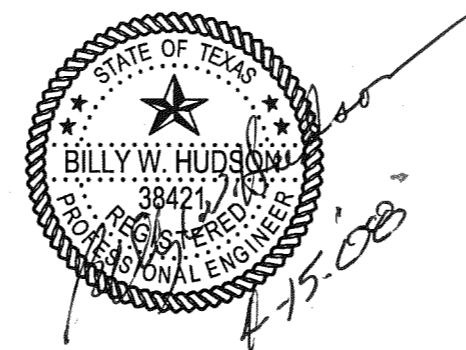

DRAWING INDEX	
	CIVIL PLANS
	FINAL PLAT - PLAN
	FINAL PLAT - SIGNATURE SHEET
C1	ENGINEERING SITE PLAN & DIMENSION CONTROL
C2	UTILITY PLAN
C3	GRADING AND DRAINAGE PLAN
C3a	ROAD PLAN PROFILE
C3b	STORM SEWER PROFILE
C3c	DRAINAGE AREA MAP
C4	PAVING AND JOINTING PLAN
C5	LANDSCAPE PLAN

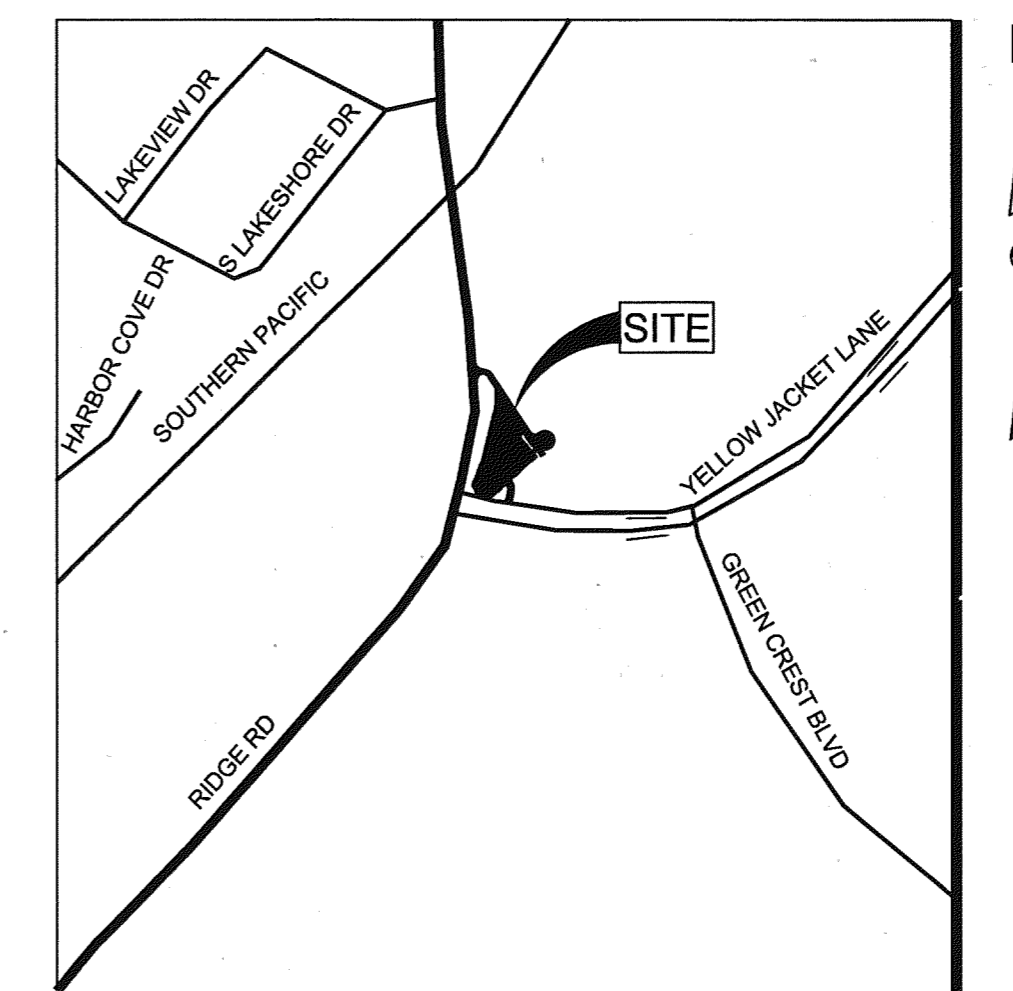

VICINITY MAP

SCALE: NONE