


NOTE: MARK OLD COUNTRY ROAD AS
"NO PARKING FIRE LANE" EVERY 25'
WHITE 4" LETTERS ON A 6" RED
STRIPED BACKGROUND.


"AS-BUILT DRAWING"

NAD-83 GEODETIC POSITION		NAD-83 TX STATE PLANE, NORTH CENTRAL ZONE	
LATITUDE	N 32° 53' 48.99664"	US SURVEY FT.	
LONGITUDE	N 96° 27' 38.61126"	NORTHING	7015228.12285
ORTHOMETRIC HEIGHT	154.2439	EASTING	2589247.61172
		ELEVATION	506.0486
		CONVERGENCE	+ 1° 08' 11.22874"
		SCALE FACTOR	0.999575247
NAD-83 GEODETIC POSITION			
AZIMUTH #1 - P.O. W/T OMNI. ANT.	28° 15' 35"	GRID	GEODETIC
AZIMUTH #2 - IH30 W/T OMNI. ANT.	73° 31' 25"		

LEGEND	
SANITARY SEWER MANHOLE	SS (Symbol)
STORM SEWER MANHOLE	MH (Symbol)
CLEAN OUT	CO (Symbol)
FIRE HYDRANT	FH (Symbol)
POWER POLE	PP (Symbol)
TELEPHONE BOX	TB (Symbol)
WATER METER	WM (Symbol)
GATE VALVE	GV (Symbol)
LIGHT POLE	(Symbol)
IRRIGATION SPRINKLER	(Symbol)
HEADLOCATION	(Symbol)
VAN ACCESSIBLE HANDICAP PARKING	(Symbol)
RIGHT OF WAY	R.O.W. (Symbol)
SET IRON ROD	S.I.R. (Symbol)
EXPANSION JOINT	E.J. (Symbol)
SAW JOINT	S.J. (Symbol)
CONSTRUCTION JOINT	C.J. (Symbol)
EXIST. LIGHTPOLE	(Symbol)
DRAINAGE & UTILITY EASEMENT	DEUE (Symbol)
DRAINAGE FLOW ARROW	(Symbol)
TRAFFIC FLOW ARROW	(Symbol)
FOUND IRON ROD	F.I.R. (Symbol)
GAS METER	(Symbol)
EXIST. WATER VALVE	(Symbol)
EXISTING CONTOURS	(Symbol)
PROPOSED CONTOURS	(Symbol)
PROPOSED SANITARY SEWER PIPE	(Symbol)
EXISTING SANITARY SEWER PIPE	(Symbol)
PROPOSED WATER LINE	(Symbol)
EXISTING WATER LINE	(Symbol)
PROPOSED POWER LINE	(Symbol)
EXISTING POWER LINE	(Symbol)
PROPOSED TELEPHONE LINE	(Symbol)
EXISTING TELEPHONE LINE	(Symbol)
PROPOSED STORM SEWER PIPE	(Symbol)
EXISTING STORM SEWER PIPE	(Symbol)
PROPOSED GUY WIRE	(Symbol)
EXISTING GUY WIRE	(Symbol)
OVERHEAD ELECTRICAL LINE	(Symbol)
EXISTING FIBER OPTICS CABLE	(Symbol)

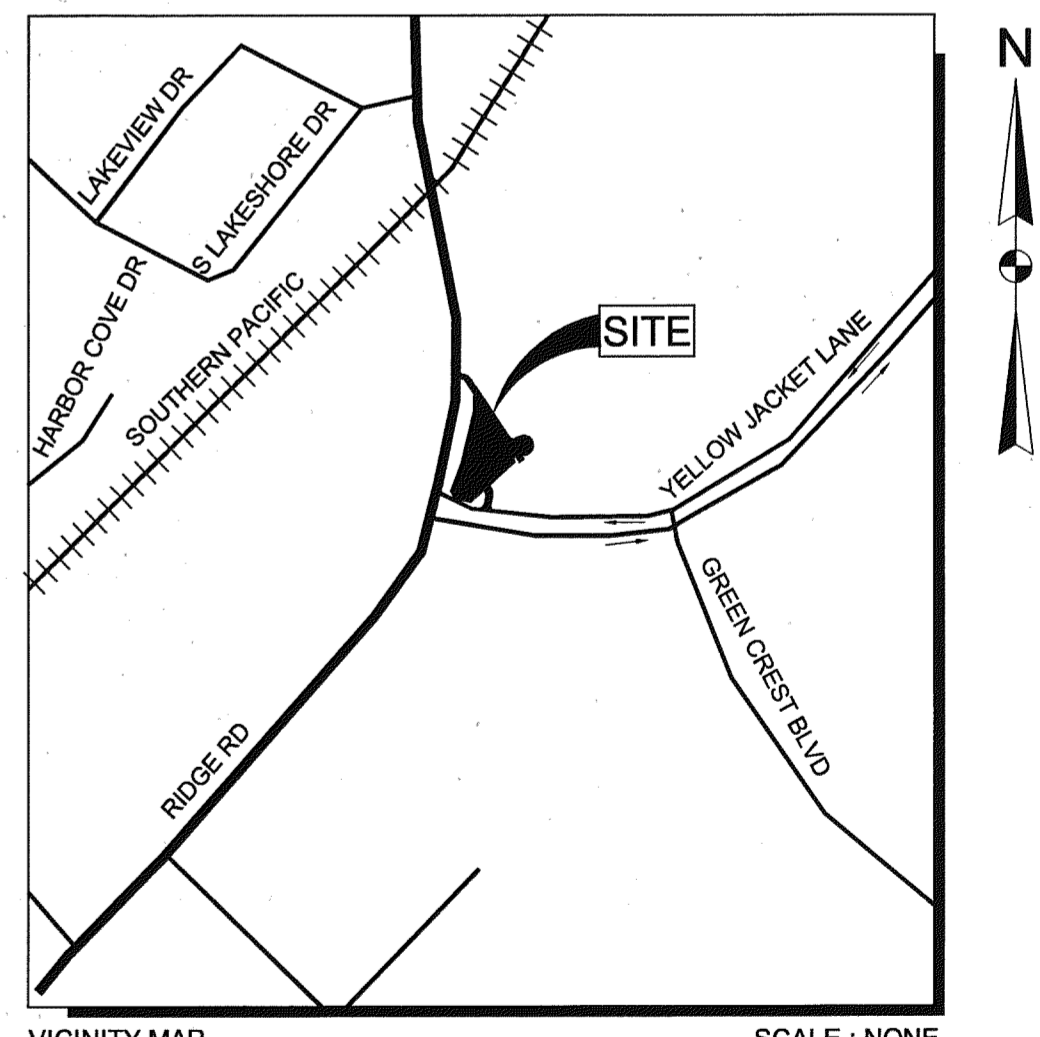

01 PAVING AND JOINTING PLAN

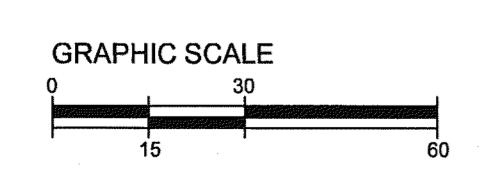

AS - BUILT DRAWINGS.
TO THE BEST OF MY KNOWLEDGE, THIS PLAN IS AS - BUILT, AND THE INFORMATION IS BASED ON SURVEYING CONDUCTED AT THE SITE AND INFORMATION PROVIDED BY THE CONTRACTOR.
BILLY W. HUDSON

OWNER/DEVELOPER:
IN KYUNG HWAN / CHUNG OH SOON
512 SUNSTONE DRIVE,
IRVING, TEXAS 75060
CONTACT PERSON:
CECIL UNRUH 972-771-3862
ERIC CHUNG 214-718-4900

BW HUDSON
ENGINEERS AND ASSOCIATES
BUILDING DESIGN-RENDERING
BLUE PRINTING-SCANNING
SCALE MODELS-ANIMATIONS
132 E. Main Street, Suite 200
Grand Prairie, Texas 75050
www.bwhudsonengineers.com
Bhudson911@aol.com
MARCH 04, 2008
Tel. No. : (972) 264-4408
Fax No. : (972) 264-4416

OWNERSHIP AND USE OF DRAWINGS
THESE DRAWINGS WHETHER PRINTED OR ELECTRONIC IN FORM, PREPARED BY THE ENGINEER/BW HUDSON ENGINEERS AND ASSOCIATES, ARE INSTRUMENTS OF SERVICE THROUGH WHICH THE CONTRACTOR SHALL EXECUTE THE WORK DESCRIBED HEREIN. ONLY THE ENGINEER SHALL OWN, CLAIM AUTHORSHIP, CLAIM COPYRIGHT OR RETAIN ANY OTHER RESERVED RIGHTS ON THESE DRAWINGS. UNLESS OTHERWISE AGREED TO OR PERMITTED IN WRITING BY THE ENGINEER, THESE DRAWINGS SHALL NOT BE COPIED, REVISED OR TRANSMITTED TO ANY THIRD PARTY.
THESE DRAWINGS SHALL BE USED SOLELY FOR THIS PROJECT. THE CONTRACTOR, SUBCONTRACTOR, MATERIAL OR EQUIPMENT SUPPLIER ARE PERMITTED TO USE OR REPRODUCE PORTION(S) OF THE DRAWINGS RELATIVE TO THEIR PERFORMANCE CONTRACT AS SPECIFIED IN THE CONTRACT DOCUMENTS.
THESE DRAWINGS SHALL NOT BE USED BY THE CONTRACTOR, SUBCONTRACTOR, MATERIAL OR EQUIPMENT SUPPLIER ON OTHER PROJECTS OR ON ADDITIONS TO THIS PROJECT OUTSIDE THE ORIGINAL SCOPE OF WORKS WITHOUT THE SPECIFIC WRITTEN CONSENT OF THE ENGINEER.
OFFICIAL SUBMISSION OF THESE PLANS TO REGULATORY AGENCIES SHALL ONLY MEAN COMPLIANCE TO REGULATORY REQUIREMENTS AND SHALL NOT BE CONSTRUED AS PUBLICATION OR LOSS OF ENGINEER'S COPYRIGHTS OR OTHER RESERVED RIGHTS.

PROJECT STATUS:
AS-BUILT DRAWING
PROJECT MANAGER:
BILLY W. HUDSON
DESIGN COORDINATOR:
DANTE ABAYON
DATE:
03/04/08
DRAWING DONE BY:
EDGARDO FORTICH JR.

ENGINEER'S SEAL
THE SEAL APPEARING ON THIS DOCUMENT WAS AUTHORIZED BY BILLY W. HUDSON, P.E. 38421 ON THE DATE INDICATED HEREIN. ALTERATION OF A SEALED DOCUMENT WITHOUT PROPER NOTIFICATION TO THE RESPONSIBLE ENGINEER IS AN OFFENSE UNDER THE TEXAS ENGINEERING ACT.

PAVING AND JOINTING PLAN
YELLOW JACKET CROSSING
INTERSECTION OF YELLOW JACKET LANE and FM 740 (Ridge Road)
CITY OF ROCKWALL, TEXAS 75087
LOT 1, BLOCK A
1.129 AC