


DEVELOPMENT PLANS

# The Highlands

CITY OF ROCKWALL, TEXAS

INDEX of SHEETS

Sheet No.	Title
1	Cover Sheet
2-5	Final Plat <i>← Need in set</i>
6-9	Grading Plan
10-30	Paving Plan & Profile
31	Drainage Area Map
32-42	Storm Drain Plan & Profiles
43-55	Sanitary Sewer Profiles
56-57	Offsite Water Profile
58-59	Water and Sewer Plan
60-61	Erosion Control Plan

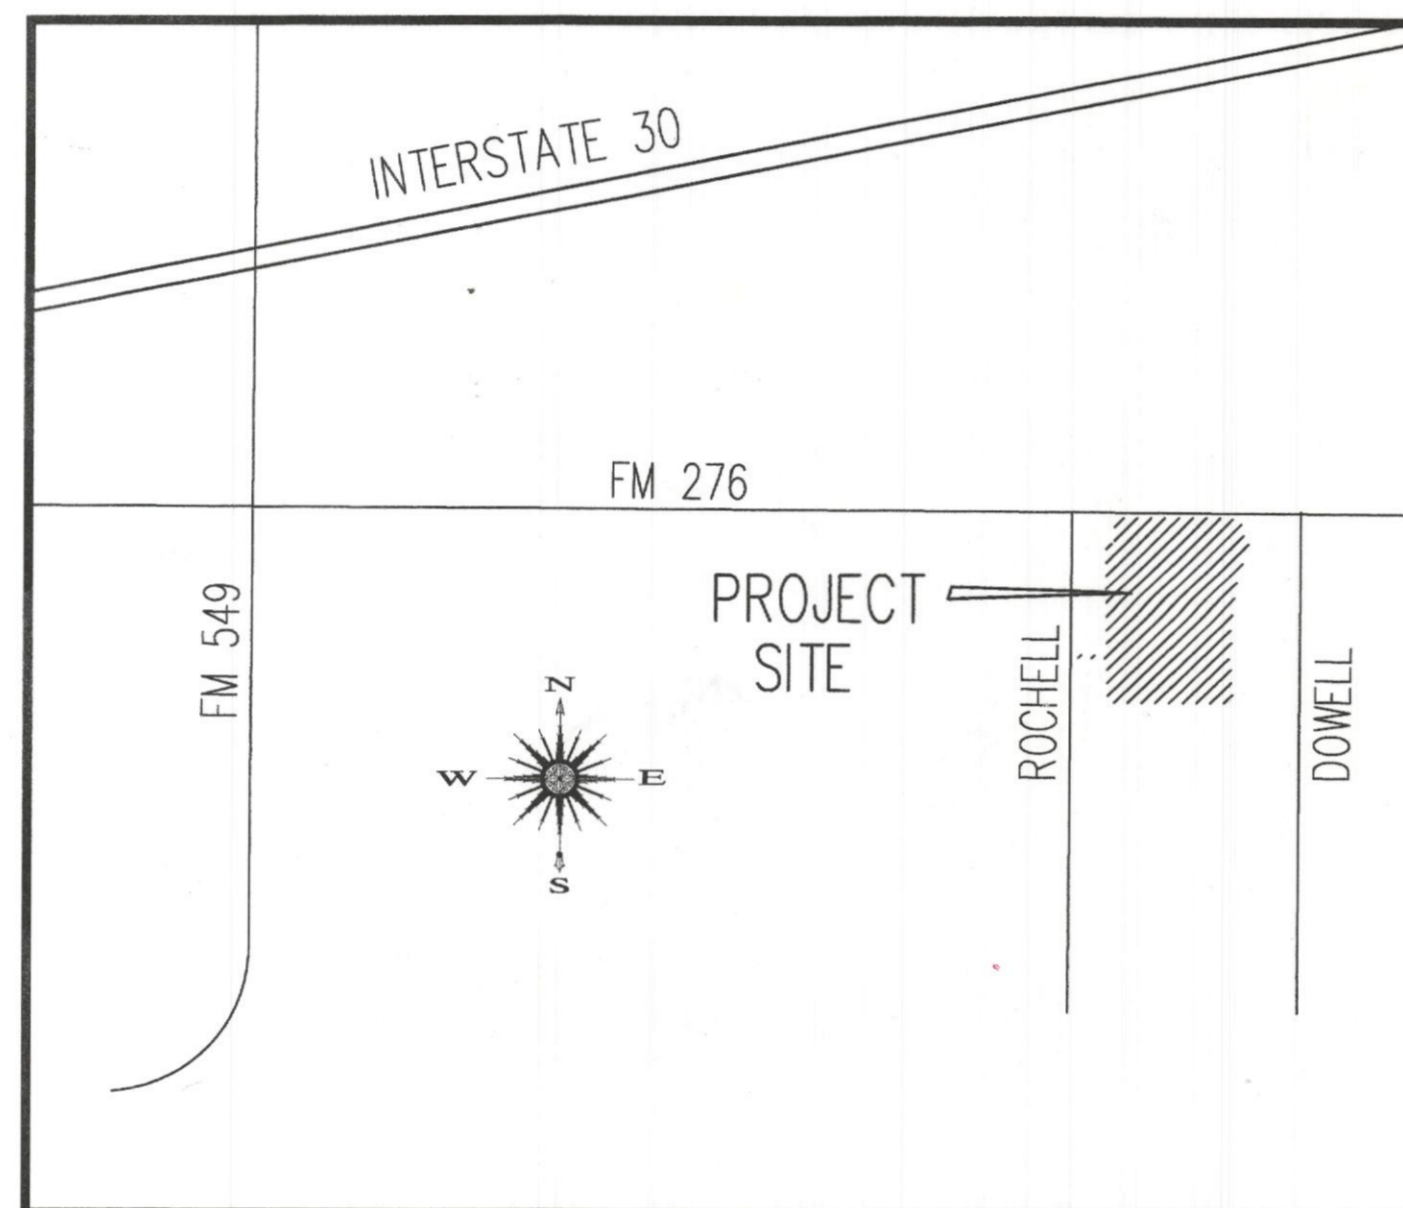

LOCATION MAP  
N.T.S.

*Flood study with this phase?*

*NO  
L-2-01  
SUBMITTAL #2  
SEP 26 2007  
Comments  
10/2/07  
BNH  
10/10/07*

*- School site?  
- TxDOT permit  
- Change names  
- storm sewer*



Applicant ~ Developer  
Spring Haven Investments, Inc.  
6750 Hillcrest Plaza Dr.  
Suite 325  
Dallas Texas 75230  
(972) 386-3333

FOR CONSTRUCTION

PROJECT # 06-004

September 25, 2007

~ Engineer ~  
**F.C. CUNY CORPORATION**  
#2 Horizon Court • Heath, Texas 75032 • (469) 402-7700