


MATCHLINE
SEE GRADING SHEET 7




MATCHLINE
SEE GRADING SHEET 8

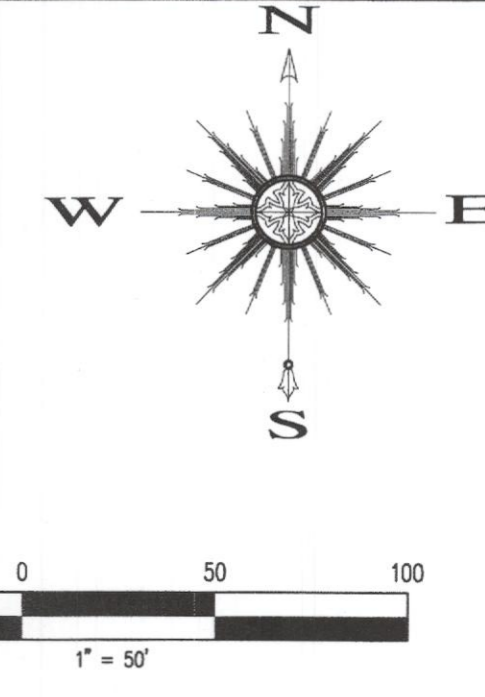

Change street name. We already have a Stratford

Note: Construct Barrier Free Ramp (B.F.R.) per City of Rockwall Specs.

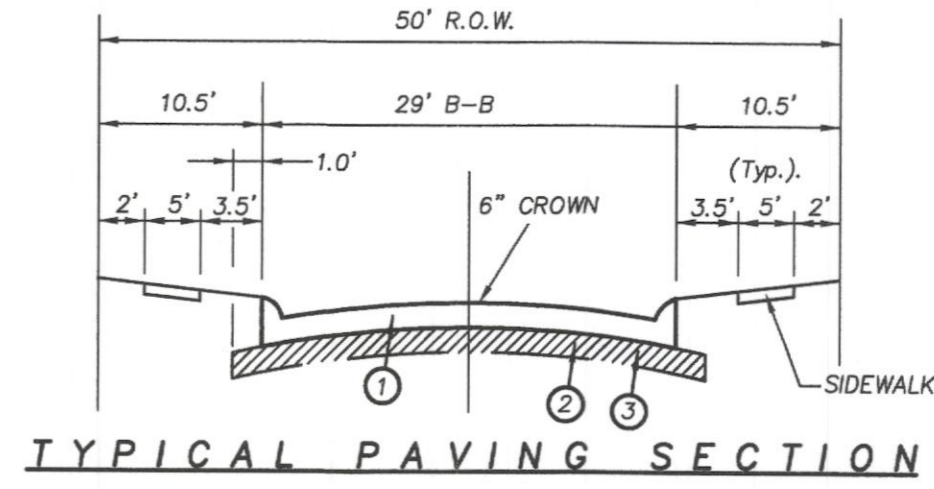

- ① 6"-3600 PSI Class "C" concrete pavement with No. 3 bars 24" on centers both ways.
Min. 6 Sack For Machine Placed
Min. 6 1/2 Sack For Hand Placed
- ② Where the Plasticity Index of the natural soil is equal to or exceeds 15, lime stabilization shall be required. A minimum of 6% by weight of lime to a depth of 6" shall be required. *lime is required*
- ③ Subgrade shall be 6" thick and compacted to a density not less than 95% at 0%-4% of optimum moisture content.

Notes:
1. All construction joints & rebar to be in conformance with the City of Rockwall Specifications and Standards.

Revision	Date	Description

Owner:
SPRING HAVEN INVESTMENTS, INC.
6750 HILLCREST PLAZA DR. • STE 325
DALLAS, TEXAS 75230 • Phone: 972-386-3333

The Highlands

F.C. CUNY CORPORATION
#2 Horizon Court • Ste. 300 • Heath, Texas 75032
Phone: 469-402-7700
Fax: 469-402-0700

THE SEAL APPEARING ON THIS DOCUMENT WAS AUTHORIZED BY CHRISTOPHER R. CUNY, P.E. 65642



Drawn By: MSC	Checked By: JW
Date: 08/25/2007	Project No.: 06-004
Sheet Title: GRADING PLAN	

Scale: 1" = 50'
Sheet No.: 9 of 61