

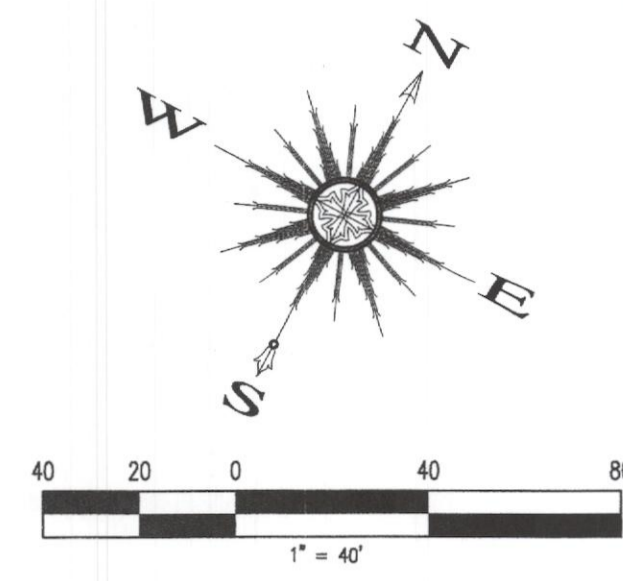


CURVE TABLE						
CURVE	LENGTH	RADIUS	DELTA	TANGENT	CHORD	BEARING
C6	341.08'	300.00	65°08'27"	191.64'	323.00'	N72°45'36"E
C7	233.78'	500.00	26°47'23"	119.07'	231.66'	S53°35'04"W

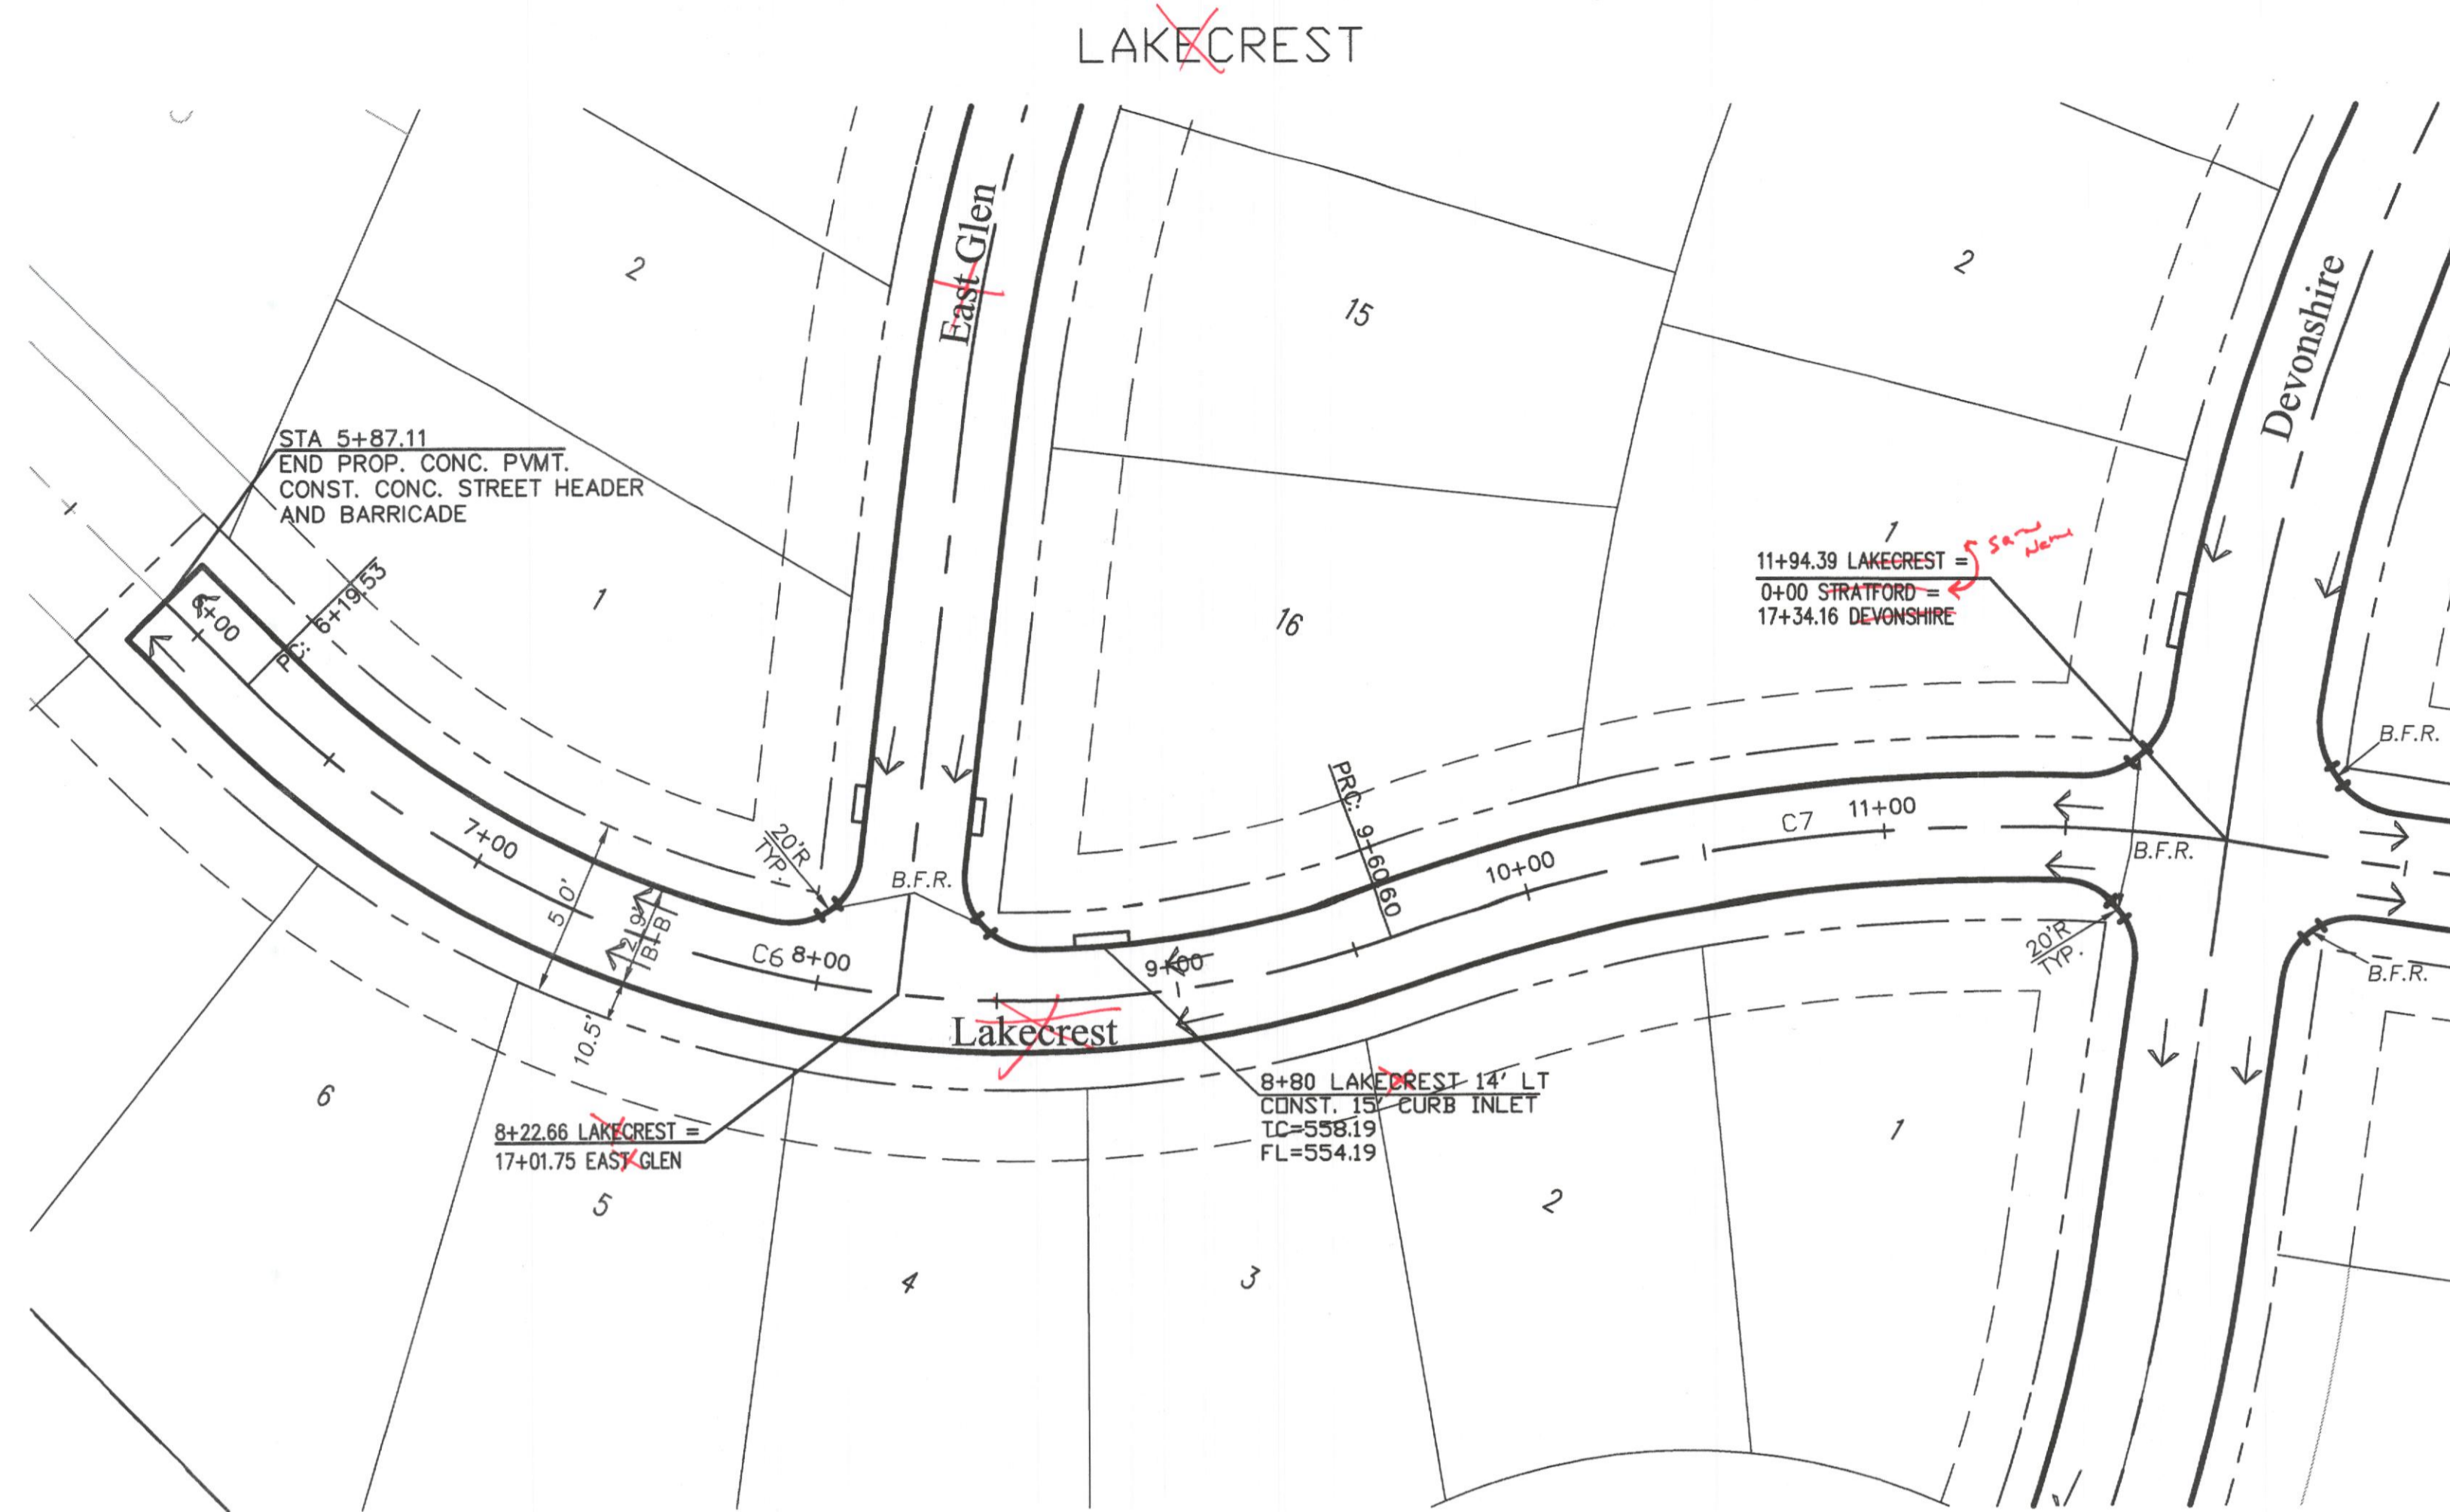

LAKECREST PROFILE

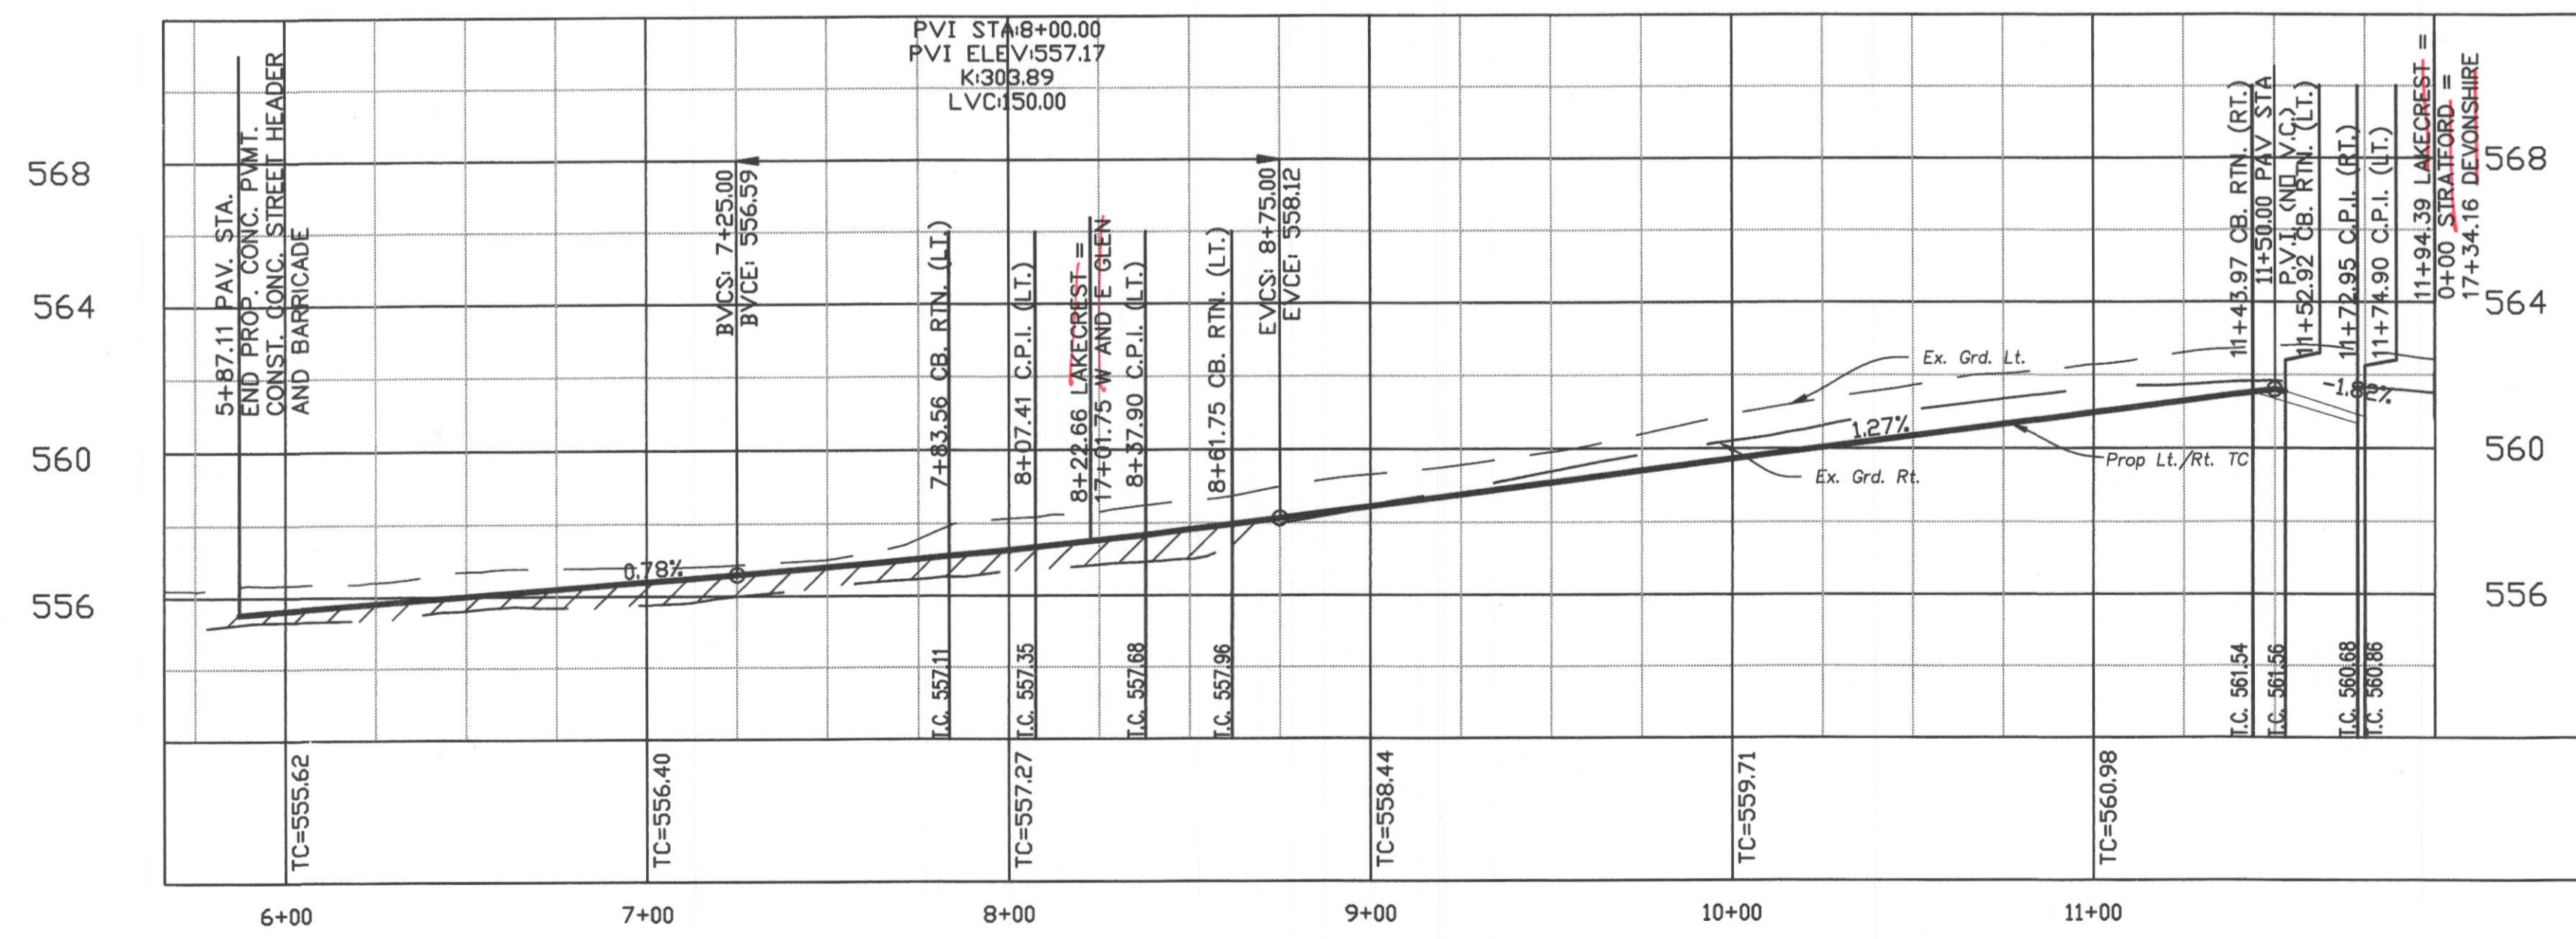


Revision	Date	Description

Owner:
SPRING HAVEN INVESTMENTS, INC.
 6750 HILLCREST PLAZA DR. • STE 325
 DALLAS, TEXAS 75230 • Phone: 972-386-3333

The Highlands

F.C. CUNY CORPORATION
 #2 Horizon Court • Ste. 500 • Heath, Texas 75032
 Phone: 469-402-7700
 Fax: 469-402-0700

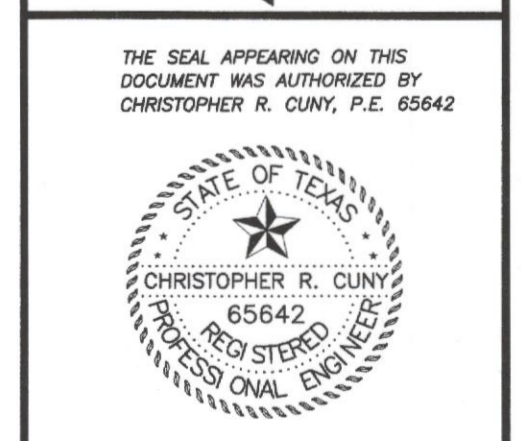

Drawn By: MSC	Checked By: JW
Date: 09/25/2007	Project No.: 06-004
Sheet Title: Lakecrest Street Paving Plan & Profile	
Scale: 1" = 40'	Sheet No.: 11 of 61