


- ① 3600 PSI Class "C" concrete pavement with No. 3 bars 24" on centers both ways. Min. 6 Sack For Machine Placed. Min. 5 1/2 Sack For Hand Placed.
 - ② Where the Plasticity Index of the natural soil is equal to or exceeds 15, lime stabilization shall be required. A minimum of 5% by weight of lime to a depth of 6" shall be required.
 - ③ Subgrade shall be 6" thick and compacted to a density not less than 95% at 0%–4% of optimum moisture content.
- Note: 1. All construction joints & rebar to be in conformance with the City of Rockwall Specifications and Standards.
 Note: Construct Barrier Free Ramp (B.F.R.) per City of Rockwall Stds.

CURVE	LENGTH	RADIUS	DELTA	TANGENT	CHORD	BEARING
CB	83.46'	400.00'	11°57'19"	41.88'	83.31'	N07°06'55"E
C9	76.48'	283.69'	15°26'48"	38.47'	76.25'	N20°48'59"E

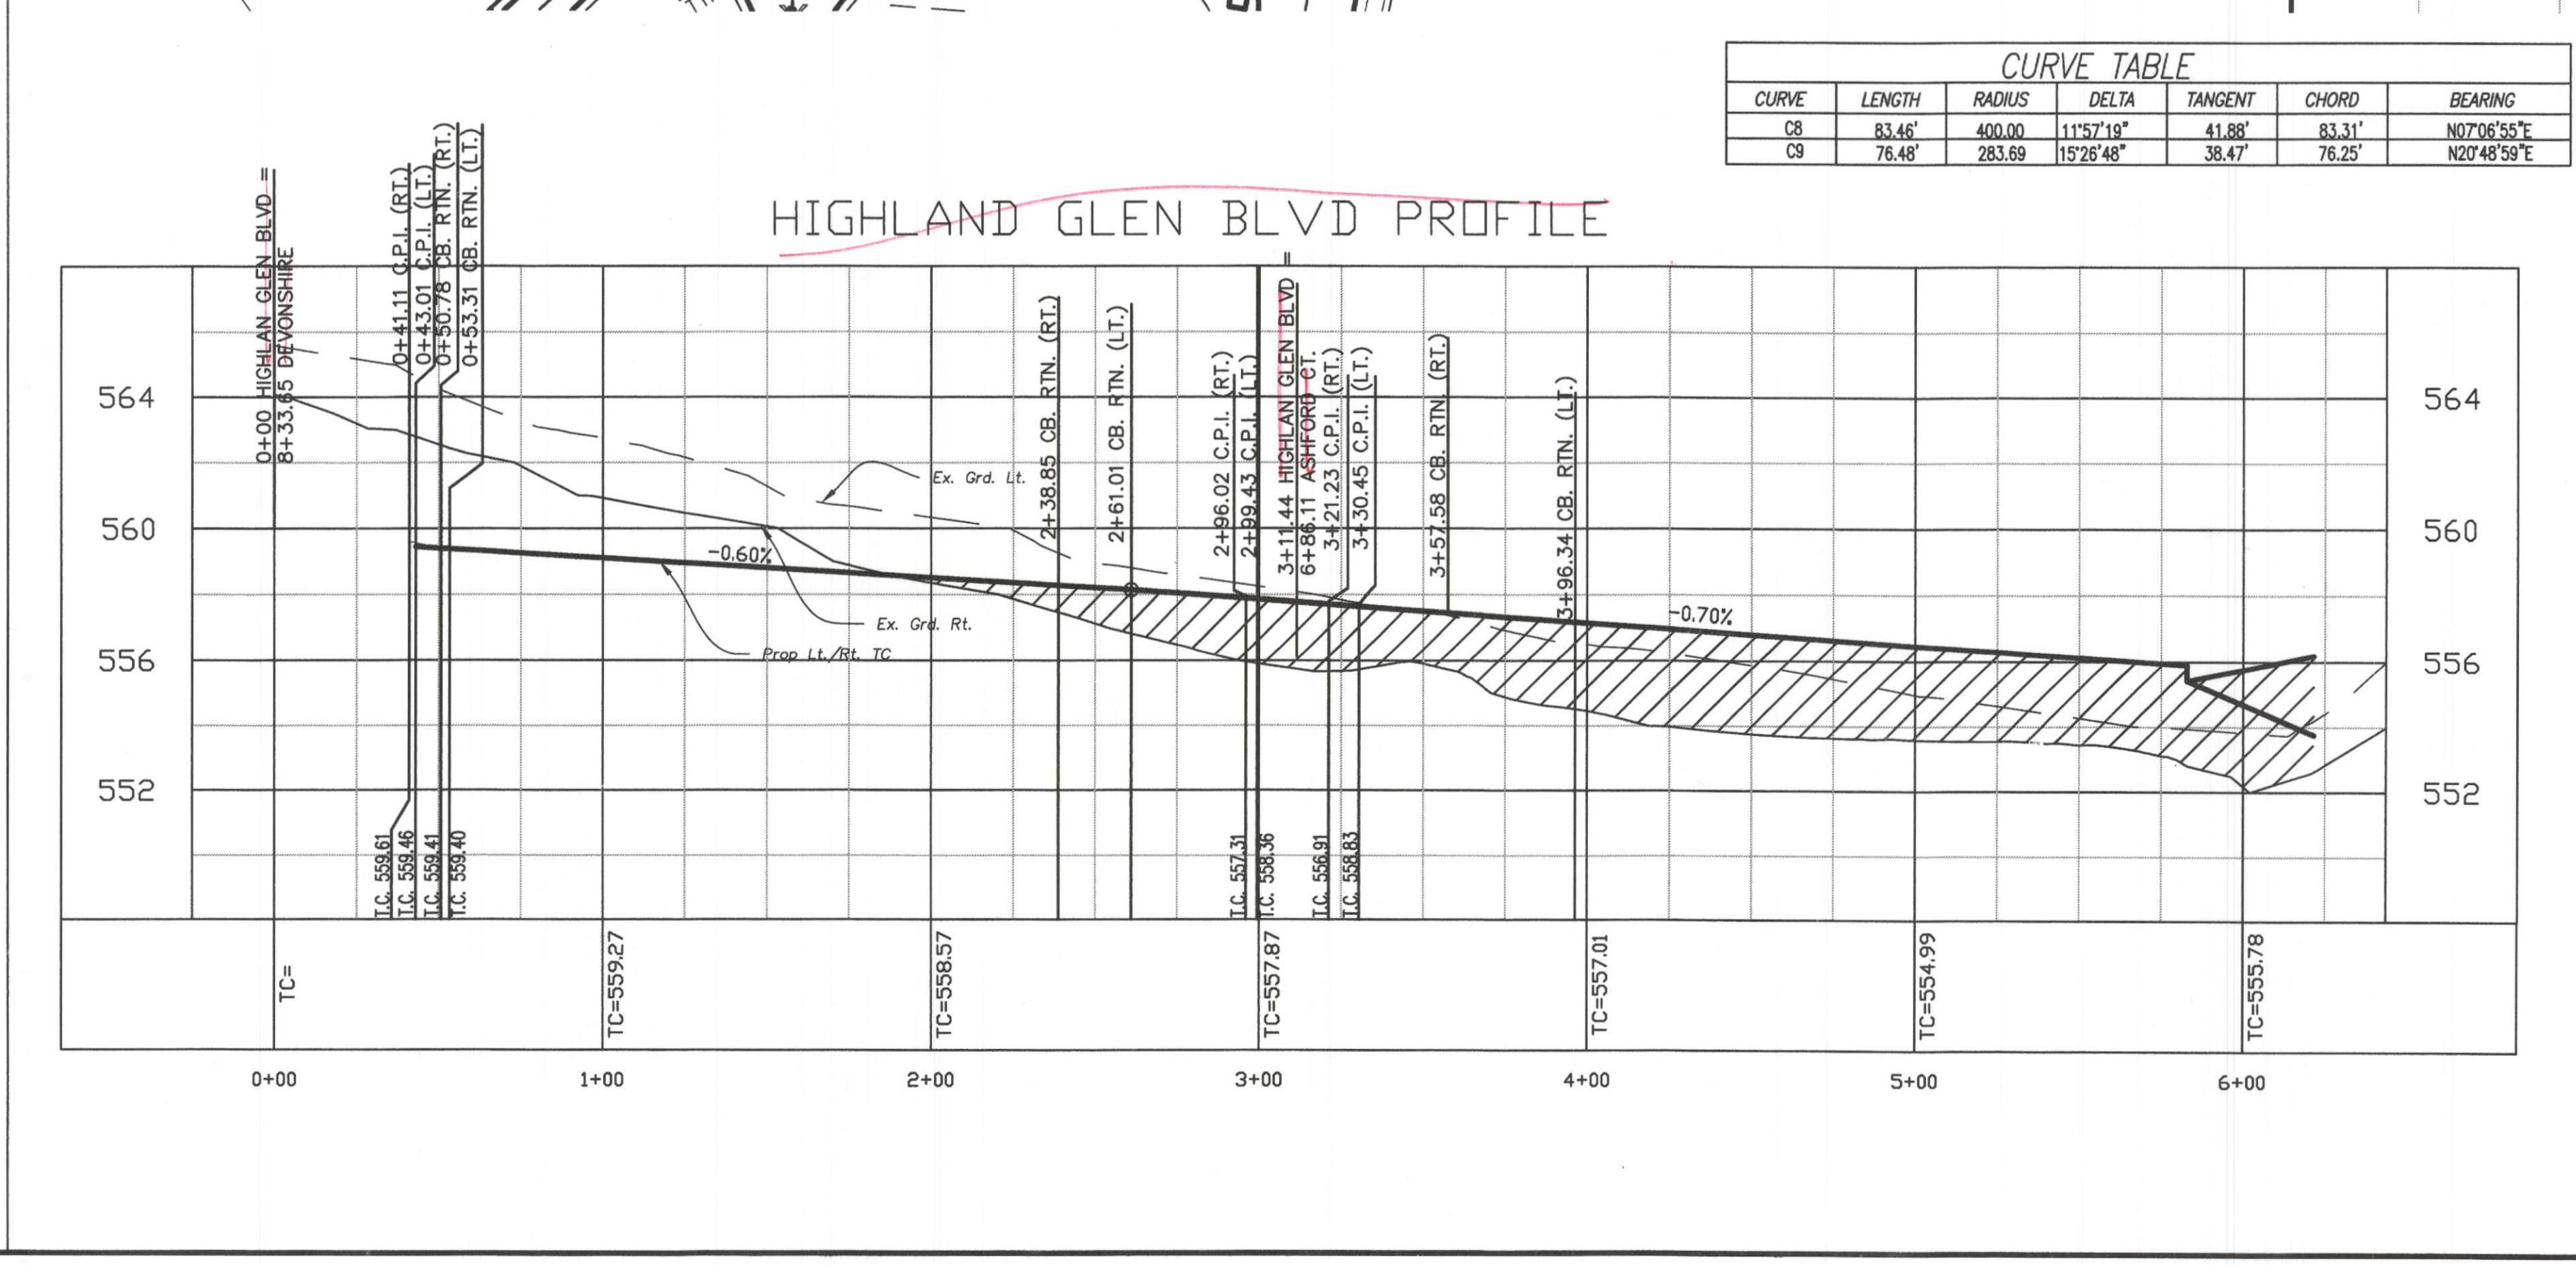

Revision	Date	Description

Owner: **SPRING HAVEN INVESTMENTS, INC.**
 6750 HILLCREST PLAZA DR. • STE 325
 DALLAS, TEXAS 75230 • Phone: 972-386-3333

The Highlands

F.C. CUNY CORPORATION
 #2 Horizon Court • Ste. 500 • Heath, Texas 75032
 Phone: 469-402-7700
 Fax: 469-402-0700

THE SEAL APPEARING ON THIS DOCUMENT WAS AUTHORIZED BY CHRISTOPHER R. CUNY, P.E. 65642

Drawn By: MSC	Checked By: JW
Date: 08/25/2007	Project No.: 06-004
Sheet Title: Kerry Lane-Highland Blvd Paving Plan & Profile	
Scale: 1" = 40'	Sheet No.: 21 of 61