

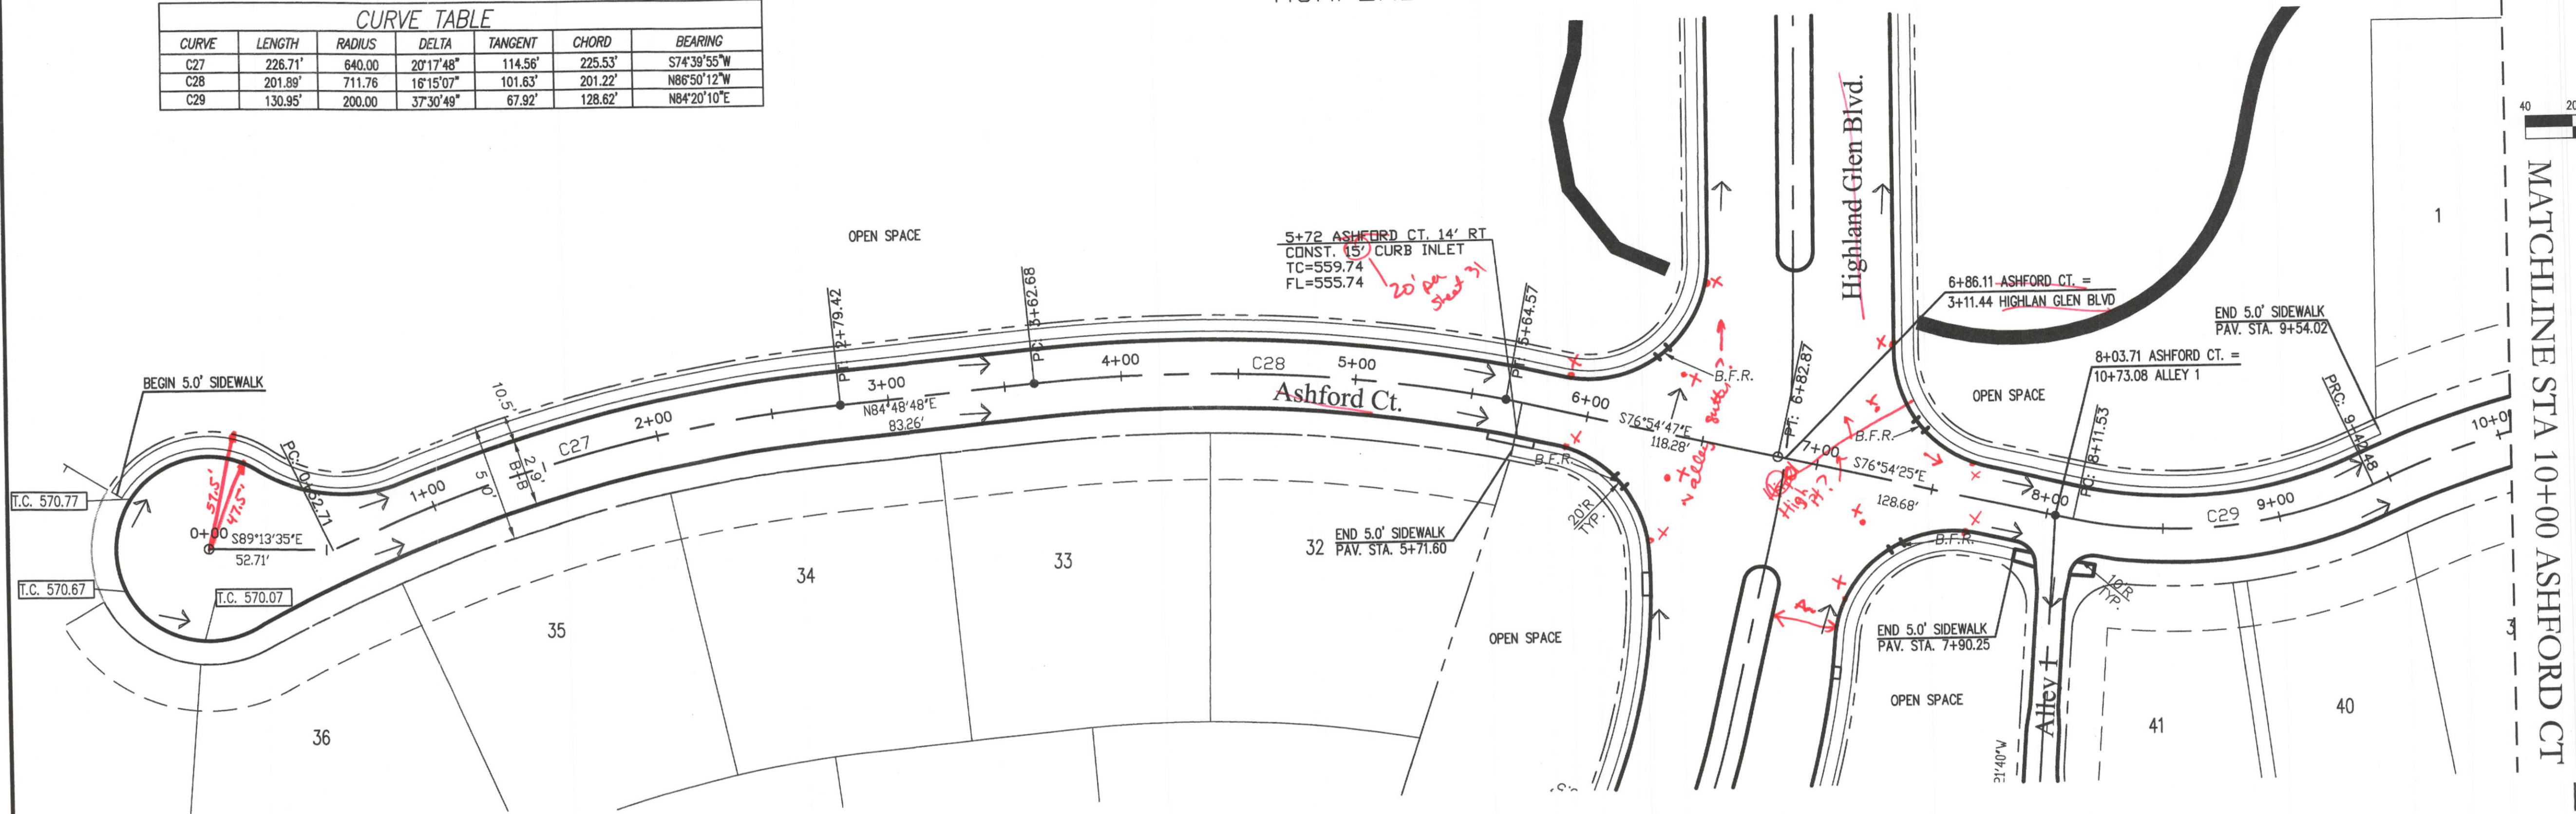


CURVE TABLE						
CURVE	LENGTH	RADIUS	DELTA	TANGENT	CHORD	BEARING
C27	226.71'	640.00	20°17'48"	114.56'	225.53'	S74°38'55"W
C28	201.89'	711.76	16°15'07"	101.63'	201.22'	N86°50'12"W
C29	130.95'	200.00	37°30'49"	67.92'	128.62'	N84°20'10"E

ASHFORD CT

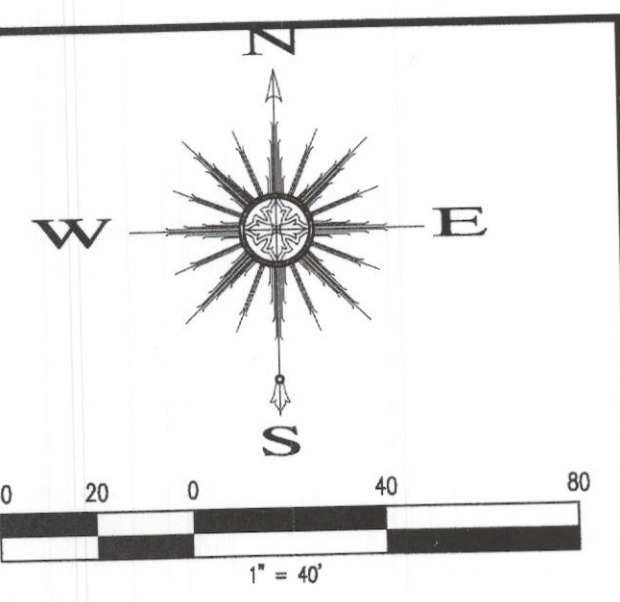

ASHFORD CT PROFILE

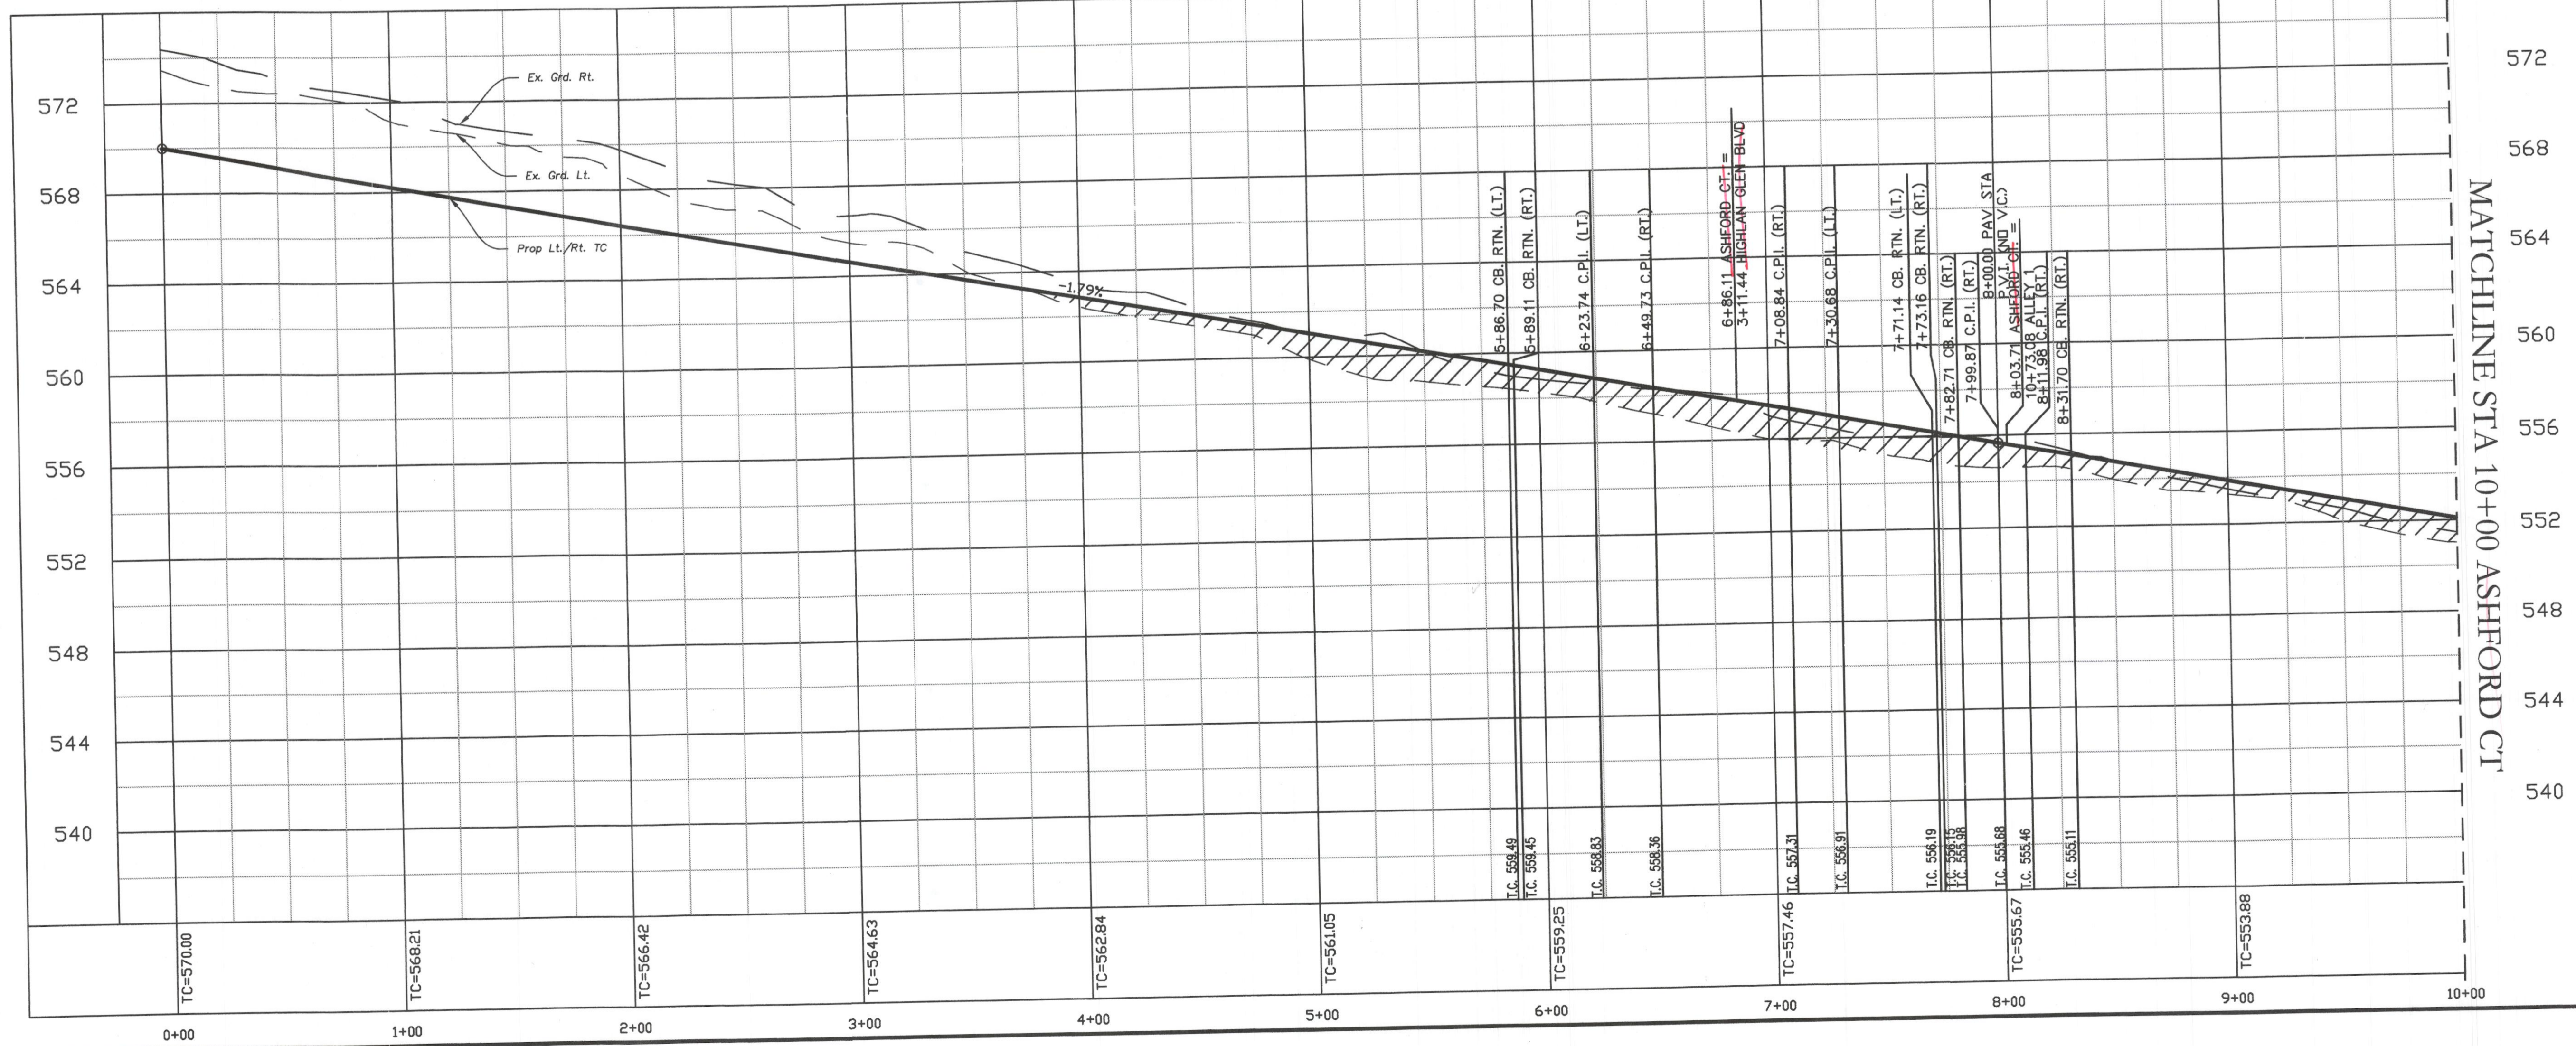


Revision	Date	Description

Owner:
SPRING HAVEN INVESTMENTS, INC.
 6750 HILLCREST PLAZA DR. • STE 325
 DALLAS, TEXAS 75230 • Phone: 972-386-3333

The Highlands

F.C. CUNY CORPORATION
 #2 Horizon Court • Ste. 500 • Heath, Texas 75032
 Phone: 469-402-7700
 Fax: 469-402-0700

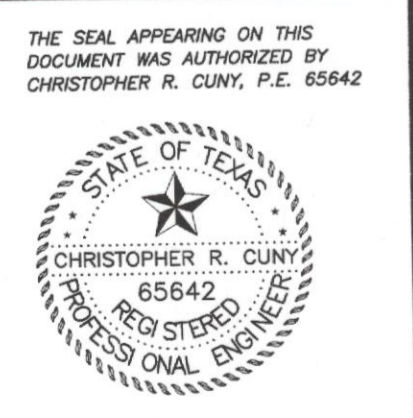

Drawn By: MSC	Checked By: JW
Date: 09/25/2007	Project No.: 06-004
Sheet Title: Ashford CT Paving Plan & Profile	
Scale: 1" = 40'	Sheet No.: 22 of 61