


CURVE TABLE						
CURVE	LENGTH	RADIUS	DELTA	TANGENT	CHORD	BEARING
C11	452.63	1115.00	23°15'32"	229.47	449.52	S 16°3'15" W

alley5 PROFILE

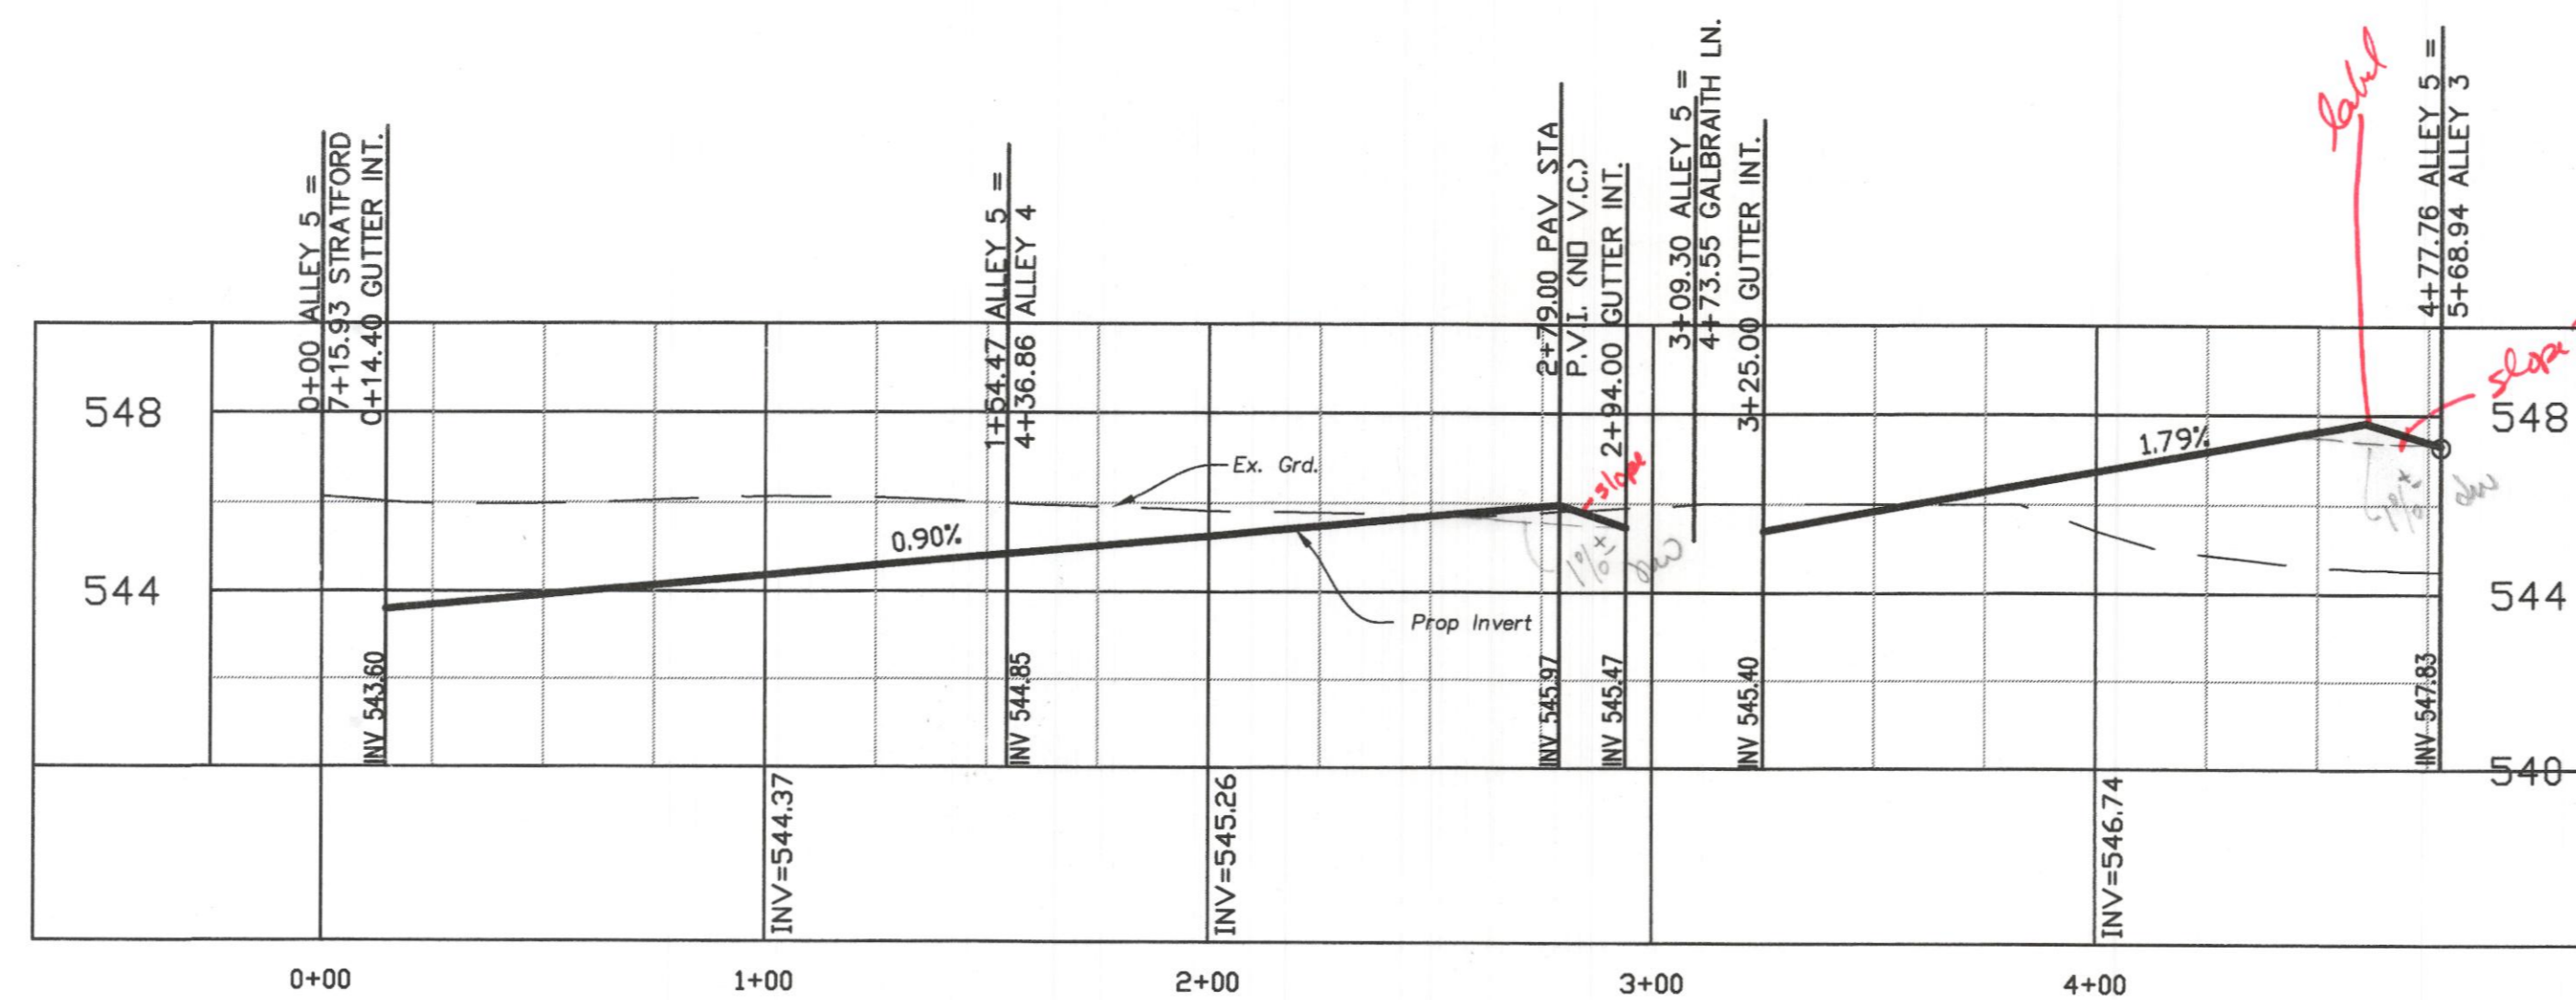

Revision	Date	Description

Owner:
SPRING HAVEN INVESTMENTS, INC.
 6750 HILLCREST PLAZA DR. • STE 325
 DALLAS, TEXAS 75230 • Phone: 972-386-3333

The Highlands

F.C. CUNY CORPORATION
 #2 Horizon Court • Ste. 500 • Heath, Texas 75032
 Phone: 469-402-7700
 Fax: 469-402-0700

THE SEAL APPEARING ON THIS DOCUMENT WAS AUTHORIZED BY CHRISTOPHER R. CUNY, P.E. 65642



Drawn By: MSC	Checked By: JW
Date: 09/25/2007	Project No.: 06-004
Sheet Title: Alley 5 Paving Plan & Profile	
Scale: 1" = 40'	Sheet No.: 29 of 61