
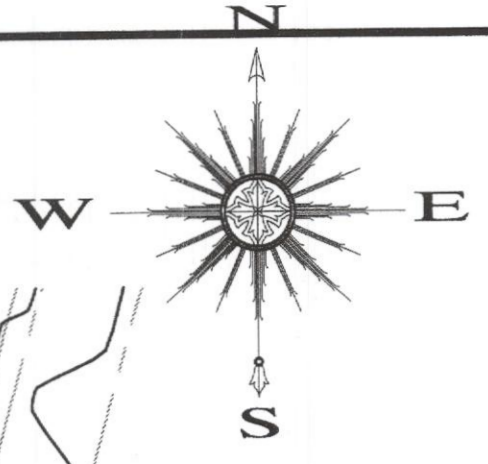


Storm Drain Line B

Storm Drain Line B

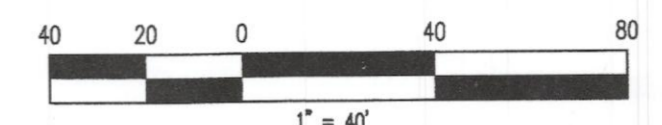

Revision	Date	Description



Owner:  
**SPRING HAVEN INVESTMENTS, INC.**  
 6750 HILLCREST PLAZA DR. • STE 325  
 DALLAS, TEXAS 75230 • Phone: 972-386-3333

**The Highlands**

**F.C. CUNY CORPORATION**  
 #2 Horizon Court • Ste. 300 • Heath, Texas 75032  
 Phone: 469-402-7700  
 Fax: 469-402-0700


THE SEAL APPEARING ON THIS DOCUMENT WAS AUTHORIZED BY CHRISTOPHER R. CUNY, P.E. 65842

Drawn By: MSC  
 Checked By: JW  
 Date: 09/25/2007  
 Project No.: 06-004  
 Sheet Title:  
**Storm Drain Line B Plan & Profile**  
 Scale: 1" = 40'  
 Sheet No.: 34 of 61

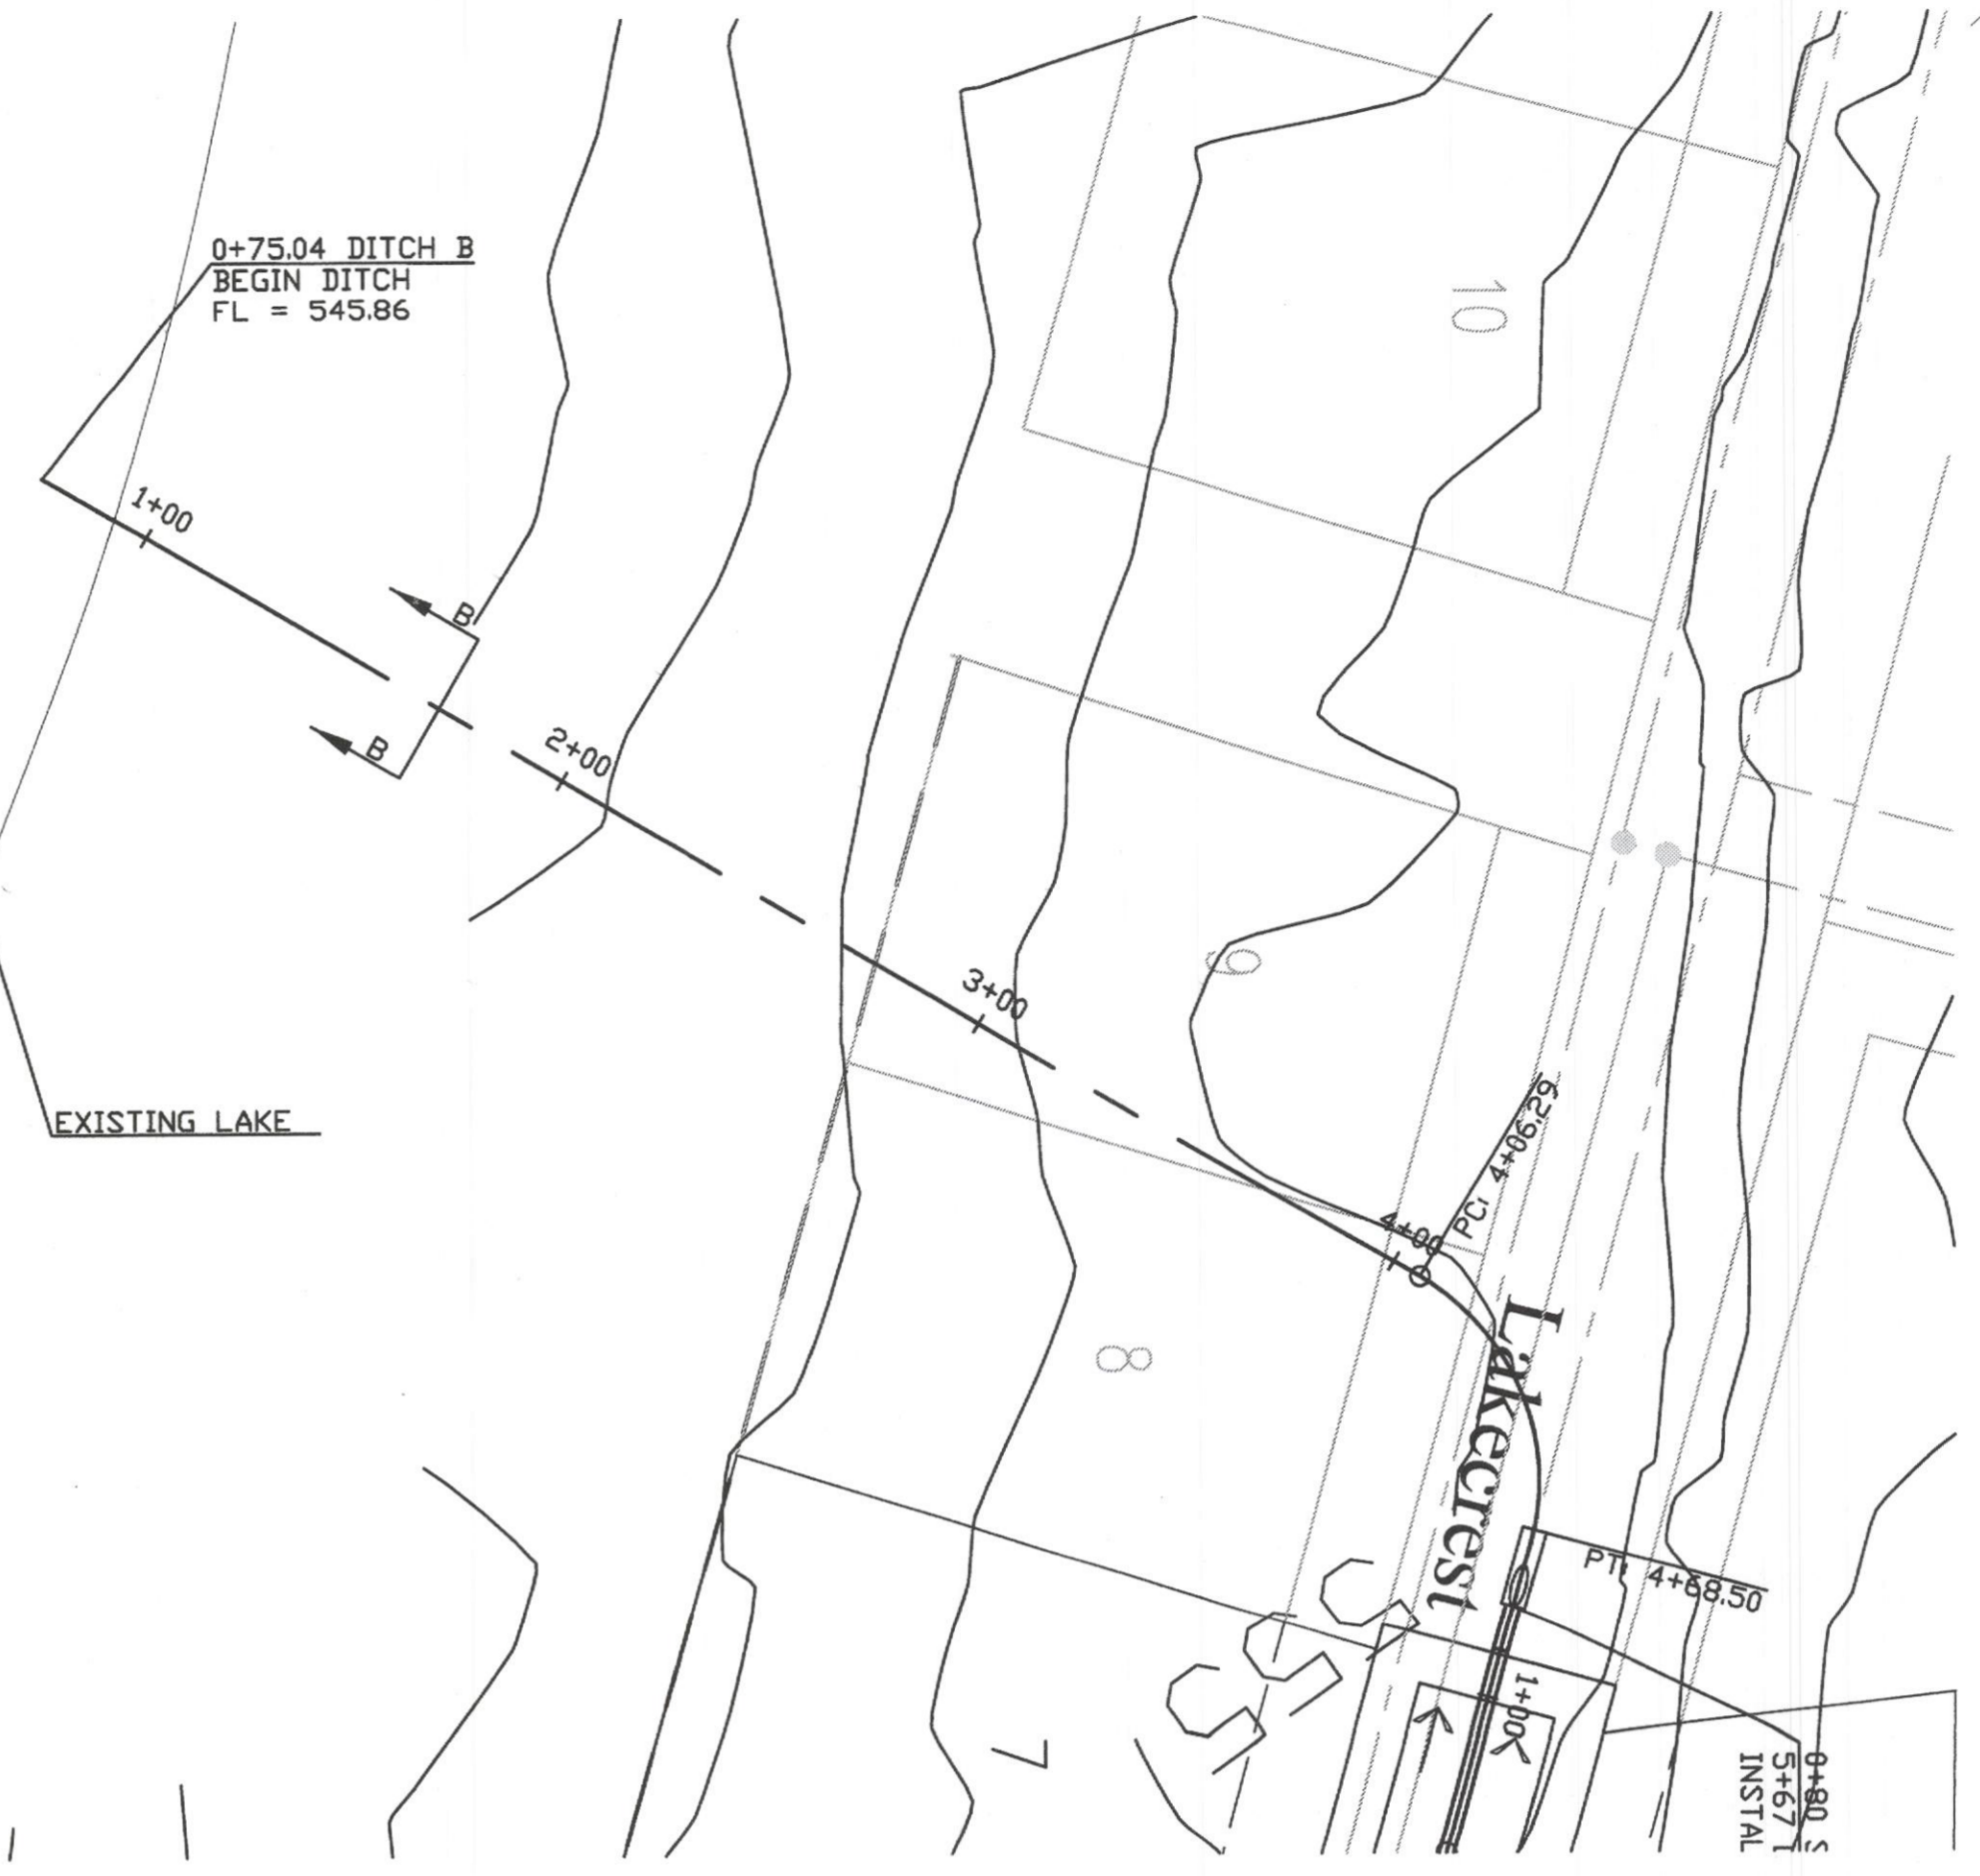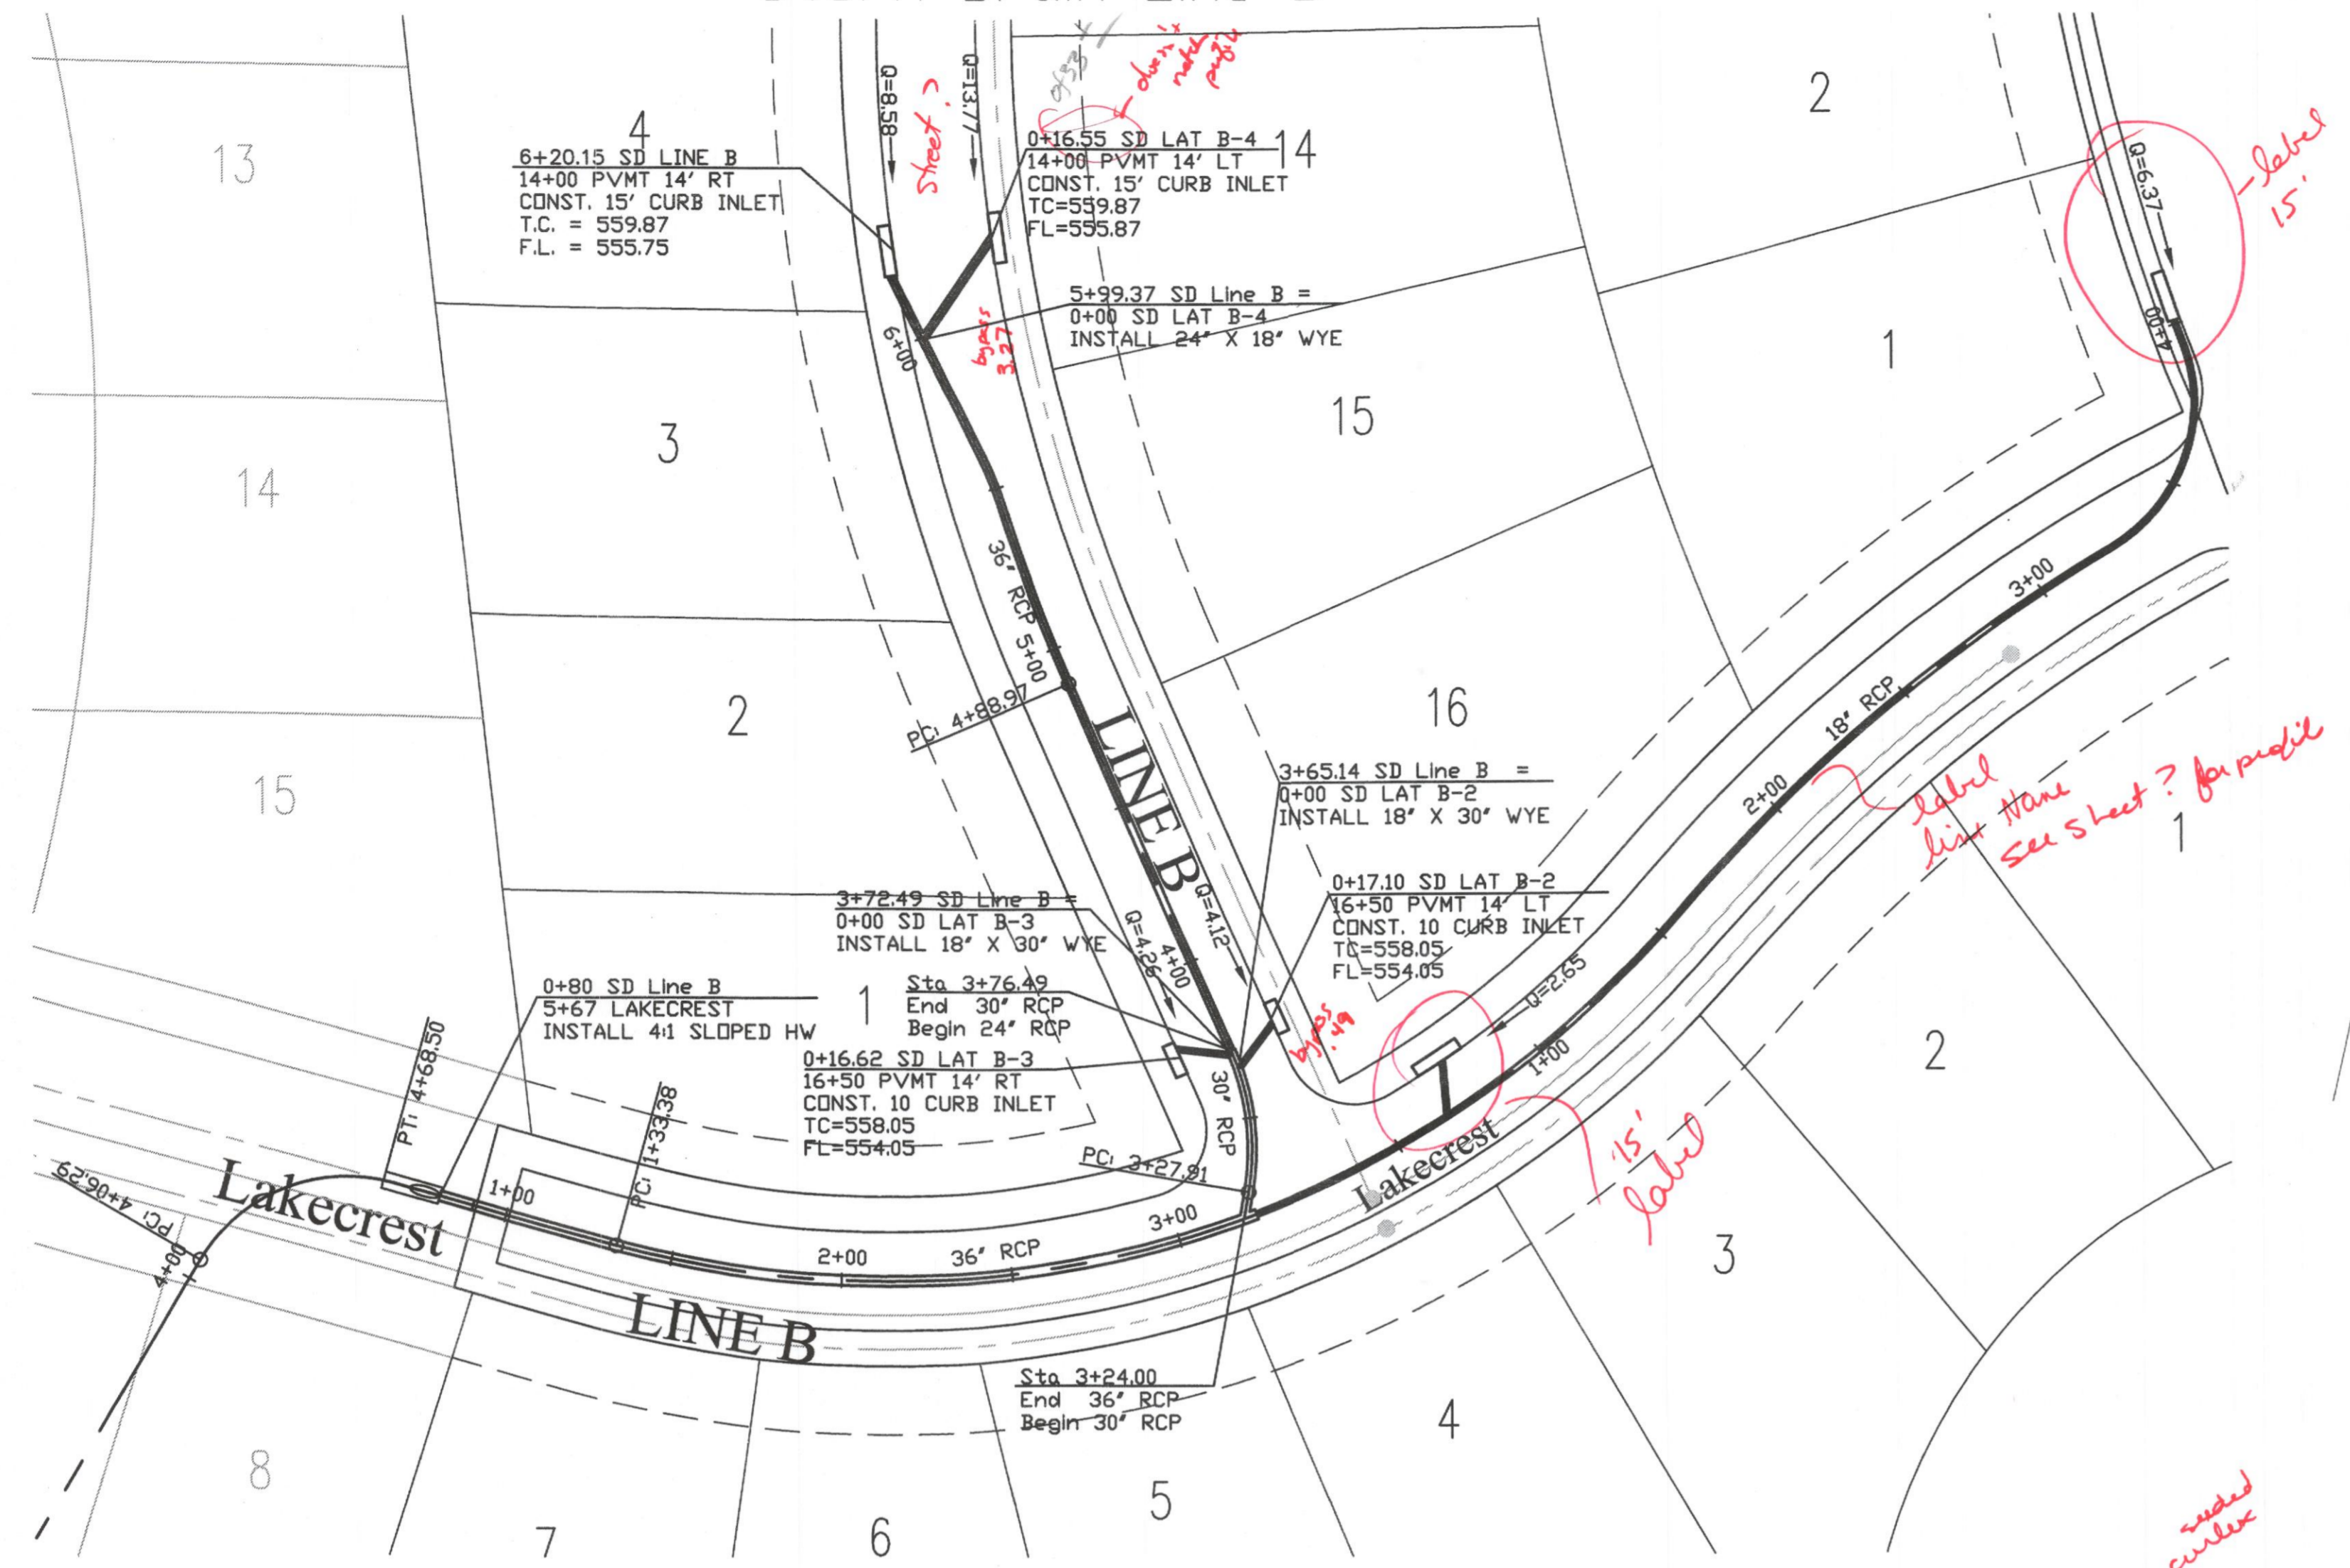

SD CENTERLINE CURVE TABLE


CURVE	DELTA	RADIUS	LENGTH	CHORD	BEARING
C19	35°37'2"	300.00	186.49	193.50	N 87°31'18" E
C20	33°10'40"	75.00	43.43	42.83	N 6°52'33" W
C21	6°17'6"	500.00	54.85	54.82	S 20°19'20" E
C22	8°55'23"	100.00	15.57	15.56	N 21°38'28" W

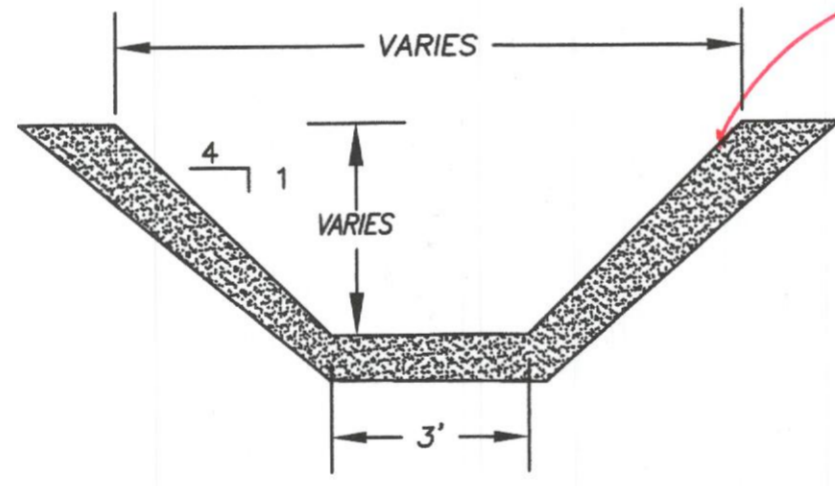

DITCH B PROFILE

DITCH CROSS-SECTION

SD Line B PROFILE

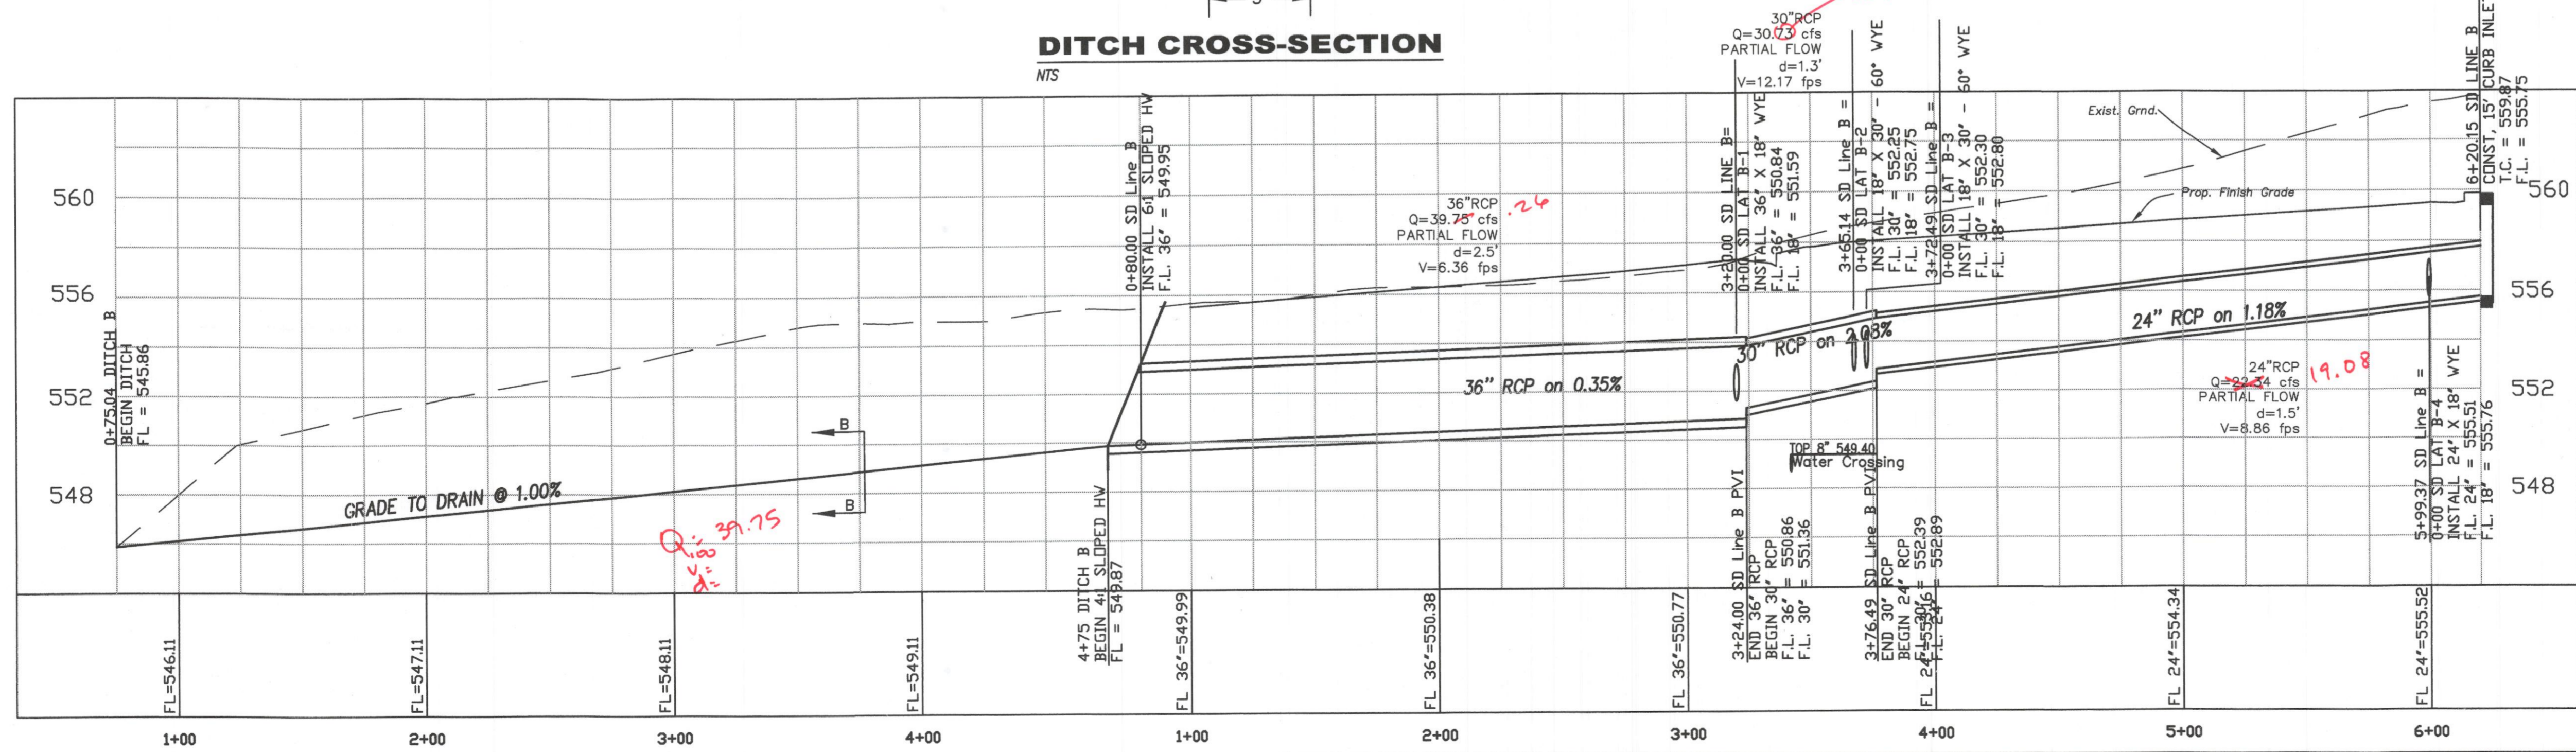

1+00 2+00 3+00 4+00 5+00 6+00