

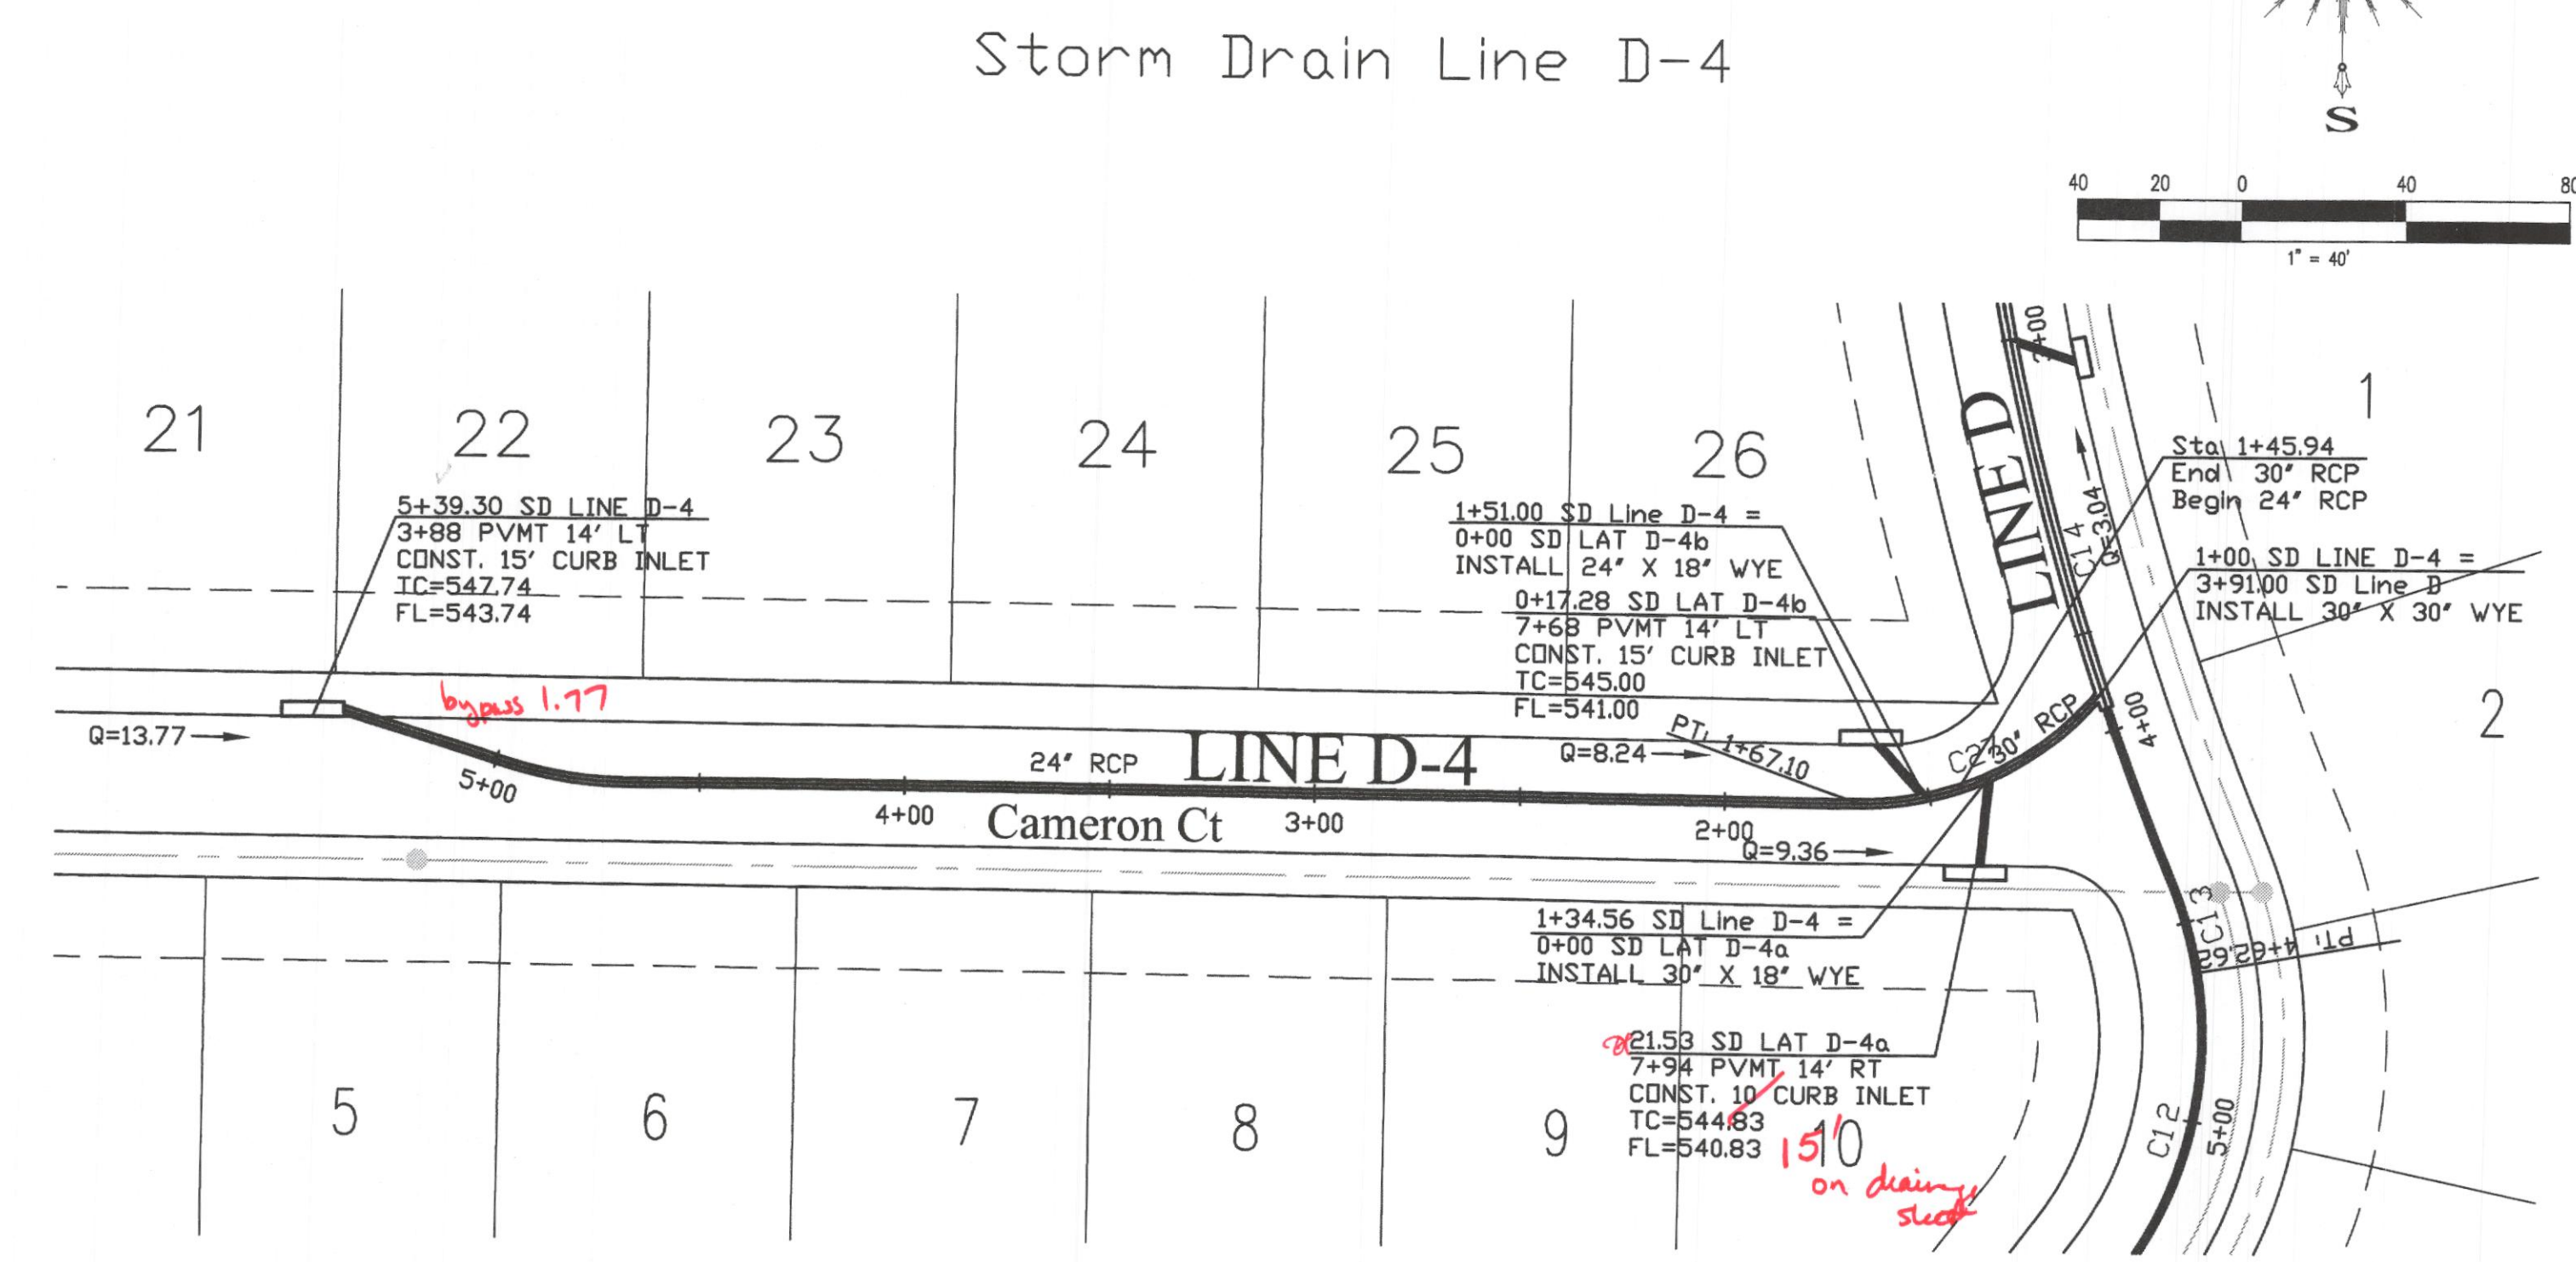
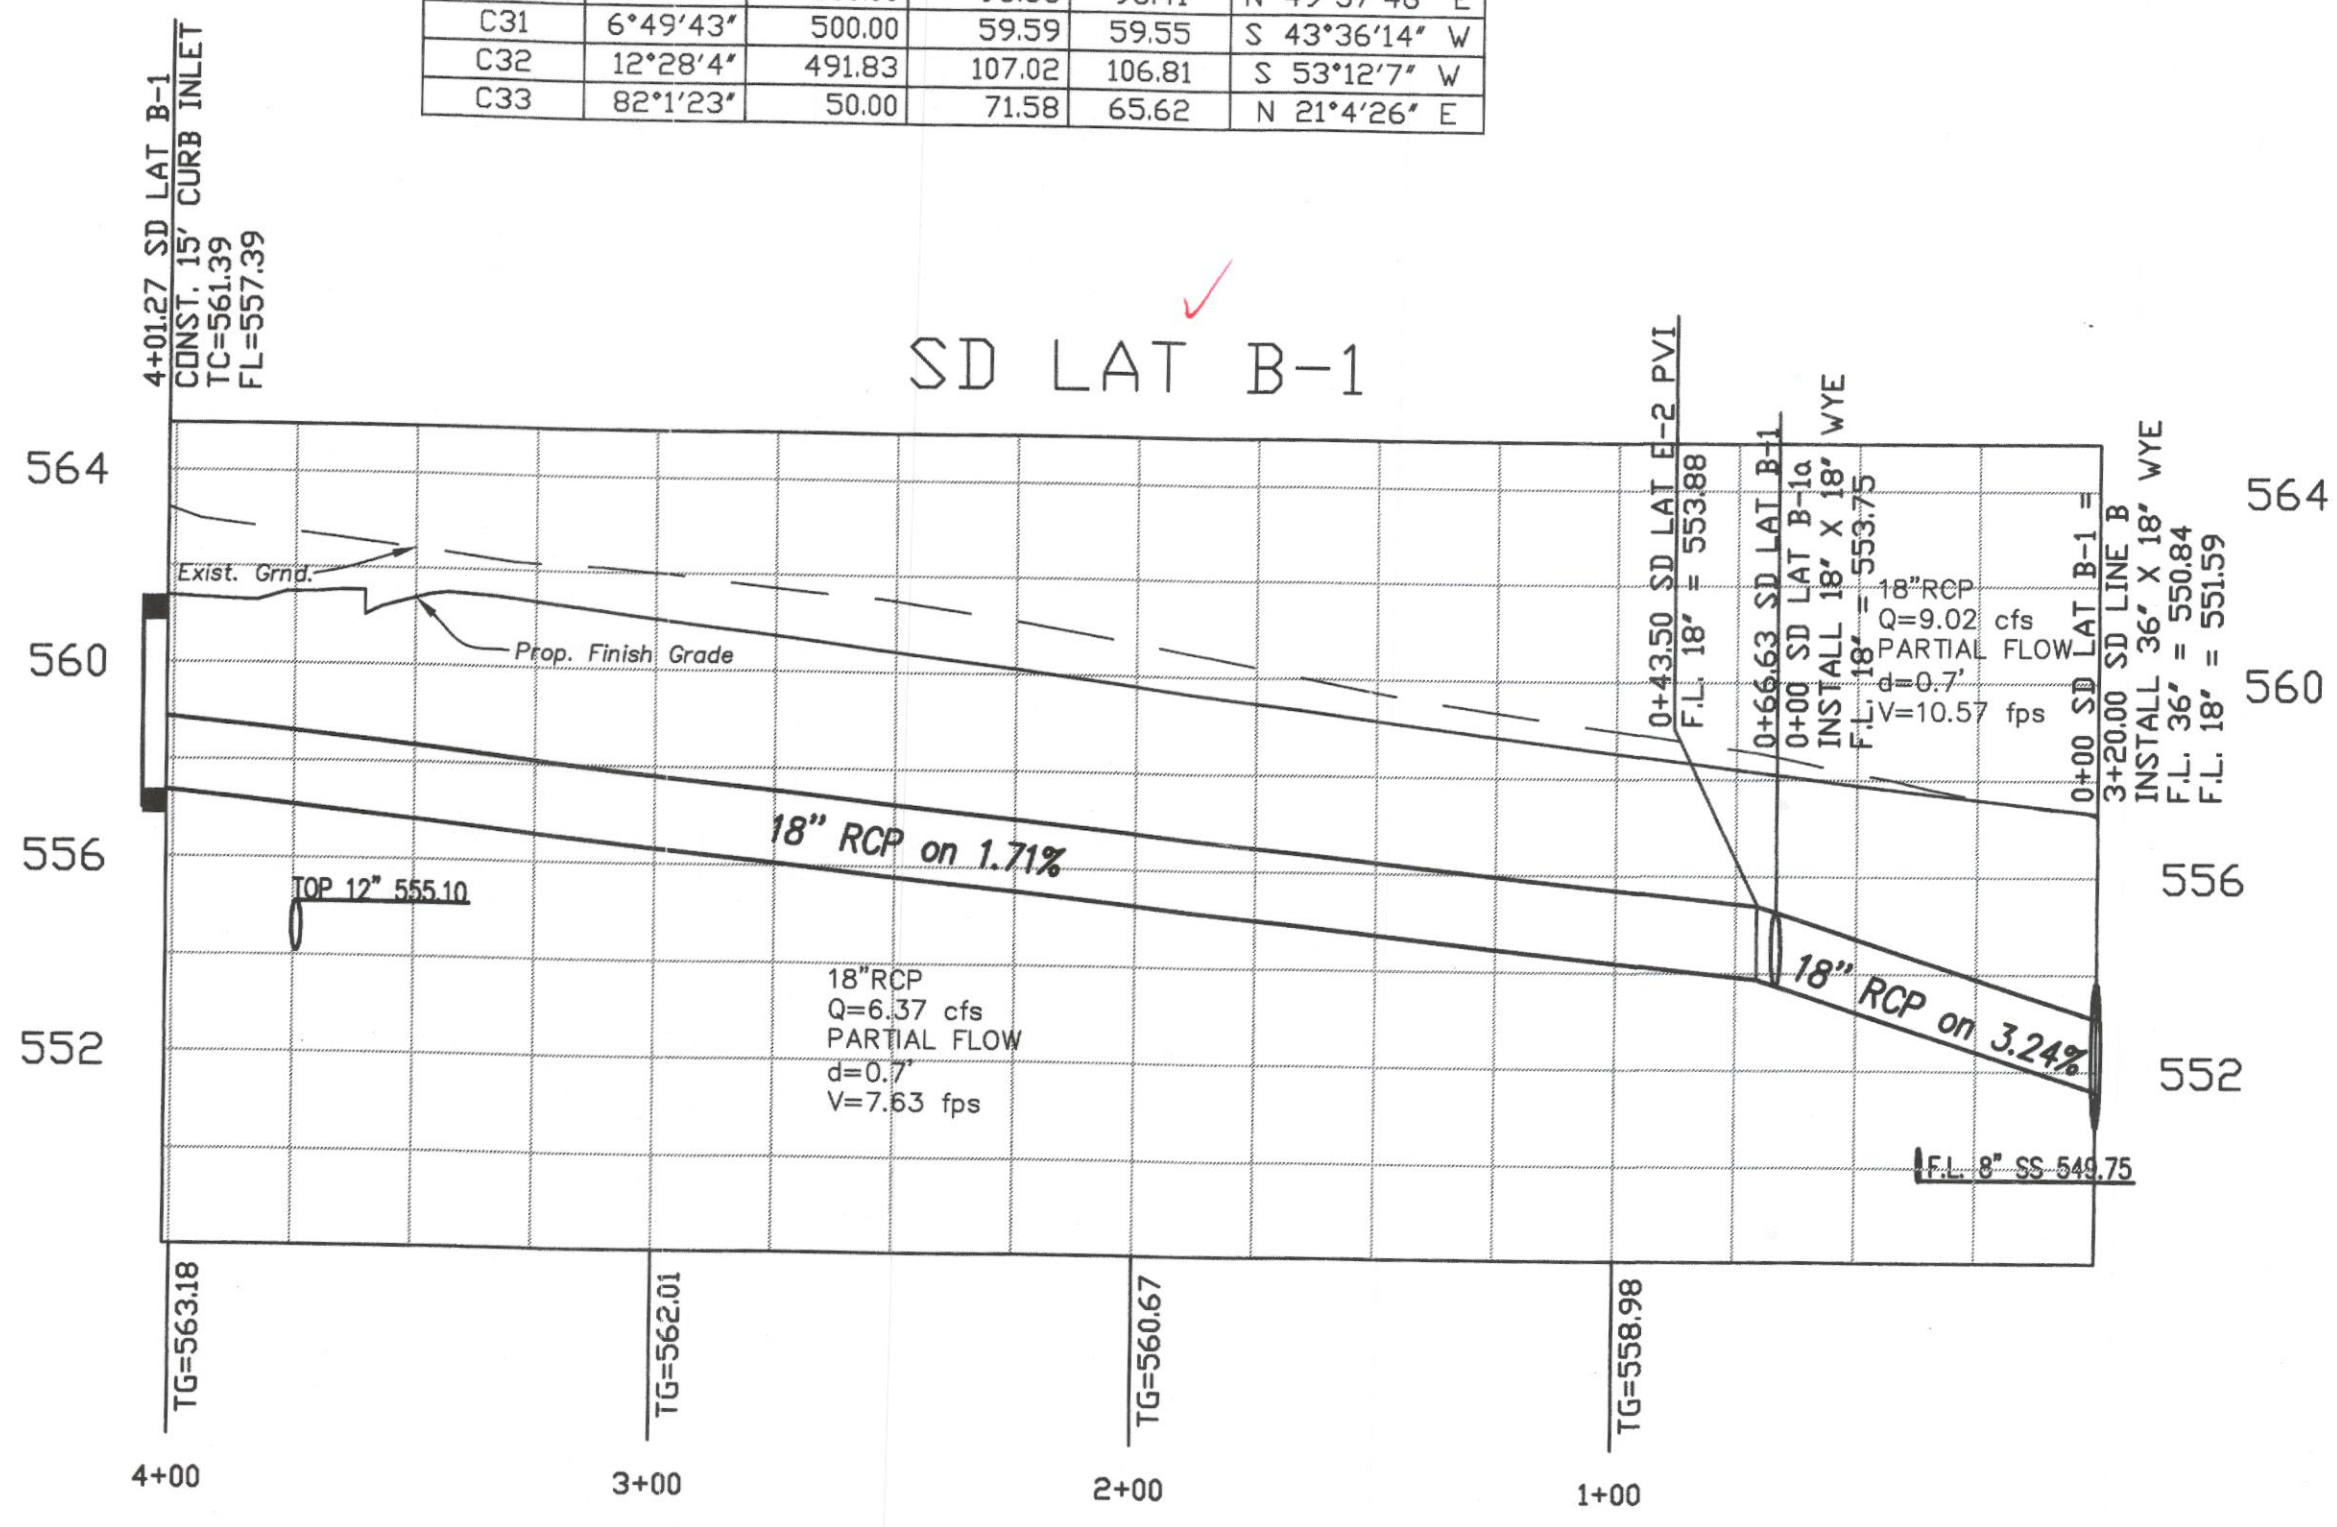


CURVE	DELTA	RADIUS	LENGTH	CHORD	BEARING
C28	7°0'11"	300.00	36.65	36.63	N 66°12'46" E
C29	3°38'38"	300.00	19.08	19.08	N 60°53'27" E
C30	18°52'46"	300.00	98.85	98.41	N 49°37'46" E
C31	6°49'43"	500.00	59.59	59.55	S 43°36'14" W
C32	12°28'4"	491.83	107.02	106.81	S 53°12'7" W
C33	82°1'23"	50.00	71.58	65.62	N 21°4'26" E

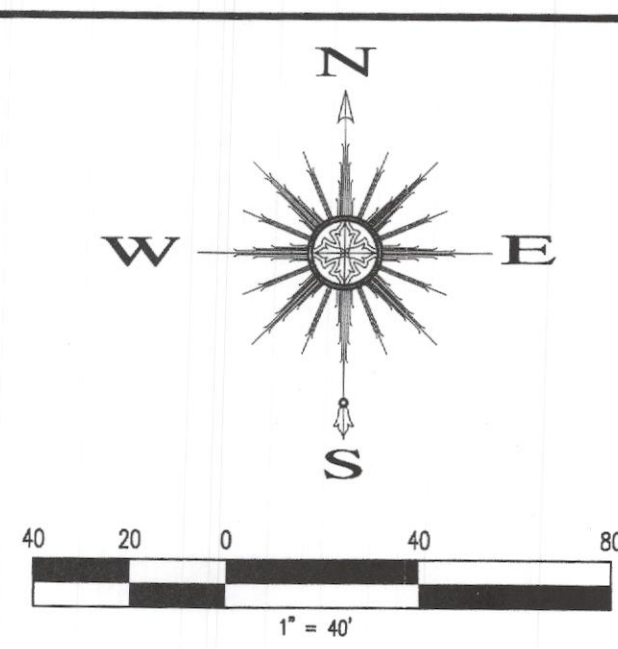

CURVE	DELTA	RADIUS	LENGTH	CHORD
C27	49°11'43"	75.00	64.40	62.44

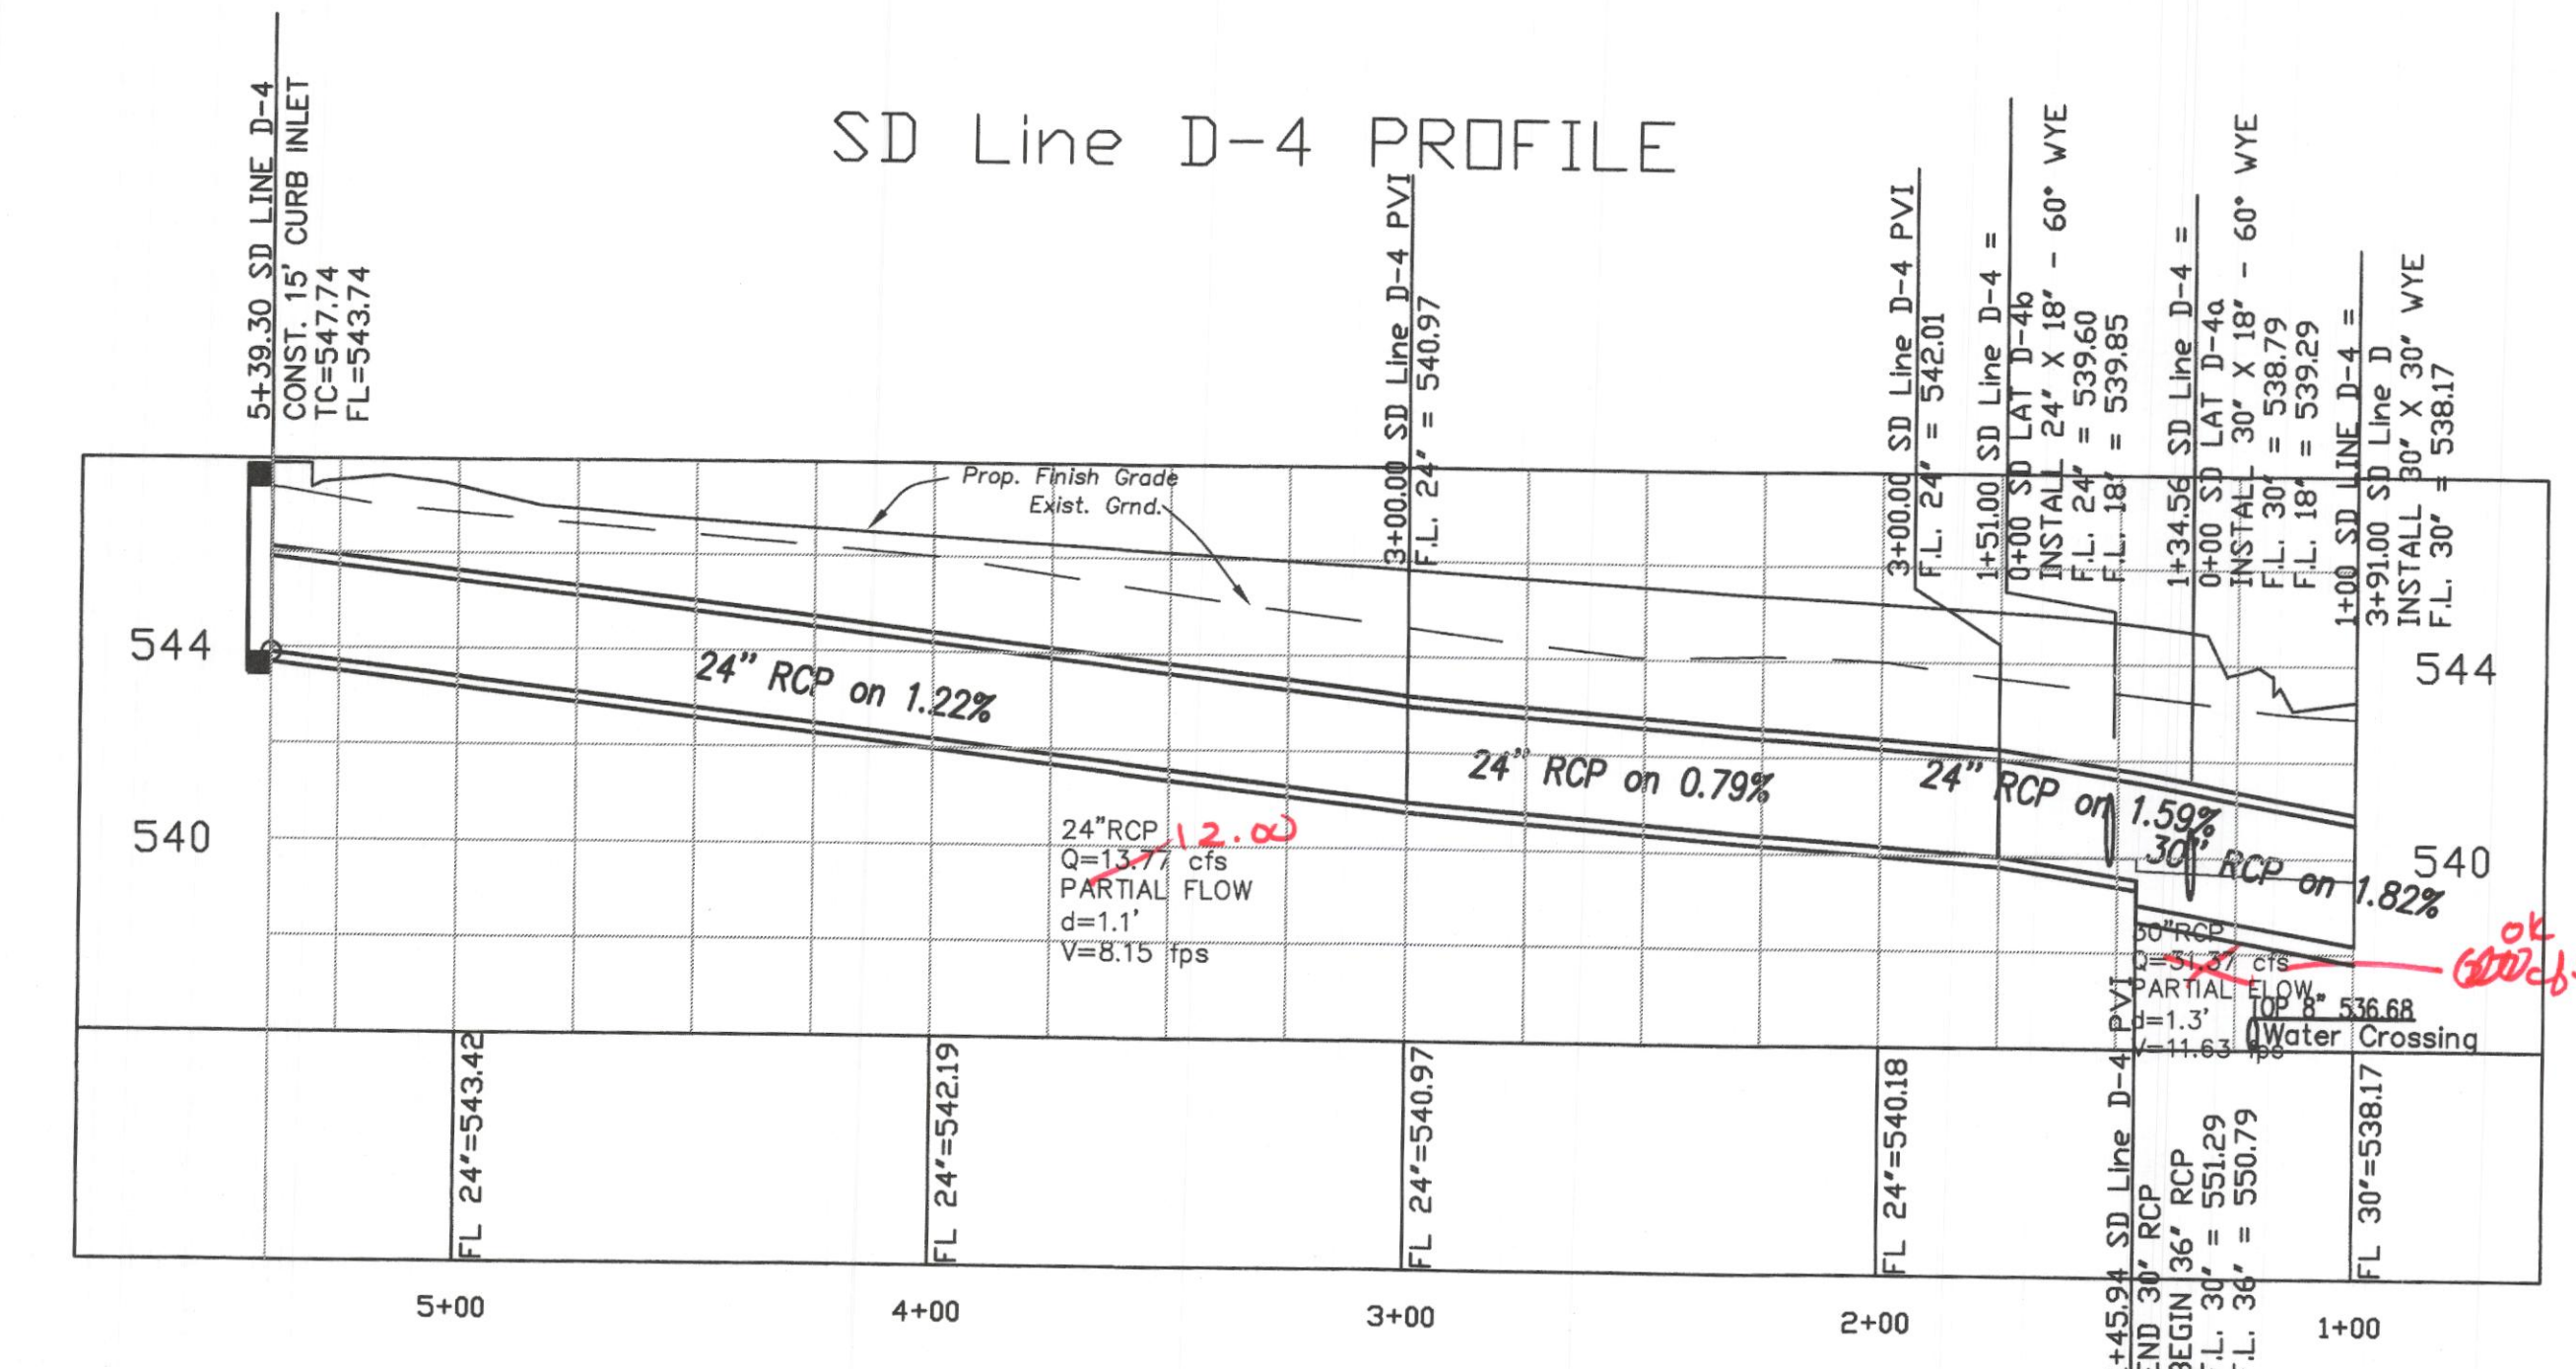


Revision	Date	Description

Owner:
SPRINGHAVEN INVESTMENTS, INC.
 6750 HILLCREST PLAZA DR. • STE. 325
 DALLAS, TEXAS 75230 • Phone: 972-366-3333

The Highlands

F.C. CUNY CORPORATION
 #2 Horizon Court • Ste. 500 • Heath, Texas 75032
 Phone: 469-402-7700
 Fax: 469-402-0700

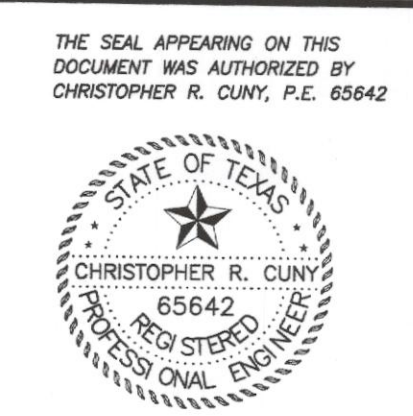

Drawn By: MSC	Checked By: JW
Date: 09/25/2007	Project No.: 06-004
Sheet Title: Storm Drain Line D-4 Plan & Profile	
Scale: 1" = 40'	Sheet No.: 38 of 61