


Sewer Line-I PROFILE

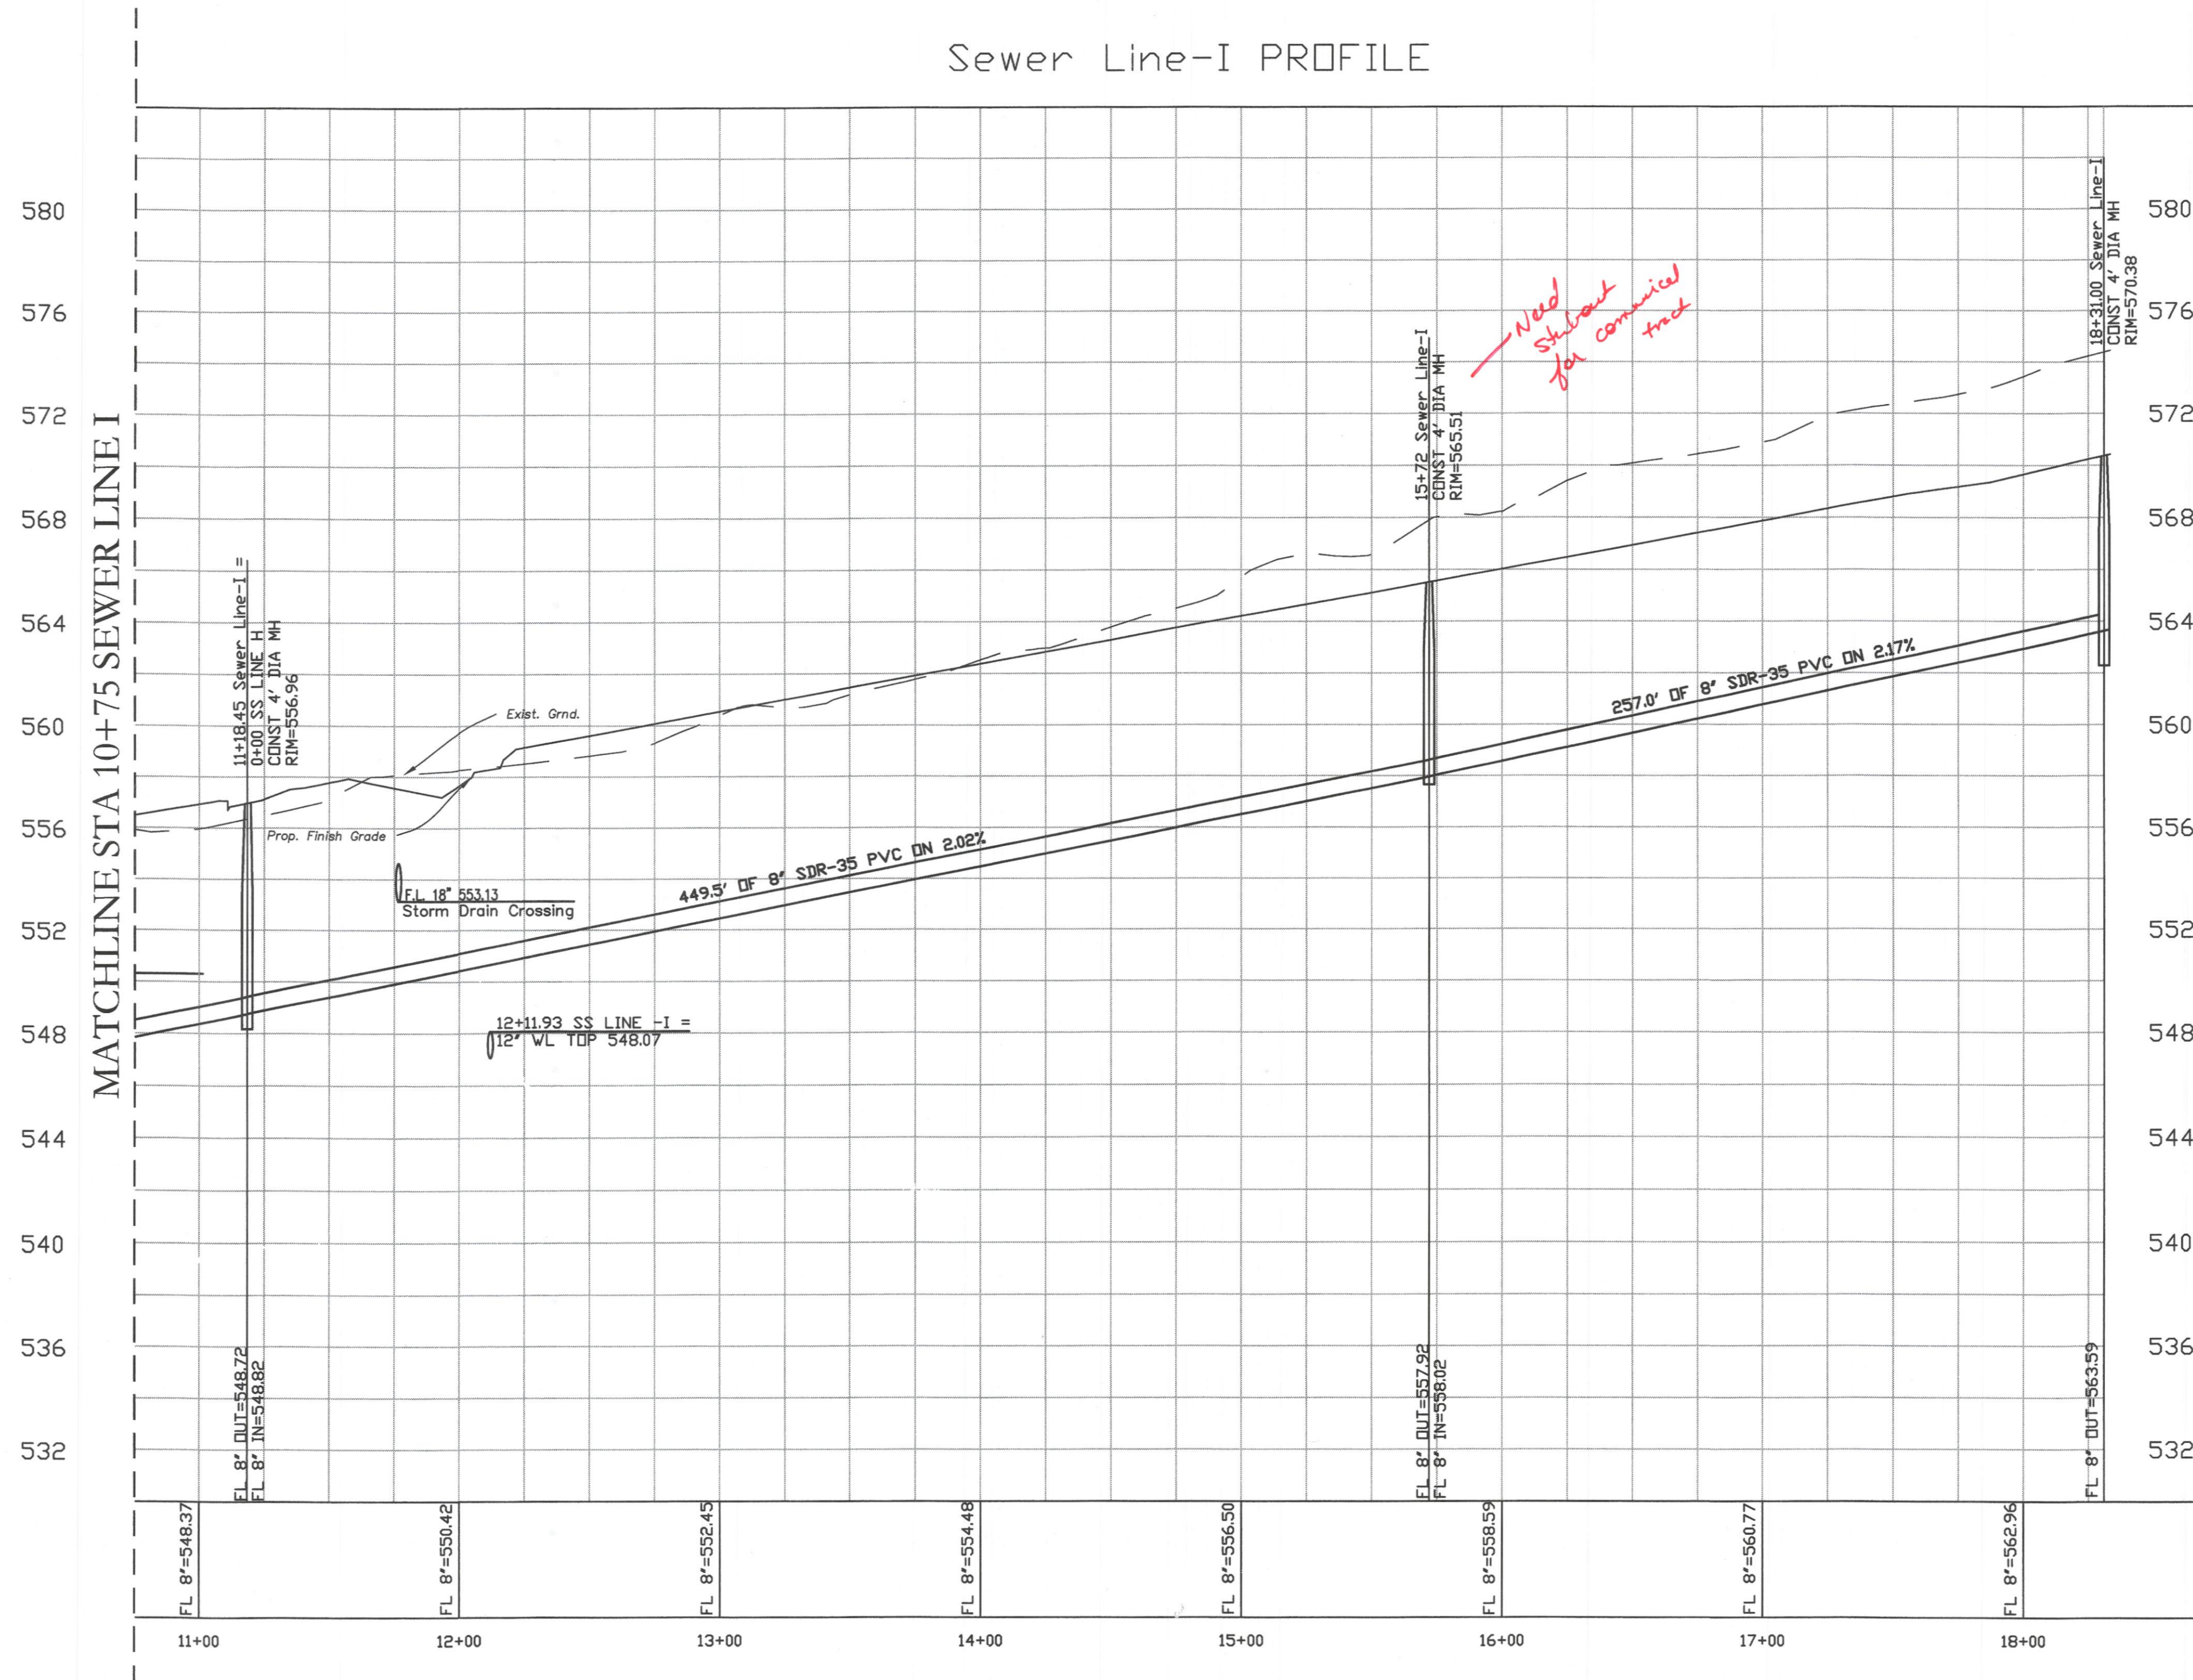

Need Strain for Commercial track

Revision	Date	Description

Owner:
SPRINGHAVEN INVESTMENTS, INC.
 6750 HILLCREST PLAZA DR. • STE 325
 DALLAS, TEXAS 75230 • Phone: 972-386-3333

**The
Highlands**

F.C. CUNY CORPORATION
 #2 Horizon Court • Ste. 500 • Heath, Texas 75032
 Phone: 469-402-7700
 Fax: 469-402-0700

THE SEAL APPEARING ON THIS DOCUMENT WAS AUTHORIZED BY CHRISTOPHER R. CUNY, P.E. 65642



Drawn By: MSC	Checked By: JW
Date: 08/25/2007	Project No.: 06-004
Sheet Title: SEWER LINE I Profile (10+75 - 18+31)	
Scale: 1" = 40'	Sheet No.: 51 of 61