


Revision	Date	Description



Owner:  
**SPRING HAVEN INVESTMENTS, INC.**  
 6750 HILLCREST PLAZA DR. • STE 325  
 DALLAS, TEXAS 75230 • Phone: 972-386-3333

**The Highlands**

**F.C. CUNY CORPORATION**  
 #2 Horizon Court • Ste. 500 • Heath, Texas 75032  
 Phone: 469-402-7700  
 Fax: 469-402-0700

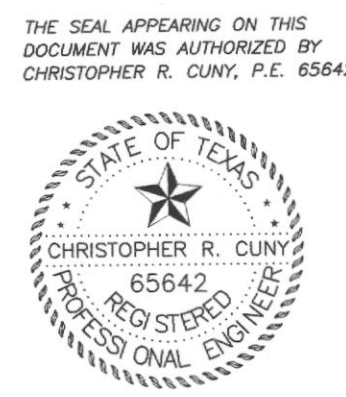

Drawn By: MSC	Checked By: JW
Date: 09/25/2007	Project No.: 06-004
Sheet Title: <b>UTILITY PLAN</b>	
Scale: 1" = 100'	Sheet No.: 59 of 61

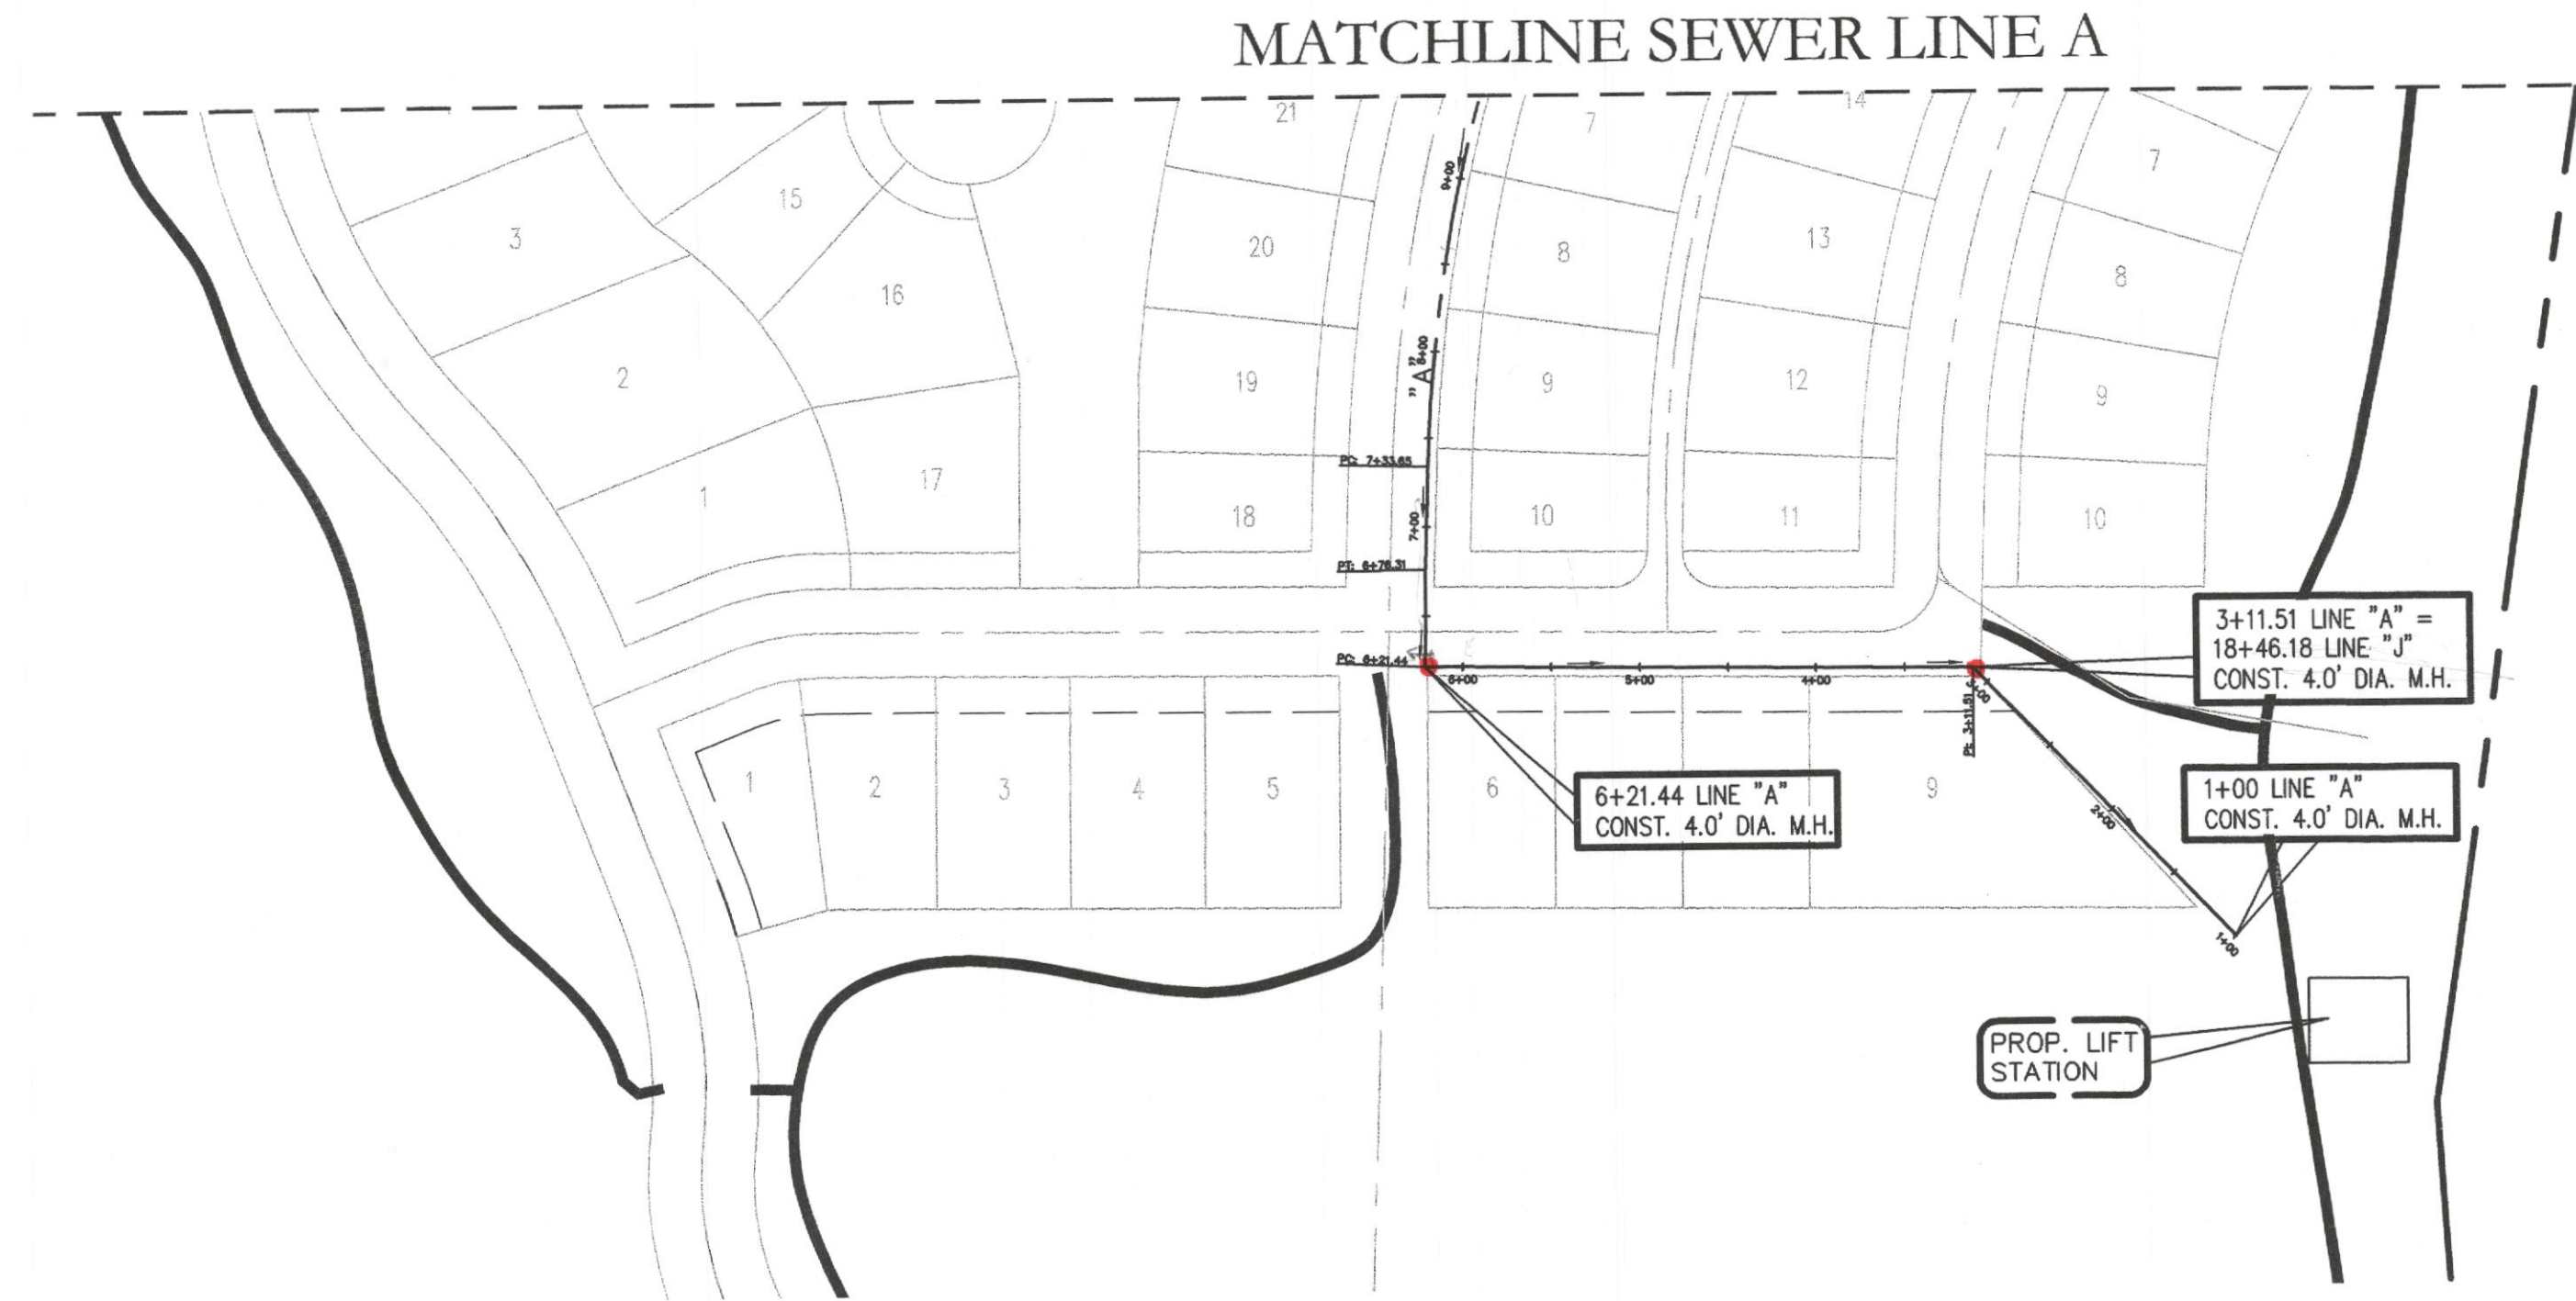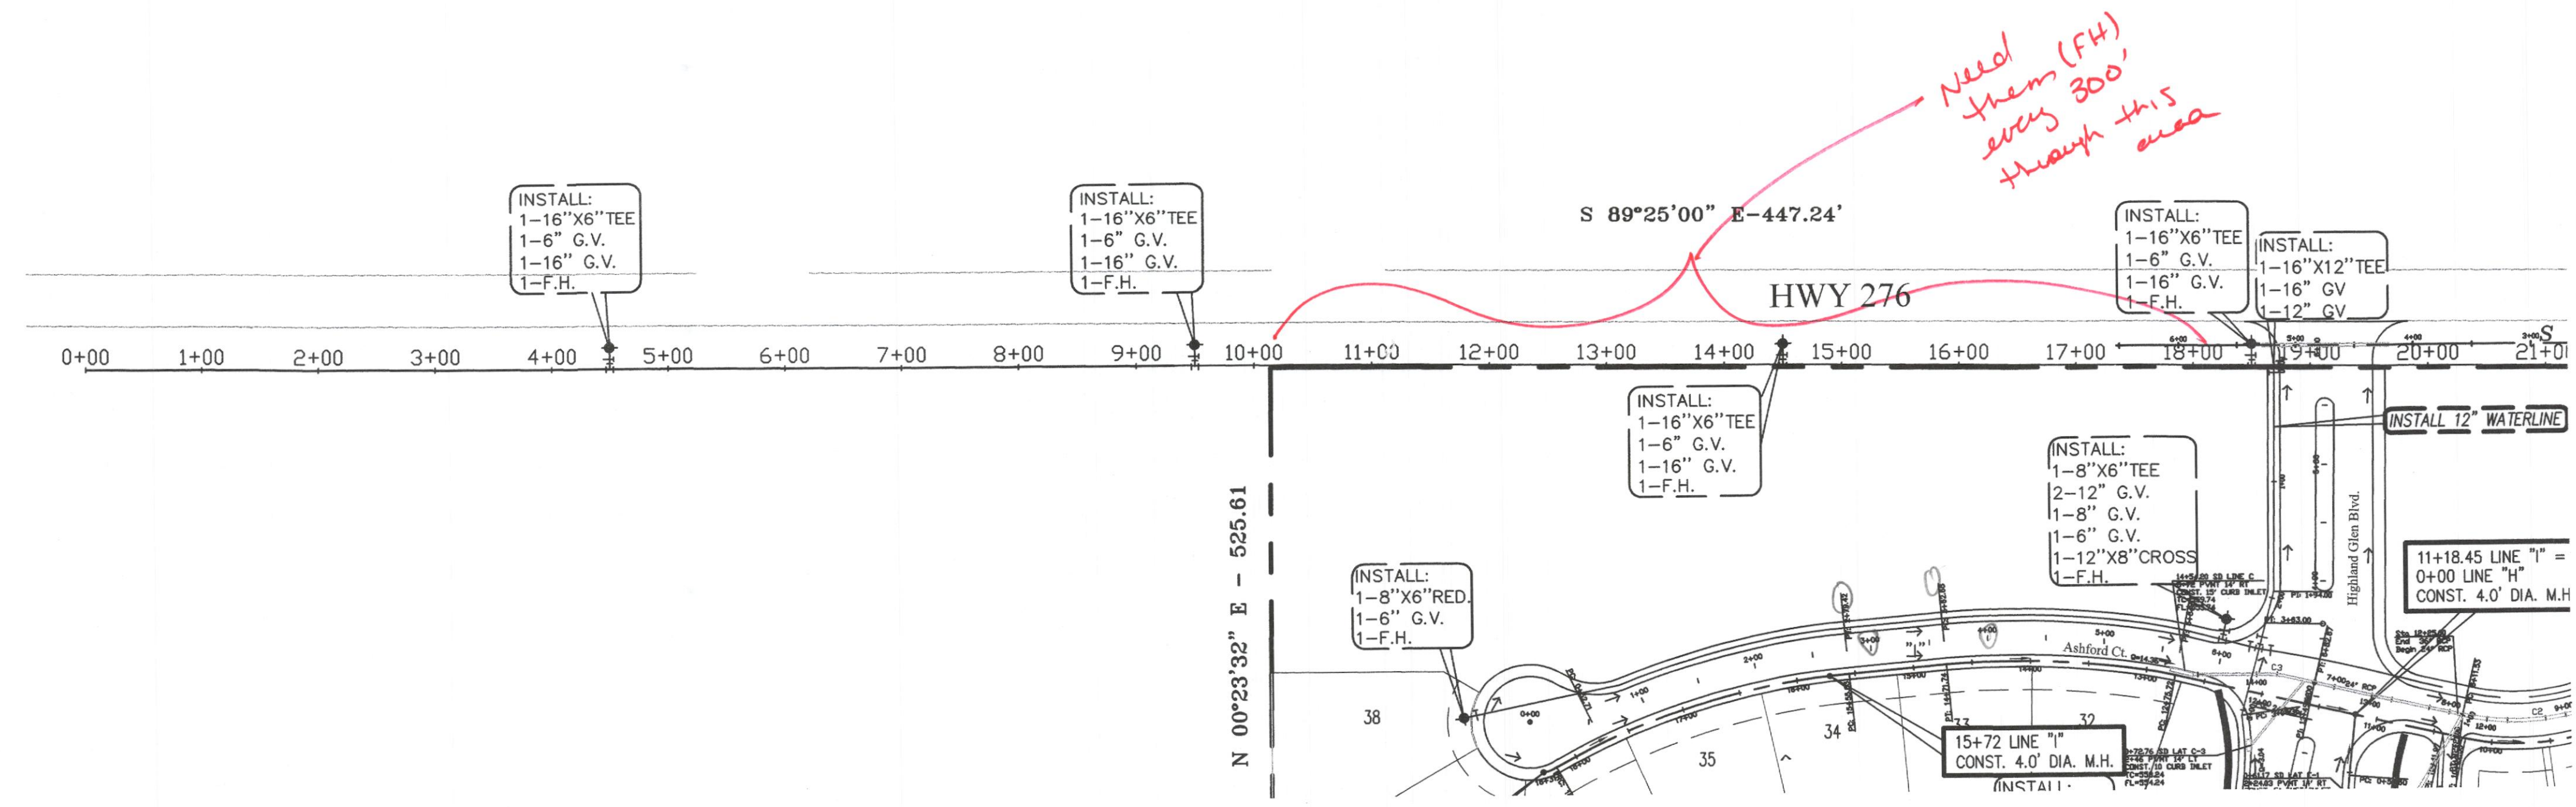

*Handwritten notes:*  
 - Check end of station pump capacity - check  
 - Need lift station plans, report, details, 3 phase station  
 - Run into  
 - If you want to see the station on approx. required...

NOTE:  
 NO SERVICE CONNECTIONS ON  
 SEWER LINE A STA 0+00.00-14+70.28

