



Turner

Construction Managers/General Contractors
460 West Dussel Drive
Maumee, Ohio 43537
p | 419.893.7000 f | 419.893.1741
www.turnerconstruction.com/lathrop

CONSULTANTS:

PREPARED BY:
WIA WIER & ASSOCIATES, INC.
ENGINEERS SURVEYORS LAND PLANNERS
701 HIGHLANDER BLVD., SUITE 300 ARLINGTON, TEXAS 76015 METRO (817)467-7700
8948 ELM STREET FRIEDO, TEXAS 75044 METRO (214)387-8000
Texas Firm Registration No. F-2776 www.WierAssociates.com

SEAL ON THIS DOCUMENT AUTHORIZED BY:



SEAL ID: [Signature]
DATE: 5/19/12

PROJECT INFORMATION:

**ROCKWALL
TECHNOLOGY PARK
PHASE III
BIMBO BAKERIES USA
ROCKWALL, TEXAS**

CLIENT INFORMATION:

ALLEN FOODS, INC
3055 Discovery Blvd.
Rockwall, Texas
75032

CLIENT PROJECT NO: 00-00000-00

NO.	DATE	SUBJECT
1	XXXXXX	REVISION NAME
	X	


PROJECT NO: WA # 12002
PROJECT MANAGER: RON RAMIREZ, P.E.
DESIGNED:
CHECKED: RON RAMIREZ, P.E.

DRAWING TITLE:
**SEDIMENTATION
POND 'A' PLAN**

DRAWING NO:

C-E102

DATE: 04-27-2012

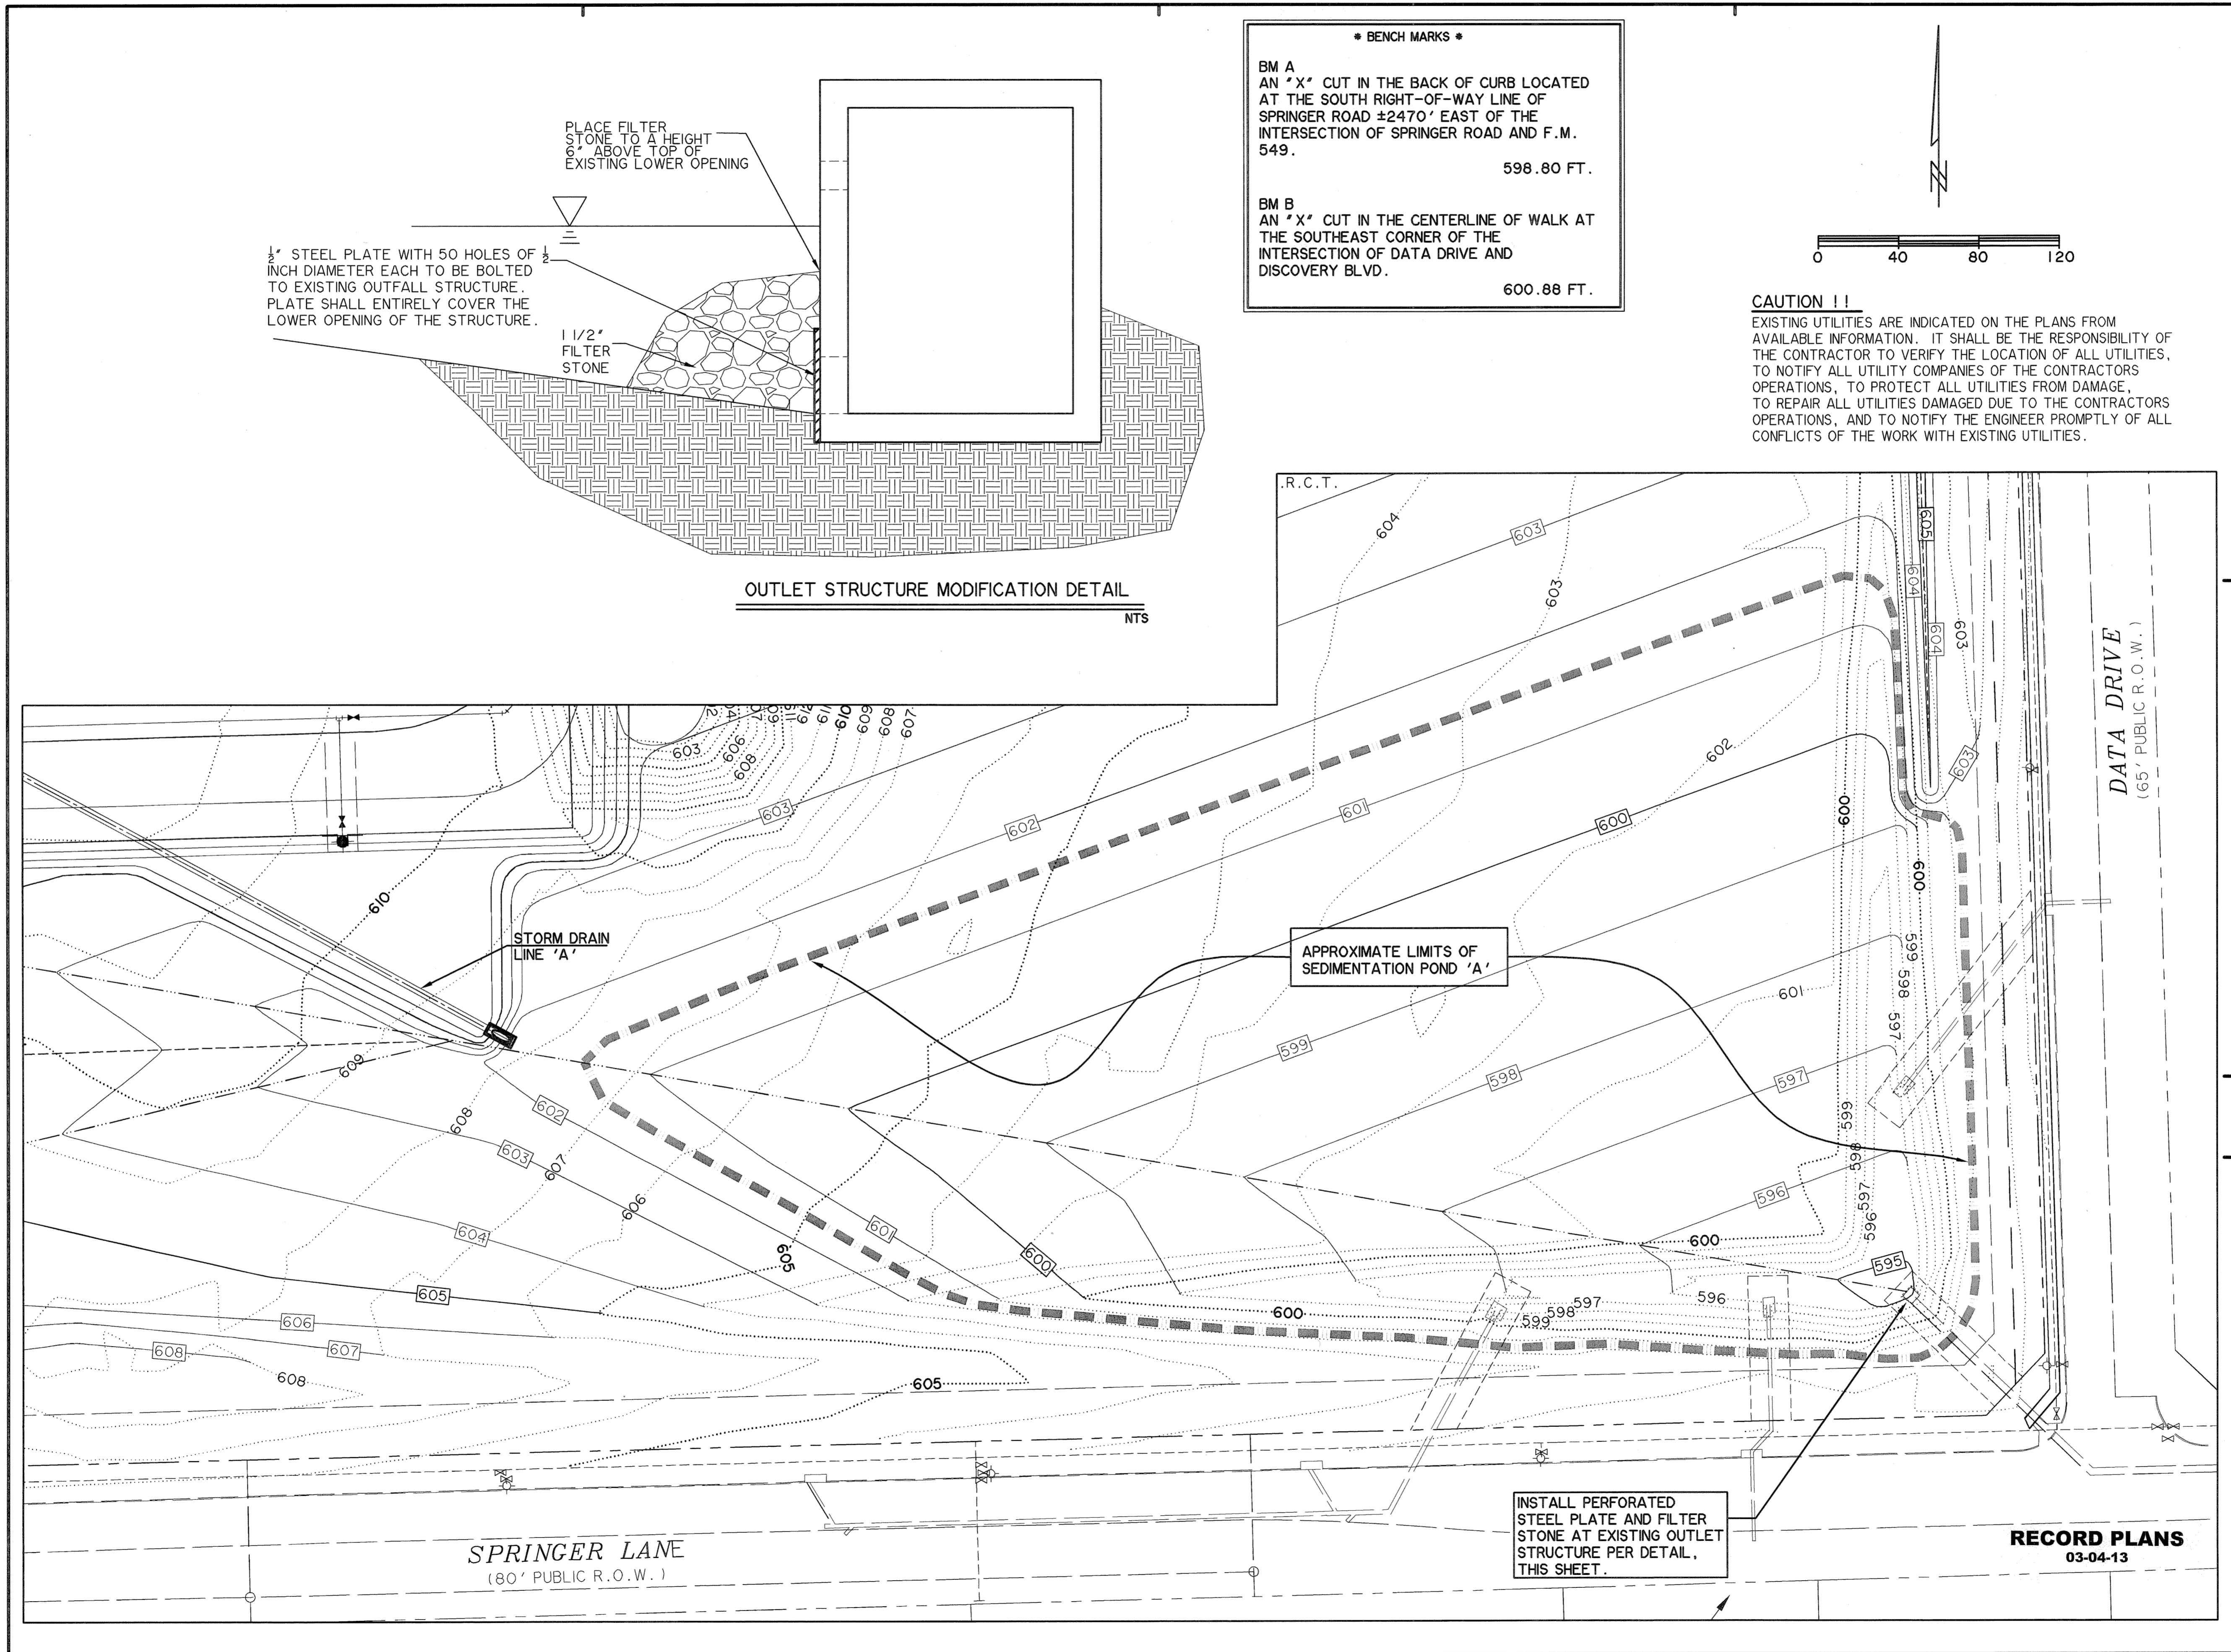

FILE: E102-SEDIMENTATION-POND-A-12002.dwg
TIME: 14:49