


FILE: U102-WATER LAYOUT-SHEET2-12002.dwg
 TIME: 13:36

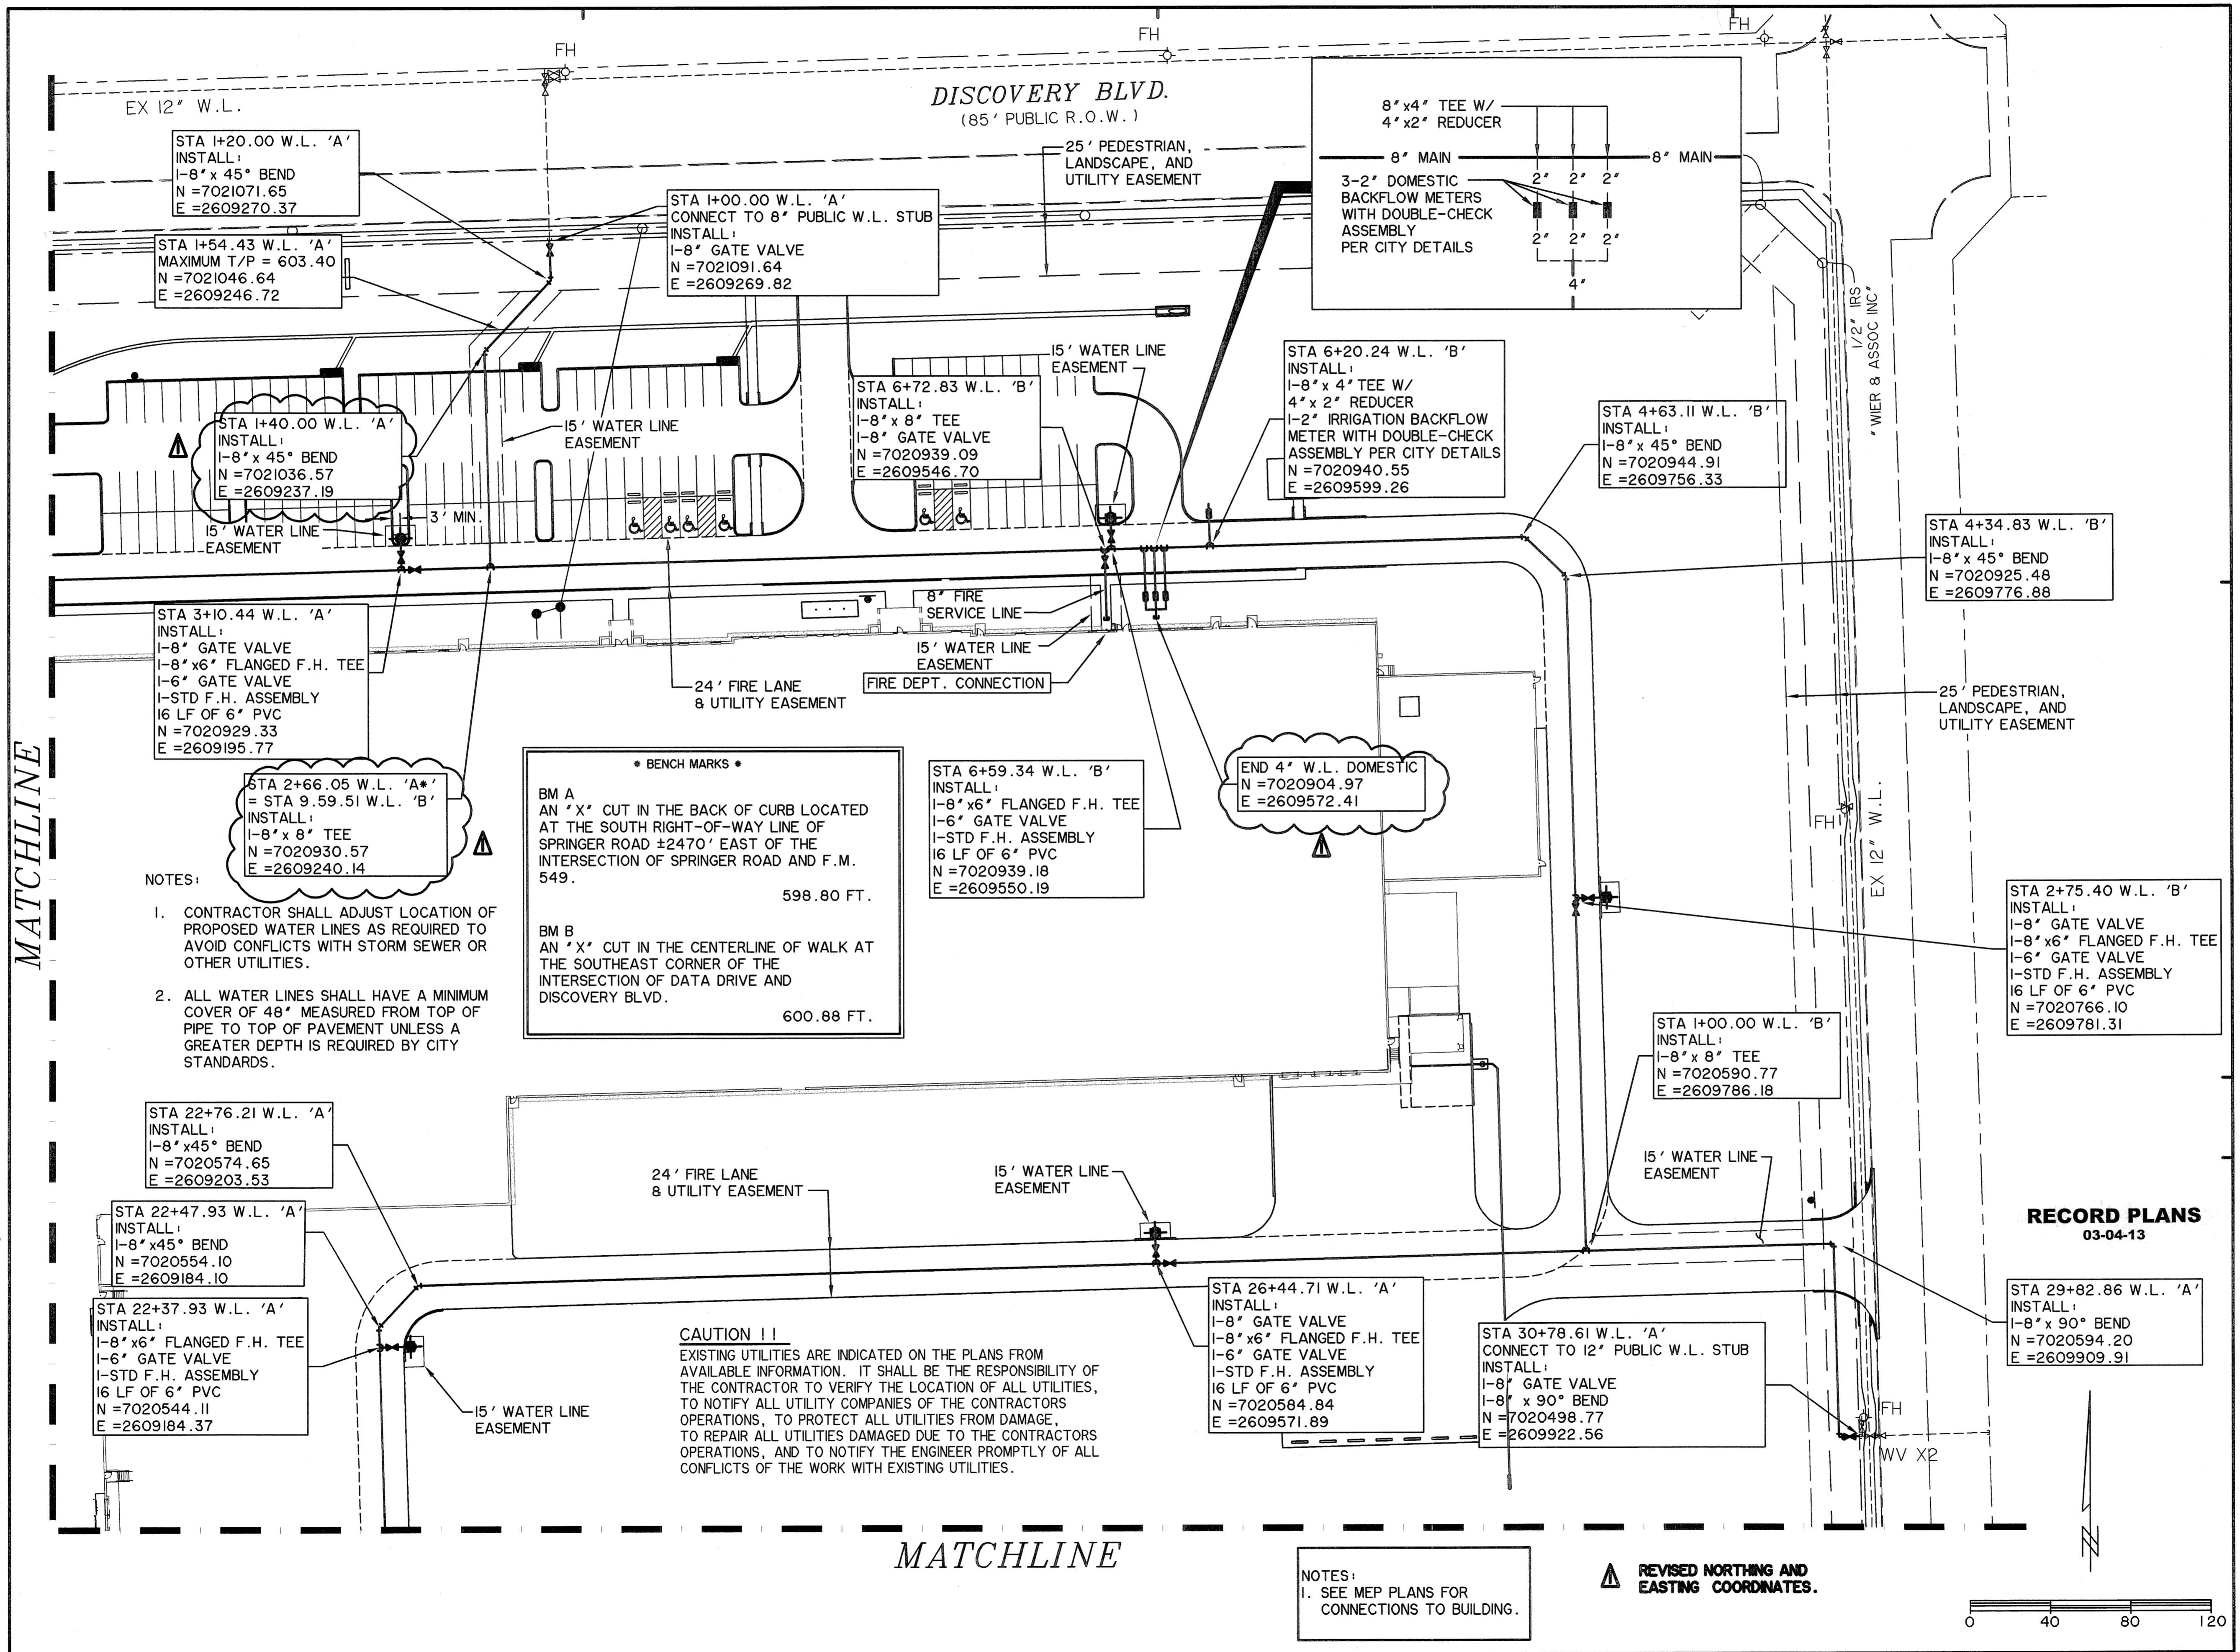

MATCHLINE

MATCHLINE

- NOTES:
- CONTRACTOR SHALL ADJUST LOCATION OF PROPOSED WATER LINES AS REQUIRED TO AVOID CONFLICTS WITH STORM SEWER OR OTHER UTILITIES.
 - ALL WATER LINES SHALL HAVE A MINIMUM COVER OF 48" MEASURED FROM TOP OF PIPE TO TOP OF PAVEMENT UNLESS A GREATER DEPTH IS REQUIRED BY CITY STANDARDS.

*** BENCH MARKS ***


BM A
 AN "X" CUT IN THE BACK OF CURB LOCATED AT THE SOUTH RIGHT-OF-WAY LINE OF SPRINGER ROAD ±2470' EAST OF THE INTERSECTION OF SPRINGER ROAD AND F.M. 549.
 598.80 FT.

BM B
 AN "X" CUT IN THE CENTERLINE OF WALK AT THE SOUTHEAST CORNER OF THE INTERSECTION OF DATA DRIVE AND DISCOVERY BLVD.
 600.88 FT.

CAUTION !!
 EXISTING UTILITIES ARE INDICATED ON THE PLANS FROM AVAILABLE INFORMATION. IT SHALL BE THE RESPONSIBILITY OF THE CONTRACTOR TO VERIFY THE LOCATION OF ALL UTILITIES, TO NOTIFY ALL UTILITY COMPANIES OF THE CONTRACTORS OPERATIONS, TO PROTECT ALL UTILITIES FROM DAMAGE, TO REPAIR ALL UTILITIES DAMAGED DUE TO THE CONTRACTORS OPERATIONS, AND TO NOTIFY THE ENGINEER PROMPTLY OF ALL CONFLICTS OF THE WORK WITH EXISTING UTILITIES.

NOTES:
 1. SEE MEP PLANS FOR CONNECTIONS TO BUILDING.

▲ REVISED NORTHING AND EASTING COORDINATES.

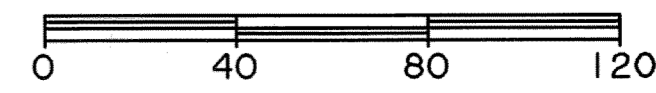

Turner

Construction Managers/General Contractors
 460 West Dussel Drive
 Maumee, Ohio 43537
 p | 419.893.7000 f | 419.893.1741
 www.turnerconstruction.com/lathrop

CONSULTANTS:

PREPARED BY:

WMA WIER & ASSOCIATES, INC.
 ENGINEERS SURVEYORS LAND PLANNERS
 701 HIGHLANDER BLVD., SUITE 300 ARLINGTON, TEXAS 76010 METRO (817)467-7700
 6849 ELM STREET FRODO, TEXAS 75044 METRO (214)307-8000
 Texas Firm Registration No. F-2776 www.WierAssociates.com

SEAL ON THIS DOCUMENT AUTHORIZED BY:

SEAL ID: [Signature]
 DATE: 5/14/12

PROJECT INFORMATION:

**ROCKWALL TECHNOLOGY PARK
 PHASE III
 BIMBO BAKERIES USA
 ROCKWALL, TEXAS**

CLIENT INFORMATION:

ALLEN FOODS, INC
 3055 Discovery Blvd.
 Rockwall, Texas
 75032

CLIENT PROJECT NO: 00-00000-00

NO.	DATE	SUBJECT

1 XXXXXX REVISION NAME
 X

PROJECT NO: **WA # 12002**
 PROJECT MANAGER: RON RAMIREZ, P.E.
 DESIGNED:
 CHECKED: RON RAMIREZ, P.E.

DRAWING TITLE:
WATER LAYOUT

DRAWING NO:
C-U102

DATE: 05-14-2012