

# THE CITY OF ROCKWALL, TEXAS

## CIVIL SITE IMPROVEMENTS

TO SERVE


LOT 3, BLOCK B

# ROCKWALL TECHNOLOGY PARK

## PHASE II



THE STANDARD SHEETS C-D304 AND C-D305 SPECIFICALLY IDENTIFIED IN THIS INDEX OF SHEETS HAVE BEEN SELECTED BY ME OR UNDER MY RESPONSIBLE SUPERVISION AS BEING APPLICABLE TO THIS PROJECT.

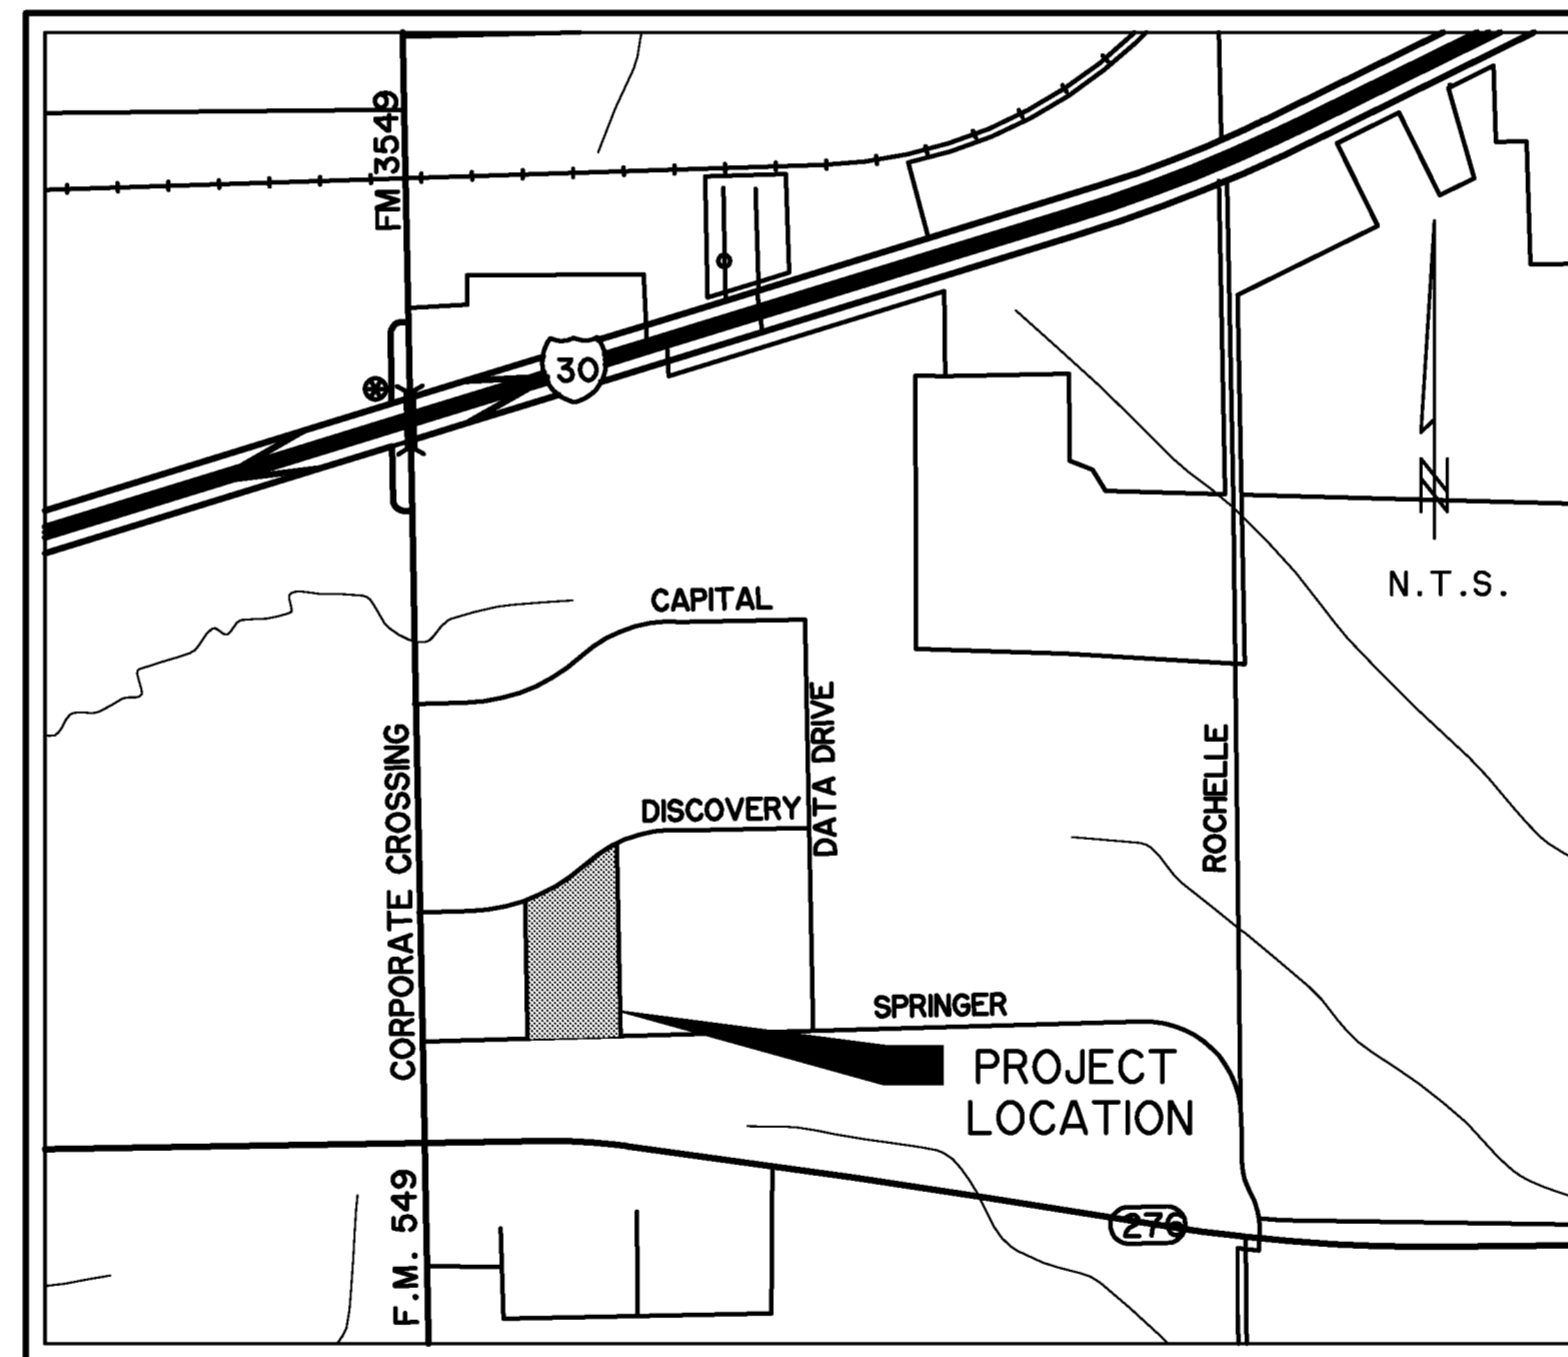

**VICINITY MAP**



PREPARED BY:  
**WIA WIER & ASSOCIATES, INC.**  
 ENGINEERS SURVEYORS LAND PLANNERS  
 701 HIGHLANDER BLVD., SUITE 300 ARLINGTON, TEXAS 76015 METRO (817)467-7700  
 Texas Firm Registration No. F-2776 www.WierAssociates.com

### SHEET INDEX



|        |  |
|--------|--|
|        | COVER SHEET                            |
|        | FINAL PLAT                             |
|        | SITE PLAN                              |
|        | LANDSCAPE PLAN                         |
|        | TOPOGRAPHIC LEGEND                     |
| C-S001 | PAVING NOTES                           |
| C-P001 | PAVING PLAN (SOUTH)                    |
| C-P101 | PAVING PLAN (NORTH)                    |
| C-P102 | PAVING DETAILS (SHEET 1 OF 2)          |
| C-P301 | PAVING DETAILS (SHEET 2 OF 2)          |
| C-P302 | EXISTING DRAINAGE AREA MAP             |
| C-D101 | PROPOSED DRAINAGE AREA MAP             |
| C-D102 | STORM DRAIN DESIGN CALCULATIONS        |
| C-D103 | STORM DRAIN PLAN (SOUTH)               |
| C-D104 | STORM DRAIN PLAN (NORTH)               |
| C-D105 | DETENTION POND                         |
| C-D106 | STORM DRAIN PROFILES (PUBLIC)          |
| C-D201 | STORM DRAIN PROFILES (PRIVATE)         |
| C-D202 | DETENTION POND DETAILS                 |
| C-D301 | DETENTION POND DETAILS                 |
| C-D302 | STORM DRAIN DETAILS                    |
| C-D303 | TxDOT SETP-CD HEADWALL DETAILS         |
| C-D304 | TxDOT SETP-CD HEADWALL DETAILS         |
| C-D305 | GRADING NOTES                          |
| C-G001 | GRADING PLAN (SOUTH)                   |
| C-G101 | GRADING PLAN (NORTH)                   |
| C-G102 | GRADING PLAN DETAIL                    |
| C-G103 | GRADING PLAN DETAIL                    |
| C-G104 | UTILITY NOTES                          |
| C-U001 | UTILITY PLAN (SOUTH)                   |
| C-U101 | UTILITY PLAN (NORTH)                   |
| C-U102 | EROSION CONTROL NOTES                  |
| C-E001 | EROSION CONTROL PLAN (SOUTH)           |
| C-E101 | EROSION CONTROL PLAN (NORTH)           |
| C-E102 | EROSION CONTROL DETAILS (SHEET 1 OF 3) |
| C-E201 | EROSION CONTROL DETAILS (SHEET 2 OF 3) |
| C-E202 | EROSION CONTROL DETAILS (SHEET 3 OF 3) |
| C-E203 |  |

**NOTE:**

- 1.) ALL REFERENCES TO "CITY" SHALL MEAN "CITY OF ROCKWALL".
- 2.) ALL CONSTRUCTION SHALL BE IN ACCORDANCE WITH THE NORTH TEXAS COUNCIL OF GOVERNMENT STANDARD SPECIFICATIONS (3RD EDITION) AND THE CITY OF ROCKWALL STANDARDS OF DESIGN AND CONSTRUCTION.
- 3) ANTICIPATED CONSTRUCTION START DATE: SEPTEMBER, 2014.

CITY OF ROCKWALL  
 STANDARD DETAIL SHEETS  
 INCORPORATED HEREIN  
 BY REFERENCE.

**RECORD PLANS**  
**October 28, 2015**

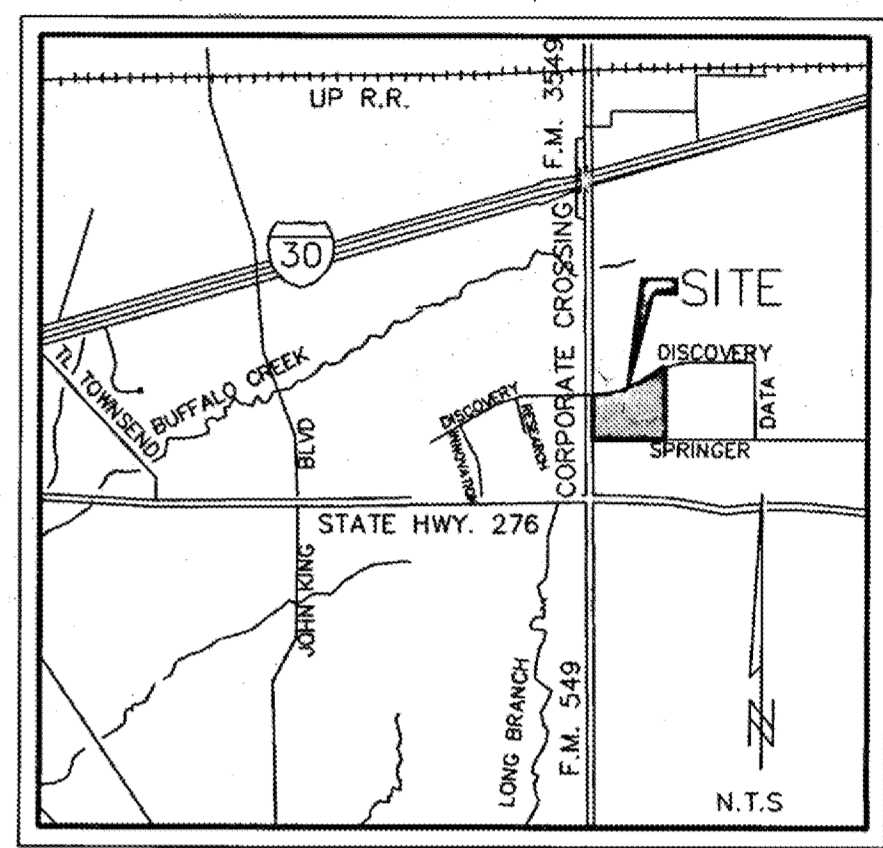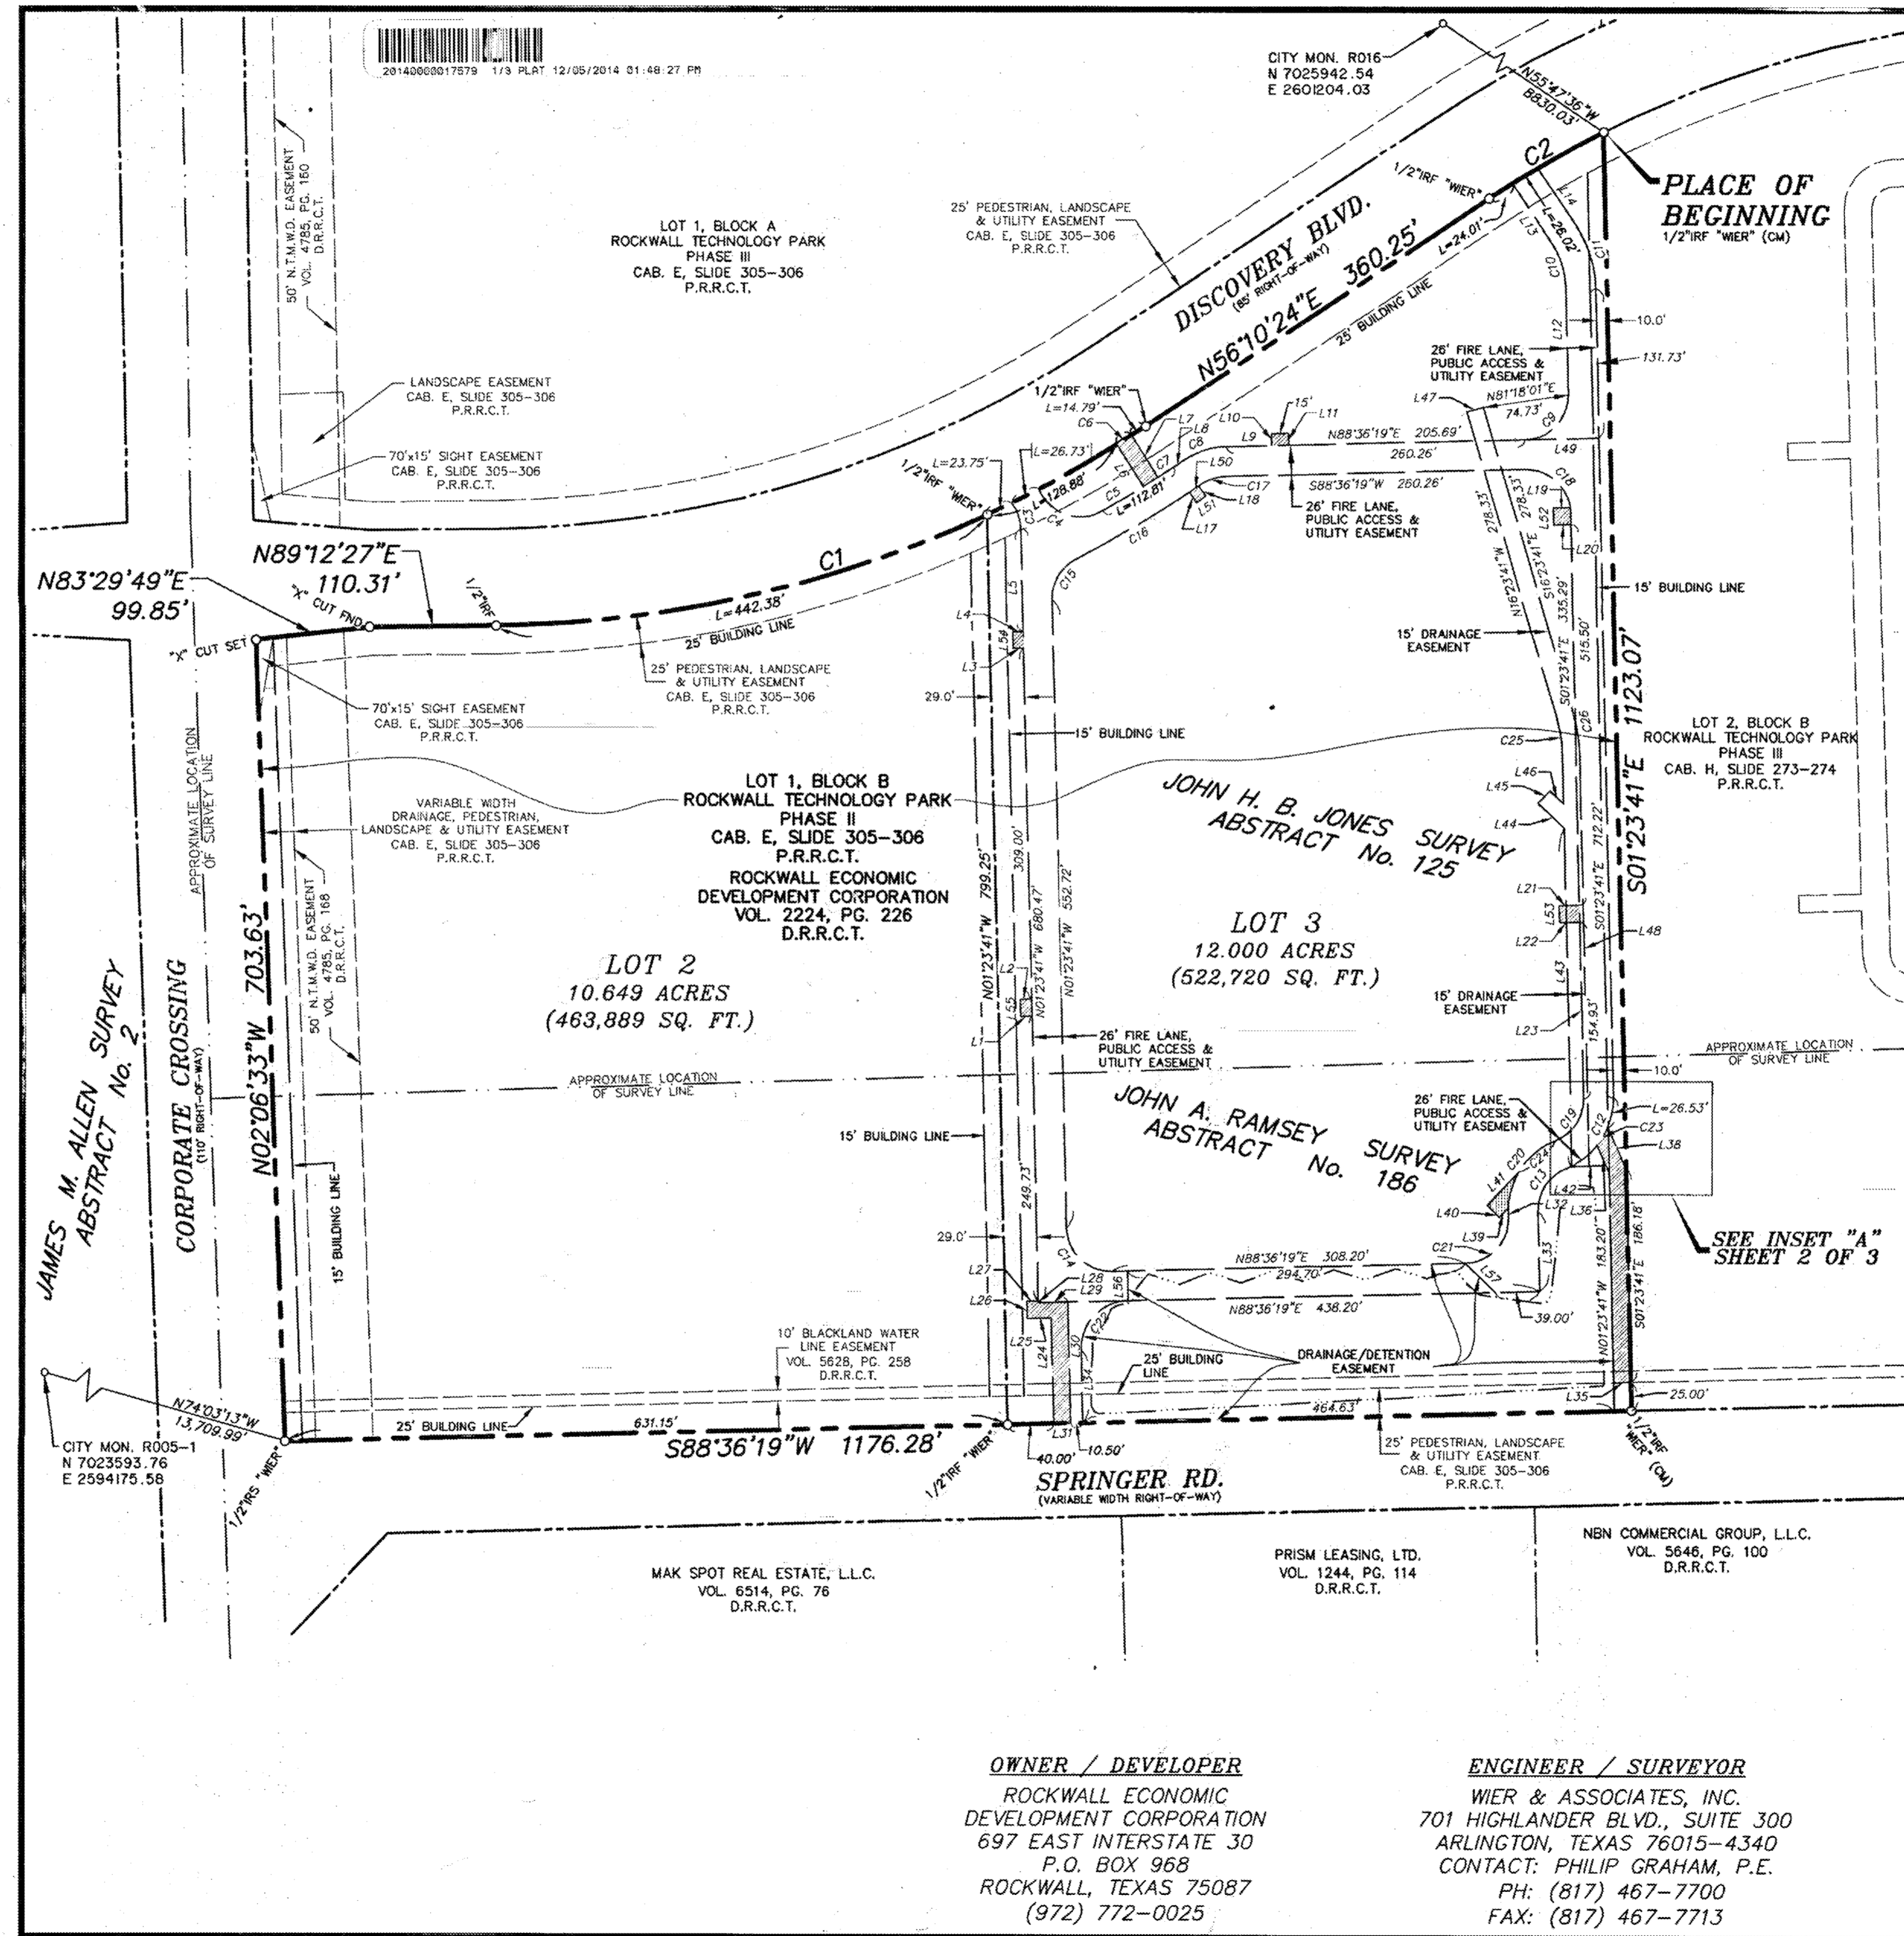


**GENERAL NOTES:**

- 1) IT SHALL BE THE POLICY OF THE CITY OF ROCKWALL TO WITHHOLD ISSUING BUILDING PERMITS UNTIL ALL STREETS, WATER, SEWER AND STORM DRAINAGE SYSTEMS HAVE BEEN ACCEPTED BY THE CITY. THE APPROVAL OF A PLAT BY THE CITY DOES NOT CONSTITUTE ANY REPRESENTATION, ASSURANCE OR GUARANTEE THAT ANY BUILDING WITHIN SUCH PLAT SHALL BE APPROVED, AUTHORIZED OR PERMIT THEREFORE ISSUED, NOR SHALL SUCH APPROVAL CONSTITUTE ANY REPRESENTATION, ASSURANCE OR GUARANTEE BY THE CITY OF THE ADEQUACY AND AVAILABILITY FOR WATER FOR PERSONAL USE AND FIRE PROTECTION WITHIN SUCH PLAT, AS REQUIRED UNDER ORDINANCE 83-54.
- 2) ALL BEARINGS BASED ON THE EAST LINE OF LOT 1, BLOCK B, ROCKWALL TECHNOLOGY PARK, PHASE II AN ADDITION TO THE CITY OF ROCKWALL, ROCKWALL COUNTY, TEXAS, AS SHOWN ON THE PLAT RECORDED IN CABINET E, SLIDES 305 AND 306, PLAT RECORDS, ROCKWALL COUNTY, TEXAS (P.R.R.C.T.), (N 01°23'41" W).

SEE SHEET 2 OF 3 FOR LINE AND CURVE TABLES

**\* LEGEND \***

|        |  |
|--------|--|
| L1     | LINE IDENTIFIED IN LINE TABLE                |
| C1     | CURVE IDENTIFIED IN CURVE TABLE              |
| (CM)   | CONTROLLING MONUMENT                         |
| IRF    | IRON ROD FOUND                               |
| IRS    | IRON ROD SET                                 |
| "WIER" | A CAP STAMPED "WIER & ASSOC INC"             |
|        | WATER EASEMENT                               |
|        | DETENTION POND 100 YEAR WATER SURFACE LIMITS |

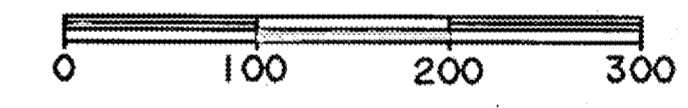

**REPLAT 1113**  
**LOTS 2 & 3, BLOCK B**  
**ROCKWALL TECHNOLOGY PARK, PHASE II**  
 BEING A REPLAT OF LOT 1, BLOCK B, ROCKWALL TECHNOLOGY PARK AS SHOWN BY THE PLAT RECORDED IN CABINET E, SLIDES 305-306. BEING 22.649 ACRES OF LAND LOCATED IN THE JOHN H. B. JONES SURVEY, ABSTRACT No. 125 AND THE JOHN A. RAMSEY SURVEY, ABSTRACT No. 186 CITY OF ROCKWALL, ROCKWALL COUNTY, TEXAS

**OWNER / DEVELOPER**  
 ROCKWALL ECONOMIC DEVELOPMENT CORPORATION  
 697 EAST INTERSTATE 30  
 P.O. BOX 968  
 ROCKWALL, TEXAS 75087  
 (972) 772-0025

**ENGINEER / SURVEYOR**  
 WIER & ASSOCIATES, INC.  
 701 HIGHLANDER BLVD., SUITE 300  
 ARLINGTON, TEXAS 76015-4340  
 CONTACT: PHILIP GRAHAM, P.E.  
 PH: (817) 467-7700  
 FAX: (817) 467-7713

PREPARED BY:  
**WIER & ASSOCIATES, INC.**  
 ENGINEERS SURVEYORS LAND PLANNERS  
 701 HIGHLANDER BLVD., SUITE 300 ARLINGTON, TEXAS 76015 METRO (817)467-7700  
 Texas Firm Registration No. E-2776 www.WierAssociates.com  
 Texas Board of Professional Land Surveying Registration No. 10033900

CASE No. P2014-036  
 DATE: 11/21/2014  
 W.A. No. 98041


PRINTED: 11/24/2014 STB FILE: WER-SURVEY.STB LAST SAVED: 11/21/2014 4:31 PM SAVED BY: MATTHEW J. REPLAT-98041.DWG

| LINE TABLE |             |         |
|------------|-------------|---------|
| LINE       | BEARING     | DIST    |
| L1         | S88°36'19"W | 10.00'  |
| L2         | N88°36'19"E | 10.00'  |
| L3         | S88°36'19"W | 9.00'   |
| L4         | N88°36'19"E | 9.00'   |
| L5         | N01°23'41"W | 90.24'  |
| L6         | N32°36'05"W | 43.50'  |
| L7         | S32°36'05"E | 43.50'  |
| L8         | N56°10'24"E | 13.04'  |
| L9         | N88°36'19"E | 39.57'  |
| L10        | N01°23'41"W | 10.56'  |
| L11        | S01°23'41"E | 10.56'  |
| L12        | N01°23'41"W | 92.73'  |
| L13        | N33°49'36"W | 60.51'  |
| L14        | S33°49'36"E | 59.51'  |
| L17        | N33°49'36"W | 11.00'  |
| L18        | N33°49'36"W | 11.00'  |
| L19        | N88°36'19"E | 14.97'  |
| L20        | S88°36'19"W | 15.25'  |
| L21        | S88°36'19"W | 17.72'  |
| L22        | N88°36'19"E | 17.72'  |
| L23        | S01°23'41"E | 154.93' |
| L24        | N01°23'41"W | 92.28'  |
| L25        | S88°36'19"W | 21.00'  |
| L26        | N01°23'41"W | 15.00'  |
| L27        | N88°36'19"E | 10.00'  |

| LINE TABLE |             |         |
|------------|-------------|---------|
| LINE       | BEARING     | DIST    |
| L28        | S01°23'41"E | 1.50'   |
| L29        | N88°36'19"E | 26.00'  |
| L30        | S01°23'41"E | 105.78' |
| L31        | S88°36'19"W | 15.00'  |
| L32        | N01°23'41"W | 4.64'   |
| L33        | N01°23'41"W | 69.64'  |
| L34        | S01°23'41"E | 63.78'  |
| L35        | S88°36'19"W | 15.00'  |
| L36        | N23°53'41"W | 26.23'  |
| L38        | S23°53'41"E | 40.08'  |
| L39        | N43°36'19"E | 11.12'  |
| L40        | N46°23'41"W | 15.00'  |
| L41        | N43°36'19"E | 40.47'  |
| L42        | N88°36'19"E | 31.45'  |
| L43        | S01°23'41"E | 297.53' |
| L44        | S46°23'41"E | 31.52'  |
| L45        | S43°36'19"W | 15.00'  |
| L46        | N46°23'41"W | 16.52'  |
| L47        | S73°36'19"W | 15.00'  |
| L48        | N01°23'41"W | 359.96' |
| L49        | N88°36'19"E | 65.00'  |
| L50        | S56°10'24"W | 13.04'  |
| L51        | S56°10'24"W | 10.00'  |
| L52        | N01°23'41"W | 15.00'  |
| L53        | N01°23'41"W | 15.00'  |

| LINE TABLE |             |        |
|------------|-------------|--------|
| LINE       | BEARING     | DIST   |
| L54        | N01°23'41"W | 15.00' |
| L55        | N01°23'41"W | 15.00' |
| L56        | N01°23'41"W | 26.00' |
| L57        | S46°23'41"E | 36.77' |

| CURVE TABLE |         |          |           |             |         |
|-------------|---------|----------|-----------|-------------|---------|
| CURVE       | ARC     | RADIUS   | DELTA     | BEARING     | DIST.   |
| C1          | 601.06' | 1042.50' | 33°02'02" | N72°41'26"E | 592.77' |
| C2          | 115.74' | 957.50'  | 6°55'33"  | N59°38'11"E | 115.67' |
| C3          | 24.36'  | 39.00'   | 35°46'53" | S19°17'07"E | 23.96'  |
| C4          | 66.49'  | 39.00'   | 97°41'13" | S71°09'43"E | 58.73'  |
| C5          | 41.70'  | 1086.00' | 2°12'01"  | N58°53'40"E | 41.70'  |
| C6          | 15.00'  | 1042.50' | 0°49'28"  | N57°23'55"E | 15.00'  |
| C7          | 15.72'  | 1086.00' | 0°49'47"  | N56°35'18"E | 15.72'  |
| C8          | 37.64'  | 66.50'   | 32°25'55" | N72°23'22"E | 37.14'  |
| C9          | 61.26'  | 39.00'   | 90°00'00" | N43°36'19"E | 55.15'  |
| C10         | 44.72'  | 79.00'   | 32°25'55" | N17°36'38"W | 44.12'  |
| C11         | 59.43'  | 105.00'  | 32°25'55" | S17°36'38"E | 58.64'  |
| C12         | 78.44'  | 65.00'   | 69°08'18" | S33°10'28"W | 73.76'  |
| C13         | 48.87'  | 40.50'   | 69°08'19" | S33°10'28"W | 45.96'  |
| C14         | 61.26'  | 39.00'   | 90°00'00" | S46°23'41"E | 55.15'  |
| C15         | 43.24'  | 39.00'   | 63°31'11" | S30°21'55"W | 41.06'  |
| C16         | 115.51' | 1112.00' | 5°57'06"  | S59°08'57"W | 115.46' |
| C17         | 22.92'  | 40.50'   | 32°25'55" | S72°23'22"W | 22.62'  |
| C18         | 61.26'  | 39.00'   | 90°00'00" | N46°23'41"W | 55.15'  |
| C19         | 47.06'  | 39.00'   | 69°08'18" | N33°10'28"E | 44.26'  |
| C20         | 80.25'  | 66.50'   | 69°08'19" | N33°10'28"E | 75.46'  |
| C21         | 61.26'  | 39.00'   | 90°00'00" | N43°36'19"E | 55.15'  |
| C22         | 65.97'  | 42.00'   | 90°00'00" | S43°36'19"W | 59.40'  |
| C23         | 18.59'  | 65.00'   | 16°23'02" | N30°10'45"E | 18.52'  |
| C24         | 42.78'  | 66.50'   | 36°51'39" | S49°18'48"W | 42.05'  |
| C25         | 37.31'  | 142.50'  | 15°00'00" | N08°53'41"W | 37.20'  |
| C26         | 41.23'  | 157.50'  | 15°00'00" | N08°53'41"W | 41.12'  |

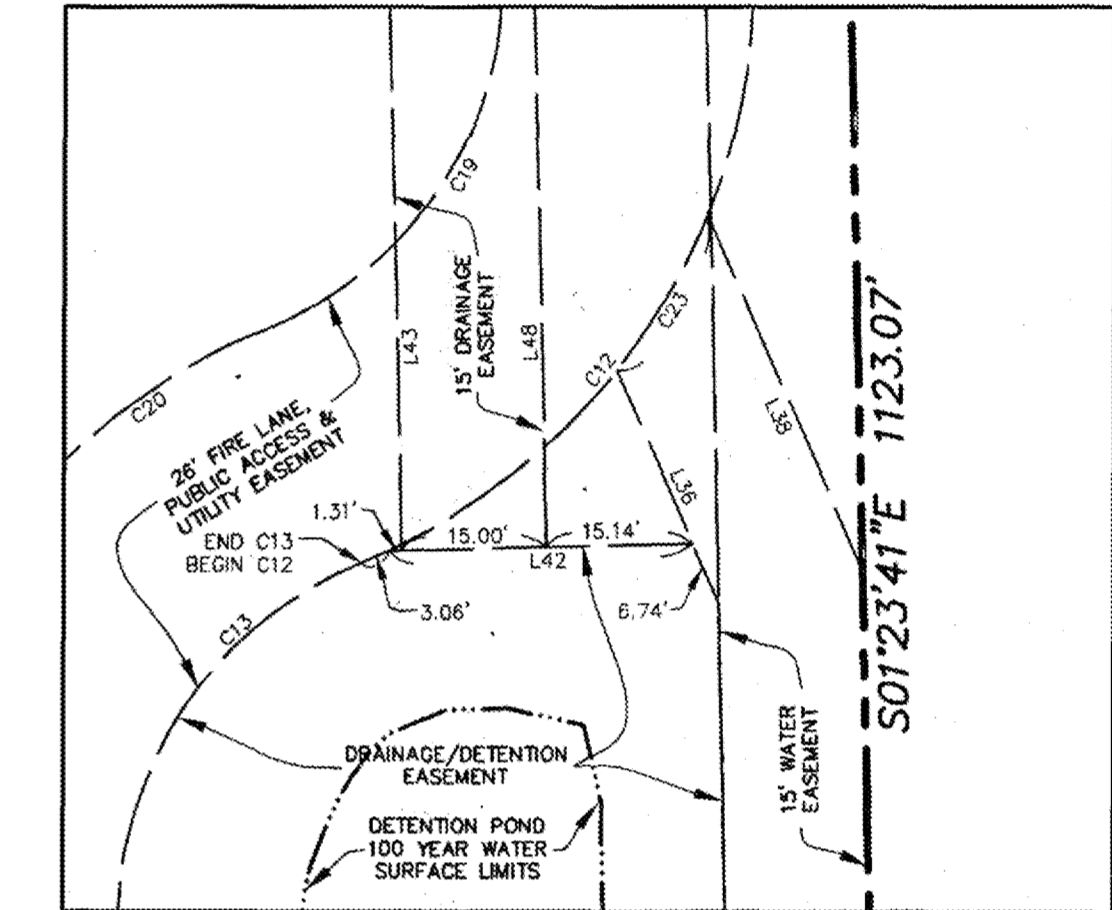

INSET "A"

1114  
**REPLAT**  
**LOTS 2 & 3, BLOCK B**  
**ROCKWALL TECHNOLOGY**  
**PARK, PHASE II**

BEING A REPLAT OF LOT 1, BLOCK B, ROCKWALL TECHNOLOGY PARK AS SHOWN BY THE PLAT RECORDED IN CABINET E, SLIDES 305-306.  
 BEING 22.649 ACRES OF LAND LOCATED IN THE JOHN H. B. JONES SURVEY, ABSTRACT No. 125 AND THE JOHN A. RAMSEY SURVEY, ABSTRACT No. 186 CITY OF ROCKWALL, ROCKWALL COUNTY, TEXAS

PREPARED BY:  
**WIER & ASSOCIATES, INC.**  
**ENGINEERS SURVEYORS LAND PLANNERS**  
 701 HIGHLANDER BLVD., SUITE 300 ARLINGTON, TEXAS 76015 METRO (817)467-7700  
 Texas Firm Registration No. F-2776 www.WierAssociates.com  
 Texas Board of Professional Land Surveying Registration No. 10033900

**OWNER / DEVELOPER**  
 ROCKWALL ECONOMIC DEVELOPMENT CORPORATION  
 697 EAST INTERSTATE 30  
 P.O. BOX 968  
 ROCKWALL, TEXAS 75087  
 (972) 772-0025

**ENGINEER / SURVEYOR**  
 WIER & ASSOCIATES, INC.  
 701 HIGHLANDER BLVD., SUITE 300  
 ARLINGTON, TEXAS 76015-4340  
 CONTACT: PHILIP GRAHAM, P.E.  
 PH: (817) 467-7700  
 FAX: (817) 467-7713

SHEET 2 OF 3

CASE No. P2014-036  
 DATE: 11/21/2014  
 W.A. No. 98041

OWNER'S CERTIFICATE

STATE OF TEXAS  
COUNTY OF ROCKWALL

WHEREAS THE ROCKWALL ECONOMIC DEVELOPMENT CORPORATION, BEING THE OWNER OF A TRACT OF LAND IN THE COUNTY OF ROCKWALL, STATE OF TEXAS, SAID TRACT BEING DESCRIBED AS FOLLOWS:

FIELD NOTES

BEING A TRACT OF LAND LOCATED IN THE JOHN A. RAMSEY SURVEY, ABSTRACT NO. 186 AND THE JOHN H.B. JONES SURVEY, ABSTRACT NO. 125, ROCKWALL COUNTY, TEXAS, BEING A PORTION OF A TRACT OF LAND DESCRIBED IN A DEED TO ROCKWALL ECONOMIC DEVELOPMENT CORPORATION, RECORDED IN VOLUME 2224, PAGE 226, DEED RECORDS, ROCKWALL COUNTY, TEXAS (D.R.R.C.T.), AND BEING ALL OF LOT 1, BLOCK B, ROCKWALL TECHNOLOGY PARK, PHASE II AN ADDITION TO THE CITY OF ROCKWALL, ROCKWALL COUNTY, TEXAS, AS SHOWN ON THE PLAT RECORDED IN CABINET E, SLIDES 305 AND 306, PLAT RECORDS, ROCKWALL COUNTY, TEXAS (P.R.R.C.T.), AND BEING MORE PARTICULARLY DESCRIBED BY METES AND BOUNDS AS FOLLOWS:

BEGINNING AT A 1/2" IRON ROD FOUND WITH CAP STAMPED "WIER & ASSOC INC" IN THE SOUTH RIGHT-OF-WAY LINE OF DISCOVERY BOULEVARD (AN 85 FOOT WIDE RIGHT-OF-WAY), SAID IRON ROD BEING THE NORTHEAST CORNER OF SAID LOT 1, AND THE NORTHWEST CORNER OF LOT 2, BLOCK B, ROCKWALL TECHNOLOGY PARK, PHASE III, AN ADDITION TO THE CITY OF ROCKWALL, ROCKWALL COUNTY TEXAS, AS SHOWN ON THE PLAT RECORDED IN CABINET H, SLIDES 273 AND 274, P.R.R.C.T.;

THENCE S 01'23"41" E, ALONG THE EAST LINE OF SAID LOT 1 AND THE WEST LINE OF SAID LOT 2, A DISTANCE OF 1123.07 FEET TO A 1/2" IRON ROD FOUND WITH CAP STAMPED "WIER & ASSOC INC" IN THE NORTH RIGHT-OF-WAY LINE OF SPRINGER ROAD (A VARIABLE WIDTH RIGHT-OF-WAY), SAID IRON ROD BEING THE SOUTHEAST CORNER OF SAID LOT 1 AND THE SOUTHWEST CORNER OF SAID LOT 2;

THENCE S 88'36"19" W, ALONG THE NORTH RIGHT-OF-WAY LINE OF SAID SPRINGER ROAD AND THE SOUTH LINE OF SAID LOT 1, A DISTANCE OF 1176.28 FEET TO A 1/2" IRON ROD SET WITH CAP STAMPED "WIER & ASSOC INC", SAID 1/2" IRON ROD BEING THE SOUTHWEST CORNER OF SAID LOT 1 AND BEING THE INTERSECTION OF THE NORTH RIGHT-OF-WAY LINE OF SAID SPRINGER ROAD AND THE EAST RIGHT-OF-WAY LINE OF CORPORATE CROSSING (A 110 FOOT WIDE RIGHT-OF-WAY);

THENCE N 02'06'33" W, ALONG THE WEST LINE OF SAID LOT 1 AND THE EAST RIGHT-OF-WAY LINE OF SAID CORPORATE CROSSING (F.M. 3549), 703.63 FEET TO AN "X" CUT SET, SAID "X" CUT SET BEING THE NORTHWEST CORNER OF SAID LOT 1 AND BEING THE INTERSECTION OF THE EAST RIGHT-OF-WAY LINE OF SAID CORPORATE CROSSING AND THE SOUTH RIGHT-OF-WAY LINE OF SAID DISCOVERY BOULEVARD;

THENCE ALONG THE NORTH LINE OF SAID LOT 1 AND THE SOUTH RIGHT-OF-WAY LINE OF SAID DISCOVERY BOULEVARD AS FOLLOWS:

- (1) N 83'29'49" E, 99.85 FEET TO AN "X" CUT FOUND;
- (2) N 89'12'27" E, 110.31 FEET TO 1/2" IRON ROD FOUND, BEING THE BEGINNING OF A-CURVE TO THE LEFT;
- (3) NORTHEASTERLY, AN ARC LENGTH OF 601.06 FEET ALONG SAID CURVE TO THE LEFT, HAVING A RADIUS OF 1042.50 FEET, A DELTA ANGLE OF 33'02"02", AND A CHORD BEARING OF N 72'41'26" E, 592.77 FEET TO A 1/2" IRON ROD FOUND WITH A CAP STAMPED "WIER & ASSOC INC";
- (4) N 56'10'24"E, 360.25 FEET TO A 1/2" IRON ROD FOUND WITH A CAP STAMPED "WIER & ASSOC INC", BEING THE BEGINNING OF A CURVE TO THE RIGHT;
- (5) NORTHEASTERLY, AN ARC LENGTH OF 115.74 FEET ALONG SAID CURVE TO THE RIGHT, HAVING A RADIUS OF 957.50 FEET, A DELTA ANGLE OF 6'55'33", AND A CHORD BEARING OF N 59'38'11" E, 115.67 FEET TO THE PLACE OF BEGINNING AND CONTAINING 22.649 ACRES (966,609 SQ. FT.) OF LAND, MORE OR LESS.

NOW, THEREFORE, KNOW ALL MEN BY THESE PRESENTS:

STATE OF TEXAS  
COUNTY OF ROCKWALL

I THE UNDERSIGNED OWNER OF THE LAND SHOWN ON THIS PLAT, AND DESIGNATED HEREIN AS LOTS 2 & 3, BLOCK B, ROCKWALL TECHNOLOGY PARK, PHASE II TO THE CITY OF ROCKWALL, TEXAS, AND WHOSE NAME IS SUBSCRIBED HERETO, HEREBY DEDICATE TO THE USE OF THE PUBLIC FOREVER ALL STREETS, ALLEYS, PARKS, WATER COURSES, DRAINS, EASEMENTS AND PUBLIC PLACES THEREON SHOWN ON THE PURPOSE AND CONSIDERATION THEREIN EXPRESSED. I FURTHER CERTIFY THAT ALL OTHER PARTIES WHO HAVE A MORTGAGE OR LIEN INTEREST IN LOTS 2 & 3, BLOCK B, ROCKWALL TECHNOLOGY PARK, PHASE II HAVE BEEN NOTIFIED AND SIGNED THIS PLAT.

I UNDERSTAND AND DO HEREBY RESERVE THE EASEMENT STRIPS SHOWN ON THIS PLAT FOR THE PURPOSES STATED AND FOR THE MUTUAL USE AND ACCOMMODATION OF ALL UTILITIES DESIRING TO USE OR USING SAME. I ALSO UNDERSTAND THE FOLLOWING;

- 1. NO BUILDINGS SHALL BE CONSTRUCTED OR PLACED UPON, OVER, OR ACROSS THE UTILITY EASEMENTS AS DESCRIBED HEREIN.
- 2. ANY PUBLIC UTILITY SHALL HAVE THE RIGHT TO REMOVE AND KEEP REMOVED ALL OR PART OF ANY BUILDINGS, FENCES, TREES, SHRUBS, OR OTHER GROWTHS OR IMPROVEMENTS WHICH IN ANY WAY ENDANGER OR INTERFERE WITH CONSTRUCTION, MAINTENANCE OR EFFICIENCY OF THEIR RESPECTIVE SYSTEM ON ANY OF THESE EASEMENT STRIPS; AND ANY PUBLIC UTILITY SHALL AT ALL TIMES HAVE THE RIGHT OF INGRESS OR EGRESS TO, FROM AND UPON THE SAID EASEMENT STRIPS FOR PURPOSE OF CONSTRUCTION, RECONSTRUCTION, INSPECTING, PATROLLING, MAINTAINING, AND EITHER ADDING TO OR REMOVING ALL OR PART OF THEIR RESPECTIVE SYSTEM WITHOUT THE NECESSITY OF, AT ANY TIME, PROCURING THE PERMISSION OF ANYONE.
- 3. THE CITY OF ROCKWALL WILL NOT BE RESPONSIBLE FOR ANY CLAIMS OF ANY NATURE RESULTING FROM OR OCCASIONED BY THE ESTABLISHMENT OF GRADE OF STREETS IN THE SUBDIVISION.
- 4. THE DEVELOPER AND ENGINEER SHALL BEAR TOTAL RESPONSIBILITY FOR STORM DRAIN IMPROVEMENTS.
- 5. THE DEVELOPER SHALL BE RESPONSIBLE FOR THE NECESSARY FACILITIES TO PROVIDE DRAINAGE PATTERNS AND DRAINAGE CONTROLS SUCH THAT PROPERTIES WITHIN THE DRAINAGE AREA ARE NOT ADVERSELY AFFECTED BY STORM DRAINAGE FROM THE DEVELOPMENT.
- 6. NO HOUSE DWELLING UNIT, OR OTHER STRUCTURE SHALL BE CONSTRUCTED ON ANY LOT IN THIS ADDITION BY THE OWNER OR ANY OTHER PERSON UNTIL THE DEVELOPER AND/OR OWNER HAS COMPLIED WITH ALL REQUIREMENTS OF THE SUBDIVISION REGULATIONS OF THE CITY OF ROCKWALL REGARDING IMPROVEMENTS WITH RESPECT TO THE ENTIRE BLOCK ON THE STREET OR STREETS ON WHICH PROPERTY ABUTS, INCLUDING THE ACTUAL INSTALLATION OF STREETS WITH THE REQUIRED BASE AND PAVING, CURB AND GUTTER, WATER AND SEWER, DRAINAGE STRUCTURES, STORM STRUCTURES, STORM SEWERS, AND ALLEYS, ALL ACCORDING TO THE SPECIFICATIONS OF THE CITY OF ROCKWALL; OR

UNTIL AN ESCROW DEPOSIT, SUFFICIENT TO PAY FOR THE COST OF SUCH IMPROVEMENTS, AS DETERMINED BY THE CITY'S ENGINEER AND/OR CITY ADMINISTRATOR, COMPUTED ON A PRIVATE COMMERCIAL RATE BASIS, HAS BEEN MADE WITH THE CITY SECRETARY, ACCOMPANIED BY AN AGREEMENT SIGNED BY THE DEVELOPER AND/OR OWNER, AUTHORIZING THE CITY TO MAKE SUCH IMPROVEMENTS AT PREVAILING PRIVATE COMMERCIAL RATES, OR HAVE THE SAME MADE BY A CONTRACTOR AND PAY FOR THE SAME OUT OF THE ESCROW DEPOSIT, SHOULD THE DEVELOPER AND/OR OWNER FAIL OR REFUSE TO INSTALL THE REQUIRED IMPROVEMENTS WITHIN THE TIME STATED IN SUCH WRITTEN AGREEMENT, BUT IN NO CASE SHALL THE CITY BE OBLIGATED TO MAKE SUCH IMPROVEMENTS ITSELF. SUCH DEPOSIT MAY BE USED BY THE OWNER AND/OR DEVELOPER AS PROGRESS PAYMENTS AS THE WORK PROGRESSES IN MAKING SUCH IMPROVEMENTS BY MAKING CERTIFIED REQUISITIONS TO THE CITY SECRETARY, SUPPORTED BY EVIDENCE OF WORK DONE; OR

UNTIL THE DEVELOPER AND/OR OWNER FILES A CORPORATE SURETY BOND WITH THE CITY SECRETARY IN A SUM EQUAL TO THE COST OF SUCH IMPROVEMENTS FOR THE DESIGNATED AREA, GUARANTEEING THE INSTALLATION THEREOF WITHIN THE TIME STATED IN THE BOND, WHICH TIME SHALL BE FIXED BY THE CITY COUNCIL OF THE CITY OF ROCKWALL.

I FURTHER ACKNOWLEDGE THAT THE DEDICATIONS AND/OR EXACTION'S MADE HEREIN ARE PROPORTIONAL TO THE IMPACT OF THE SUBDIVISION UPON THE PUBLIC SERVICES REQUIRED IN ORDER THAT THE DEVELOPMENT WILL COMPORT WITH THE PRESENT AND FUTURE GROWTH NEEDS OF THE CITY; I, MY SUCCESSORS AND ASSIGNS HEREBY WAIVE ANY CLAIM, DAMAGE, OR CAUSE OF ACTION THAT I MAY HAVE AS A RESULT OF THE DEDICATION OF EXACTIONS MADE HEREIN.

WITNESS OUR HANDS THIS THE 2<sup>nd</sup> DAY OF December, 2014.

FOR: ROCKWALL ECONOMIC DEVELOPMENT CORPORATION


*Shari Franca*  
OWNER

STATE OF TEXAS  
COUNTY OF ROCKWALL

BEFORE ME, THE UNDERSIGNED AUTHORITY, ON THIS DAY PERSONALLY APPEARED Shari Franca OF ROCKWALL ECONOMIC DEVELOPMENT CORPORATION, KNOWN TO ME TO BE THE PERSON WHOSE NAME IS SUBSCRIBED TO THE FOREGOING INSTRUMENT, AND ACKNOWLEDGED TO ME THAT HE EXECUTED THE SAME FOR THE PURPOSE AND CONSIDERATION THEREIN STATED.

GIVEN UPON MY HAND AND SEAL OF OFFICE THIS 2 DAY OF December, 2014.

*Shari Franca*  
NOTARY PUBLIC IN AND FOR THE STATE OF TEXAS  
*Shari Franca*  
PRINTED NAME

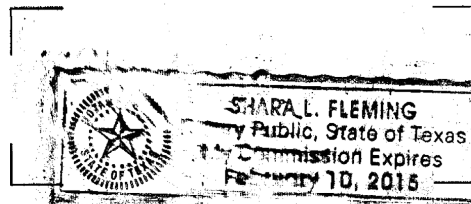

OWNER / DEVELOPER  
ROCKWALL ECONOMIC DEVELOPMENT CORPORATION  
697 EAST INTERSTATE 30  
P.O. BOX 968  
ROCKWALL, TEXAS 75087  
(972) 772-0025


ENGINEER / SURVEYOR  
WIER & ASSOCIATES, INC.  
701 HIGHLANDER BLVD., SUITE 300  
ARLINGTON, TEXAS 76015-4340  
CONTACT: PHILIP GRAHAM, P.E.  
PH: (817) 467-7700  
FAX: (817) 467-7713

SURVEYOR'S CERTIFICATION:

NOW, THEREFORE KNOW ALL MEN BY THESE PRESENTS:

THAT I, GREGG A.E. MADSEN, DO HEREBY CERTIFY THAT I PREPARED THIS PLAT FROM AN ACTUAL AND ACCURATE SURVEY OF THE LAND, AND THAT THE CORNER MONUMENTS SHOWN THEREON WERE PROPERLY PLACED UNDER MY PERSONAL SUPERVISION.

*Gregg A.E. Madsen*  
GREGG A.E. MADSEN REGISTERED PUBLIC SURVEYOR  
STATE OF TEXAS NO. 5798  
EMAIL: GREGGM@WIERASSOCIATES.COM

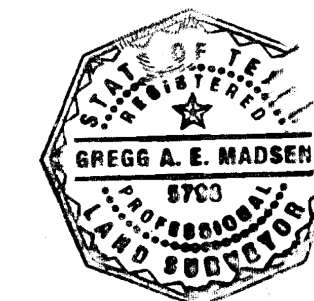

RECOMMENDED FOR FINAL APPROVAL

*Paul Sweet*  
PLANNING AND ZONING COMMISSION, CHAIRMAN

11/11/2014  
DATE

APPROVED

I HEREBY CERTIFY THAT THE ABOVE AND FOREGOING PLAT OF AN ADDITION TO THE CITY OF ROCKWALL, TEXAS, WAS APPROVED BY THE CITY COUNCIL OF THE CITY OF ROCKWALL ON THE 19<sup>th</sup> DAY OF November, 2014.


THIS APPROVAL SHALL BE INVALID UNLESS THE APPROVED PLAT FOR SUCH ADDITION IS RECORDED IN THE OFFICE OF THE COUNTY CLERK OF ROCKWALL COUNTY, TEXAS WITHIN ONE HUNDRED EIGHTY (180) DAYS FROM SAID DATE OF FINAL APPROVAL.

WITNESS OUR HANDS, THIS 4<sup>th</sup> DAY OF December, 2014.

*Paul Sweet*  
MAYOR, CITY OF ROCKWALL

*Krista Halberstam*  
CITY SECRETARY

*Omni Williams*  
CITY ENGINEER

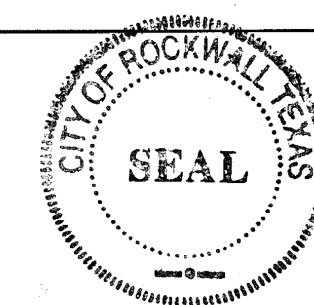

1115

REPLAT  
LOTS 2 & 3, BLOCK B  
ROCKWALL TECHNOLOGY  
PARK, PHASE II

BEING A REPLAT OF LOT 1, BLOCK B, ROCKWALL TECHNOLOGY PARK AS SHOWN BY THE PLAT RECORDED IN CABINET E, SLIDES 305-306.

BEING 22.649 ACRES OF LAND LOCATED IN THE JOHN H. B. JONES SURVEY, ABSTRACT NO. 125 AND THE JOHN A. RAMSEY SURVEY, ABSTRACT NO. 186 CITY OF ROCKWALL, ROCKWALL COUNTY, TEXAS

PREPARED BY:  
**W&A WIER & ASSOCIATES, INC.**  
ENGINEERS SURVEYORS LAND PLANNERS  
701 HIGHLANDER BLVD., SUITE 300 ARLINGTON, TEXAS 76015 METRO (817)467-7700  
Texas Firm Registration No. F-2776 www.WierAssociates.com  
Texas Board of Professional Land Surveying Registration No. 10033900

SHEET 3 OF 3

CASE No. P2014-036  
DATE: 11/21/2014  
W.A. No. 98041

Filed and Recorded  
Official Public Records  
Shelli Miller, County Clerk  
Rockwall County, Texas  
12/05/2014 01:48:27 PM  
\$150.00  
20140000017579


*Shelli Miller*

PRINTED: 10/30/2015 2:59 PM WIER-PAVING STB LAST FILE: WIER-PAVING STB FILE: PHILIP FILE: SITE-PLAN-14029.DWG

| PARKING INFORMATION  |   |
|--|---|
| <b>OFFICE:</b><br>1 SPACE/300 SQ. FT.<br>15,750 SQ. FT./300 SQ. FT. = 53 SPACES            | <b>HANDICAP PARKING SPACES REQUIRED:</b><br>= 8 SPACES WITH 2 OF THOSE BEING VAN ACCESSIBLE |
| <b>PRODUCTION AREA:</b><br>1 SPACE/500 SQ. FT.<br>105,490 SQ. FT./500 SQ. FT. = 211 SPACES | <b>HANDICAP PARKING SPACES PROVIDED:</b><br>= 9 SPACES WITH 4 OF THOSE BEING VAN ACCESSIBLE |
| <b>WAREHOUSE:</b><br>1 SPACE/1,000 SQ. FT.<br>25,000 SQ. FT./1,000 SQ. FT. = 25 SPACES     | <b>LANE USE:</b><br>OFFICE/INDUSTRIAL/WAREHOUSE   |
| <b>TOTAL PARKING SPACES REQUIRED:</b><br>= 53 + 211 + 25 = 289 SPACES                      | <b>*A PARKING VARIANCE HAS BEEN GRANTED*</b>  |
| <b>TOTAL PARKING SPACES PROVIDED:</b><br>= 219 SPACES                                      |   |

| LEGEND |  |
|--------|--|
|        | 8' 3,600 P.S.I. (MIN. 6.5 SACK) TRUCK DOCK & DUMPSTER PAVEMENT   |
|        | 7' 3,600 P.S.I. (MIN. 6.5 SACK) TRUCK ROUTE & FIRE LANE PAVEMENT |
|        | 6' 3,600 P.S.I. (MIN. 6.5 SACK) FIRE LANE PAVEMENT               |
|        | 5' 3,600 P.S.I. (MIN. 6.5 SACK) LIGHT DUTY PAVEMENT              |
|        | 8' 4,200 P.S.I. (MIN. 7.0 SACK) PUBLIC DRIVE APPROACH            |
|        | PROPOSED SIDEWALK (3,000 P.S.I., MIN. 5.5 SACK)                  |
|        | STANDARD PARKING SPACE   |
|        | HANDICAP PARKING   |
|        | PARKING LOT LIGHT POLE SEE MEP PLAN                              |

**CAUTION !!**  
EXISTING UTILITIES ARE INDICATED ON THE PLANS FROM AVAILABLE INFORMATION. IT SHALL BE THE RESPONSIBILITY OF THE CONTRACTOR TO VERIFY THE LOCATION OF ALL UTILITIES, TO NOTIFY ALL UTILITY COMPANIES OF THE CONTRACTORS OPERATIONS, TO PROTECT ALL UTILITIES FROM DAMAGE, TO REPAIR ALL UTILITIES DAMAGED DUE TO THE CONTRACTORS OPERATIONS, AND TO NOTIFY THE ENGINEER PROMPTLY OF ALL CONFLICTS OF THE WORK WITH EXISTING UTILITIES.

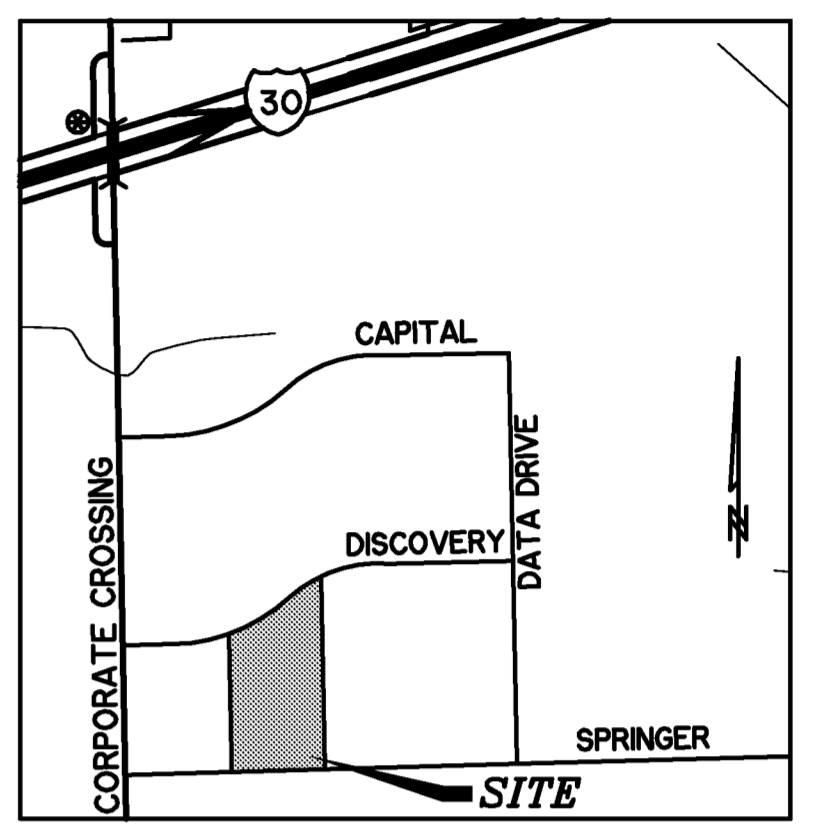

**VICINITY MAP**


- GENERAL NOTES:**
- ALL DIMENSIONS ARE TO BACK OF CURB UNLESS NOTED OTHERWISE
  - REFER TO ELECTRICAL SITE LAYOUT FOR PARKING LOT LIGHTING CONDUIT LOCATIONS AND LANDSCAPE IRRIGATION PLANS FOR IRRIGATION SLEEVE LOCATIONS.
  - ALL LIGHT POLES SHALL BE A MINIMUM OF 2' BACK OF CURB AND NOT LOCATED WITHIN AN EASEMENT.
  - ALL CURB RETURNS ARE 5' RADII UNLESS OTHERWISE SPECIFIED.
  - SPEED BUMPS ARE NOT PERMITTED WITHIN A FIRELANE.
  - TWO POINTS OF ACCESS SHALL BE MAINTAINED FOR THE PROPERTY AT ALL TIMES.

- SCREENING NOTE:**
- BOTH OF THE GARBAGE DUMPSTERS LOCATED ON THE EAST AND WEST SIDES OF THE BUILDING WILL BE FULLY ENCLOSED WITH 10' TALL TEXTURED CONCRETE TILT WALLS TO MATCH THE BUILDING.
  - THE TRUCK COURTS LOCATED ON THE WEST SIDE OF THE BUILDING WILL BE SCREENED USING 10' TALL TEXTURED CONCRETE TILT WALLS TO MATCH THE BUILDING.
  - ALL ROOF MOUNTED UTILITY EQUIPMENT WILL BE SCREENED SO THAT IT SHALL NOT BE VISIBLE FROM ANY DIRECTION.

**CUSHMAN & WAKEFIELD**  
**SCOTT + REID**  
**COL-MET spray booths**

**RECORD PLANS**  
October 30, 2015  
SCALE: 1" = 50'  
DATE: 10/30/2015  
W.A. No. 14029

|  |
|--|
| <b>PROJECT NAME</b><br>COL-MET SPRAY BOOTHS  |
| <b>LAND AND BLOCK DESIGNATION</b><br>LOT 3, BLOCK B<br>ROCKWALL TECHNOLOGY PARK PHASE II |
| <b>SHEET TITLE</b><br>SITE PLAN  |
| <b>CASE #</b><br>#SP2014-012   |

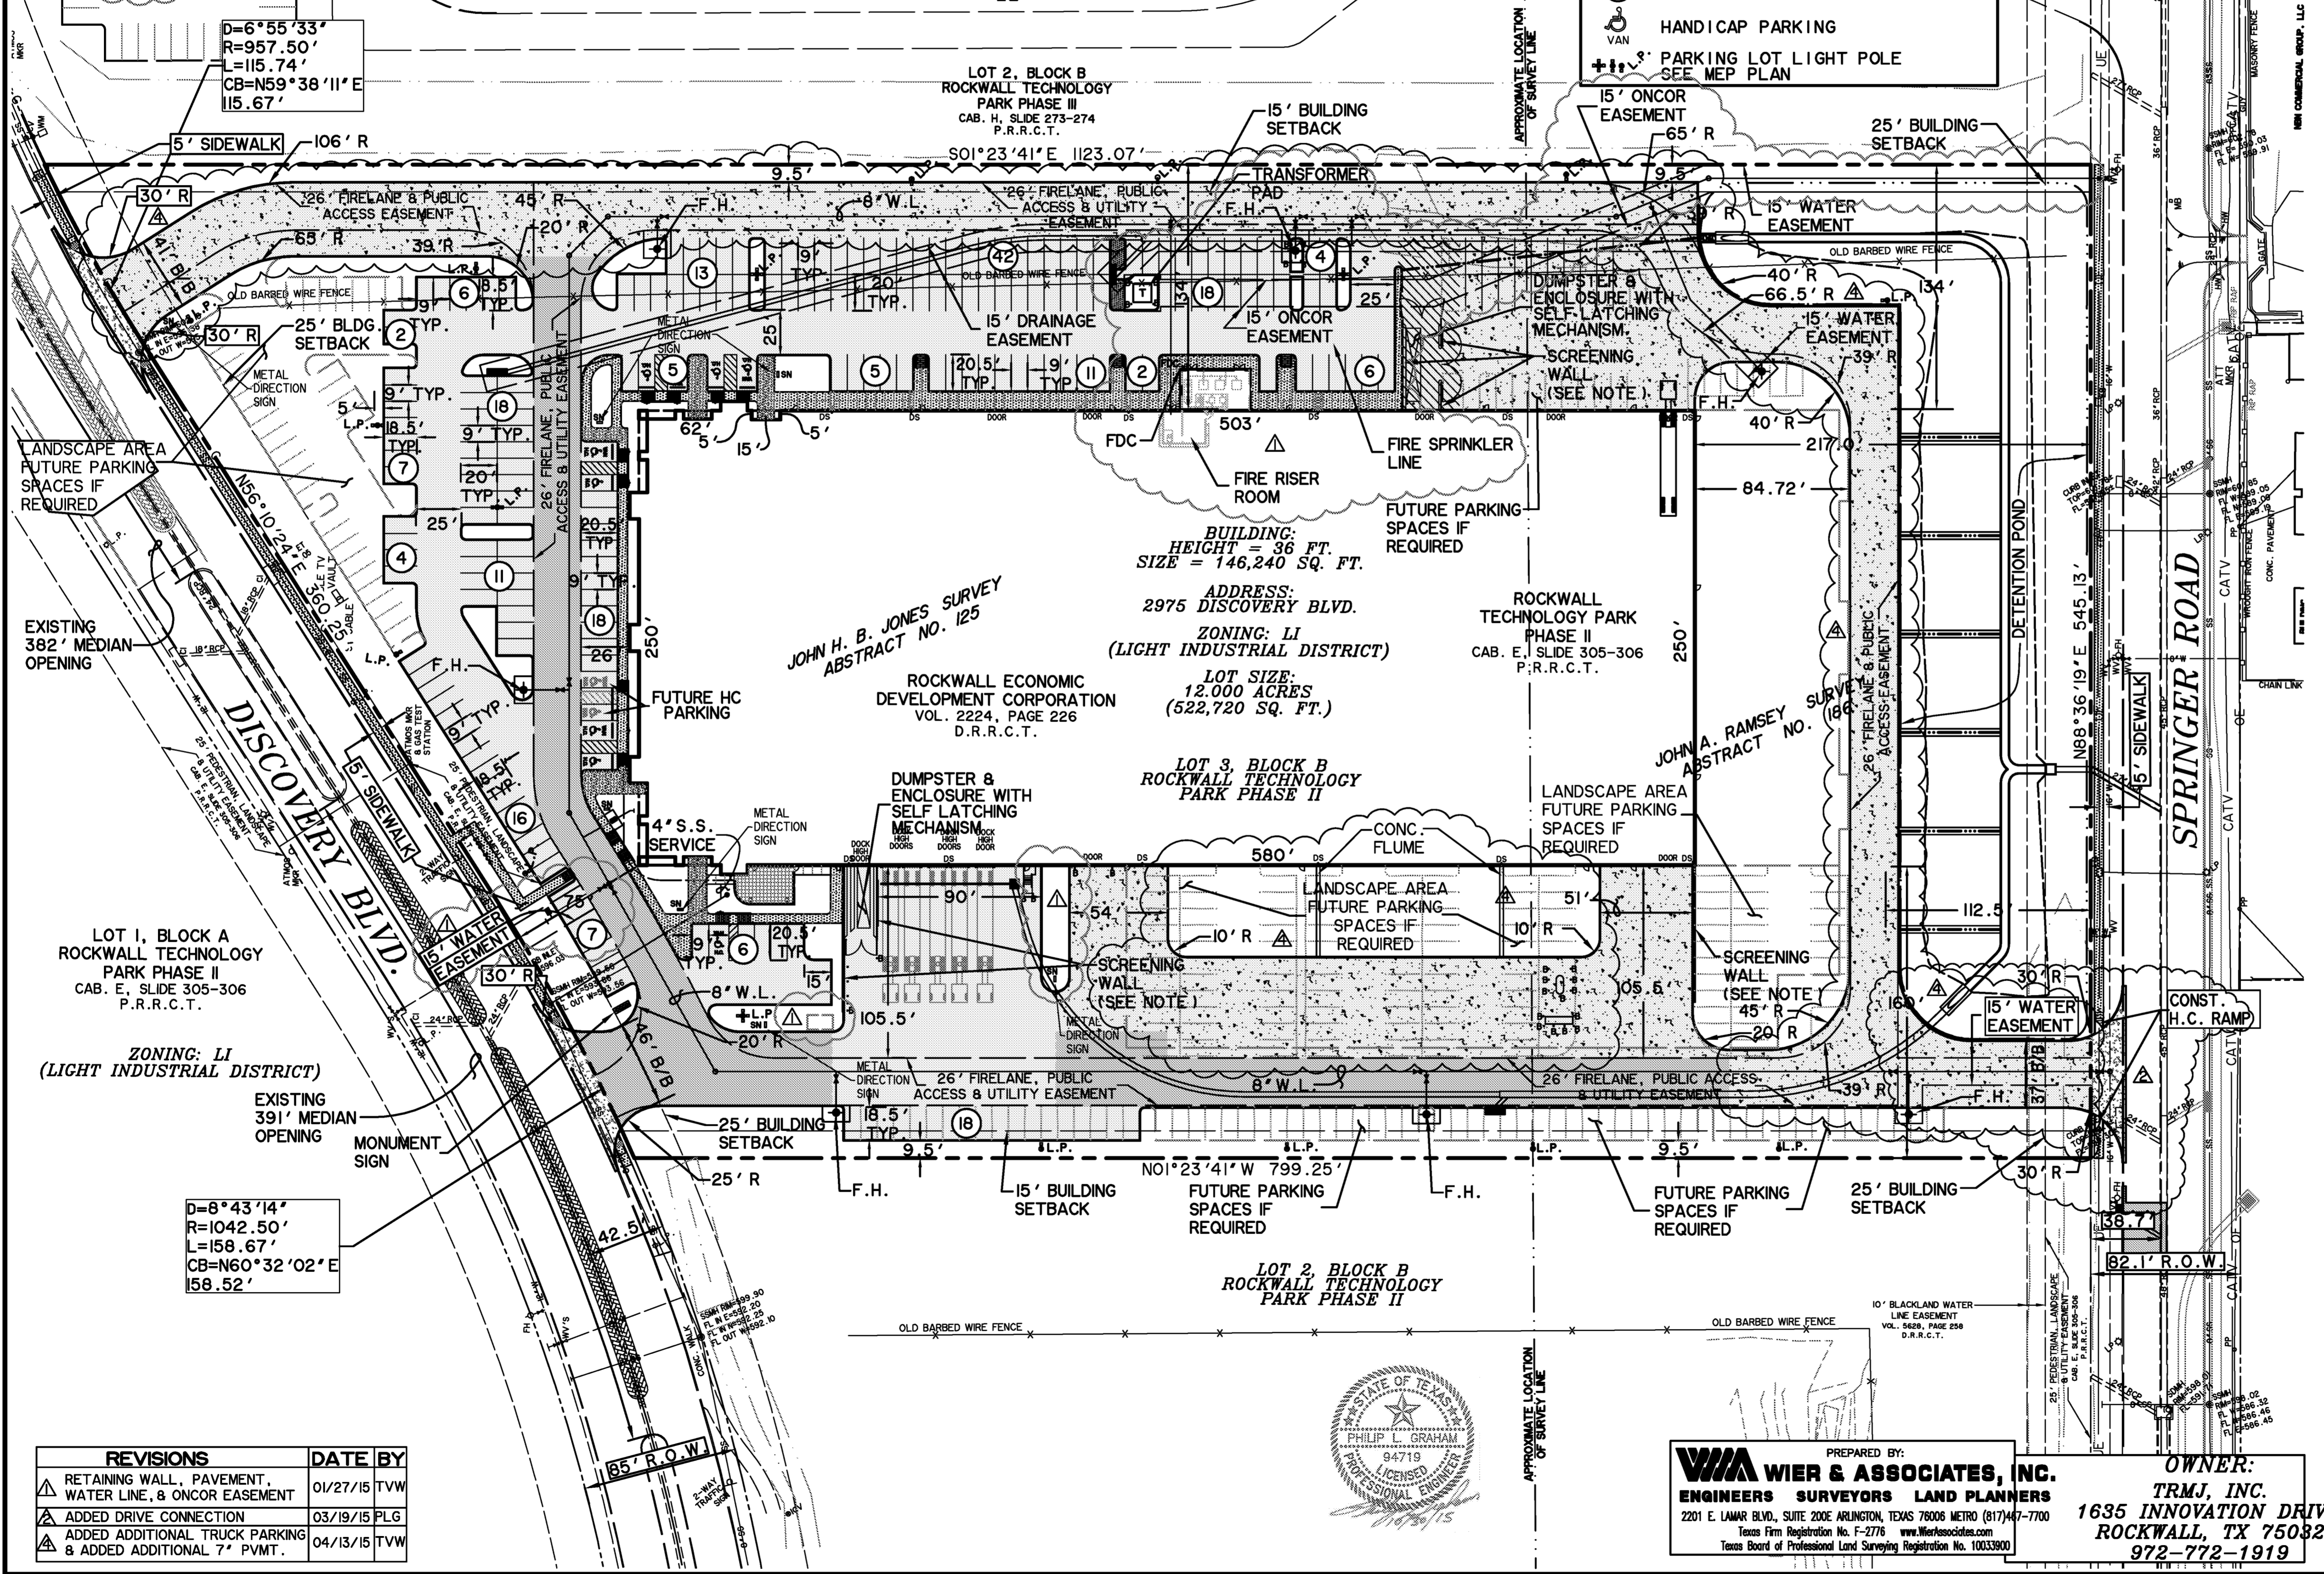



COL-MET SPRAY BOOTHS  
ROCKWALL, TEXAS



ISSUE:

REVISIONS:

LANDSCAPE  
REFERENCE

L1.0


GENERAL LEGEND

|                          |                             |
|--------------------------|-----------------------------|
| PROPERTY / BOUNDARY LINE | ---                         |
| CONTROL JOINT            | — C.J. —                    |
| EXPANSION JOINT          | — E.J. —                    |
| LIMITS OF WORK           | — L.O.W. —                  |
| SHEET MATCHLINE          | ■ ■ ■ ■ ■                   |
| APPROX.                  | APPROXIMATELY               |
| ARCH.                    | ARCHITECT, ARCHITECTURE     |
| BLDG.                    | BUILDING                    |
| B.O.C.                   | BACK OF CURB                |
| CAL.                     | CALIPER                     |
| CIVIL                    | CIVIL ENGINEER/ ENGINEERING |
| C.J.                     | CONTROL JOINT               |
| DIA.                     | DIAMETER                    |
| EJ                       | EXPANSION JOINT             |
| EQ.                      | EQUAL                       |
| F.O.C.                   | FACE OF CURB                |
| GAL.                     | GALLON                      |
| LF                       | LINEAR FEET                 |
| L.O.W.                   | LIMITS OF WORK              |
| MEP                      | MEP ENGINEER/ ENGINEERING   |
| MAX.                     | MAXIMUM                     |
| MIN.                     | MINIMUM                     |
| N/A                      | NOT APPLICABLE              |
| N.I.C.                   | NOT IN CONTRACT             |
| O.C.                     | ON-CENTER                   |
| O.C.E.W.                 | ON-CENTER EACH WAY          |
| PA                       | PLANTING AREA               |
| PERP.                    | PERPENDICULAR               |
| POB.                     | POINT OF BEGINNING          |
| REF.                     | REFER, REFERENCE            |
| RET.                     | RETAIN, RETAINING           |
| SF                       | SQUARE FEET                 |
| STRUCTURAL               | STRUCTURAL ENGINEER         |
| TBD                      | TO BE DETERMINED            |
| TYP.                     | TYPICAL                     |
| UNO.                     | UNLESS NOTED OTHERWISE      |
| W/                       | WITH                        |
| W/O                      | WITHOUT                     |

GENERAL NOTES:

1. CONTRACTOR SHALL PROVIDE ALL MATERIALS AND LABOR TO COMPLETE SCOPE OF WORK AS INDICATED IN DOCUMENTS.
2. ALL WORK SHALL BE EXECUTED IN ACCORDANCE WITH ALL FEDERAL, STATE AND LOCAL REGULATIONS, AND SHALL COMPLY WITH PREVAILING ACCESSIBILITY REQUIREMENTS. CONTRACTOR SHALL NOTIFY LANDSCAPE ARCHITECT OF ANY PORTION OF DOCUMENTS WHICH CONFLICT WITH REGULATIONS PRIOR TO CONSTRUCTION.
3. CONTRACTOR IS RESPONSIBLE FOR SECURING ALL REQUIRED PERMITS, APPROVALS AND INSPECTIONS RELATED TO SCOPE OF WORK.
4. CONTRACTOR IS RESPONSIBLE FOR NOTIFYING LANDSCAPE ARCHITECT IN ADVANCE OF REQUESTED SITE VISITS IN ACCORDANCE WITH GENERAL REQUIREMENTS OF SPECIFICATIONS.
5. DRAWINGS ARE BASED ON SURVEY DATA AND DESIGN DRAWINGS PROVIDED BY OTHERS. IT IS THE CONTRACTOR'S RESPONSIBILITY TO VERIFY EXISTING CONDITIONS AND SHALL NOTIFY LANDSCAPE ARCHITECT OF ANY DISCREPANCIES BETWEEN DOCUMENTS AND ACTUAL SITE CONDITIONS PRIOR TO CONSTRUCTION.
6. DO NOT PROCEED WITH ANY PORTION OF WORK AS INDICATED IN DOCUMENTS IF OBSTRUCTIONS, DISCREPANCIES OR UNKNOWN CONDITIONS ARE ENCOUNTERED. NOTIFY LANDSCAPE ARCHITECT IMMEDIATELY FOR DIRECTION ON HOW TO PROCEED.
7. CONTRACTOR SHALL COORDINATE ALL WORK WITH OTHER DISCIPLINES AND TRADES.
8. LIMITS OF WORK INDICATED ON DRAWINGS, IF ANY, ARE GENERAL IN NATURE AND ARE INTENDED TO DEFINE THE GENERAL VICINITY IN WHICH THE SCOPE OF WORK EXISTS. ACTUAL LIMITS OF WORK SHALL INCLUDE ALL AREAS NECESSARY TO COMPLETE SCOPE OF DESIGN INTENT.

PLANTING LEGEND

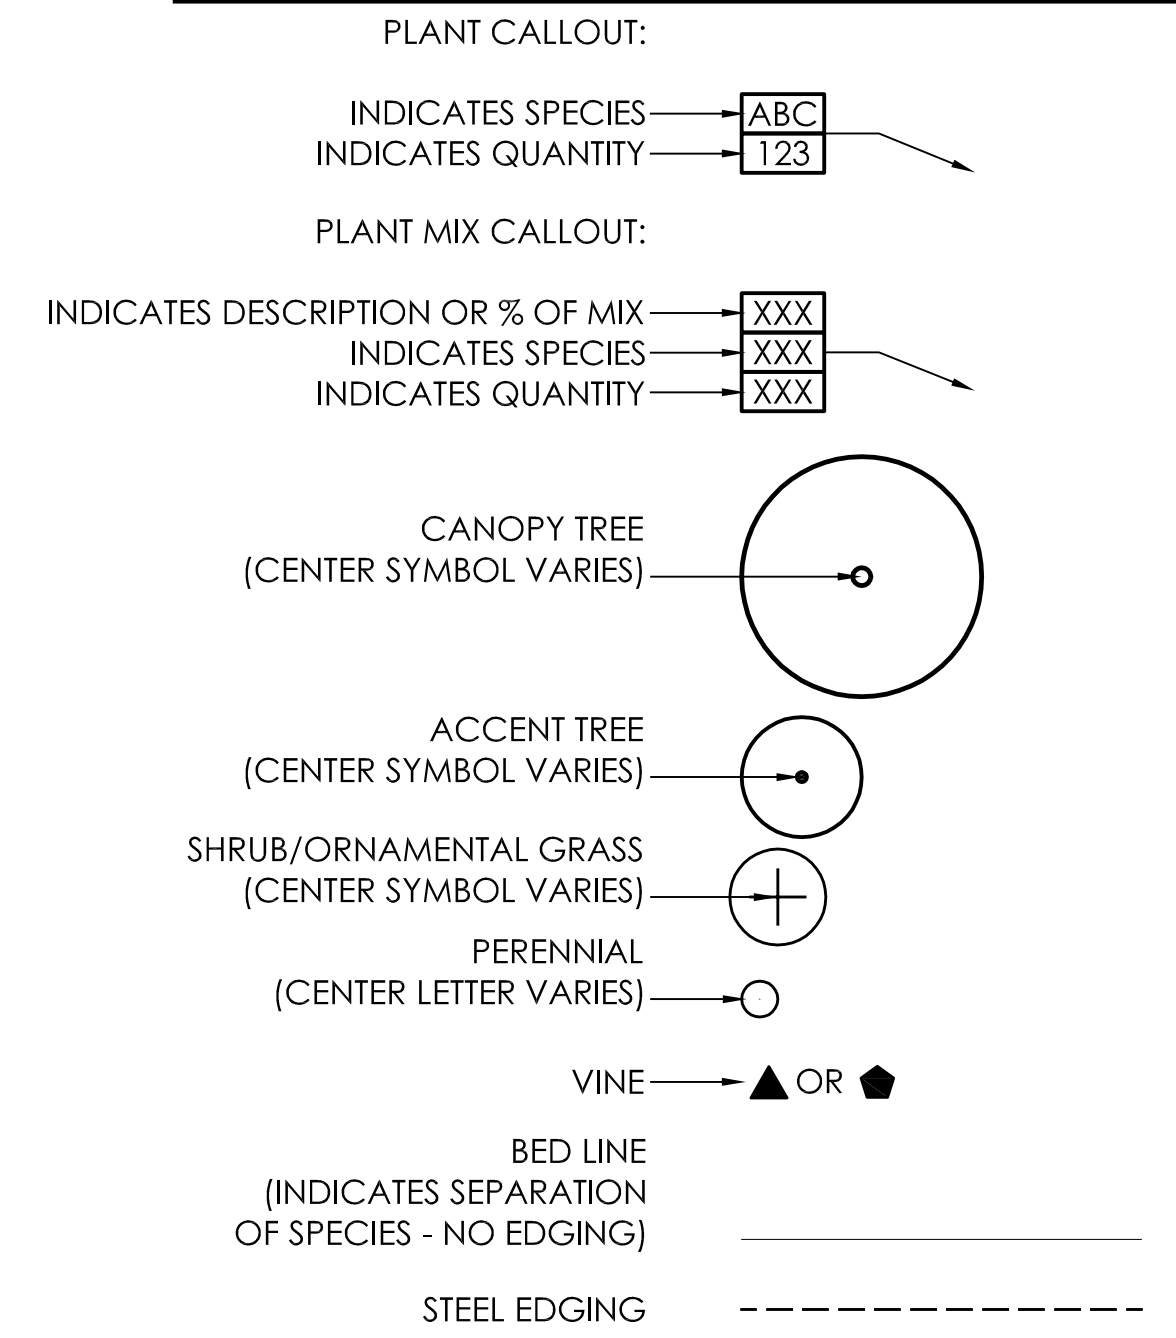

PLANTING NOTES:

1. ALL NON-DIMENSIONED PLANT SYMBOLS, EDGING AND BED LINES ARE DIAGRAMMATIC AND SHALL BE SCALED FROM DRAWINGS.
2. STAKE ALL PROPOSED TREE LOCATIONS ON FINISH GRADE WITH DIFFERENT COLOR FLAGS FOR REVIEW AND APPROVAL BY LANDSCAPE ARCHITECT PRIOR TO EXCAVATION. THE LANDSCAPE ARCHITECT RESERVES THE RIGHT TO MAKE MINOR ADJUSTMENTS TO TREE LOCATIONS PRIOR TO EXCAVATION.
3. PAINT OR STRING ALL EDGING AND BED LINE LOCATIONS ON FINISH GRADE FOR REVIEW AND APPROVAL BY LANDSCAPE ARCHITECT PRIOR TO INSTALLATION. THE LANDSCAPE ARCHITECT SHALL RESERVE THE RIGHT TO MAKE MINOR ADJUSTMENTS TO LAYOUT OF PLANTING AREAS PRIOR TO EXCAVATION.
4. TREES SHALL BE PLANTED NO CLOSER THAN 4' TO PAVEMENT, CURB, EDGING, WALL OR UTILITIES UNLESS NOTED OTHERWISE.
5. TREES SHALL BE PLANTED NO CLOSER THAN 10' TO ANY STRUCTURE OR OVERHEAD UTILITY.
6. TREES OVERHANGING PEDESTRIAN AND VEHICULAR PAVEMENTS ARE INTENDED TO HAVE A MINIMUM CLEAR-TRUNK BRANCHING HEIGHT OF 7' AT MATURITY.
7. TREES OVERHANGING VISIBILITY EASEMENTS OR RIGHTS-OF-WAY ARE INTENDED TO HAVE A MINIMUM CLEAR-TRUNK BRANCHING HEIGHT OF 9' AT MATURITY.
8. ALL TREES, LAWN AND PLANTING AREAS TO RECEIVE 100% IRRIGATION COVERAGE FROM AUTOMATIC UNDERGROUND IRRIGATION SYSTEM UNLESS NOTED OTHERWISE.
9. FINISH GRADE SHALL BE APPROVED BY LANDSCAPE ARCHITECT PRIOR TO PLANTING.
10. ANY QUANTITIES PROVIDED ON PLANS OR SCHEDULES ARE FOR INFORMATION AND CONTRACTOR CONVENIENCE ONLY. CONTRACTOR IS RESPONSIBLE FOR QUANTITY TAKE-OFFS AND SHALL PROVIDE FULL COVERAGE OF PLANTING AREAS AS INDICATED IN DRAWINGS.
11. ALL PLANTS SHALL MEET SIZE AND QUALITY SPECIFICATIONS AS INDICATED IN DOCUMENTS AND SHALL BE OF TOP QUALITY, VIGOROUS, HEALTHY CONDITION. THE LANDSCAPE ARCHITECT RESERVES THE RIGHT TO REJECT PLANTS NOT MEETING SPECIFICATIONS.
12. ALL NEW PLANTS AND LAWNS SHALL BE FERTILIZED ACCORDING TO SOIL ANALYSIS RECOMMENDATIONS, SUPPLIER RECOMMENDATIONS, AS INDICATED IN DOCUMENTS OR AS APPROVED BY LANDSCAPE ARCHITECT.
13. ALL PLANTING BEDS SHALL BE PREPARED WITH 6" OF "PH-BALANCED ORGANIC COMPOST", TILLED INTO EXISTING TOPSOIL TO OVERALL DEPTH OF 12". "PH-BALANCED COMPOST" AS DISTRIBUTED BY SOIL-BUILDING SYSTEMS, DALLAS, TEXAS.
14. MULCH ALL PLANTING AREAS WITH 3" DEPTH OF "FINE-SHREDDED HARDWOOD MULCH" AS DISTRIBUTED BY SOIL-BUILDING SYSTEMS, DALLAS, TEXAS.
15. PREPARE LAWN AREAS WITH 2" DEPTH OF "TURF SOIL" AS DISTRIBUTED BY SOIL-BUILDING SYSTEMS, DALLAS, TEXAS.
16. PROVIDE 90-DAY TEMPORARY MAINTENANCE AND ESTABLISHMENT FOR LANDSCAPE AND IRRIGATION SYSTEM, INCLUDING MOWING/EDGING, TRIMMING, MULCHING, WEEDING, SUPPLEMENTAL WATERING, RE-SETTING OF PLANTS, STAKES OR GUYS, REPAIR AND ADJUSTMENT OF IRRIGATION SYSTEM AND CLEAN-UP OF LITTER.
17. PROVIDE 1-YEAR WARRANTY ON LIVING PLANT MATERIALS AND IRRIGATION SYSTEM.



LOT 1, BLOCK A  
ROCKWALL TECHNOLOGY  
PARK PHASE II

CAB. E, SLIDE 305-306  
P.R.R.C.T.

ZONING: LI  
(LIGHT INDUSTRIAL DISTRICT)

ZONING: LI  
(LIGHT INDUSTRIAL DISTRICT)

ROCKWALL ECONOMIC  
DEVELOPMENT CORPORATION

VOL. 2224, PAGE 226  
LOT 3, BLOCK B  
ROCKWALL TECHNOLOGY PARK  
PHASE II

CAB. E, SLIDE 305-306  
P.R.R.C.T.

REFERENCE SHEET L1.2

- GENERAL NOTES:
1. ALL LAWN AND PLANTING AREAS SHALL BE IRRIGATED WITH 100% AUTOMATIC IRRIGATION SYSTEM.
  2. ALL PLANING AND IRRIGATION SHALL COMPLY WITH THE CITY OF ROCKWALL CODES AND ORDINANCES.
  3. THE OWNER SHALL BE RESPONSIBLE FOR THE CONTINUED MAINTENANCE IN PERPETUITY OF ALL LANDSCAPING AND IRRIGATION. ALL PLANT MATERIAL SHALL BE MAINTAINED IN A HEALTHY AND GROWING CONDITION AS IS APPROPRIATE FOR THE SEASON OF THE YEAR. ALL IRRIGATION HEADS OR LINES WHICH ARE BROKEN AND FLOW WATER SHALL BE REPLACED OR REPAIRED IMMEDIATELY TO PREVENT THE WASTING OF WATER.
  4. NO TREES WILL BE PLANTED WITHIN 5 FEET OF A UTILITY LINE.

A SITE PLAN

SCALE: 1" = 30'-0"

COL-MET SPRAY BOOTHS  
ROCKWALL, TEXAS



ISSUE:

REVISIONS:

LANDSCAPE PLAN

L1.1



COL-MET SPRAY BOOTHS  
ROCKWALL, TEXAS



ISSUE:

|  |
|--|
|  |
|--|

REVISIONS:

|  |  |
|--|--|
|  |  |
|  |  |
LANDSCAPE PLAN

THE ROCKWALL CITY CODE - PART III UNIFIED DEVELOPMENT CODE - Article VIII LANDSCAPE STANDARDS - SECTION 5. MANDATORY PROVISIONS

Sec. 5.1. Landscape buffer-strip

A minimum ten-foot-wide landscape buffer-strip must be provided along the entire length of the portion of the perimeter of any commercial or industrial lot that abuts, without an alley or drive separation, or is directly across a public street from a residential zoning district, exclusive of driveways and access-ways.

Not applicable - not adjacent to residential zoning district

Sec. 5.2. Screening of off-street loading docks

- B. Off-street loading docks in industrial zoning classifications must be screened from:
1. Arterial streets, as indicated on the city's thoroughfare plan; and
  2. Any residential district that abuts or is directly across a public street or alley from the lot.

Not applicable - loading docks do not face any arterial street and there is not adjacent residential zoning district

Sec. 5.6. Screening from residential uses

Not applicable - not adjacent to residential zoning district

Sec. 5.7. Street landscaping

A street landscape buffer-strip with a minimum width of ten feet, must be provided along the entire length of the property to be developed that is adjacent to a major arterial or collector street. Large trees shall be provided in the required buffer in numbers equal to one tree for each 50 feet of street frontage.

A 10' buffer strip has been provided along Discovery Blvd. and Springer Rd.  
Frontage along Discovery Blvd. = 635' 1 large tree/50' = 13 large trees required **13 TREES PROVIDED**  
Frontage along Springer Rd. = 545' 1 large tree/50' = 11 large trees required **11 TREES PROVIDED**

Sec. 5.9. Parking Lot Landscaping

A. Any parking lot with more than two rows of spaces shall have a minimum of five percent or 200 square feet, whichever is greater, in the interior of the parking lot in landscaping. Such landscaping shall be counted toward the total landscaping.

The proposed parking area has approximately 6.5% landscape area.

B. If the parking and maneuvering space exceeds 20,000 square feet one large canopy tree for every ten required parking spaces shall be required internal to the parking lot. No tree shall be planted closer than 2½ feet to the pavement.

The proposed parking area has 200 parking spaces - 20 trees required - **28 TREES PROVIDED**

Sec. 5.12. Required landscaping

A. Amount of landscaping.

1. Light Industrial - 10% of the site is required to be landscaping.


Total site area = 522,823.6 SF 10% of total = 52,282.4 SF  
Total landscape area provided = **192,215 SF (37%)**

**NOTE:** No trees to be planted (horizontally) within 5' of any public utility.

All fire hydrants to have 5' clearance around them. Groundcover is acceptable.

DETENTION AREA: 35,652 SF  
55,536 SF / 750 SF = 74 TREES REQUIRED  
38 PROPOSED BALD CYPRESS  
+  
36 PROPOSED EASTERN RED CEDAR  
50 TOTAL TREES PROVIDED

GENERAL NOTES:  
1. ALL LAWN AND PLANTING AREAS SHALL BE IRRIGATED WITH 100% AUTOMATIC IRRIGATION SYSTEM.  
2. ALL PLANING AND IRRIGATION SHALL COMPLY WITH THE CITY OF ROCKWALL CODES AND ORDINANCES.  
3. THE OWNER SHALL BE RESPONSIBLE FOR THE CONTINUED MAINTENANCE IN PERPETUITY OF ALL LANDSCAPING AND IRRIGATION. ALL PLANT MATERIAL SHALL BE MAINTAINED IN A HEALTHY AND GROWING CONDITION AS IS APPROPRIATE FOR THE SEASON OF THE YEAR. ALL IRRIGATION HEADS OR LINES WHICH ARE BROKEN AND FLOW WATER SHALL BE REPLACED OR REPAIRED IMMEDIATELY TO PREVENT THE WASTING OF WATER.  
4. NO TREES WILL BE PLANTED WITHIN 5 FEET OF A UTILITY LINE.

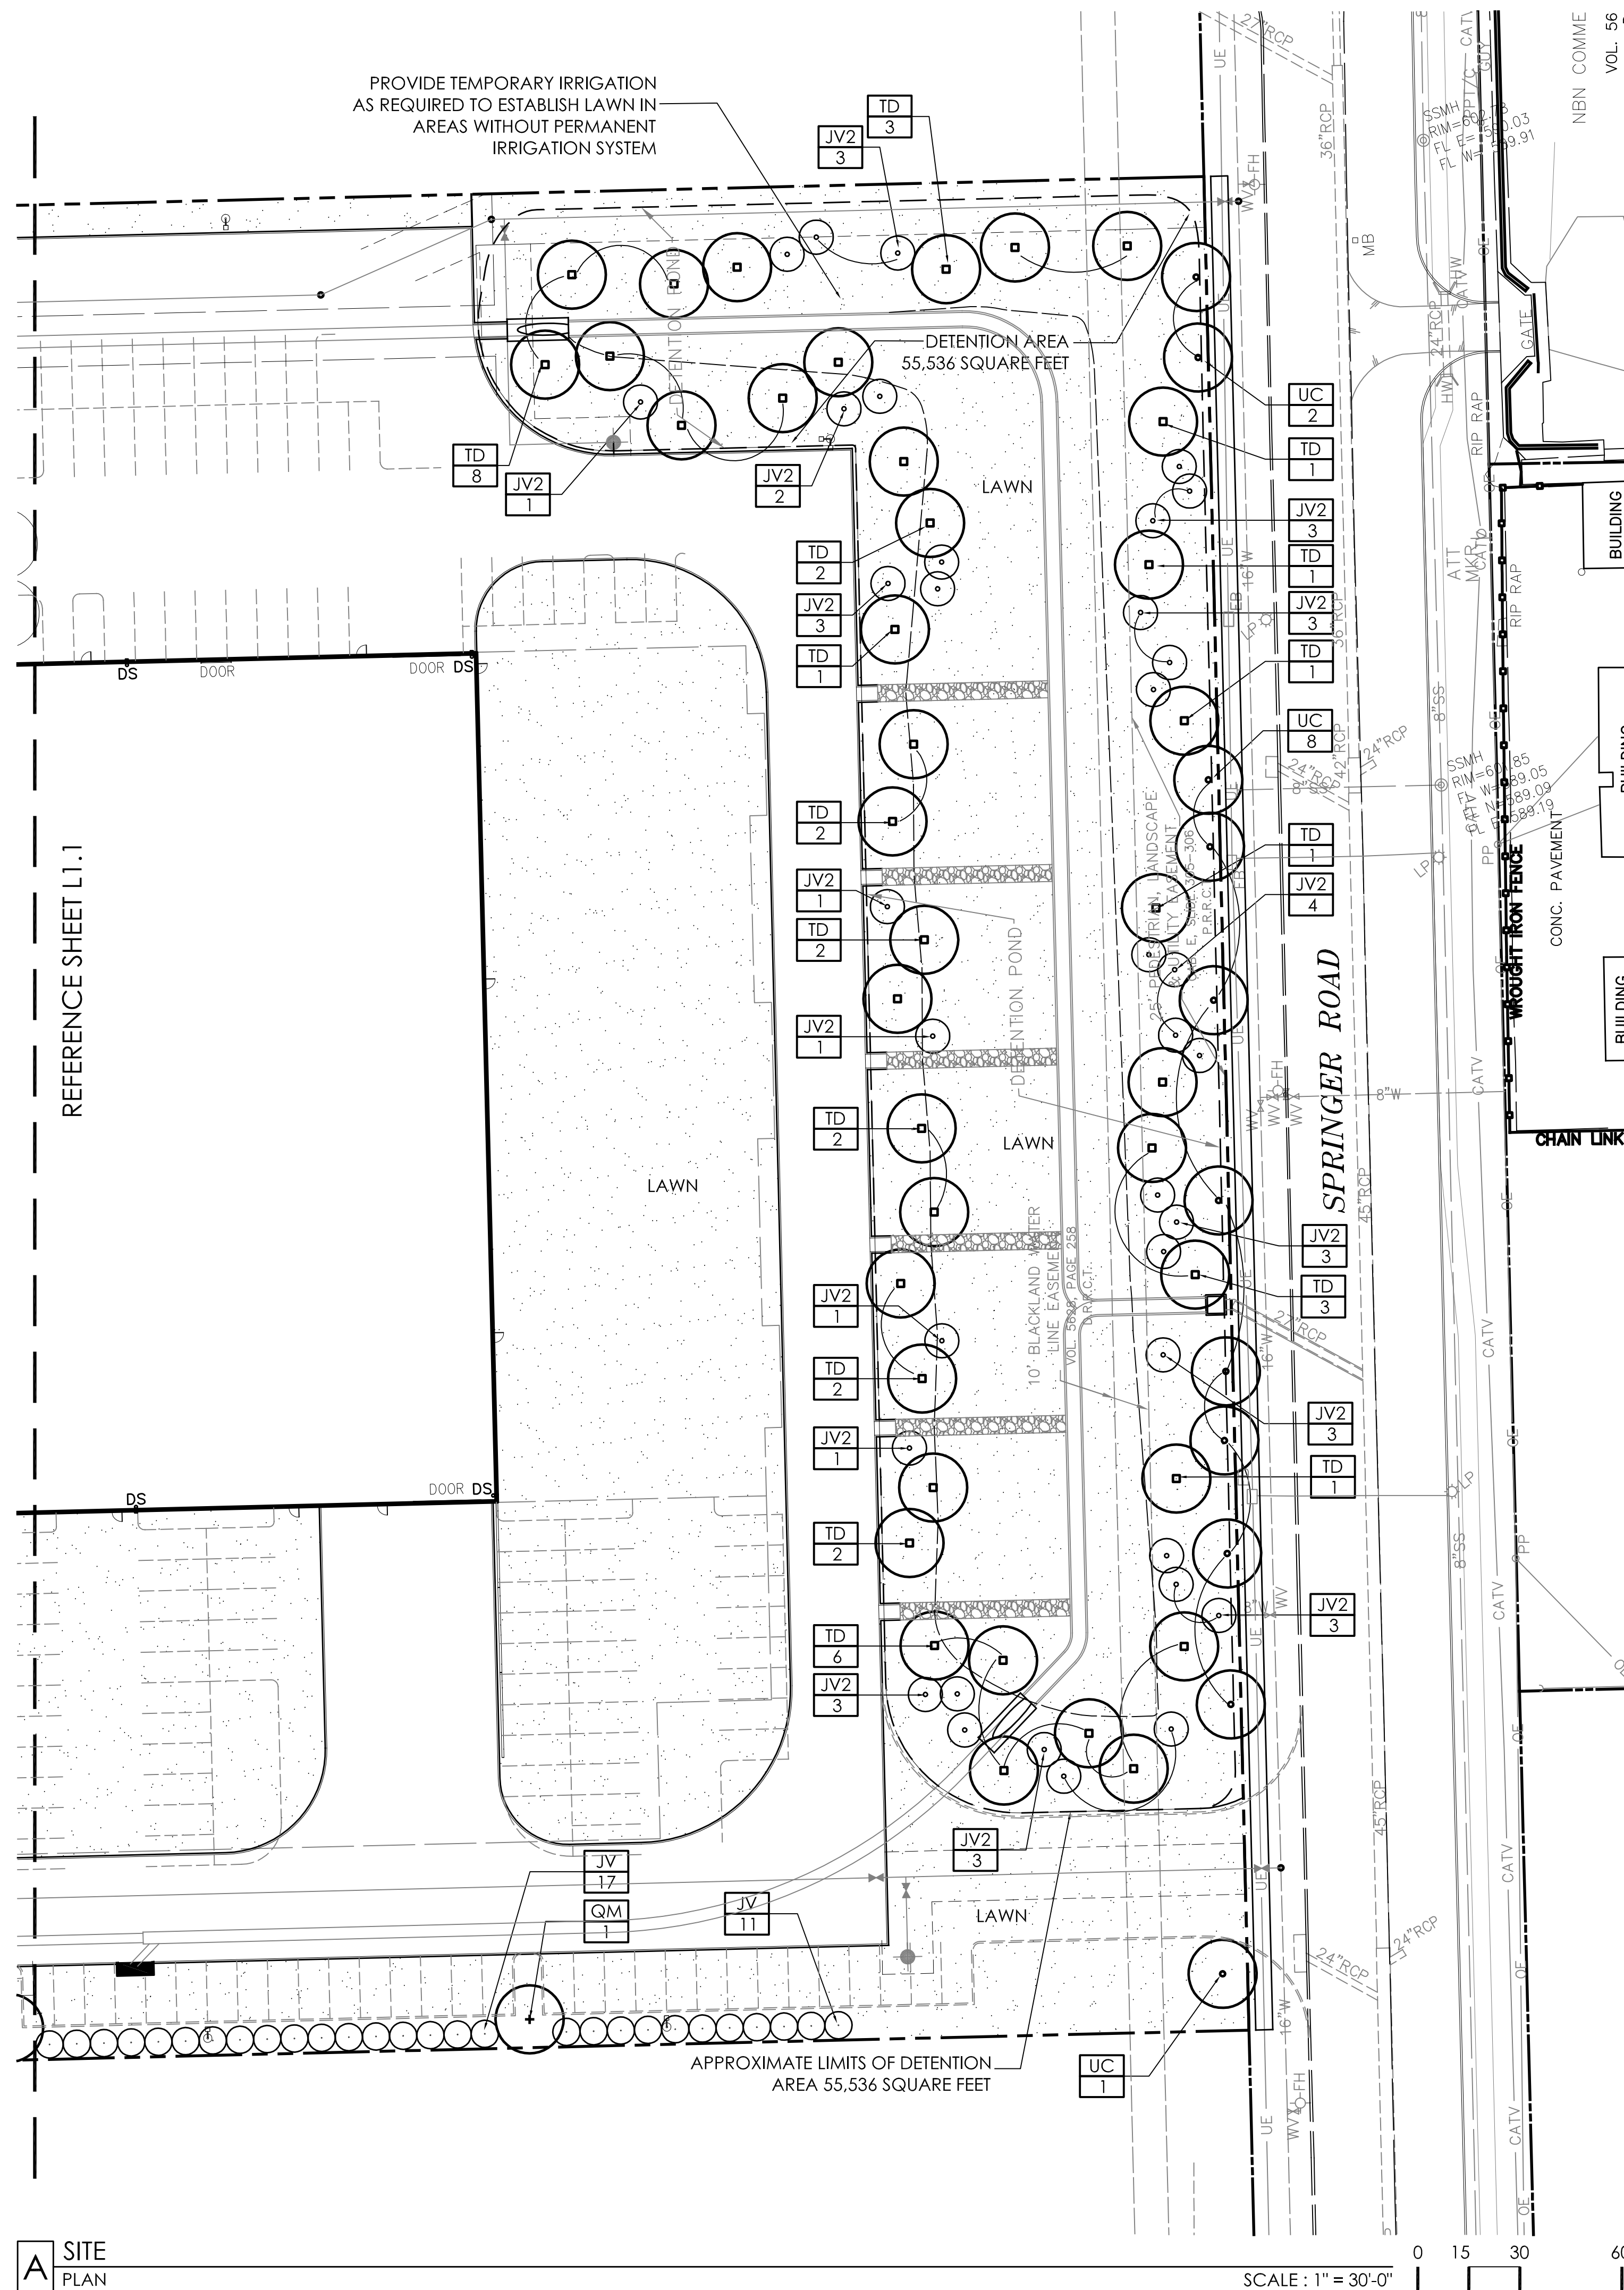





COL-MET SPRAY BOOTHS  
ROCKWALL, TEXAS




ISSUE:

REVISIONS:

LANDSCAPE MATERIALS & DETAILS

PLANT SCHEDULE

| QUANT.                             | SYM.                   | BOTANICAL NAME/<br>COMMON NAME                           | MIN.<br>CAL. | MIN.<br>HEIGHT        | MIN.<br>SPREAD | CONTAINER/<br>ROOTBALL      | SPACING  | REMARKS  |
|------------------------------------|------------------------|--|--------------|-----------------------|----------------|-----------------------------|----------|--|
| <b>TREES</b>                       |                        |  |              |                       |                |                             |          |  |
| 10                                 | AR                     | ACER RUBRUM 'OCTOBER GLORY' /<br>OCTOBER GLORY RED MAPLE | 4"           | 15'                   | 5'             | 65 GAL.                     | PER PLAN | SINGLE STRAIGHT TRUNK,<br>FULL CANOPY, MATCHED   |
| *65                                | JV                     | JUNIPERUS VIRGINIANA /<br>EASTERN RED CEDAR              |              | 8 - 10'               | 3'             | 45 GAL.<br>OR<br>TRANSPLANT | PER PLAN | * TRANSPLANT EXISTING CEDARS<br>FROM TECHNOLOGY PARK AS<br>AVAILABLE. COORDINATE WITH<br>DEVELOPER |
| *36                                | JV2                    | JUNIPERUS VIRGINIANA /<br>EASTERN RED CEDAR              |              | 10-12'                | 4'             | 45 GAL.<br>OR<br>TRANSPLANT | PER PLAN | * TRANSPLANT EXISTING CEDARS<br>FROM TECHNOLOGY PARK AS<br>AVAILABLE. COORDINATE WITH<br>DEVELOPER |
| 26                                 | QM                     | QUERCUS MUHLENBERGIA /<br>CHINQUAPIN OAK                 | 4"           | 15'                   | 5'             | 65 GAL.                     | PER PLAN | SINGLE STRAIGHT TRUNK,<br>FULL CANOPY, MATCHED   |
| 38                                 | TD                     | TAXODIUM DISTICHUM /<br>BALD CYPRESS                     | 4"           | 15'                   | 5'             | 65 GAL.                     | PER PLAN | SINGLE STRAIGHT TRUNK,<br>FULL CANOPY, MATCHED   |
| 23                                 | UC                     | ULMUS CRASSIFOLIA /<br>CEDAR ELM                         | 4"           | 15'                   | 5'             | 65 GAL.                     | PER PLAN | SINGLE STRAIGHT TRUNK,<br>FULL CANOPY, MATCHED   |
| <b>SHRUBS / ORNAMENTAL GRASSES</b> |                        |  |              |                       |                |                             |          |  |
| 106                                | MP                     | MYRICA PUSILLA/<br>DWARF WAX MYRTLE                      | NA           | 18"                   | 15"            | 5 GAL.                      | 36" O.C. |  |
| 224                                | SG                     | SALVIA GREGGII /<br>AUTUMN SAGE                          | NA           | 18"                   | 18"            | 3 GAL.                      | 30" O.C. |  |
| 26                                 | JH                     | JASMINUM HUMILE/<br>ITALIAN JASMINE                      | NA           | 36"                   | 36"            | 15 GAL.                     | 72" O.C. |  |
| 16                                 | JS                     | SKYROCKET JUNIPER/<br>JUNIPERUS SCOPULORUM 'SKYROCKET'   | NA           | 60"                   | 24"            | 15 GAL.                     | 48" O.C. |  |
| 27                                 | LF                     | LEUCOPHYLLUM FRUTESCENS 'SILVERADO' /<br>SILVERADO SAGE  | NA           | 18"                   | 24"            | 5 GAL.                      | 48" O.C. |  |
| <b>GROUNDCOVERS / VINES</b>        |                        |  |              |                       |                |                             |          |  |
| 591                                | LM                     | LANTANA MONTEVIDENSIS/<br>TRAILING LANTANA               | NA           | 6"                    | 12"            | 1 GAL.                      | 30" O.C. |  |
| 575                                | TJ                     | TRACHAELOSPERMUM JASMINOIDES/<br>STAR JASMINE            | NA           | 6"                    | 12"            | 4" POTS                     | 18" O.C. | 3 (12") RUNNERS MINIMUM  |
| <b>LAWN</b>                        |                        |  |              |                       |                |                             |          |  |
|                                    |                        | CYNADON DACTYLON/<br>COMMON BERMUDA                      |              |                       |                |                             |          | HYDROSEED AREAS DESIGNATED ON PLANS  |
| SYM.                               | DESCRIPTION            | COLOR  | FINISH       | REMARKS               |                |                             |          |  |
| E.1                                | 1/8" X 4" STEEL EDGING | GREEN  | POWDER-COAT  |                       |                |                             |          |  |
| G.1                                | CRUSHED GRANITE        |  |              | 1 1/2" SIZE: 4" DEPTH |                |                             |          |  |

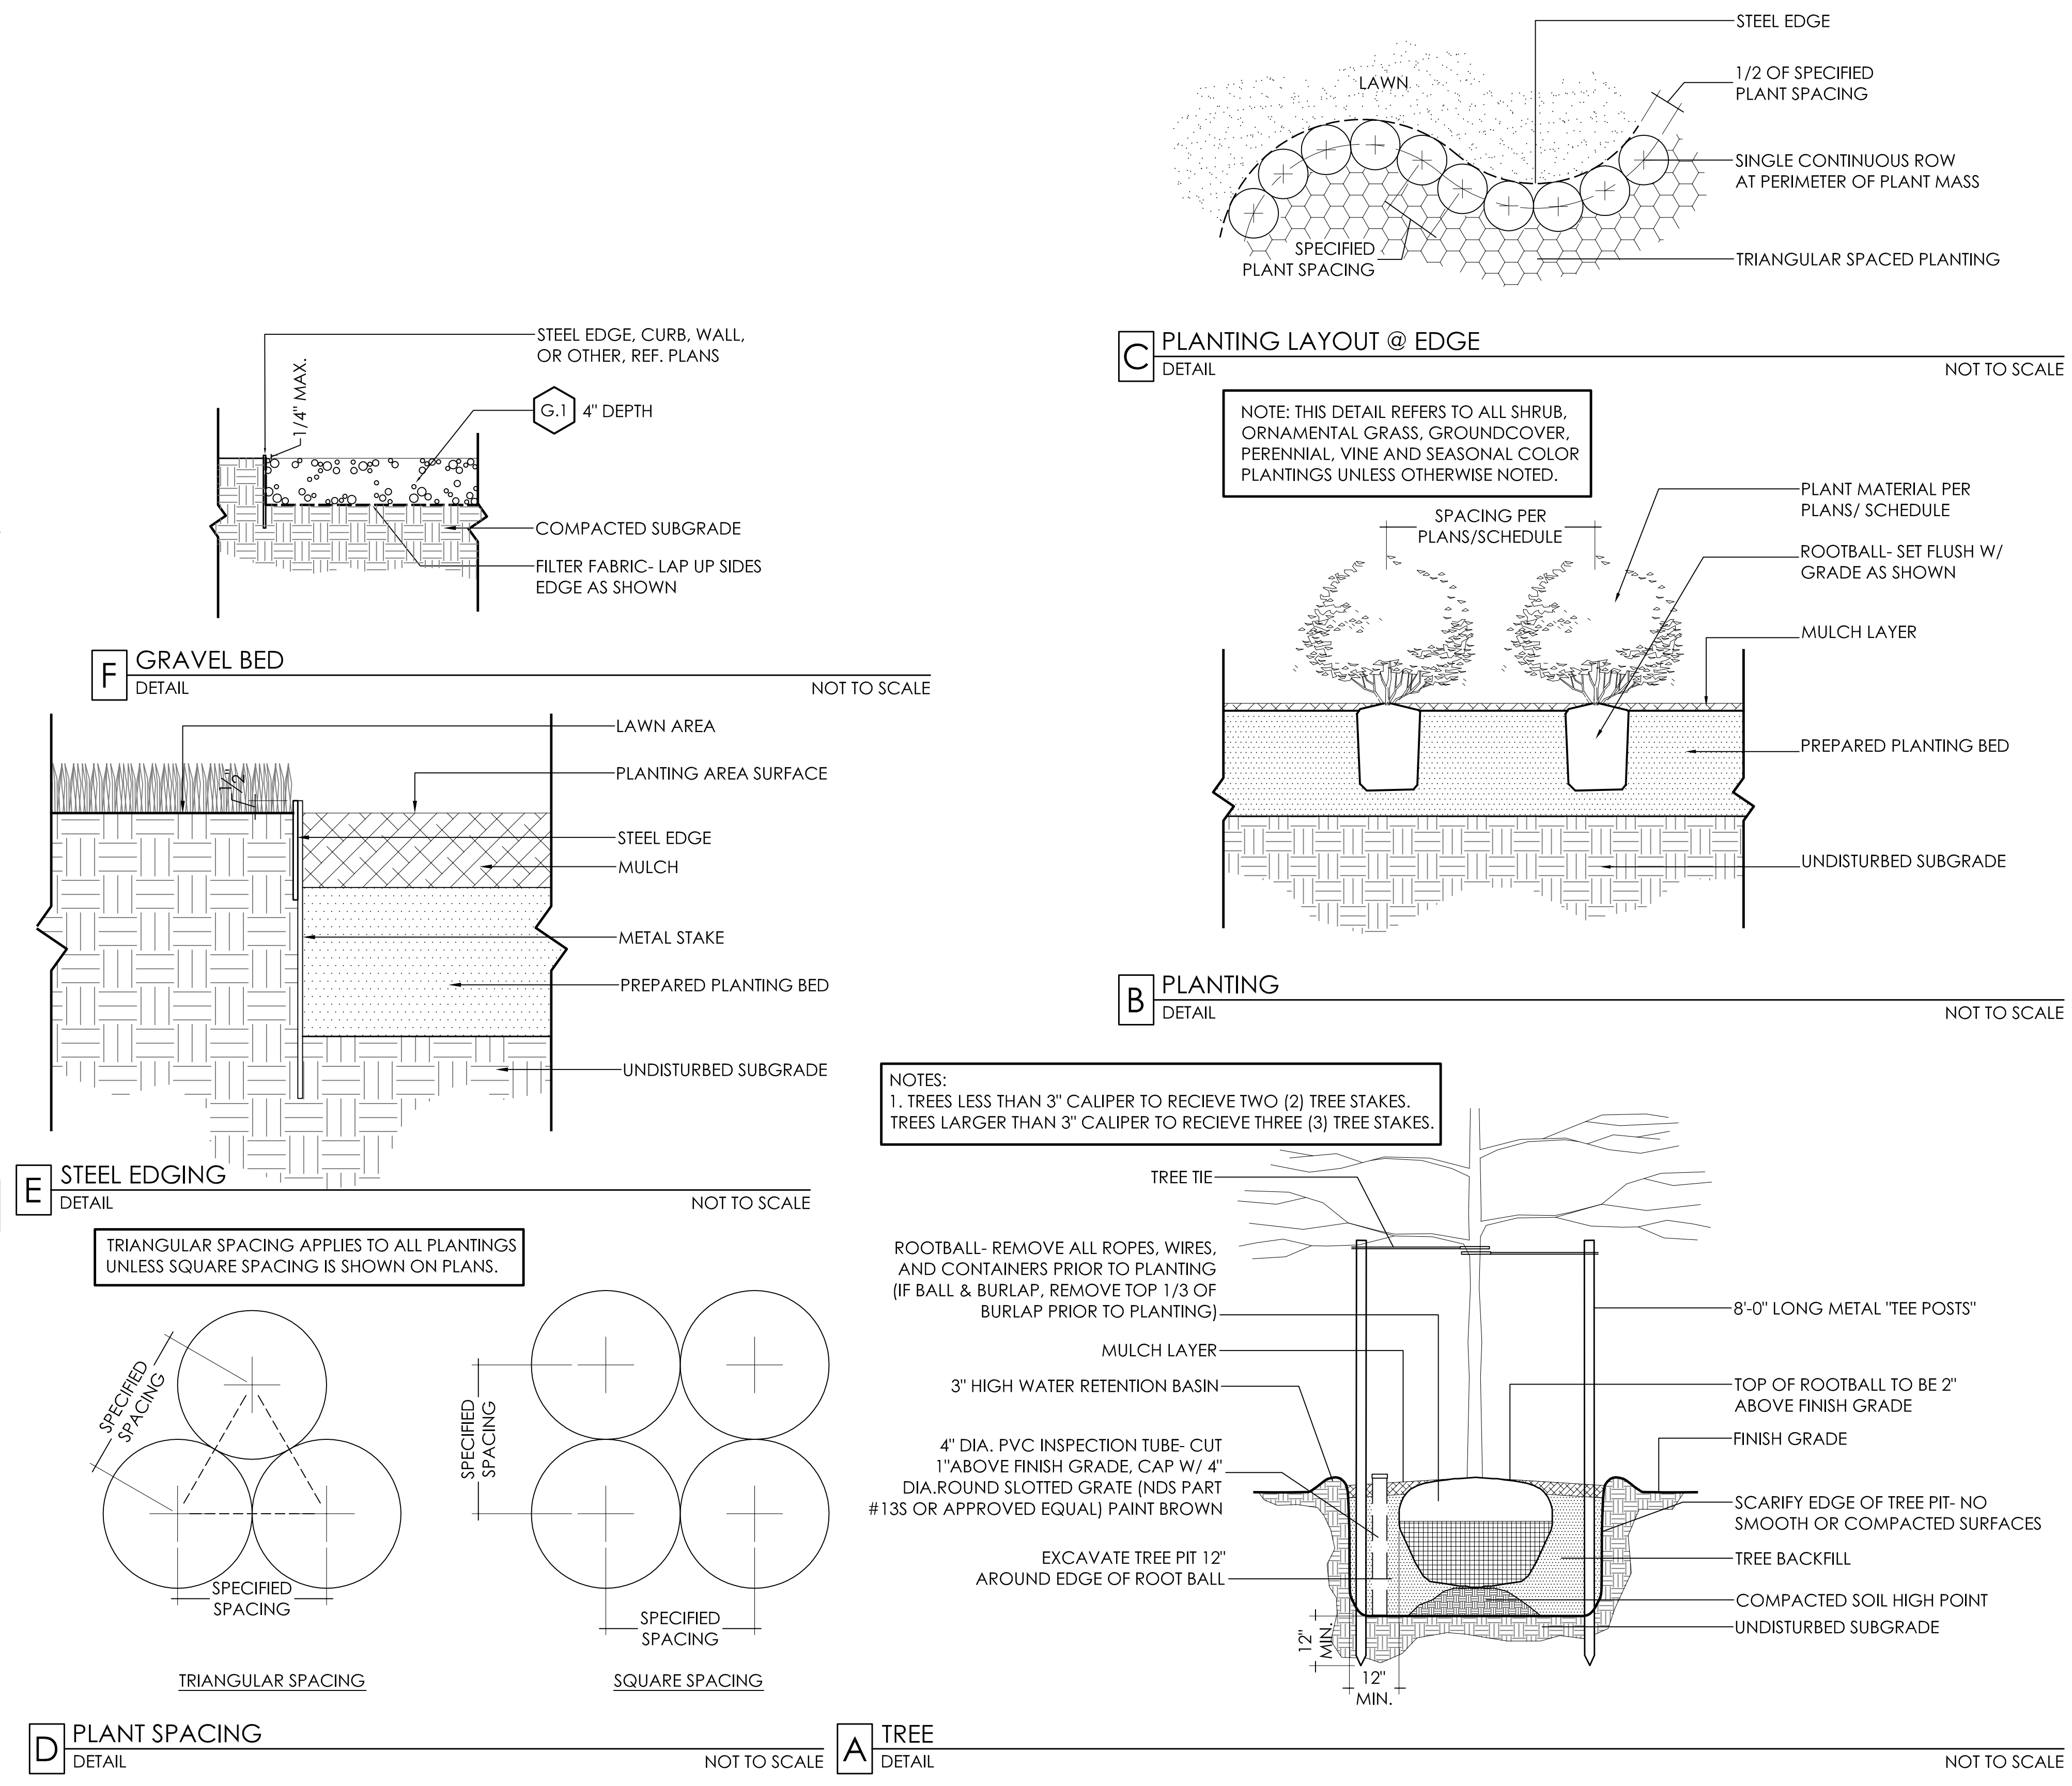

NOTES:  
1. TREES LESS THAN 3" CALIPER TO RECEIVE TWO (2) TREE STAKES.  
TREES LARGER THAN 3" CALIPER TO RECEIVE THREE (3) TREE STAKES.

TRIANGULAR SPACING APPLIES TO ALL PLANTINGS  
UNLESS SQUARE SPACING IS SHOWN ON PLANS.

ROOTBALL- REMOVE ALL ROPES, WIRES,  
AND CONTAINERS PRIOR TO PLANTING  
(IF BALL & BURLAP, REMOVE TOP 1/3 OF  
BURLAP PRIOR TO PLANTING)

MULCH LAYER

3" HIGH WATER RETENTION BASIN

4" DIA. PVC INSPECTION TUBE- CUT  
1" ABOVE FINISH GRADE. CAP W/ 4"  
DIA. ROUND SLOTTED GRATE (NDS PART  
#13S OR APPROVED EQUAL) PAINT BROWN

EXCAVATE TREE PIT 12"  
AROUND EDGE OF ROOT BALL

12" MIN.

12" MIN.

TREE TIE

8'-0" LONG METAL "TEE POSTS"

TOP OF ROOTBALL TO BE 2"  
ABOVE FINISH GRADE

FINISH GRADE

SCARIFY EDGE OF TREE PIT- NO  
SMOOTH OR COMPACTED SURFACES

TREE BACKFILL


COMPACTED SOIL HIGH POINT

UNDISTURBED SUBGRADE

D PLANT SPACING  
DETAIL

A TREE  
DETAIL

NOT TO SCALE

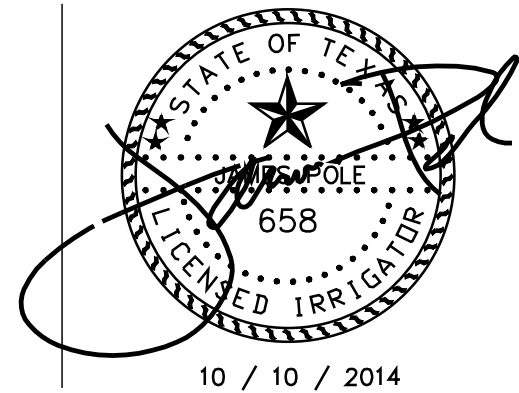

COL-MET SPRAY BOOTHS  
ROCKWALL, TEXAS




ISSUE:

|  |  |
|--|--|
|  |  |
|--|--|


REVISIONS:

|  |  |  |
|--|--|--|
|  |  |  |
|  |  |  |
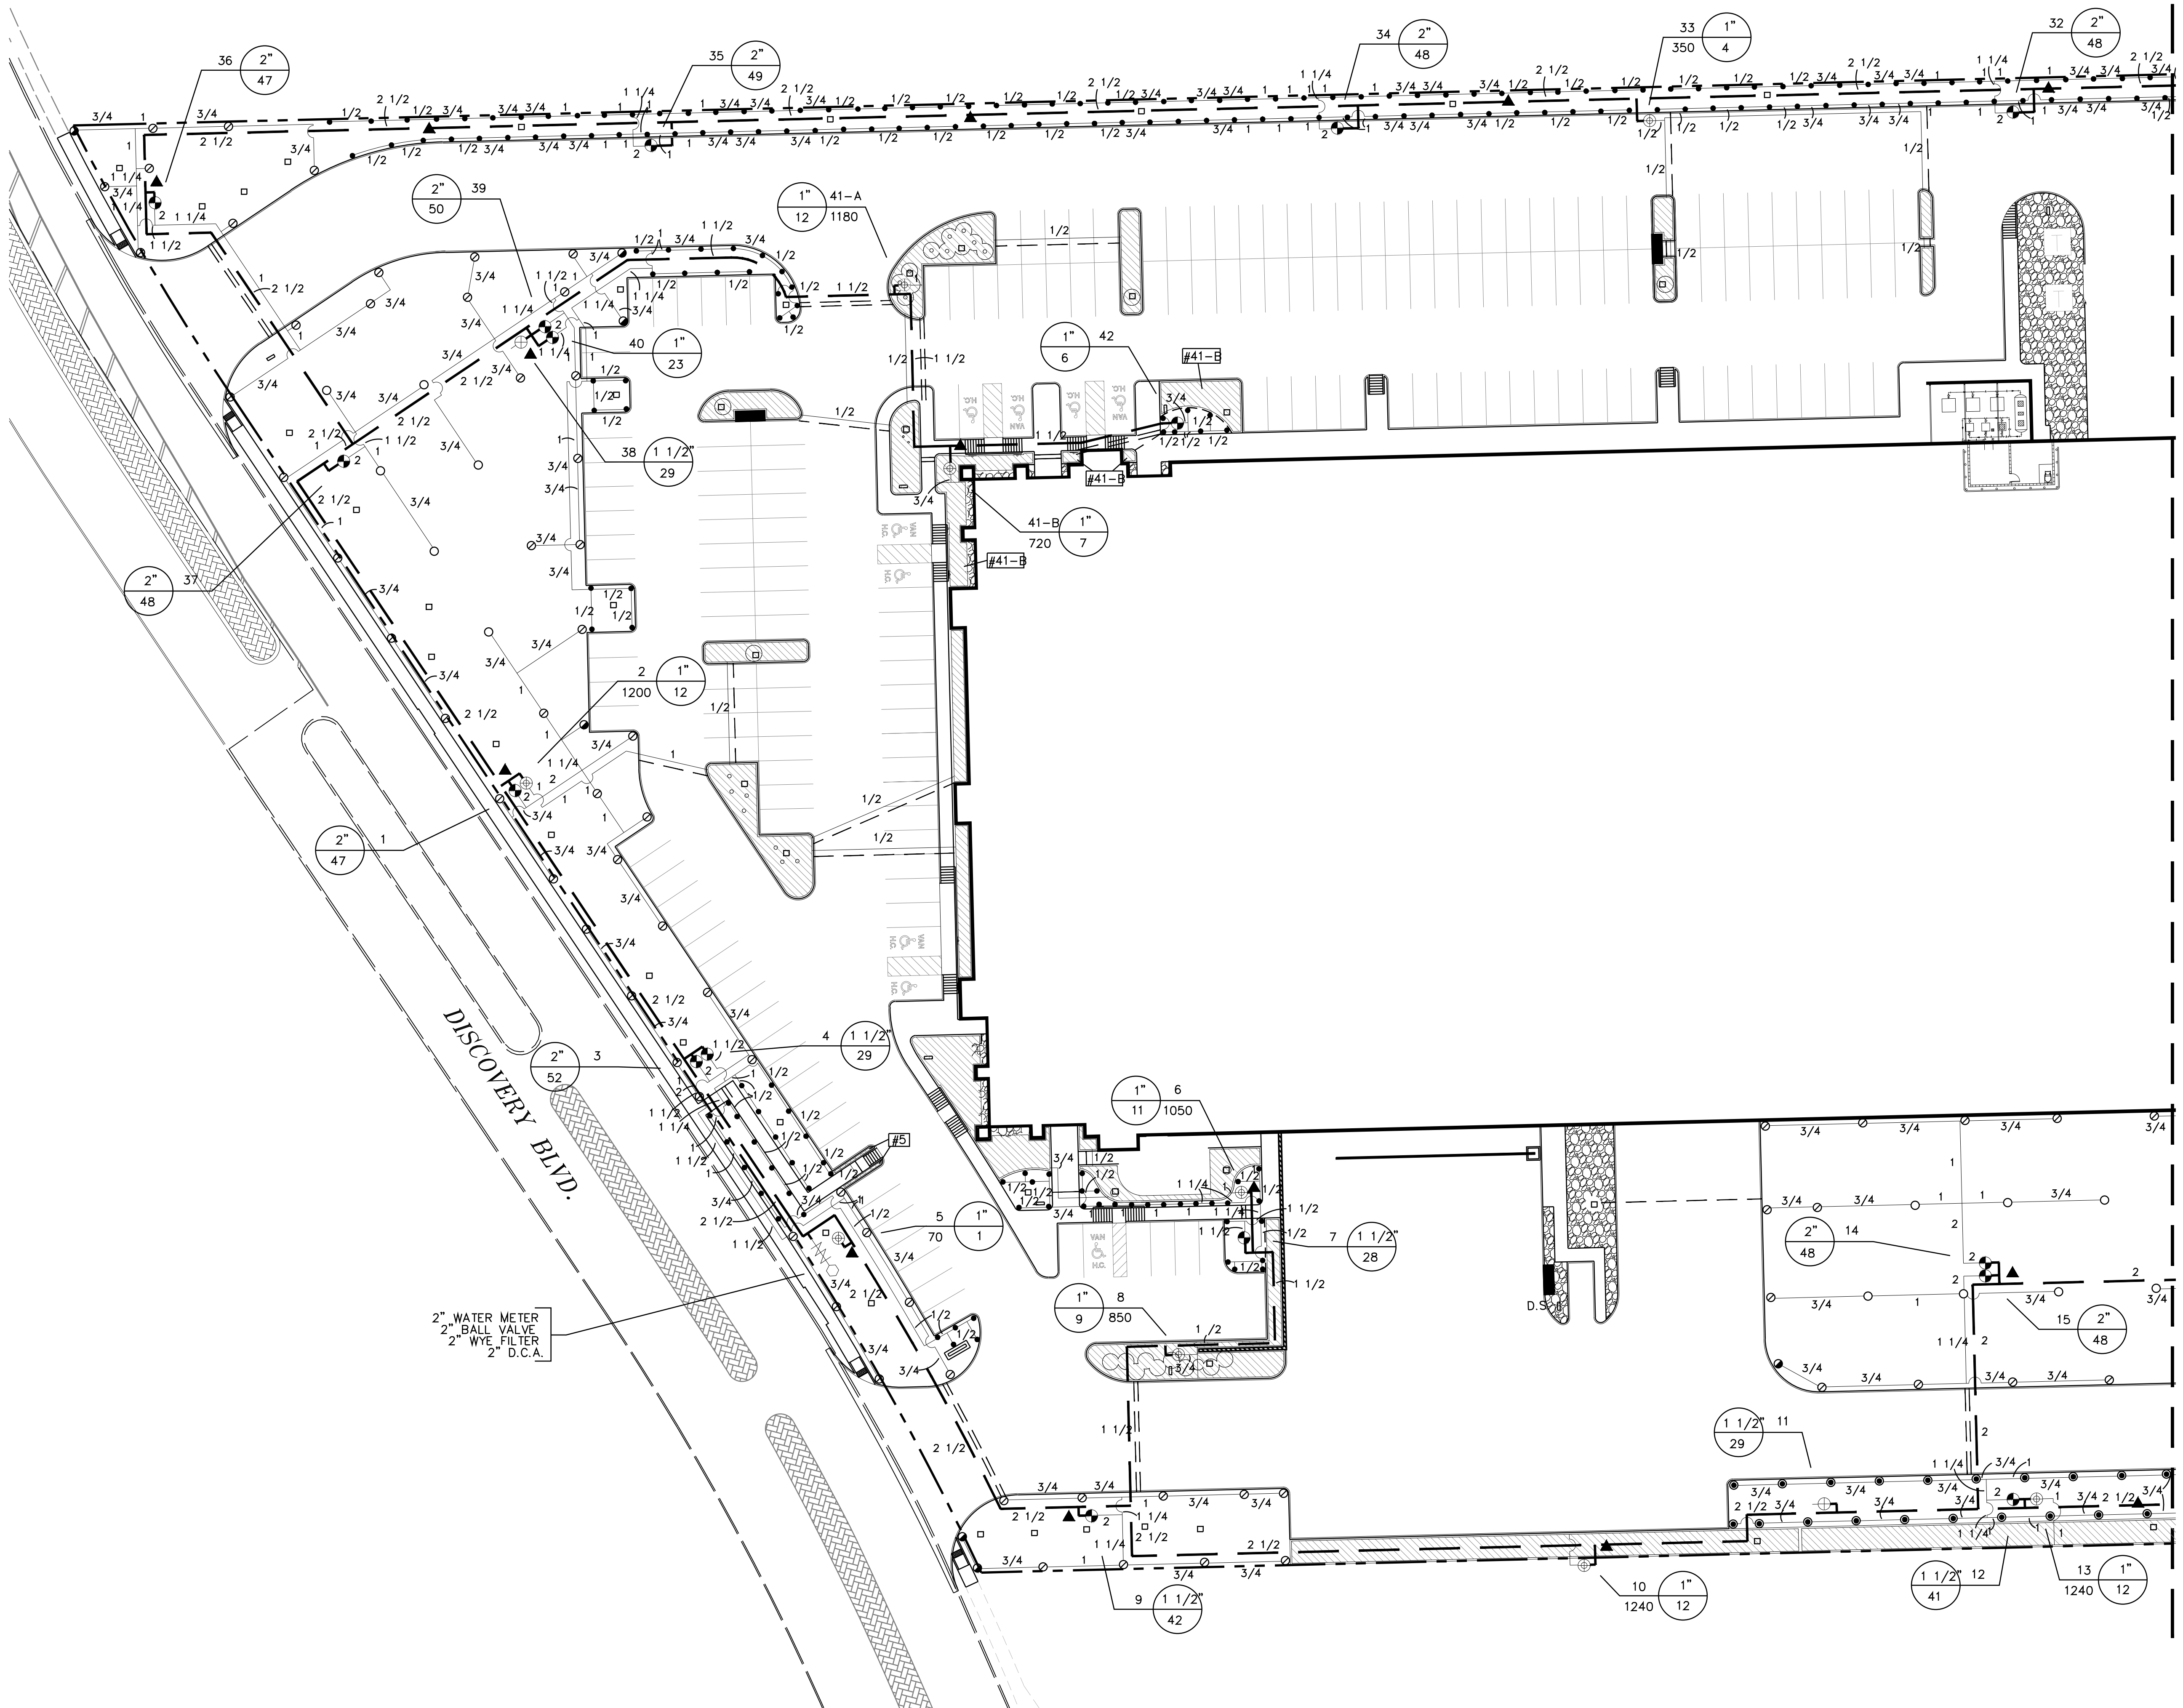


2" WATER METER  
2" BALL VALVE  
2" WYE FILTER  
2" D.C.A.


**James Pole**  
IRRIGATION CONSULTANTS

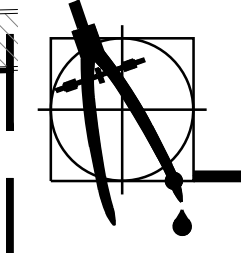


IRRIGATION DESIGN, CONSULTING, AND  
LANDSCAPE WATER MANAGEMENT  
TEXAS L.I.C. #658      PHONE: 940.243.2364  
100 N. LOCUST ST., SUITE 3      FAX: 940.382.2475  
DENTON, TEXAS 76201      james@jamespoleirrigation.com

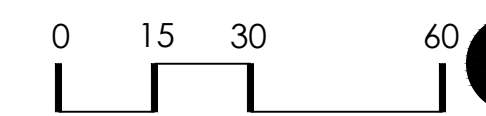

IRRIGATION IN TEXAS IS REGULATED BY  
THE TEXAS COMMISSION ON ENVIRONMENTAL  
QUALITY (TCEQ) (MC-178) P.O. BOX 13087  
T.C.E.Q.'S WEB SITE IS: WWW.TCEQ.STATE.TX.US

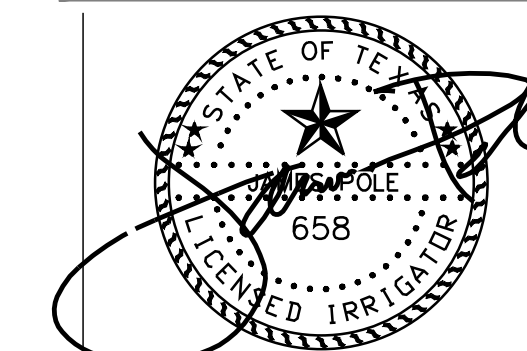

COL-MET SPRAY BOOTHS  
ROCKWALL, TEXAS

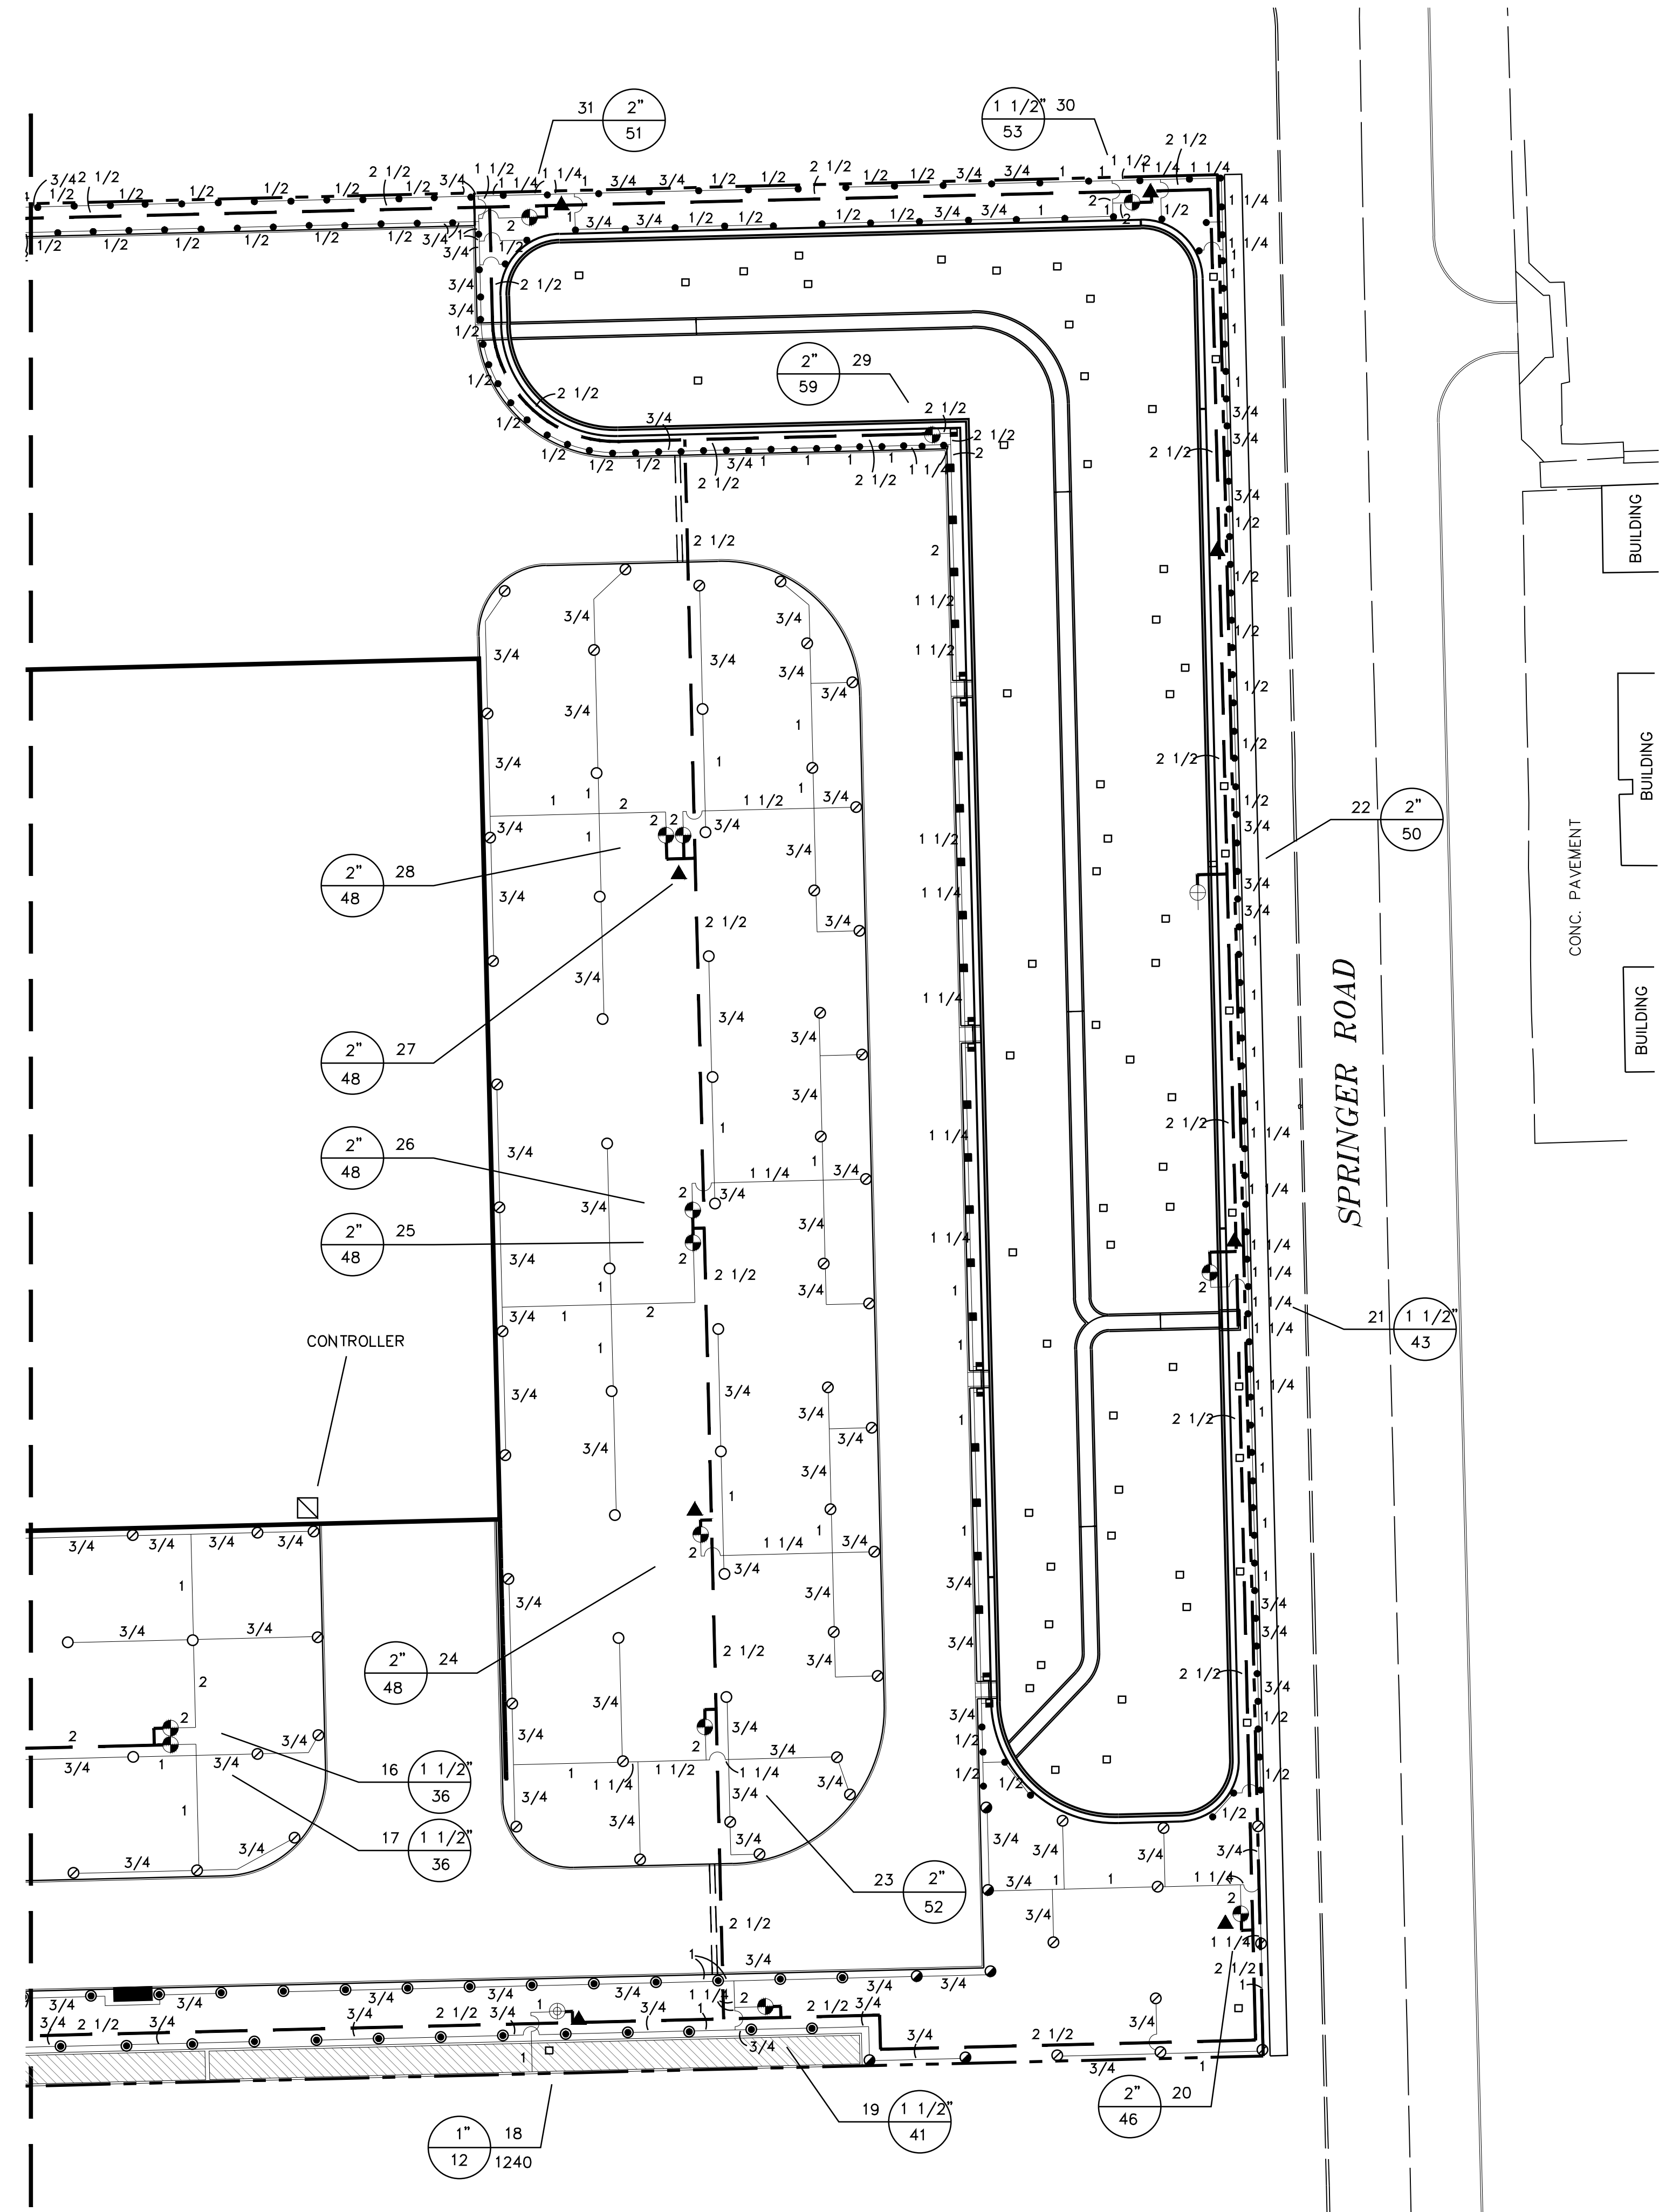

LEGEND

- HUNTER PROS-06-NSI-PRS30 SERIES POP UP SPRAY HEADS WITH HUNTER MSBN-50H STREAM BUBBLER NOZZLES. ( TWO PER TREE )  
SEE INSTALLATION NOTE #13 REGARDING TREE BUBBLER LATERAL PIPE
- /■ HUNTER PROS-04-PRS30 SERIES POP UP SPRAY HEAD WITH SS / ES SERIES STRIP NOZZLE UNLESS NOTED OTHERWISE.
- HUNTER PROS-04-PRS30 SERIES POP UP SPRAY HEAD WITH PRO SPRAY SERIES NOZZLE AS NOTED BELOW
- ▨ HUNTER PLD SERIES ( PLD-06-12 ) DRIP TUBE IN SHRUB BED INSTALLED AT 2" DEPTH  
SEE INSTALLATION NOTE #16 REGARDING DRIP TUBE LAYOUT IN SHRUB BEDS.
- ▩ HUNTER PLD SERIES ( PLD-06-12 ) DRIP TUBE IN NARROW TURF AREAS INSTALLED AT 4" DEPTH  
SEE INSTALLATION NOTE #17 REGARDING DRIP TUBE LAYOUT IN TURF.
- HUNTER PGP ULTRA, ADJUSTABLE ARC 4" POP UP ROTARY HEAD, PART CIRCLE, #2.5 BLUE NOZZLE UNLESS NOTED OTHERWISE
- HUNTER PGP ULTRA, ADJUSTABLE ARC 12" POP UP ROTARY HEAD, PART CIRCLE, #1.0SR BLACK NOZZLE UNLESS NOTED OTHERWISE
- HUNTER PGP ULTRA, ADJUSTABLE ARC 4" POP UP ROTARY HEAD, PART CIRCLE, #4.0 BLUE NOZZLE UNLESS NOTED OTHERWISE
- HUNTER PGP ULTRA, ADJUSTABLE ARC 4" POP UP ROTARY HEAD, FULL CIRCLE, #8.0 BLUE NOZZLE UNLESS NOTED OTHERWISE
- ⊕ HUNTER ICV SERIES ELECTRIC REMOTE CONTROL VALVE
- ⊕ HUNTER ICV SERIES ELECTRIC REMOTE CONTROL, "TREE BUBBLER ZONE" VALVE  
SEE INSTALLATION NOTE #13 REGARDING TREE BUBBLER LATERAL PIPE
- ⊕ HUNTER PCZ-101, ICZ-101, AND ICZ-102 DRIP VALVE ASSEMBLY WITH 40 PSI PRESSURE REGULATOR AND COMMERCIAL BASKET FILTER WITH STAINLESS STEEL SCREEN
- ▲ HUNTER HQ-33-LRC-R QUICK COUPLING VALVE WITH LOCKING PURPLE COVER AND 3/4" PVC BALL VALVE
- ⊕ 2" WILKINS 350 SERIES D.C.A. INSTALLED PER CITY CODE, WITH SAME SIZE WILKINS 850 SERIES BRONZE BALL VALVE AND WILKINS YB SERIES BRONZE WYE FILTER WITH 20 MESH STAINLESS STEEL SCREEN
- 2" IRRIGATION WATER METER AND TAP
- HUNTER IC-4200-M SERIES AUTOMATIC CONTROLLER WITH WRFC WIRELESS RAIN / FREEZE SENSOR  
LOCATE SENSOR AS FIELD DIRECTED BY THE LANDSCAPE ARCHITECT
- CLASS 200 PVC MAINLINE PIPE
- CLASS 200 ( EXCEPT 1/2 INCH #315 ) PVC LATERAL PIPE
- ONE 4" CLASS 200 SLEEVE PIPE UNLESS NOTED OTHERWISE
- TWO 4" CLASS 200 SLEEVE PIPES UNLESS NOTED OTHERWISE

L.I.C. SHALL SELECT PRO-SPRAY SPRAY NOZZLES FOR "HEAD-TO-HEAD" COVERAGE, ADJUSTED FOR NO OVERSPRAY ONTO WALLS AND WALKS. NO OVERSPRAY INTO STREETS IS PERMITTED.

TEMPORARY IRRIGATION

THE CONTRACTOR SHALL COORDINATE WITH THE PLANTING PLAN AND PROVIDE TEMPORARY IRRIGATION FOR THE ESTABLISHMENT OF ALL PROPOSED PLANT MATERIALS LOCATED OUTSIDE THE LIMITS OF COVERAGE PROVIDED BY THE PERMANENT SYSTEM.

**James Pole**  
IRRIGATION CONSULTANTS  
IRRIGATION DESIGN, CONSULTING, AND LANDSCAPE WATER MANAGEMENT  
TEXAS L.I.C. #658      PHONE: 940.243.2364  
100 N. LOCUST ST., SUITE 3      FAX: 940.382.2475  
DENTON, TEXAS 76201      james@jamespoleirrigation.com




IRRIGATION IN TEXAS IS REGULATED BY THE TEXAS COMMISSION ON ENVIRONMENTAL QUALITY ( TCEQ ) ( MC-178 ) P.O. BOX 13087 T.C.E.Q.'S WEB SITE IS: WWW.TCEQ.STATE.TX.US

ISSUE:

|  |
|--|
|  |
|--|

REVISIONS:

|  |  |  |
|--|--|--|
|  |  |  |
|  |  |  |
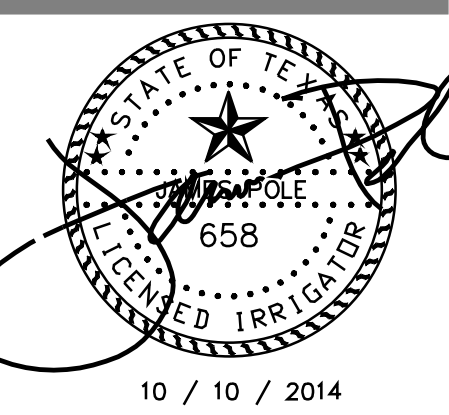

COL-MET SPRAY BOOTHS  
 ROCKWALL, TEXAS



ISSUE:

|  |
|--|
|  |
|  |
REVISIONS:





|  |  |
|--|--|
|  |  |
|  |  |
IRRIGATION NOTES & DETAILS

L2.3

INSTALLATION NOTES

- COORDINATE IRRIGATION INSTALLATION WITH PLANTING PLAN AND SITE CONDITIONS TO PROVIDE COMPLETE COVERAGE WITH MINIMUM OVERSPRAY. THE IRRIGATION CONTRACTOR SHALL MAKE MINOR ADJUSTMENTS TO ENSURE PROPER COVERAGE AT NO ADDITIONAL COST TO THE OWNER.
- THE IRRIGATION CONTRACTOR SHALL COMPLY WITH ALL LOCAL AND STATE MANDATED IRRIGATION ORDINANCES AND CODES, AND WILL SECURE ALL REQUIRED PERMITS. I.L.C. SHALL PAY ANY ASSOCIATED FEES UNLESS OTHERWISE NOTED. ALL LOCAL CODES SHALL PREVAIL OVER ANY DISCREPANCIES HEREIN AND SHALL BE ADDRESSED BEFORE ANY CONSTRUCTION BEGINS.
- CONFIRM MINIMUM STATIC WATER PRESSURE OF 60 PSI AT THE HIGHEST ELEVATION OF THE SYSTEM LIMITS, AND MAXIMUM STATIC WATER PRESSURE OF 90 P.S.I. AT THE LOWEST ELEVATION OF THE SYSTEM LIMITS AT LEAST 7 DAYS BEFORE BEGINNING WORK. IF STATIC WATER PRESSURE IS OUTSIDE THE RANGE STATED ABOVE, DO NOT PROCEED UNTIL DIRECTED BY THE LANDSCAPE ARCHITECT.
- LATERAL PIPE SHALL BE INSTALLED AT A MINIMUM DEPTH OF 12 INCHES. MAINLINE PIPE AND WIRES SHALL BE INSTALLED AT A MINIMUM DEPTH OF 18 INCHES. NO MACHINE TRENCHING SHALL BE PERMITTED WITHIN EXISTING TREE ROOT ZONES. WHEN HAND - TRENCHING WITHIN EXISTING TREE ROOT ZONES, NO ROOTS LARGER THAN 1" DIAMETER SHALL BE CUT.
- UNSLEEVED PIPES MAY BE SHOWN UNDER PAVEMENT FOR GRAPHIC CLARITY ONLY. INSTALL THESE PIPES IN ADJACENT LANDSCAPED AREAS.
- ELECTRIC POWER SHALL BE PROVIDED WITHIN FIVE FEET OF CONTROLLER LOCATION BY GENERAL CONTRACTOR. I.L.C. TO PROVIDE FINAL HARD-WIRE TO CONTROLLER.
- 24 VOLT VALVE WIRE SHALL BE A MINIMUM OF #14 GAUGE, U.F. APPROVED FOR DIRECT BURIAL, SINGLE CONDUCTOR "IRRIGATION WIRE". WIRE SPLICES SHALL INCLUDE DBY CONNECTORS AS MANUFACTURED BY 3M COMPANY. ALL FIELD SPLICES SHALL BE LOCATED IN A ROUND VALVE BOX OF SUFFICIENT SIZE TO ALLOW INSPECTION.
- VALVE BOXES SHALL BE INSTALLED FLUSH WITH GRADE, SUPPORTED BY BRICKS IF NEEDED, WITH 3 INCHES OF CLEAN PEA GRAVEL LOCATED BELOW THE VALVE. USE 12" x 17" RECTANGULAR VALVE BOXES WITH PURPLE LID FOR QUICK COUPLING VALVES, AND 10" ROUND BOXES FOR ELECTRIC VALVES UNLESS NOTED OTHERWISE. D.C.A., WITH UPSTREAM BALL VALVE AND WYE FILTER SHALL BE BOXED AND LOCATED ACCORDING TO LOCAL CODE.
- USE RIGID SCH. 80 PVC SWING JOINT ASSEMBLIES TO CONNECT ALL ROTARY HEADS AND QUICK COUPLERS.
- ALL SPRAY HEADS SHALL BE CONNECTED WITH A 12" MINIMUM LENGTH OF 1/2" FLEX PVC. THE FLEX PVC SHALL BE SOLVENT WELDED TO SCHEDULE 40 PVC FITTINGS WITH WELD-ON #795 SOLVENT AND #P-70 PRIMER.
- PROVIDE ONE QUICK COUPLER KEY WITH SWIVEL HOSE ELL FOR EVERY SIX Q.C. VALVES. ( MINIMUM ONE SET ).
- CONTRACTOR IS TO CONTACT APPROPRIATE AUTHORITIES AND LOCATE ALL UTILITIES PRIOR TO CONSTRUCTION.
- LATERAL PIPE TO TREE STREAM BUBBLER HEADS IS OMITTED FOR GRAPHIC CLARITY. CONNECT TREE BUBBLER HEADS TO VALVES AS SHOWN WITH CLASS 200 PVC PIPE SIZED TO ALLOW A MAXIMUM FLOW VELOCITY OF 5 FEET PER SECOND
- THE PROPOSED LOCATIONS OF ALL ABOVE- GROUND EQUIPMENT INCLUDING BACKFLOW PREVENTORS, CONTROLLERS AND WEATHER SENSORS SHALL BE STAKED BY THE CONTRACTOR FOR APPROVAL BY THE LANDSCAPE ARCHITECT OR OWNER'S REPRESENTATIVE BEFORE THESE ITEMS ARE INSTALLED.
- ALL HEADS SHALL BE INSTALLED A MINIMUM OF 4" FROM PAVEMENT EDGES. ( 6" OR GREATER WHERE REQUIRED BY LOCAL CODE ) FINAL ADJUSTMENTS BY THE CONTRACTOR SHALL INCLUDE THE ADDITION OF CHECK VALVES WHERE NEEDED TO PREVENT EXCESSIVE LOW HEAD DRAINAGE. THE CONTRACTOR SHALL BUDGET FOR, AND INSTALL CHECK VALVES FOR UP TO 10 % OF THE TOTAL NUMBER OF HEADS WHEN NEEDED, WITH NO ADDITIONAL COST TO THE OWNER.
- WHERE SHOWN ON THE PLANS, MASS SHRUB / GROUNDCOVER BEDS SHALL INCLUDE HUNTER PLD SERIES DRIP TUBE WITH PRE-INSTALLED .6 GPH DRIP EMITTERS AT 12" INTERVALS, INSTALLED IN CENTER-FED GRIDS WITH ROWS SPACED 18" APART. INDIVIDUAL DRIP TUBE RUNS SHALL NOT EXCEED 150 L.F. PVC LATERAL "TRUNK" LINES SHALL BE INSTALLED 10" DEEP. DRIP TUBE SHALL BE SET 2" BELOW FINISHED SOIL GRADE ( NOT INCLUDING MULCH LAYER ), AND SECURELY STAKED EVERY 18". FLUSH VALVES SHALL BE INSTALLED AT THE FARTHEST POINTS FROM THE ZONE VALVE. USE 17 MM BARBED FITTINGS FOR DRIP LINE CONNECTIONS, SET THE MAXIMUM OPERATING PRESSURE AT 30 PSI. DRIP TUBE SHALL BE INSTALLED PERPENDICULAR TO SLOPE FACE. INSTALL IN-LINE CHECK VALVES EVERY 4.5 FEET OF DRIP LINE ELEVATION CHANGE WITHIN THE ZONE. USE STAPLES TO SECURE TUBING EVERY 18". EACH DRIP ZONE SHALL INCLUDE ONE MAINTENANCE "FLAG" WHICH SHALL CONSIST OF A 12" POP-UP SPRAY HEAD AND COMPLETELY CLOSED SPRAY NOZZLE. THE POP-UP HEAD SHALL BE CONNECTED TO THE DRIP ZONE PIPE, SET FLUSH WITH GRADE, AND LOCATED AT THE FARTHEST DISTANCE FROM THE DRIP VALVE ASSEMBLY. INSTALL THE "FLAG" HEAD ADJACENT TO EDGING OR IN LOW PLANTINGS FOR EASE OF VIEWING.
- WHERE SHOWN ON THE PLANS, SPECIFIC TURF AREAS SHALL INCLUDE HUNTER PLD SERIES DRIP TUBE WITH PRE-INSTALLED .6 GPH DRIP EMITTERS AT 12" INTERVALS, INSTALLED IN CENTER-FED GRIDS WITH ROWS SPACED 12" APART. INDIVIDUAL DRIP TUBE RUNS SHALL NOT EXCEED 150 L.F. PVC LATERAL "TRUNK" LINES SHALL BE INSTALLED 10" DEEP. DRIP TUBE SHALL BE SET 4" BELOW FINISHED SOIL GRADE AND SECURELY STAKED EVERY 18". FLUSH VALVES SHALL BE INSTALLED AT THE FARTHEST POINTS FROM THE ZONE VALVE. USE 17 MM BARBED FITTINGS FOR DRIP LINE CONNECTIONS, SET THE MAXIMUM OPERATING PRESSURE AT 30 PSI. DRIP TUBE SHALL BE INSTALLED PERPENDICULAR TO SLOPE FACE. INSTALL IN-LINE CHECK VALVES EVERY 4.5 FEET OF DRIP LINE ELEVATION CHANGE WITHIN THE ZONE. USE STAPLES TO SECURE TUBING EVERY 18". EACH DRIP ZONE SHALL INCLUDE ONE MAINTENANCE "FLAG" WHICH SHALL CONSIST OF A 12" POP-UP SPRAY HEAD AND COMPLETELY CLOSED SPRAY NOZZLE. THE POP-UP HEAD SHALL BE CONNECTED TO THE DRIP ZONE PIPE, SET FLUSH WITH GRADE, AND LOCATED AT THE FARTHEST DISTANCE FROM THE DRIP VALVE ASSEMBLY. INSTALL THE "FLAG" HEAD ADJACENT TO EDGING OR IN LOW PLANTINGS FOR EASE OF VIEWING.

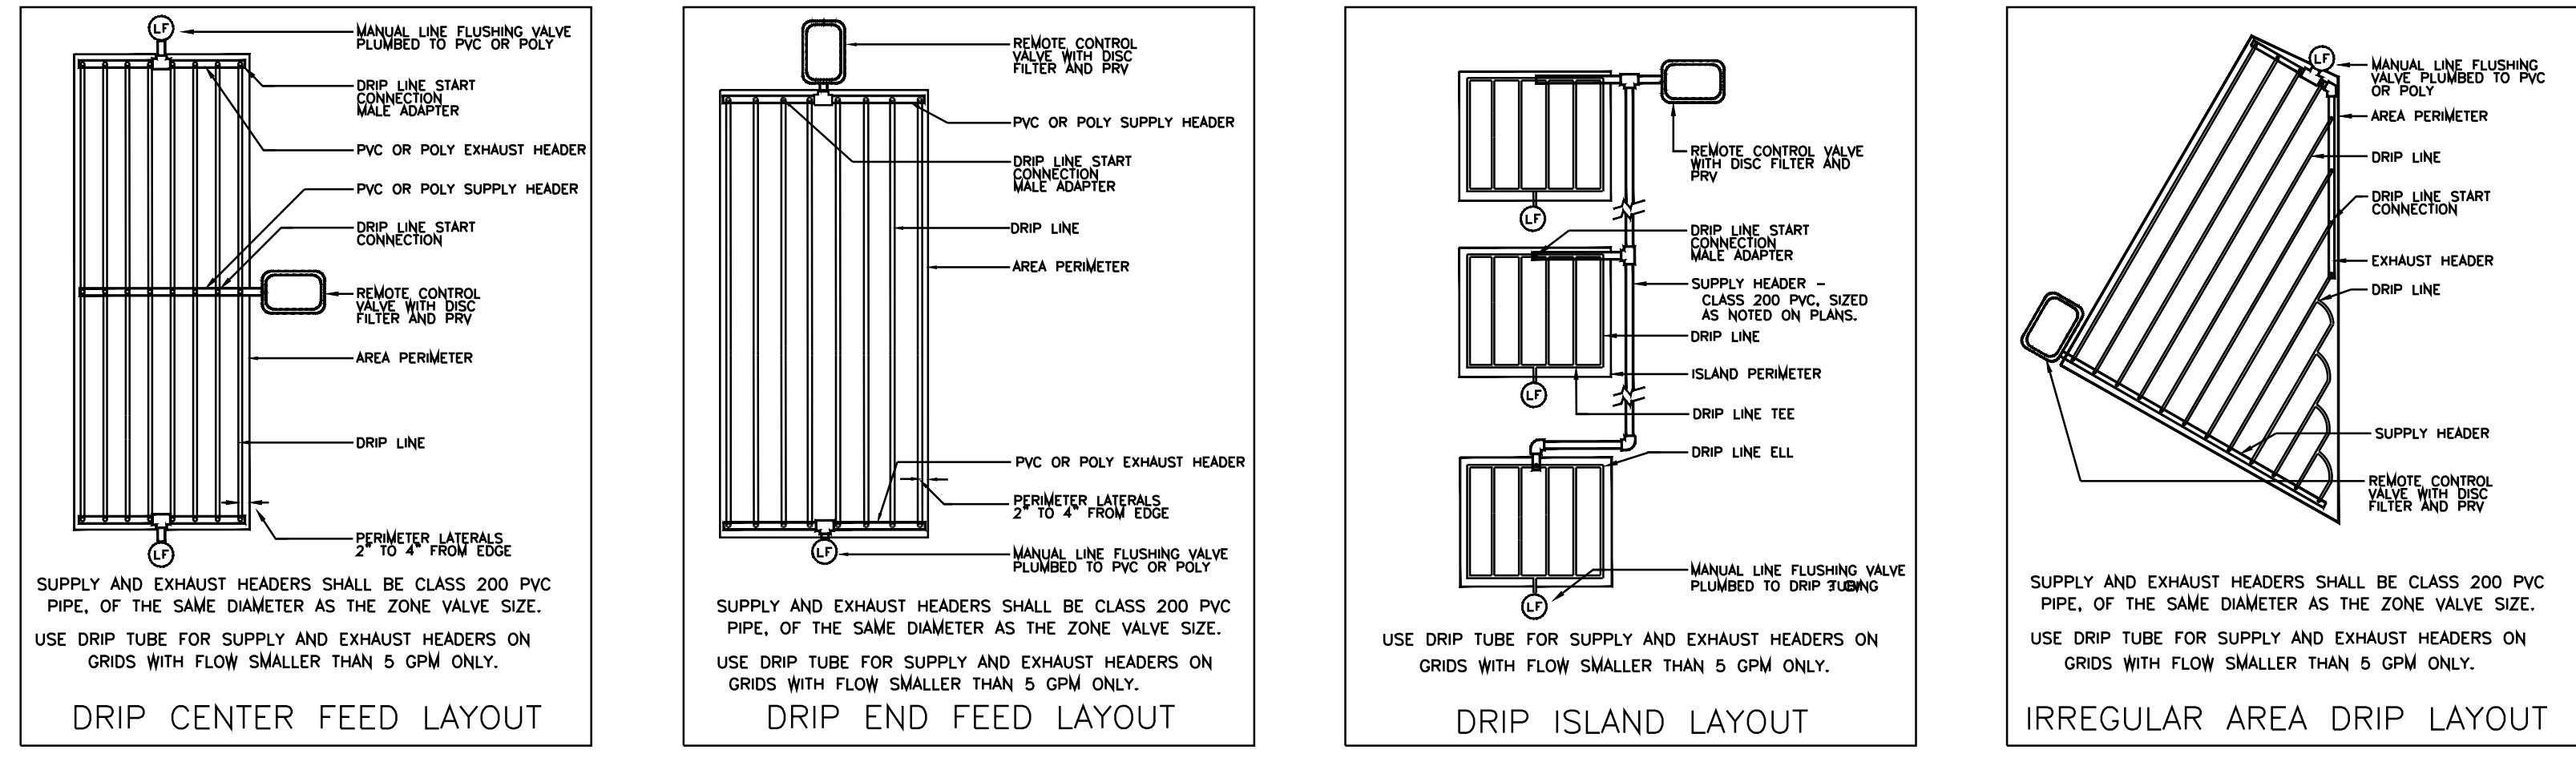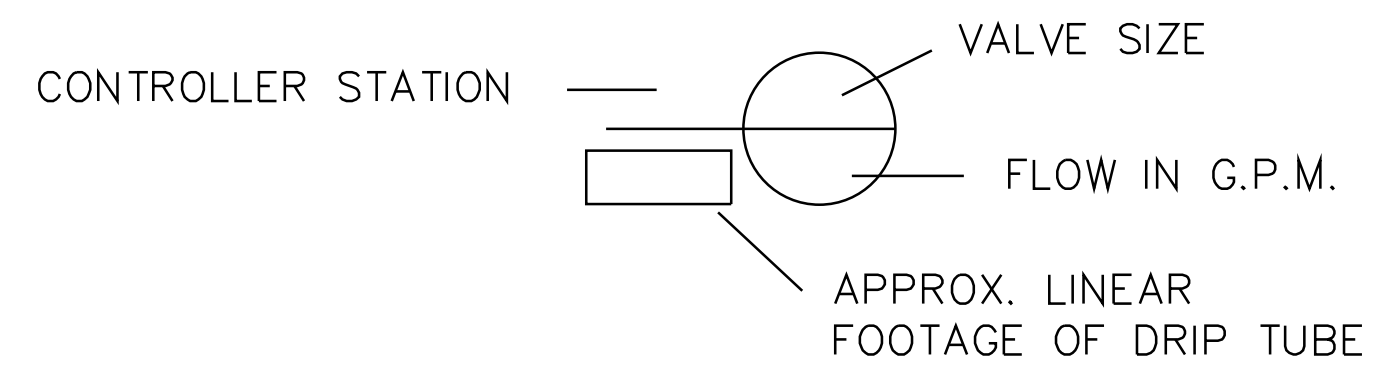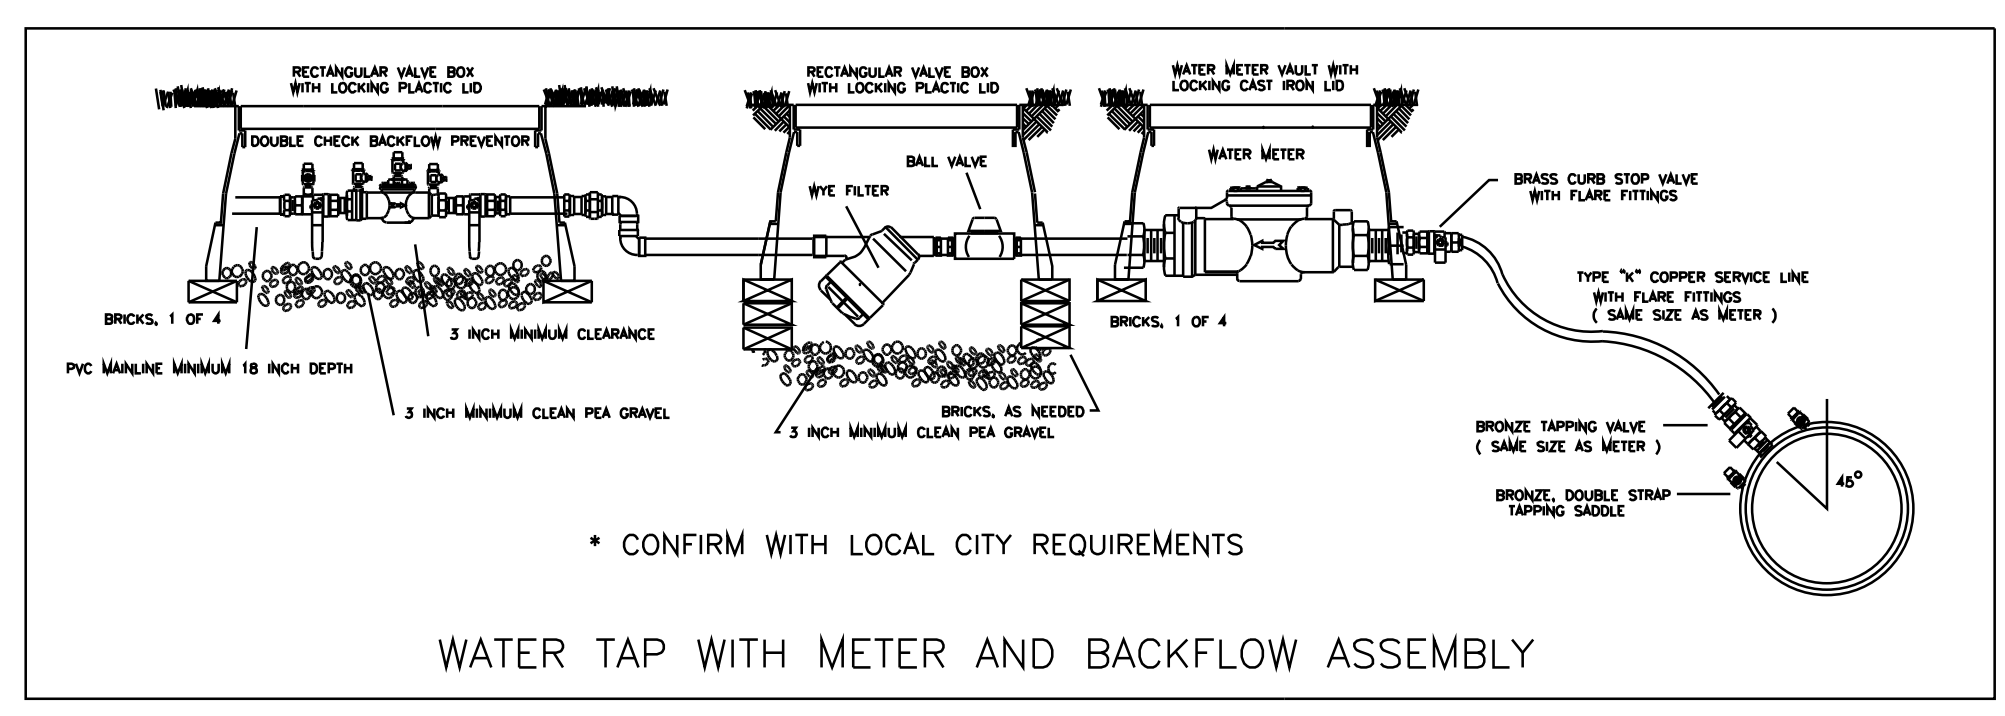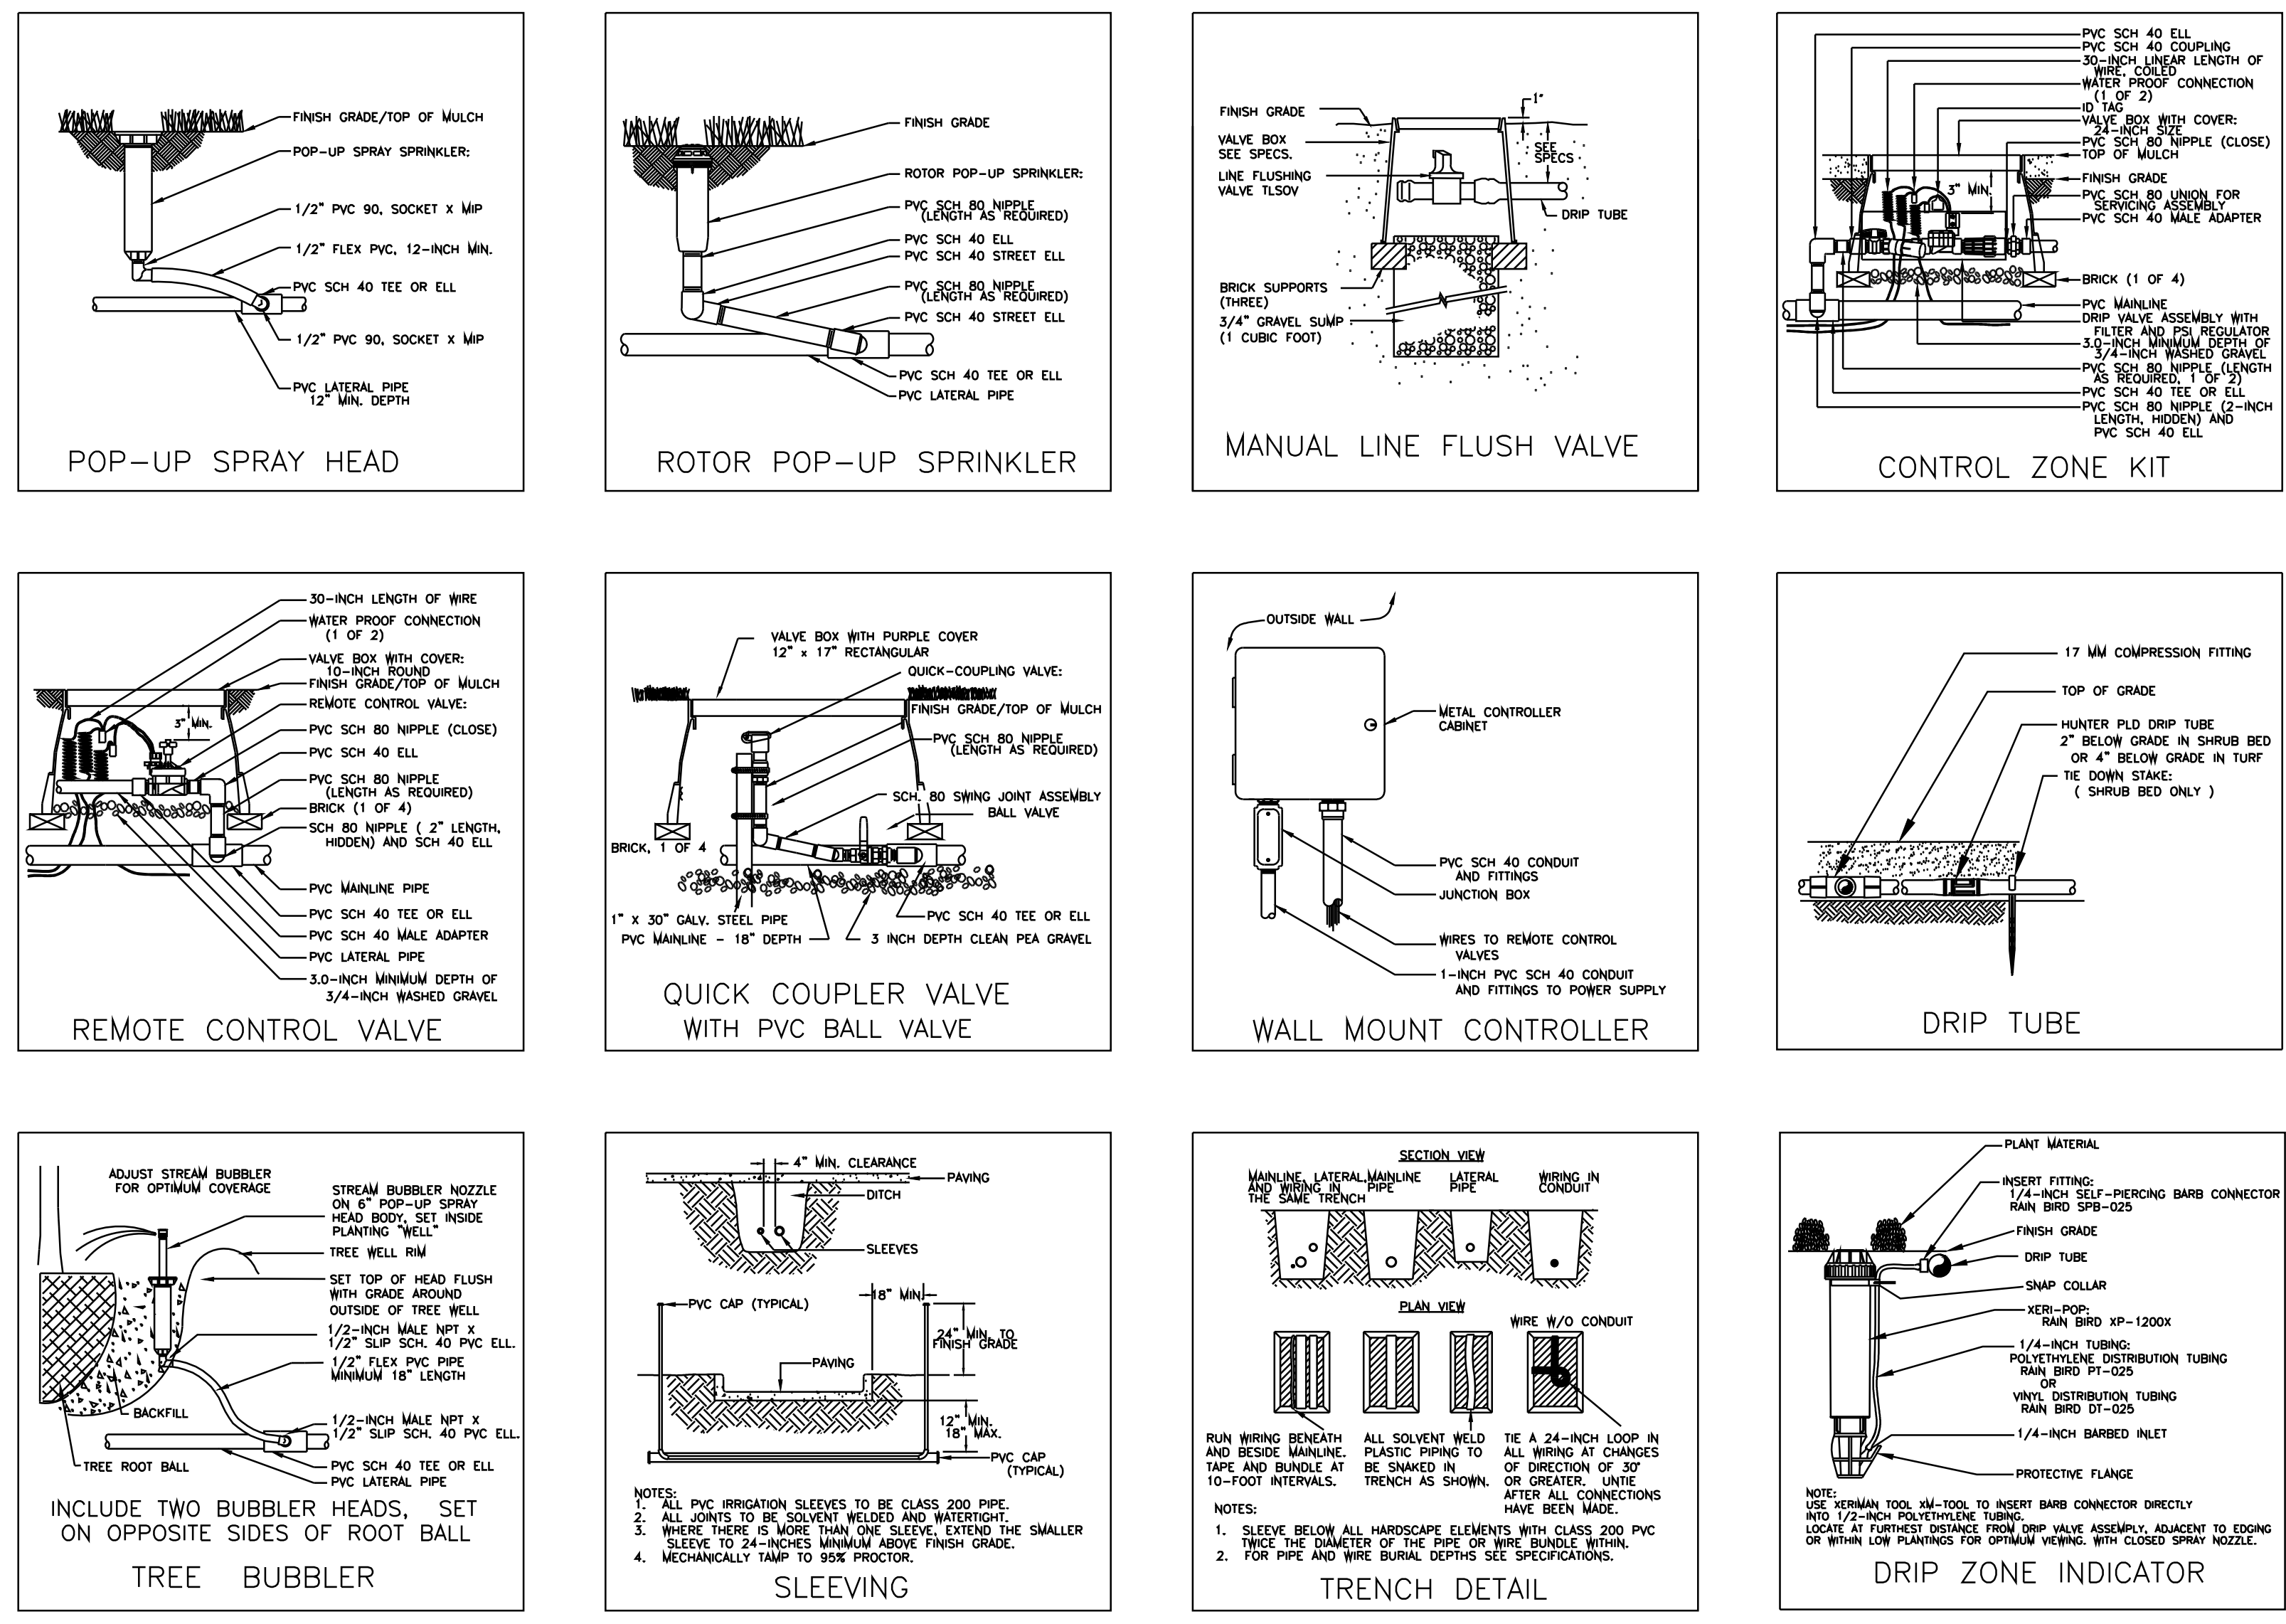

TEMPORARY IRRIGATION

THE CONTRACTOR SHALL COORDINATE WITH THE PLANTING PLAN AND PROVIDE TEMPORARY IRRIGATION FOR THE ESTABLISHMENT OF ALL PROPOSED PLANT MATERIALS LOCATED OUTSIDE THE LIMITS OF COVERAGE PROVIDED BY THE PERMANENT SYSTEM.

MINIMUM STATIC PRESSURE = 65 PSI  
 DESIGN PRESSURE = 58 PSI

**James Pole**  
 IRRIGATION CONSULTANTS  
 IRRIGATION DESIGN, CONSULTING, AND LANDSCAPE WATER MANAGEMENT  
 TEXAS L.I.C. #658 100 N. LOCUST ST., SUITE 3 DENTON, TEXAS 76201  
 PHONE: 940.243.2364 FAX: 940.382.2475  
 james@jamespoleirrigation.com

EPA WaterSense PARTNER  
 IRRIGATION IN TEXAS IS REGULATED BY THE TEXAS COMMISSION ON ENVIRONMENTAL QUALITY ( TCEQ ) ( MC-178 ) P.O. BOX 13087 T.C.E.Q.'S WEB SITE IS: WWW.TCEQ.STATE.TX.US

PRINTED: 10/30/2015 10:30:20 AM STB FILE: WIER-PAVING STB LAST SAVED: 10/30/2015 2:44 PM SAVED BY: PHILIP FILE: LEGEND-14029.DWG

**EXISTING TOPOGRAPHIC LEGEND**

|  |  |
|--|--|
|  | ASPHALT PAVEMENT                           |
|  | BOLLARD/GUARD POST                         |
|  | DIMENSION TO BACK OF CURB                  |
|  | CABLE TV                                   |
|  | CONTROL MONUMENT                           |
|  | CONCRETE                                   |
|  | EDGE OF ASPHALT PAVEMENT                   |
|  | ELEC BOX (GROUND)                          |
|  | ELEC METER                                 |
|  | FIRE HYDRANT                               |
|  | FIBER OPTIC CABLE                          |
|  | GAS METER                                  |
|  | GAS MANHOLE                                |
|  | GAS TEST STATION                           |
|  | GUY WIRE                                   |
|  | CONCRETE HEADWALL                          |
|  | IRRIGATION CONTROL VALVE                   |
|  | IRON ROD FOUND                             |
|  | IRON ROD SET                               |
|  | LIGHT POLE                                 |
|  | POWER POLE                                 |
|  | POWER POLE W/LIGHT                         |
|  | STORM DRAIN MANHOLE                        |
|  | SPRINKLER HEAD                             |
|  | SIGN                                       |
|  | SANITARY SEWER MANHOLE                     |
|  | SANITARY SEWER CLEANOUT                    |
|  | SOUTH WESTERN BELL TELEPHONE               |
|  | TELEPHONE PEDESTAL                         |
|  | TELEPHONE SWITCH GEAR                      |
|  | TRAFFIC SIGNAL BOX                         |
|  | TRAFFIC SIGNAL POLE                        |
|  | TRAFFIC SIGNAL CONTROLLER                  |
|  | TRANSFORMER PAD                            |
|  | WATER METER                                |
|  | WATER VALVE                                |
|  | OVERHEAD ELECTRIC LINE                     |
|  | UNDERGROUND ELECTRIC LINE                  |
|  | WATER LINE                                 |
|  | SANITARY SEWER LINE                        |
|  | FIBER OPTIC LINE                           |
|  | UNDERGROUND TELEPHONE                      |
|  | OVERHEAD TELEPHONE                         |
|  | UNDERGROUND GAS                            |
|  | EXISTING CONCRETE STORM DRAIN LINE         |
|  | EXISTING CORREGATED METAL STORM DRAIN LINE |
|  | EXISTING FLOWLINE                          |
|  | BARBED WIRE FENCE                          |
|  | CHAIN LINK FENCE                           |
|  | WOOD FENCE                                 |
|  | GUARD RAIL / BARRICADE                     |
|  | EXISTING TREE LINE                         |
|  | EXISTING TREE                              |

**PAVING PLAN LEGEND**

|  |   |
|--|---|
|  | 8' 3,600 P.S.I. REINFORCED CONCRETE TRUCK DOCK & DUMPSTER PAVEMENT (MIN. 6.5 SACK MIX)            |
|  | 7' 3,600 P.S.I. REINFORCED CONCRETE TRUCK ROUTE & FIRE LANE PAVEMENT (MIN. 6.5 SACK MIX)          |
|  | 6' 3,600 P.S.I. REINFORCED CONCRETE FIRE LANE PAVEMENT (MIN. 6.5 SACK MIX)                        |
|  | 5' 3,600 P.S.I. REINFORCED CONCRETE LIGHT DUTY PAVEMENT (MIN. 6.5 SACK MIX)                       |
|  | 8' 4,200 P.S.I. REINFORCED CONCRETE PUBLIC DRIVE APPROACH (MIN. 7.0 SACK MIX)                     |
|  | 4' 3,000 P.S.I. REINFORCED CONCRETE SIDEWALK (MIN. 5.5 SACK MIX)                                  |
|  | HANDICAP RAMP DETECTIBLE WARNING (TRUNCATED DOME PLATES SAME COLOR AS THE REDC AND R.O.W. PLATES) |
|  | PROPOSED EDGE OF PAVEMENT   |
|  | FUTURE EDGE OF PAVEMENT   |
|  | L2 LINE IDENTIFIED IN LINE TABLE  |
|  | C2 CURVE IDENTIFIED IN CURVE TABLE  |
|  | B/B BACK OF CURB TO BACK OF CURB  |
|  | PROPOSED CHAIN LINK FENCE   |
|  | PROPOSED BARBED WIRE FENCE  |
|  | PROPOSED WOOD / STOCKADE FENCE  |
|  | PROPOSED BARRICADE / GUARD RAIL   |
|  | PROPOSED RETAINING WALL   |
|  | HANDICAP PARKING  |
|  | PROPOSED SIGN & POST  |
|  | INDICATES PROPOSED STANDARD CURB INLET  |
|  | BOLLARD   |
|  | DIRECTIONAL SIGN SEE ARCHITECT'S PLANS  |

**DRAINAGE PLAN LEGEND**

|  |   |
|--|---|
|  | DRAINAGE AREA DESIGNATION DRAINAGE AREA (ACRES) |
|  | WATERSHED LIMITS                                |
|  | MAJOR DRAINAGE AREA DIVIDE                      |
|  | MAJOR DRAINAGE AREA SUB-DIVIDE                  |
|  | ZONING BOUNDARY                                 |
|  | FLOW DIRECTION ARROW                            |
|  | L2 LINE IDENTIFIED IN LINE TABLE                |
|  | C2 CURVE IDENTIFIED IN CURVE TABLE              |
|  | INDICATES PROPOSED STANDARD CURB INLET          |
|  | INDICATES PROPOSED DROP INLET                   |
|  | INDICATES PROPOSED JUNCTION BOX                 |
|  | 27' RCP PROPOSED STORM DRAIN                    |
|  | 27' RCP FUTURE STORM DRAIN                      |
|  | PROPOSED SWALE                                  |


**EROSION CONTROL LEGEND**

|  |   |
|--|---|
|  | LIMITS OF OPERATOR DAY TO DAY OPERATIONAL CONTROL |
|  | PROPOSED SWALE                                    |
|  | INDICATES STABILIZED CONSTRUCTION ENTRANCE        |
|  | INDICATES REINFORCED SILT FENCE                   |
|  | INDICATES ROCK BERM                               |
|  | INDICATES DROP INLET PROTECTION                   |
|  | INDICATES PROPOSED INLET TREATMENT                |
|  | CURLEX EROSION CONTROL BLANKET                    |
|  | INDICATES SEDIMENT TRAP OUTLET CONTROL DEVICE     |
|  | 640 EXISTING CONTOUR LINE                         |
|  | 640 PROPOSED CONTOUR LINE                         |

**WATER & SANITARY SEWER PLAN LEGEND**

|  |  |
|--|--|
|  | 24' W PROPOSED 16' OR LARGER WATER MAIN      |
|  | 8' W PROPOSED 12' OR SMALLER WATER MAIN      |
|  | 24' W FUTURE 16' OR LARGER WATER MAIN        |
|  | 8' W FUTURE 12' OR SMALLER WATER MAIN        |
|  | PROPOSED GATE VALVE                          |
|  | PROPOSED REDUCER                             |
|  | PROPOSED WATER METER                         |
|  | PROPOSED FIRE HYDRANT                        |
|  | PROPOSED AIR RELEASE VALVE OR BLOW-OFF VALVE |
|  | 24' SS PROPOSED 16' OR LARGER SANITARY SEWER |
|  | 8' SS PROPOSED 12' OR SMALLER SANITARY SEWER |
|  | 24' SS FUTURE 16' OR LARGER SANITARY SEWER   |
|  | 8' SS FUTURE 12' OR SMALLER SANITARY SEWER   |
|  | PROPOSED SANITARY SEWER MANHOLE              |
|  | PROPOSED SANITARY SEWER CLEANOUT             |


PREPARED BY:  
**WIER & ASSOCIATES, INC.**  
**ENGINEERS SURVEYORS LAND PLANNERS**  
 2201 E. LAMAR BLVD., SUITE 200E ARLINGTON, TEXAS 76006 METRO (817)467-7700  
 Texas Firm Registration No. F-2776 www.wierassociates.com

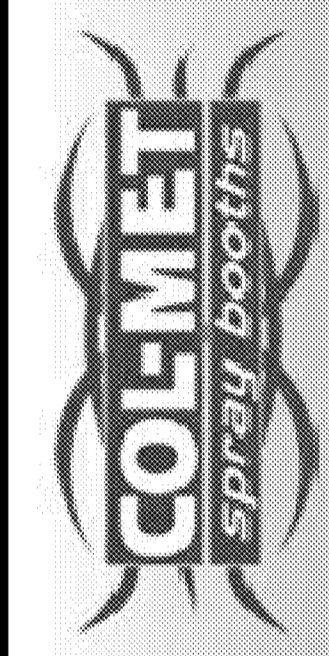

**LOT 3, BLOCK B**  
**ROCKWALL TECHNOLOGY PARK PHASE I**  
**COL-MET SPRAY BOOTHS**  
**TOPOGRAPHIC LEGEND**



**RECORD PLANS**  
**October 30, 2015**

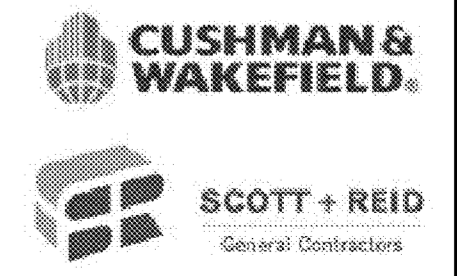

COPYRIGHT ©  
 WIER & ASSOCIATES, INC.  
 LAST SHEET EDIT  
 DATE 10/30/2015  
 WA# 14029  
**SHEET NO.**  
**C-S001**

PAVEMENT & JOINT SEALING NOTES

- ALL CONCRETE FOR PAVEMENT SHALL BE CLASS "C" AND HAVE A MINIMUM 3,600 PSI COMPRESSIVE STRENGTH (MINIMUM 6.5 SACK MIX) AT 28 DAYS WITH 4 TO 6 PERCENT AIR ENTRAINMENT UNLESS OTHERWISE NOTED. PAVEMENT MATERIALS AND CONSTRUCTION SHALL CONFORM TO THE APPLICABLE SECTIONS OF THE 3RD EDITION OF THE "STANDARD SPECIFICATIONS FOR PUBLIC WORKS CONSTRUCTION" PREPARED BY THE NORTH CENTRAL TEXAS COUNCIL OF GOVERNMENTS AND THE CITY OF ROCKWALL STANDARDS. SLIP FORMED CONCRETE SHALL HAVE A MAXIMUM SLUMP OF THREE INCHES. HAND-PLACED CONCRETE SHALL HAVE A MAXIMUM FIVE-INCH SLUMP. ALL REINFORCEMENT SHALL BE CHAIRED.
- THE JOINTING SHALL CONFORM TO THE LOCATIONS AND DETAILS SHOWN ON THESE PLANS. SPECIFIC SAWED CONTRACTION OR CONSTRUCTION JOINT LOCATIONS ARE NOT SHOWN. THE CONTRACTOR SHALL SUBMIT A LAYOUT INDICATING THE SAWED JOINT LOCATIONS TO BE REVIEWED AND APPROVED BY THE ENGINEER. ISOLATION JOINTS SHALL BE PROVIDED AT ALL MANHOLE RIMS, LIGHT STANDARDS AND OTHER SIMILAR INSTALLATIONS. EXPANSION JOINT LOCATIONS HAVE BEEN INDICATED ON PAVING AND DIMENSIONAL CONTROL PLANS.
- PROVIDE SAWED JOINTS AT MAXIMUM 20-FOOT SPACING FOR EIGHT-INCH CONCRETE. MAXIMUM 15 FEET FOR SIX-INCH CONCRETE AND MAXIMUM 12-FOOT SPACING FOR FIVE-INCH CONCRETE. DO NOT PLACE SAWED JOINT LONGITUDINALLY ALONG LOW POINT OR AT GUTTER LINE. SAWING OF JOINTS SHALL BEGIN AS SOON AS CONCRETE HAS HARDENED SUFFICIENTLY TO PERMIT SAWING WITHOUT EXCESSIVE RAVELING. COMPLETE ALL SAWED JOINTS BEFORE UNCONTROLLED SHRINKAGE CRACKING OCCURS.
- DO NOT PLACE SAND OR SELECT FILL BENEATH CONCRETE PAVEMENT, SIDEWALKS, DRIVE APPROACHES OR HANDICAP RAMPS FOR LEVEL UP COURSE. UTILIZE COMPACTED NATIVE MATERIALS.
- BACKFILL ALL CURBS TO EDGE OF SUBGRADE WITH ON-SITE CLAY SOILS. COMPACT TO 95% TO 100% OF STANDARD PROCTOR DENSITY AT OR ABOVE OPTIMUM MOISTURE CONTENT.
- CONTRACTOR SHALL SAW-CUT TIE-INS AT EXISTING CURBS AS NECESSARY TO INSURE SMOOTH TRANSITIONS. CONTRACTOR SHALL SAW-CUT AND TRANSITION TO MEET EXISTING PAVEMENT AS NECESSARY TO INSURE POSITIVE DRAINAGE. (TYP. ALL INTERSECTIONS)
- ALL EXPANSION, CONTRACTION AND CONSTRUCTION JOINTS IN PAVED AREAS SHALL BE SEALED IN ACCORDANCE WITH THESE SPECIFICATIONS AND THE JOINT SEALING MANUFACTURERS RECOMMENDATIONS.
- CLEAN ALL JOINTS PRIOR TO PLACEMENT OF JOINT SEALING MATERIAL IN ACCORDANCE WITH MANUFACTURERS RECOMMENDATIONS.
- PROVIDE BACKER RODS FOR JOINTS WITHOUT PRE-MOLDED JOINT MATERIAL IN ACCORDANCE WITH MANUFACTURERS RECOMMENDATIONS. INSTALL CERA-ROD MANUFACTURED BY W.R. MEADOWS OR EQUAL.
- EXPANSION AND ISOLATION JOINT MATERIAL TO BE PRE-MOLDED EXPANSION JOINT MATERIAL AS RECOMMENDED BY JOINT SEALING MANUFACTURER WITH JOINT CAP TO PROTECT SEALANT RESERVOIR.
- TYPICALLY, JOINT SEALING MATERIAL IS PLACED BELOW SURFACE OF CONCRETE TO NEAR FULL LEVEL. CERTAIN PRODUCTS SUCH AS SOFT SEAL ARE RECOMMENDED TO BE PLACED TO FULL LEVEL. REFER TO MANUFACTURERS RECOMMENDATIONS.
- THE CONTRACTOR SHALL CONSTRUCT ALL DRIVEWAY APPROACHES IN CONFORMANCE WITH APPLICABLE CITY STANDARD ORDINANCES AND REQUIREMENTS. CONTRACTOR SHALL CONFIRM APPLICABLE DRIVEWAY OR ACCESS PERMITS HAVE BEEN OBTAINED PRIOR TO CONSTRUCTION.
- ALL DIMENSIONS ARE TO BACK OF CURB, UNLESS NOTED OTHERWISE.
- ALL COORDINATES ARE TO BACK OF CURB, UNLESS NOTED OTHERWISE.
- SEE ARCHITECTURAL PLANS FOR BUILDING DIMENSIONS.
- ALL EDGE OF PAVEMENT WITH NO CURB SHALL BE THICKENED EDGE.

WALKWAY, MARKING, AND SIGNAGE NOTES

- ALL PEDESTRIAN WALKWAYS UTILIZED FOR DISABLED ACCESS ROUTE SHALL CONFORM TO LOCAL, STATE, AND FEDERAL REGULATIONS INCLUDING THE "STATE OF TEXAS PROGRAM FOR THE ELIMINATION OF ARCHITECTURAL BARRIERS", "TEXAS ACCESSIBILITY STANDARDS" (TAS) AND THE "AMERICANS WITH DISABILITIES ACT OF 1990" (ADA).
- THE CONTRACTOR SHALL OBTAIN ALL REQUIRED CITY PERMITS AND NOTIFY THE CITY PRIOR TO CONSTRUCTING PUBLIC SIDEWALKS.
- UNLESS REQUIRED OTHERWISE BY CITY REGULATIONS, ALL WALKWAYS SHALL BE CONSTRUCTED OF MINIMUM 3,000 PSI CONCRETE AND A MINIMUM CEMENT CONTENT OF 5.5 SACKS PER CUBIC YARD. ALL SIDEWALKS SHALL BE REINFORCED WITH A MINIMUM OF #3 BARS AT 18-INCH CENTERS EACH WAY LOCATED AT THE CENTER OF THE THICKNESS. THE STEEL SHALL BE PLACED ON CHAIR SUPPORTS BEFORE CONCRETE PLACEMENT. IF NECESSARY, DURING CONCRETE PLACEMENT, THE STEEL SHALL BE PULLED UP TO INSURE THE PROPER LOCATION OF REINFORCEMENT.
- WALKWAYS SHALL BE CONSTRUCTED TO THE LINE AND GRADE INDICATED ON THE PLANS OR THE TYPICAL LOCATIONS SHOWN ON THE PAVING PLANS IN RELATION TO PROPOSED CURB. SEE PAVEMENT NOTE #1 ABOVE.
- PUBLIC AND PRIVATE SIDEWALKS SHALL BE CONSTRUCTED ON NATIVE MATERIALS. DO NOT PLACE SAND UNDER PUBLIC OR PRIVATE SIDEWALKS OR HANDICAP RAMPS FOR LEVEL UP COURSE. PUBLIC SIDEWALKS SHALL BE CONSTRUCTED ACCORDING TO CITY DETAILS.
- FORMS SET FOR SIDEWALKS SHALL BE TRUE TO LINE AND GRADE AND SHALL PROVIDE A SLOPE OF 1/4 INCH PER FOOT ACROSS THE SIDEWALK UNLESS INDICATED OTHERWISE ON THE PLANS. FORMS SHALL BE SET TO PROVIDE FOR A FULL DEPTH OF CONCRETE INDICATED ON THE PLANS AND FORMS SHALL REMAIN IN PLACE A MINIMUM OF 24 HOURS. UPON REMOVAL OF THE FORM WORK, THE CONTRACTOR SHALL IMMEDIATELY BACKFILL THE EDGES OF THE WALK FOR A MINIMUM OF ONE FOOT (1') EACH SIDE OF THE WALK.
- 24-INCH BY 3/4-INCH DIAMETER ASPHALT-COATED DOWELS WITH FIVE INCH BY 13/16-INCH DOWEL SLEEVE SHALL BE INSTALLED ON 16-INCH CENTERS, ALONG WITH REDWOOD EXPANSION BOARD AND SEALING COMPOUND AS PER STANDARD EXPANSION JOINT DETAIL SHEET ALONG PERIMETER OF WHEEL CHAIR RAMP AND SIDEWALK.
- PROVIDE 15-INCH MINIMUM LAP BETWEEN REINFORCING STEEL IN STREET AND REINFORCING STEEL IN WHEEL CHAIR RAMP.
- SUBGRADE FOR WALKWAYS ABUTTING CURBS, WITHIN PARKING ISLAND AREAS OR BETWEEN THE PARKING AREA AND BUILDING, SHALL BE PLACED ON COMPACTED FILL OR FIRM COMPACTED EXCAVATED GRADE. FILLS FOR SIDEWALKS SHALL CONFORM TO THE SAME REQUIREMENTS AS CONTROLLED DENSITY FILLS IN PARKING AREAS WITH THE COMPACTED MATERIAL EXTENDING A MINIMUM 18 INCHES BEYOND THE WALKWAY.
- JOINT SEALING MATERIAL UTILIZED IN WALKWAY AREAS BETWEEN THE PARKING AREA AND THE BUILDING FOR EXPANSION JOINTS SHALL CONSIST OF "POURTHANE" MANUFACTURED BY W.R. MEADOWS, INC. OR EQUAL. THIS INCLUDES WALKWAYS ABUTTING PERIMETER PARKING IN FRONT OF BUILDING.
- FOR WALKWAYS SIX FEET IN WIDTH OR LESS, GROOVED OR SAWED CONTRACTION JOINTS SHALL BE MADE AT UNIFORM INTERVALS EQUAL TO THE WIDTH OF THE SIDEWALK. ON WALKWAYS GREATER THAN SIX FEET IN WIDTH, CONTRACTION JOINTS SHALL BE SAWED. CONTRACTION JOINTS SHALL ONLY BE SEALED WHERE CONCENTRATED RUNOFF OCCURS IN PARKING AREAS, ENTRANCES AND WALKWAYS AT THE BUILDING. SEAL PARKING LOT CONCENTRATED RUNOFF AREAS SAME AS PARKING PAVEMENT. SEAL WALKWAYS WITHIN 50 FEET OF BUILDING WITH "DECK-O-SEAL" AS MANUFACTURED BY W.R. MEADOWS OR EQUAL.
- CONCRETE FINISH SHALL BE BROOMED FOR ALL WALKWAYS LESS THAN SIX FEET IN WIDTH AND MINOR ACCESS ROUTES GREATER THAN EIGHT FEET IN WIDTH. ALL HANDICAP ACCESS RAMPS SHALL HAVE SURFACE TEXTURE FINISH COMPLYING WITH ADA AND TAS GUIDELINES 302 AND 405.4.
- JOINT SEALING MATERIAL FOR WALKWAY AND EXPANSION JOINTS IN THE INTERNAL PARKING AREAS AND EXTERNAL OPEN AREAS SHALL BE "HI SPEC" MANUFACTURED BY W.R. MEADOWS

OR EQUAL.


- CLEAN ALL JOINTS IN ACCORDANCE WITH MANUFACTURERS RECOMMENDATION PRIOR TO SEALING.
- ALL SIGNS, PAVEMENT MARKINGS AND OTHER TRAFFIC CONTROL DEVICES SHALL CONFORM TO THE LATEST EDITION OF THE MANUAL ON UNIFORM TRAFFIC CONTROL DEVICES.
- ALL PAVEMENT MARKINGS SHALL BE FOUR INCHES WIDE. COLOR WHITE UNLESS INDICATED OTHERWISE ON THE DRAWINGS. STRIPING TO BE TWO COATS OF PAINT. SECOND COAT TO THE APPLIED IMMEDIATELY PRIOR TO OBTAINING A CERTIFICATE OF OCCUPANCY.
- A MINIMUM CLEARANCE OF TWO (2) FEET SHALL BE MAINTAINED BETWEEN THE FACE OF CURB AND ANY PART OF A TRAFFIC SIGN.
- CONTRACTOR SHALL FURNISH AND INSTALL ALL PAVEMENT MARKINGS AS SHOWN ON THE PLANS.
- CONTRACTOR SHALL COORDINATE INSTALLATION OF ALL SIGNS, PAVEMENT MARKINGS AND OTHER TRAFFIC CONTROL DEVICES WITH OTHER CONTRACTORS ON THE SITE.
- FIRE LANE STRIPING WIDTH AND RADIUS TO BE COORDINATED WITH FIRE MARSHAL WHERE FIRE LANE IS INDICATED ON PLANS. FIRE LANE IS ANTICIPATED TO REQUIRE SOLID SIX-INCH RED CONTINUOUS STRIPING ON BOTH SIDES AND CURB RETURNS. THE WORDS "FIRE LANE NO PARKING" SHALL BE PAINTED ON MINIMUM 20-FOOT CENTERS WITH FOUR-INCH WHITE LETTERS WITHIN SOLID RED STRIPE PER FIRE CODE. PAINT TYPE AND COLOR SHALL BE APPROVED BY CITY TRAFFIC ENGINEER.

TESTING


- REFER TO PROJECT GEOTECHNICAL RECOMMENDATIONS FOR FREQUENCY OF CONCRETE TESTING AND TEST METHODS. ALL CONCRETE SHALL BE TESTED. IF TESTING IS NOT ADDRESSED IN GEOTECHNICAL RECOMMENDATIONS PROVIDE AS PER NCTCOG ITEM 303.7.3 AND ITEM 702.2.4.

PRINTED: 10/28/2015 5TB FILE: WIER-PAVING.STB LAST SAVED: 10/28/2015 6:10 AM. SAVED BY: PHILIPG FILE: PAVING-NOTES-14029.DWG

PREPARED BY:  
**WIER & ASSOCIATES, INC.**  
**ENGINEERS SURVEYORS LAND PLANNERS**  
 2201 E. LAMAR BLVD., SUITE 200E ARLINGTON, TEXAS 76006 METRO (817)467-7700  
 www.wierassociates.com  
 Texas Firm Registration No. F-2776

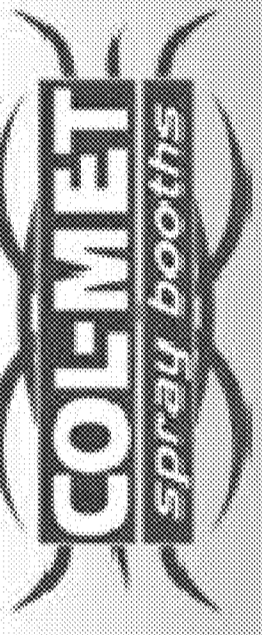

LOT 3, BLOCK B  
**ROCKWALL TECHNOLOGY PARK PHASE I**  
**COL-MET SPRAY BOOTHS**  
**PRIVATE GENERAL PAVING NOTES**

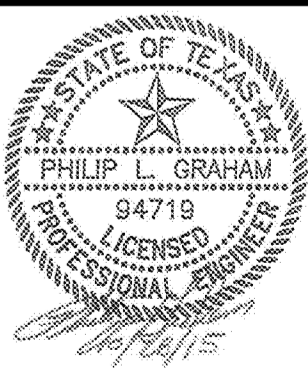


**RECORD PLANS**  
**October 28, 2015**

COPYRIGHT ©  
 WIER & ASSOCIATES, INC.  
 LAST SHEET OF 11  
 DATE 10/28/2015  
 WA# 14029  
**SHEET NO.**  
**C-P001**

PRINTED: 10/30/2015 10:30:20 AM FILE: WIER-PAVING-STB LAST SAVED: 10/30/2015 2:43 PM BY: PHILIP FILE: PAVING-PLAN-14029.DWG

SEE SHEET C-P102

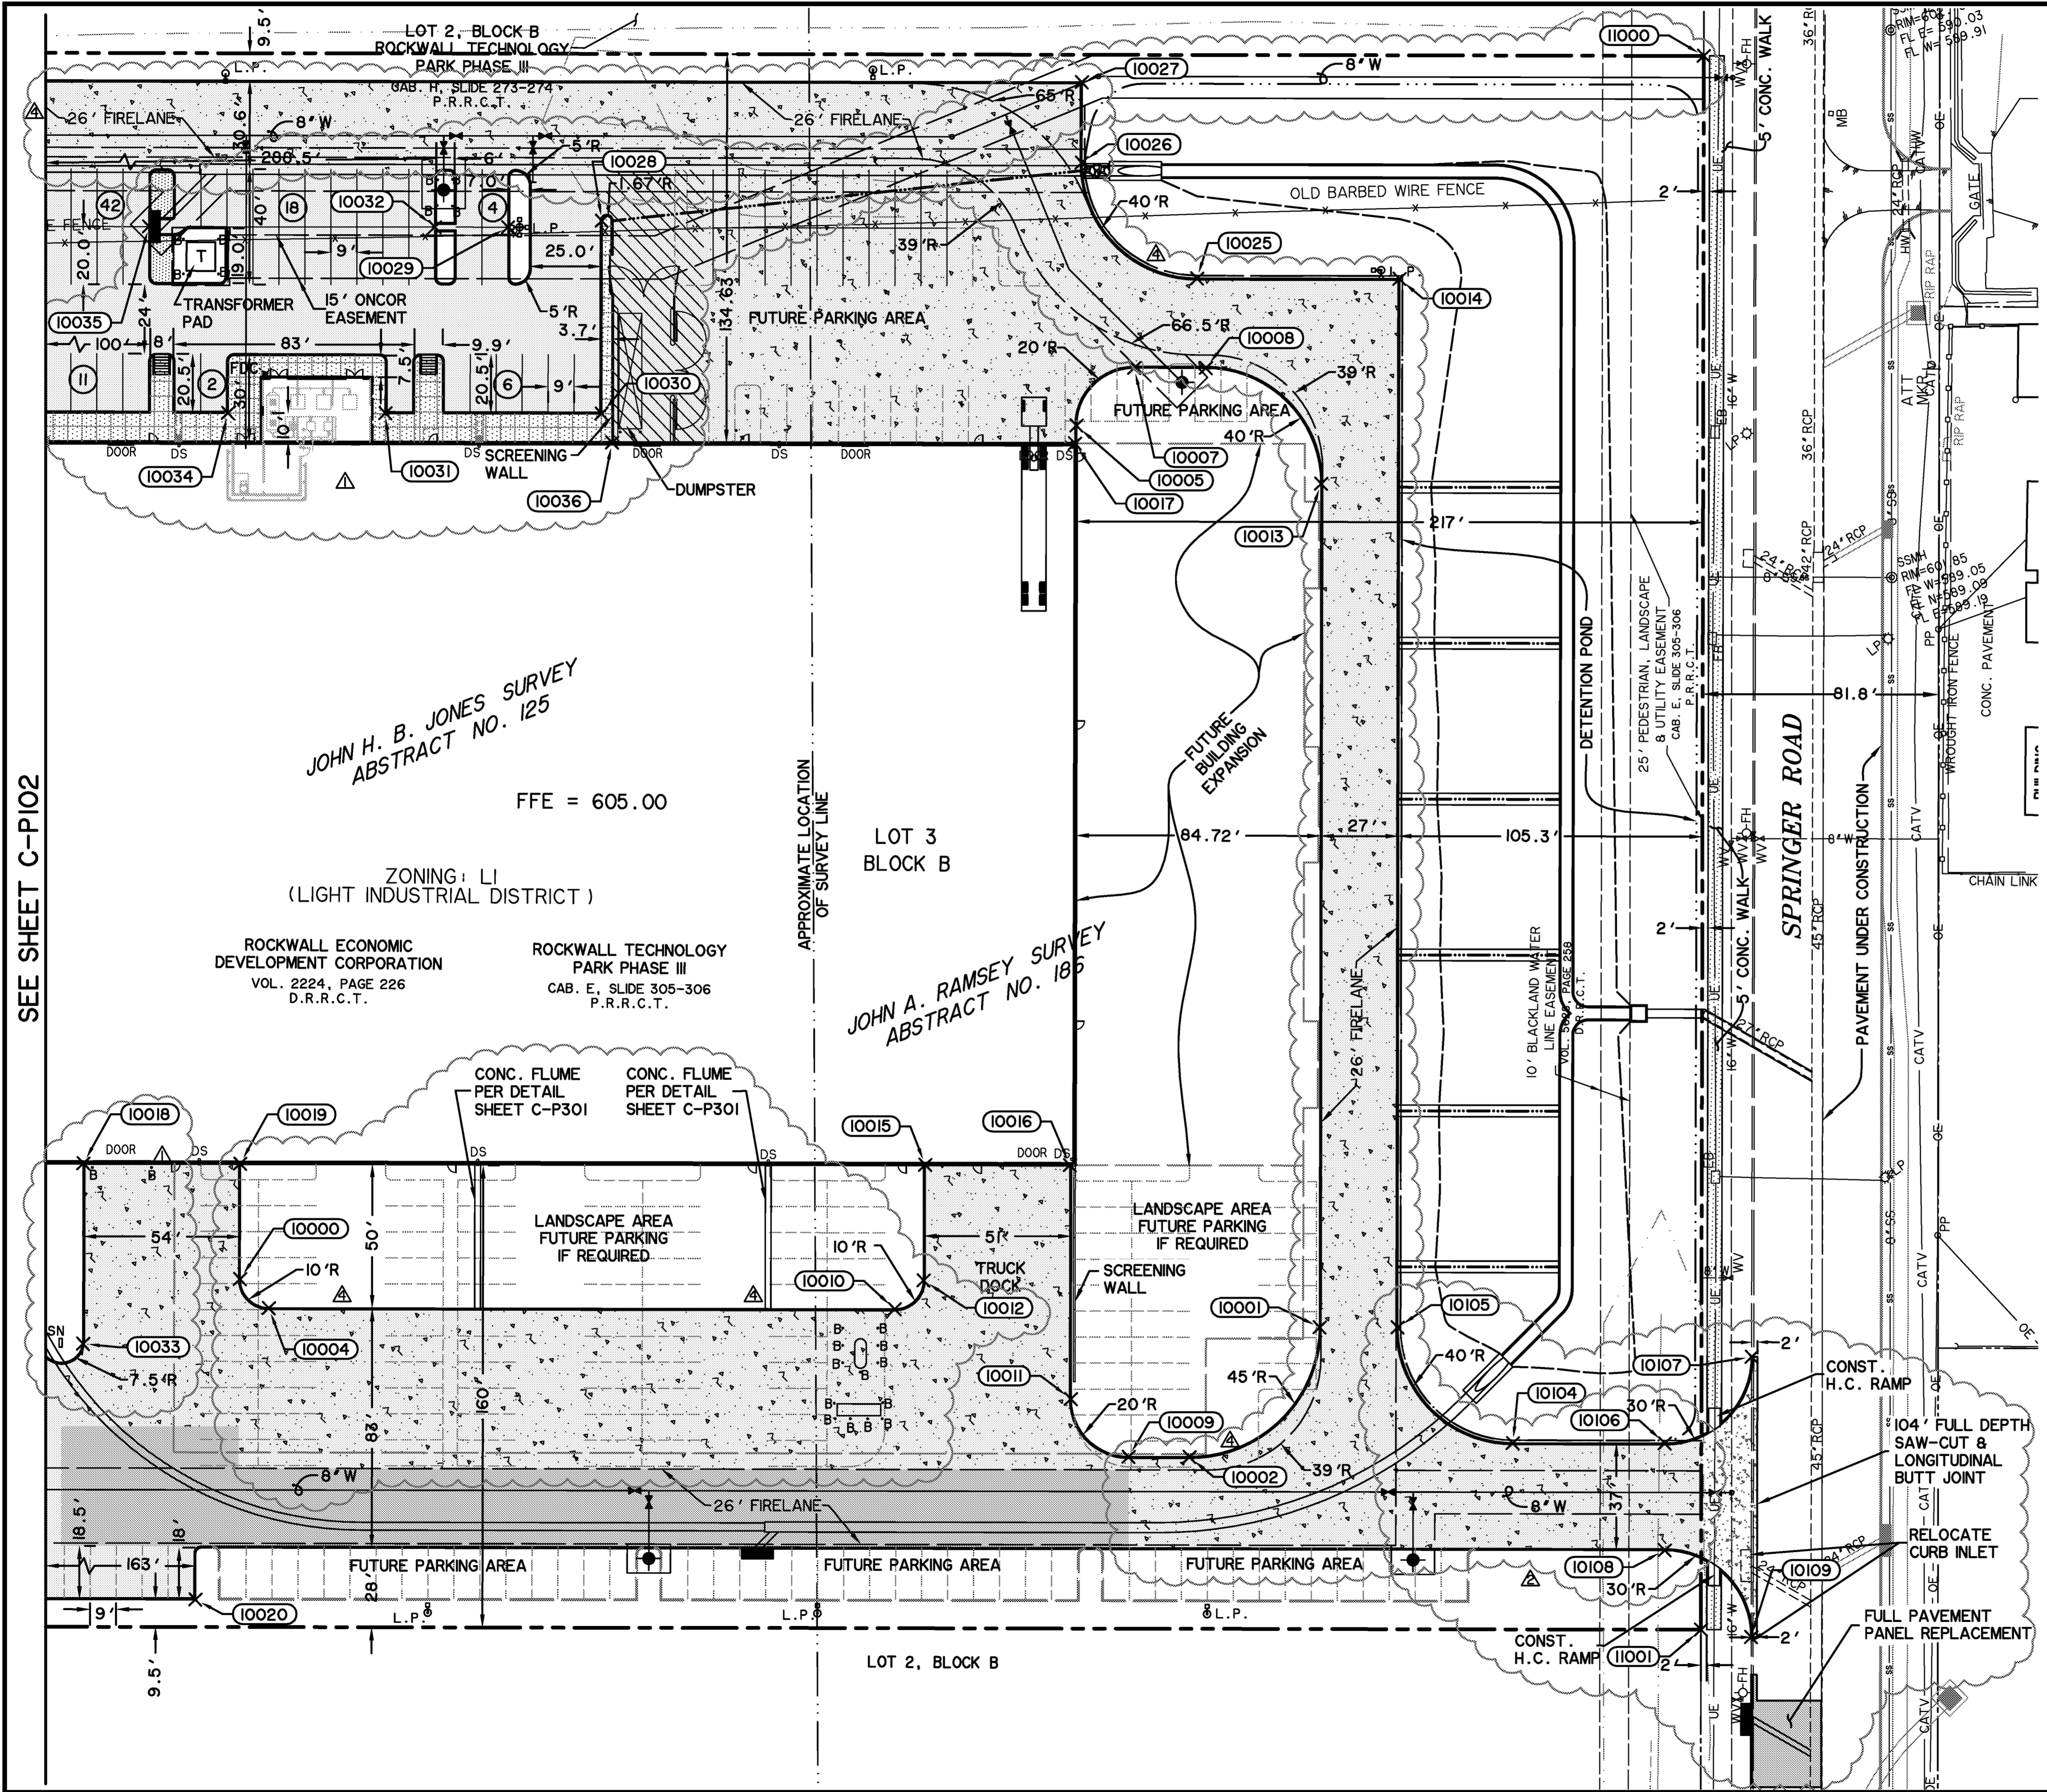

JOHN H. B. JONES SURVEY  
ABSTRACT NO. 125

ZONING: LI  
(LIGHT INDUSTRIAL DISTRICT)

ROCKWALL ECONOMIC  
DEVELOPMENT CORPORATION  
VOL. 2224, PAGE 226  
D.R.R.C.T.

FFE = 605.00

ROCKWALL TECHNOLOGY  
PARK PHASE III  
CAB. E. SLIDE 305-306  
P.R.R.C.T.

JOHN A. RAMSEY SURVEY  
ABSTRACT NO. 185

LOT 3  
BLOCK B

LOT 2, BLOCK B

**CAUTION !!!**  
EXISTING UTILITIES ARE INDICATED ON THE PLANS FROM AVAILABLE INFORMATION. IT SHALL BE THE RESPONSIBILITY OF THE CONTRACTOR TO VERIFY THE LOCATION OF ALL UTILITIES, TO NOTIFY ALL UTILITY COMPANIES OF THE CONTRACTORS OPERATIONS, TO PROTECT ALL UTILITIES FROM DAMAGE, TO REPAIR ALL UTILITIES DAMAGED DUE TO THE CONTRACTORS OPERATIONS, AND TO NOTIFY THE ENGINEER PROMPTLY OF ALL CONFLICTS OF THE WORK WITH EXISTING UTILITIES.

- GENERAL NOTES:**
1. ALL DIMENSIONS ARE TO BACK OF CURB UNLESS NOTED OTHERWISE.
  2. SEE ARCHITECTURAL PLANS FOR BUILDING DIMENSIONS.
  3. REFER TO ELECTRICAL SITE LAYOUT FOR PARKING LOT LIGHTING CONDUIT LOCATIONS AND LANDSCAPE IRRIGATION PLANS FOR IRRIGATION SLEEVE LOCATIONS.
  4. ALL CURB RETURNS ARE 2' RADII UNLESS OTHERWISE SPECIFIED.
  5. SPEED BUMPS ARE NOT PERMITTED WITHIN A FIRELANE.
  6. TWO POINTS OF ACCESS SHALL BE MAINTAINED FOR THE PROPERTY AT ALL TIMES.
  7. SEE SHEET C-S001 FOR PAVING LEGEND.

| PAVING CONTROL POINTS |              |              |
|-----------------------|--------------|--------------|
| POINT                 | NORTHING     | EASTING      |
| 10000                 | 7020351.5590 | 2608097.1085 |
| 10001                 | 7019977.2724 | 2608090.2159 |
| 10002                 | 7020021.1638 | 2608044.1340 |
| 10004                 | 7020341.3186 | 2608087.3548 |
| 10005                 | 7020069.6658 | 2608400.2597 |
| 10007                 | 7020050.1585 | 2608420.7406 |
| 10008                 | 7020025.3462 | 2608421.3447 |
| 10009                 | 7020042.2426 | 2608043.6208 |
| 10010                 | 7020124.5872 | 2608092.6316 |
| 10011                 | 7020062.7235 | 2608063.1281 |
| 10012                 | 7020114.8336 | 2608102.8720 |
| 10013                 | 7019984.3844 | 2608382.3301 |
| 10014                 | 7019959.1206 | 2608453.9663 |
| 10015                 | 7020115.3073 | 2608142.8723 |
| 10016                 | 7020065.1948 | 2608144.0924 |
| 10017                 | 7020070.0147 | 2608394.0491 |
| 10018                 | 7020406.8494 | 2608135.7741 |
| 10019                 | 7020352.5326 | 2608137.0966 |
| 10020                 | 7020364.0712 | 2607985.7708 |
| 10025                 | 7020029.2357 | 2608452.2592 |
| 10026                 | 7020070.1975 | 2608491.2738 |
| 10027                 | 7020070.8773 | 2608519.1958 |
| 10028                 | 7020235.8535 | 2608466.8617 |
| 10029                 | 7020268.2872 | 2608463.7439 |
| 10030                 | 7020234.2270 | 2608400.0540 |
| 10031                 | 7020309.0552 | 2608398.2322 |
| 10032                 | 7020293.6301 | 2608463.1269 |
| 10033                 | 7020405.3285 | 2608073.3053 |
| 10034                 | 7020363.5391 | 2608396.9057 |
| 10035                 | 7020392.6008 | 2608460.7172 |
| 10036                 | 7020230.3003 | 2608390.1467 |
| 10104                 | 7019909.3187 | 2608051.8585 |
| 10105                 | 7019950.2804 | 2608090.8731 |
| 10106                 | 7019856.6625 | 2608053.1405 |
| 10107                 | 7019827.4021 | 2608083.8846 |
| 10108                 | 7019855.7474 | 2608016.1518 |
| 10109                 | 7019825.0257 | 2607986.8758 |
| 11000                 | 7019855.7517 | 2608533.9361 |
| 11001                 | 7019842.4841 | 2607988.9666 |


| REVISIONS  | DATE     | BY  |
|--|----------|-----|
| RETAINING WALL, PAVEMENT, WATER LINE, & ONCOR EASEMENT     | 01/27/15 | TTW |
| ADDED DRIVE CONNECTION                                     | 03/19/15 | PLG |
| ADDED ADDITIONAL TRUCK PARKING & ADDED ADDITIONAL 7' PVMT. | 04/13/15 | TTW |

\* ALL RESPONSIBILITY FOR ADEQUACY OF DESIGN REMAINS WITH THE DESIGN ENGINEER. THE CITY OF ROCKWALL, IN REVIEWING AND RELEASING THE PLANS FOR CONSTRUCTION, ASSUMES NO RESPONSIBILITY FOR ADEQUACY OR ACCURACY OF DESIGN.

**RECORD PLANS**  
October 30, 2015



PREPARED BY:  
**WIER & ASSOCIATES, INC.**  
ENGINEERS SURVEYORS LAND PLANNERS  
2201 E. LAMAR BLVD., SUITE 200E ARLINGTON, TEXAS 76010 METRO (817)467-7700  
www.wierassociates.com

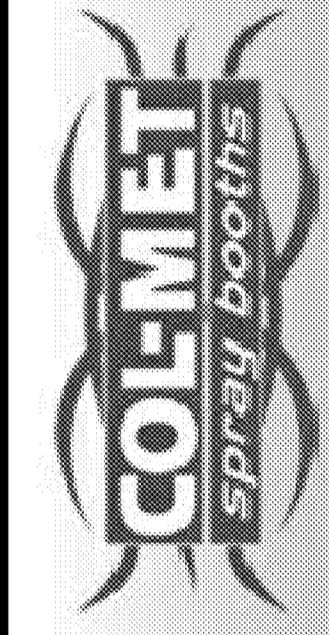


**LOT 3, BLOCK B**  
**ROCKWALL TECHNOLOGY PARK PHASE II**  
**COL-MET SPRAY BOOTHS**  
**PAVING PLAN**  
SOUTH



COPYRIGHT ©  
WIER & ASSOCIATES, INC.  
LAST SHEET EDIT  
DATE 10/30/2015  
WA# 14029  
**SHEET NO.**  
C-P101

PRINTED: 10/30/2015 2:49 PM LAST SAVED: 10/30/2015 2:49 PM FILE: PAVING-PLAN-2-14029.DWG

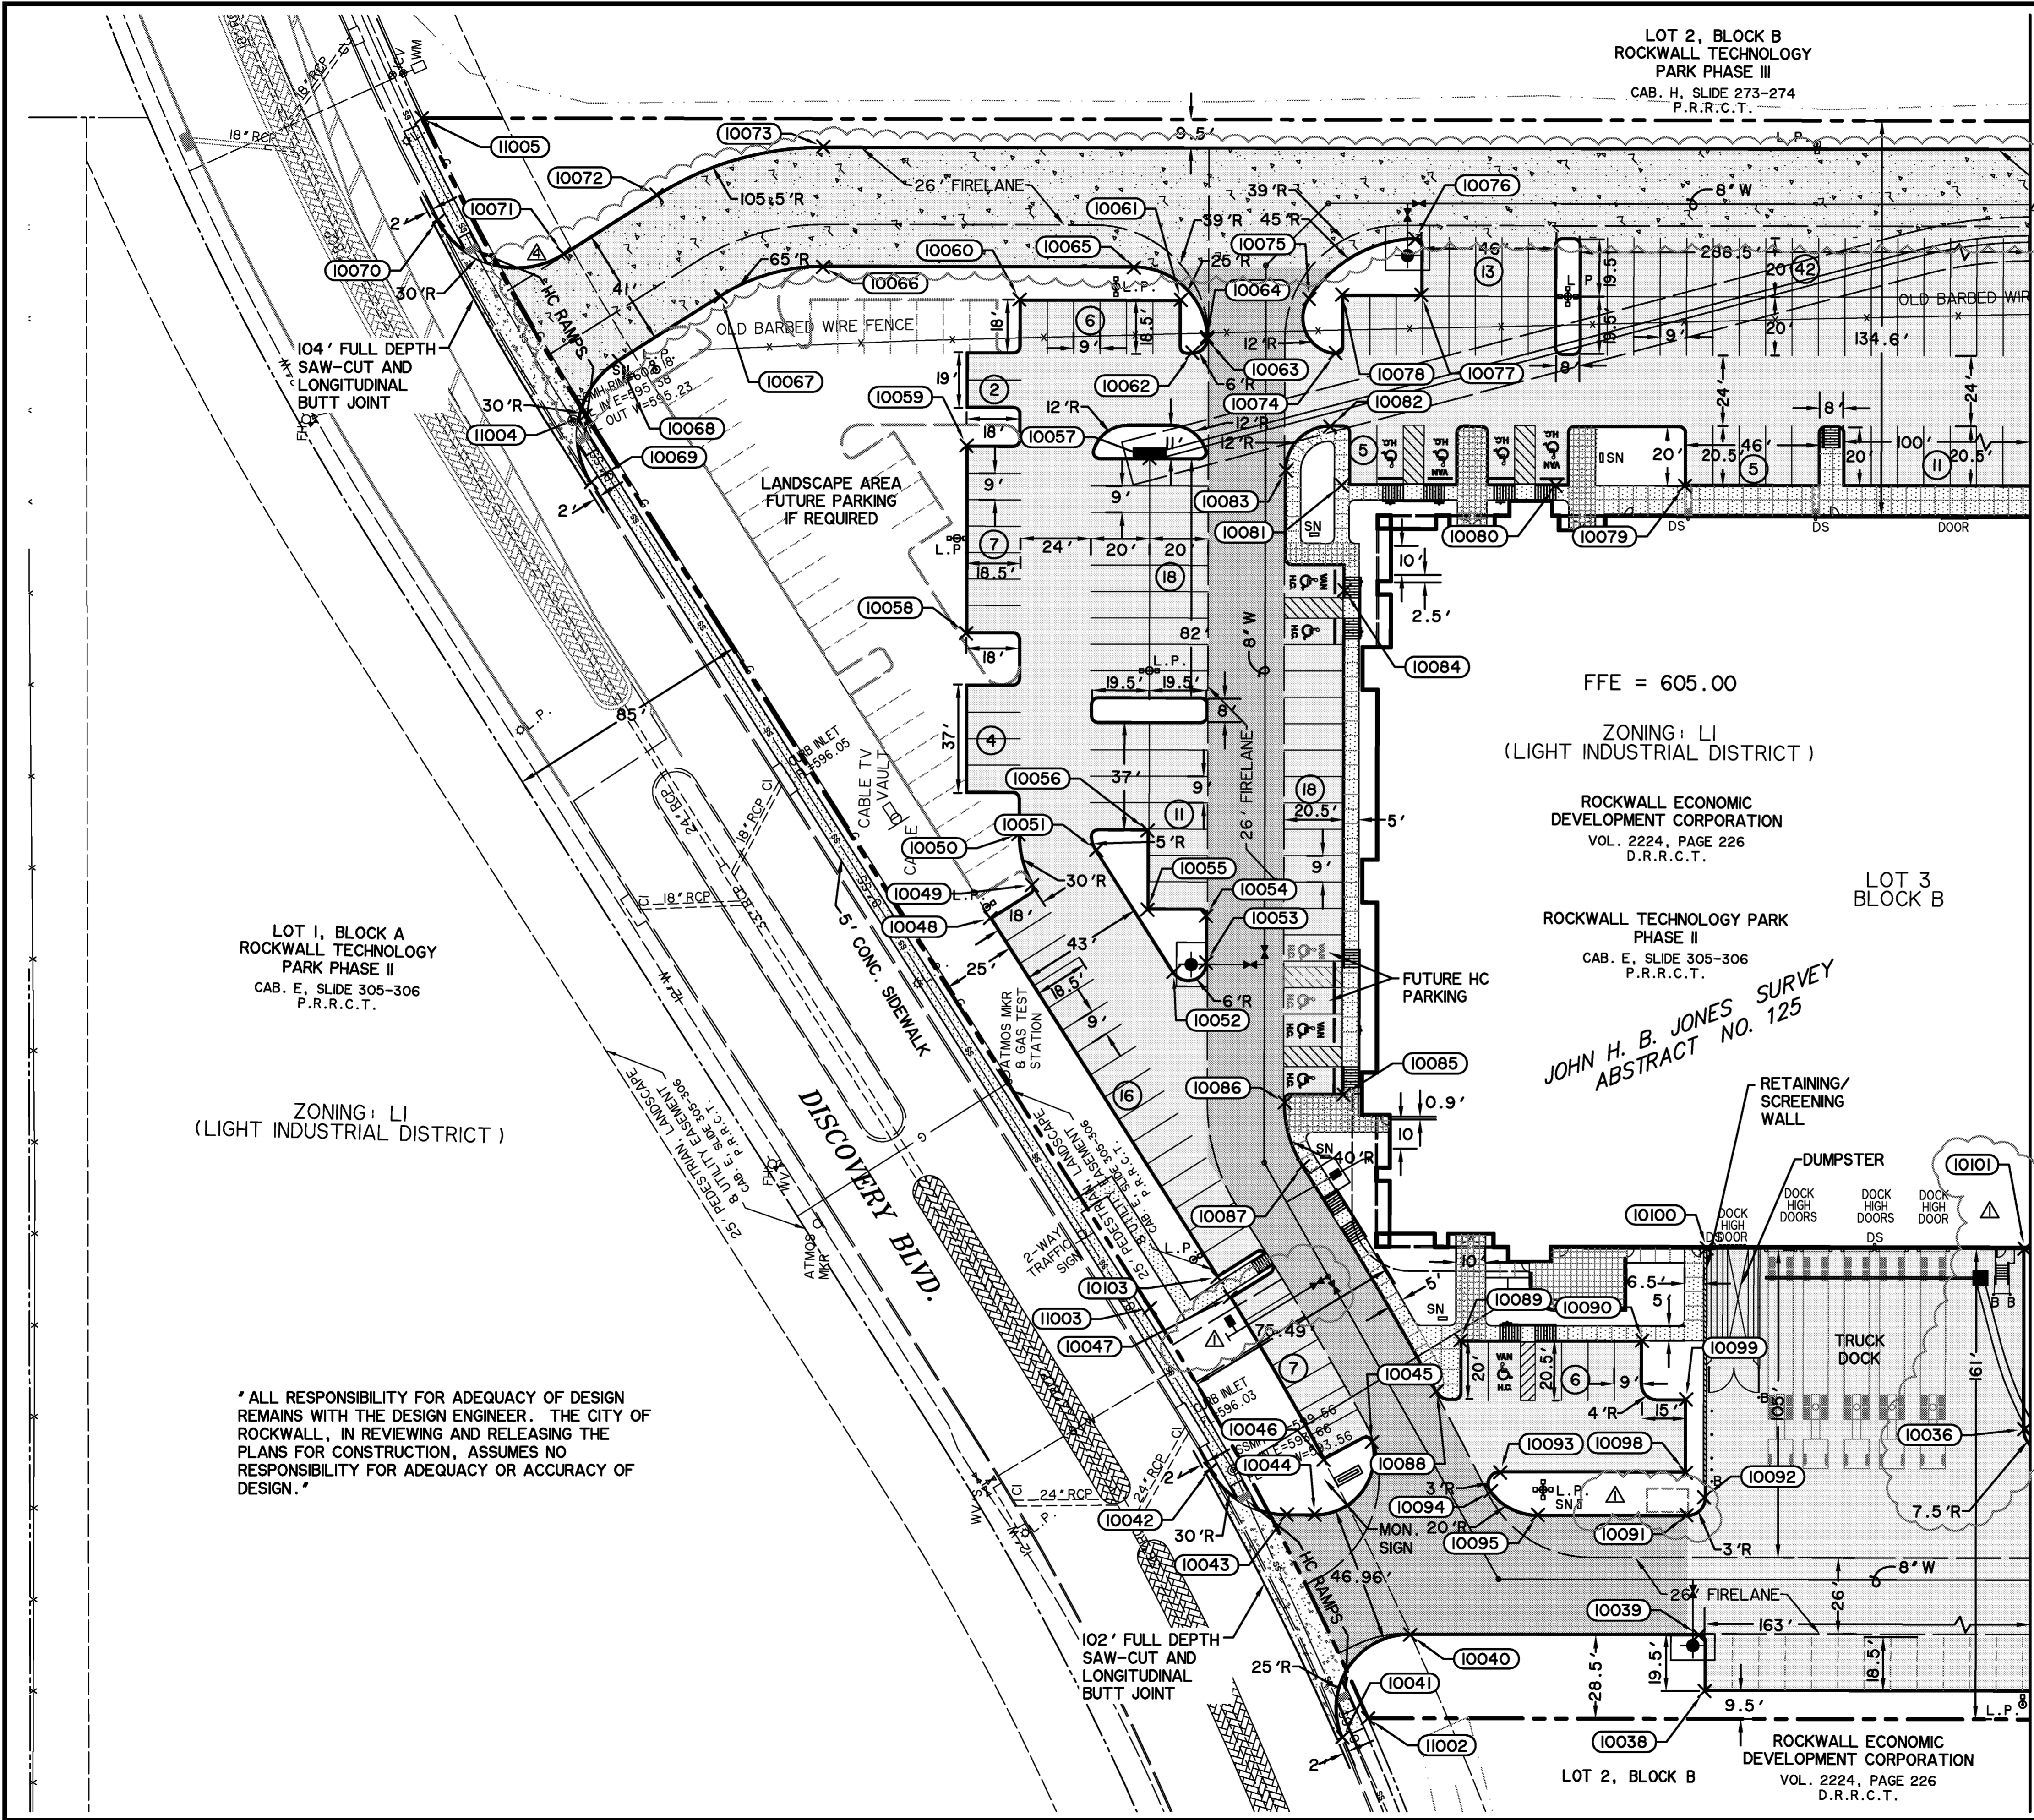

LOT 1, BLOCK A  
 ROCKWALL TECHNOLOGY  
 PARK PHASE II  
 CAB. E. SLIDE 305-306  
 P.R.R.C.T.  
 ZONING: LI  
 (LIGHT INDUSTRIAL DISTRICT)

\* ALL RESPONSIBILITY FOR ADEQUACY OF DESIGN  
 REMAINS WITH THE DESIGN ENGINEER. THE CITY OF  
 ROCKWALL, IN REVIEWING AND RELEASING THE  
 PLANS FOR CONSTRUCTION, ASSUMES NO  
 RESPONSIBILITY FOR ADEQUACY OR ACCURACY OF  
 DESIGN.

LOT 2, BLOCK B  
 ROCKWALL TECHNOLOGY  
 PARK PHASE III  
 CAB. H. SLIDE 273-274  
 P.R.R.C.T.

FFE = 605.00  
 ZONING: LI  
 (LIGHT INDUSTRIAL DISTRICT)

ROCKWALL ECONOMIC  
 DEVELOPMENT CORPORATION  
 VOL. 2224, PAGE 226  
 D.R.R.C.T.

ROCKWALL TECHNOLOGY PARK  
 PHASE II  
 CAB. E. SLIDE 305-306  
 P.R.R.C.T.  
 JOHN H. B. JONES SURVEY  
 ABSTRACT NO. 125

LOT 3  
 BLOCK B

TRUCK DOCK

DUMPSTER

MON. 20' SIGN

RETAINING/SCREENING WALL

DISCOVERY BLVD.

ATMOSPHERIC GAS TEST STATION

LANDSCAPE AREA FUTURE PARKING IF REQUIRED

104' FULL DEPTH SAW-CUT AND LONGITUDINAL BUTT JOINT

102' FULL DEPTH SAW-CUT AND LONGITUDINAL BUTT JOINT

**CAUTION !!!**  
 EXISTING UTILITIES ARE INDICATED ON THE PLANS FROM AVAILABLE INFORMATION. IT SHALL BE THE RESPONSIBILITY OF THE CONTRACTOR TO VERIFY THE LOCATION OF ALL UTILITIES, TO NOTIFY ALL UTILITY COMPANIES OF THE CONTRACTORS OPERATIONS, TO PROTECT ALL UTILITIES FROM DAMAGE, TO REPAIR ALL UTILITIES DAMAGED DUE TO THE CONTRACTORS OPERATIONS, AND TO NOTIFY THE ENGINEER PROMPTLY OF ALL CONFLICTS OF THE WORK WITH EXISTING UTILITIES.

- GENERAL NOTES:**
1. ALL DIMENSIONS ARE TO BACK OF CURB UNLESS NOTED OTHERWISE.
  2. SEE ARCHITECTURAL PLANS FOR BUILDING DIMENSIONS.
  3. REFER TO ELECTRICAL SITE LAYOUT FOR PARKING LOT LIGHTING CONDUIT LOCATIONS AND LANDSCAPE IRRIGATION PLANS FOR IRRIGATION SLEEVE LOCATIONS.
  4. ALL CURB RETURNS ARE 2' RADII UNLESS OTHERWISE SPECIFIED.
  5. SPEED BUMPS ARE NOT PERMITTED WITHIN A FIRELANE.
  6. TWO POINTS OF ACCESS SHALL BE MAINTAINED FOR THE PROPERTY AT ALL TIMES.
  7. SEE SHEET C-5001 FOR PAVING LEGEND.

PAVING CONTROL POINTS

| POINT | NORTHING     | EASTING      | POINT | NORTHING     | EASTING      |
|-------|--------------|--------------|-------|--------------|--------------|
| 10036 | 7020420.3468 | 2608073.8754 | 10071 | 7020928.9398 | 2608461.6191 |
| 10038 | 7020527.0230 | 2607981.8035 | 10072 | 7020897.7390 | 2608482.5272 |
| 10039 | 7020529.4848 | 2608000.7492 | 10073 | 7020841.3107 | 2608500.4388 |
| 10040 | 7020627.9017 | 2607998.3531 | 10074 | 7020664.7057 | 2608434.6247 |
| 10041 | 7020649.9568 | 2607962.8077 | 10075 | 7020674.2605 | 2608452.8957 |
| 10042 | 7020697.5217 | 2608053.0218 | 10076 | 7020638.5711 | 2608474.2332 |
| 10043 | 7020670.9779 | 2608038.3165 | 10077 | 7020636.0409 | 2608455.2904 |
| 10044 | 7020661.4685 | 2608038.5481 | 10078 | 7020663.0329 | 2608454.6332 |
| 10045 | 7020642.6349 | 2608063.7116 | 10079 | 7020544.4854 | 2608392.5002 |
| 10046 | 7020658.9237 | 2608057.2772 | 10080 | 7020588.4724 | 2608391.4293 |
| 10047 | 7020692.3338 | 2608111.8186 | 10081 | 7020661.4508 | 2608389.6525 |
| 10048 | 7020777.4541 | 2608238.9546 | 10082 | 7020665.9644 | 2608409.5485 |
| 10049 | 7020763.5280 | 2608250.5792 | 10083 | 7020680.5948 | 2608394.1878 |
| 10050 | 7020768.5446 | 2608267.7998 | 10084 | 7020659.6106 | 2608353.8179 |
| 10051 | 7020741.8623 | 2608263.0849 | 10085 | 7020655.4196 | 2608181.8688 |
| 10052 | 7020714.4836 | 2608222.2281 | 10086 | 7020675.3465 | 2608178.6243 |
| 10053 | 7020703.5010 | 2608225.7143 | 10087 | 7020668.5874 | 2608157.3307 |
| 10054 | 7020703.8904 | 2608241.7068 | 10088 | 7020621.0140 | 2608081.6284 |
| 10055 | 7020723.9331 | 2608243.2194 | 10089 | 7020613.3670 | 2608099.2054 |
| 10056 | 7020724.5903 | 2608270.2114 | 10090 | 7020551.3854 | 2608100.7144 |
| 10057 | 7020727.1816 | 2608397.1859 | 10091 | 7020534.7205 | 2608041.6339 |
| 10058 | 7020788.2064 | 2608335.8363 | 10092 | 7020528.8684 | 2608047.7781 |
| 10059 | 7020789.7642 | 2608399.8174 | 10093 | 7020598.6140 | 2608054.5512 |
| 10060 | 7020772.9828 | 2608450.0869 | 10094 | 7020601.6705 | 2608048.0921 |
| 10061 | 7020717.9990 | 2608451.4255 | 10095 | 7020585.4144 | 2608040.3997 |
| 10062 | 7020713.5871 | 2608433.5276 | 10098 | 7020535.2945 | 2608056.0929 |
| 10063 | 7020708.7232 | 2608438.1474 | 10099 | 7020535.9030 | 2608081.0855 |
| 10064 | 7020708.7226 | 2608438.8976 | 10100 | 7020530.2083 | 2608132.7708 |
| 10065 | 7020734.2620 | 2608462.0328 | 10101 | 7020421.8450 | 2608135.4090 |
| 10066 | 7020840.3128 | 2608459.4509 | 10103 | 7020696.7354 | 2608118.4993 |
| 10067 | 7020874.9151 | 2608448.4674 | 11002 | 7020641.5002 | 2607969.5137 |
| 10068 | 7020909.1098 | 2608425.5530 | 11003 | 7020719.4778 | 2608107.5284 |
| 10069 | 7020917.3651 | 2608383.9815 | 11004 | 7020920.0204 | 2608406.7951 |
| 10070 | 7020971.9037 | 2608472.0415 | 11005 | 7020978.4914 | 2608506.6018 |

SEE SHEET C-P101


RECORD PLANS  
 October 30, 2015

| REVISIONS  | DATE     | BY  |
|--|----------|-----|
| RETAINING WALL, PAVEMENT, WATER LINE, & CONOR EASEMENT | 01/27/15 | TVW |
| ADDED ADDITIONAL 7' PAVEMENT                           | 04/13/15 | TVW |



CUSHMAN & WAKEFIELD  
 SCOTT + REID  
 General Contractors

PREPARED BY:  
**WIER & ASSOCIATES, INC.**  
 ENGINEERS SURVEYORS & LAND PLANNERS  
 2201 E. LAMAR BLVD., SUITE 200E ARLINGTON, TEXAS 76010 METRO (817)467-7700  
 www.wierassociates.com

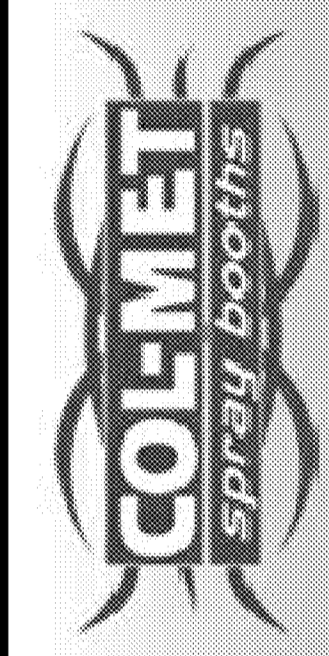












LOT 3, BLOCK B  
 ROCKWALL TECHNOLOGY PARK PHASE II  
 COL-MET SPRAY BOOTHS  
 PAVING PLAN  
 NORTH




COPYRIGHT ©  
 WIER & ASSOCIATES, INC.  
 LAST SHEET EDIT  
 DATE 10/30/2015  
 WA# 14029  
**SHEET NO.**  
 C-P102




PRINTED: 10/30/2015 5:53 PM FILE: WIER-PAVING.STB LAST SAVED: 10/30/2015 2:53 PM SAVED BY: PHILIP FILE: PAVING-DETAILS-I-14029.DWG

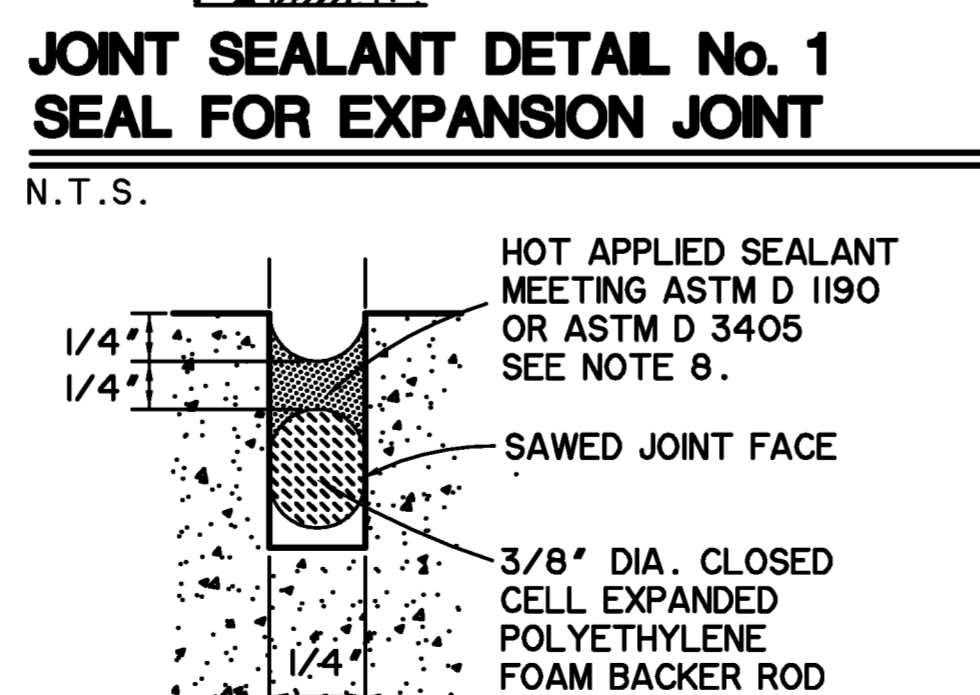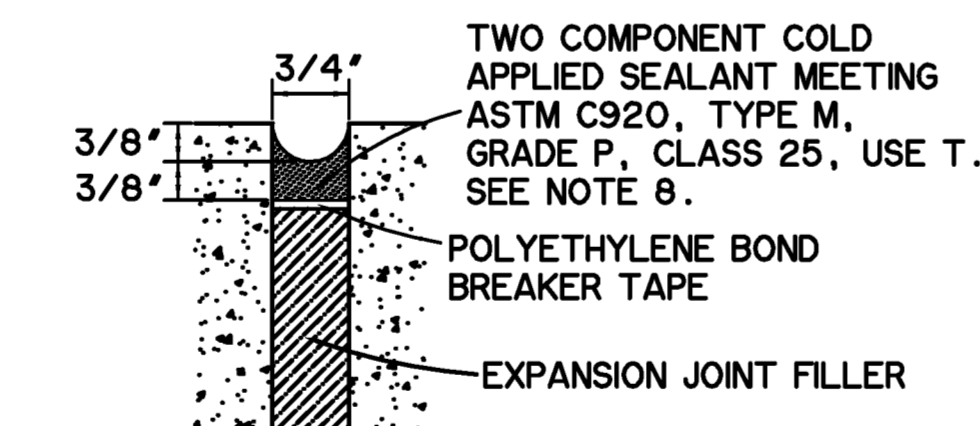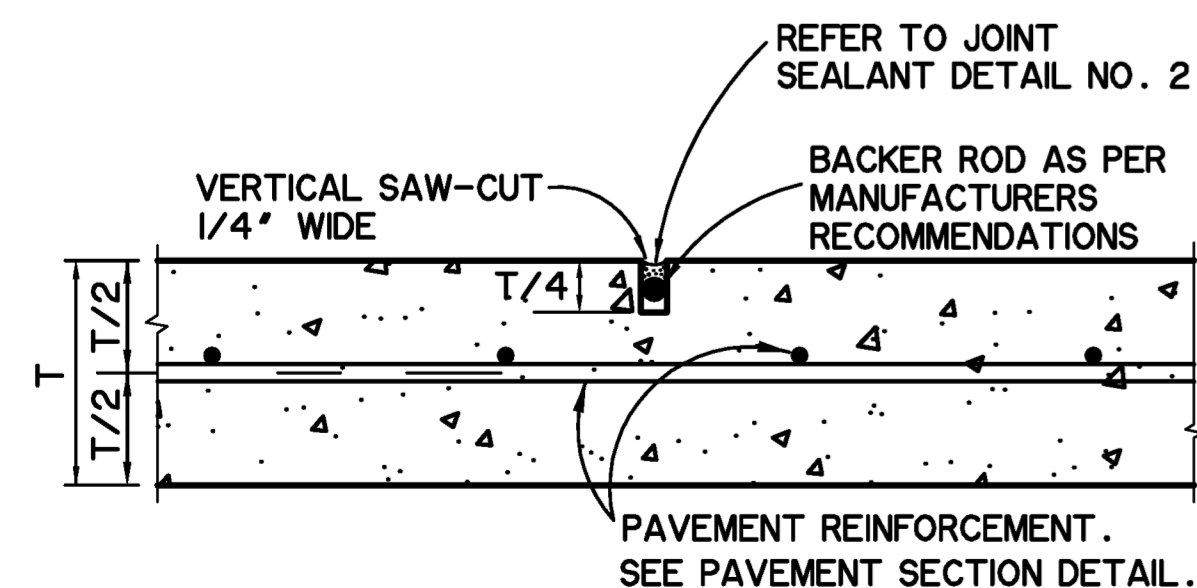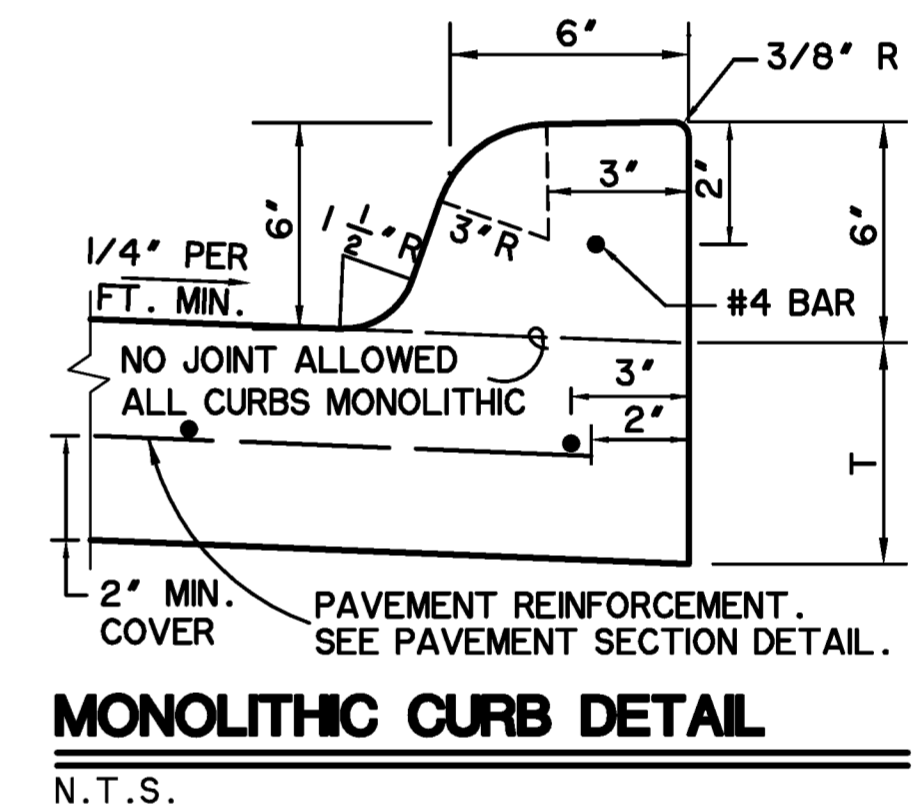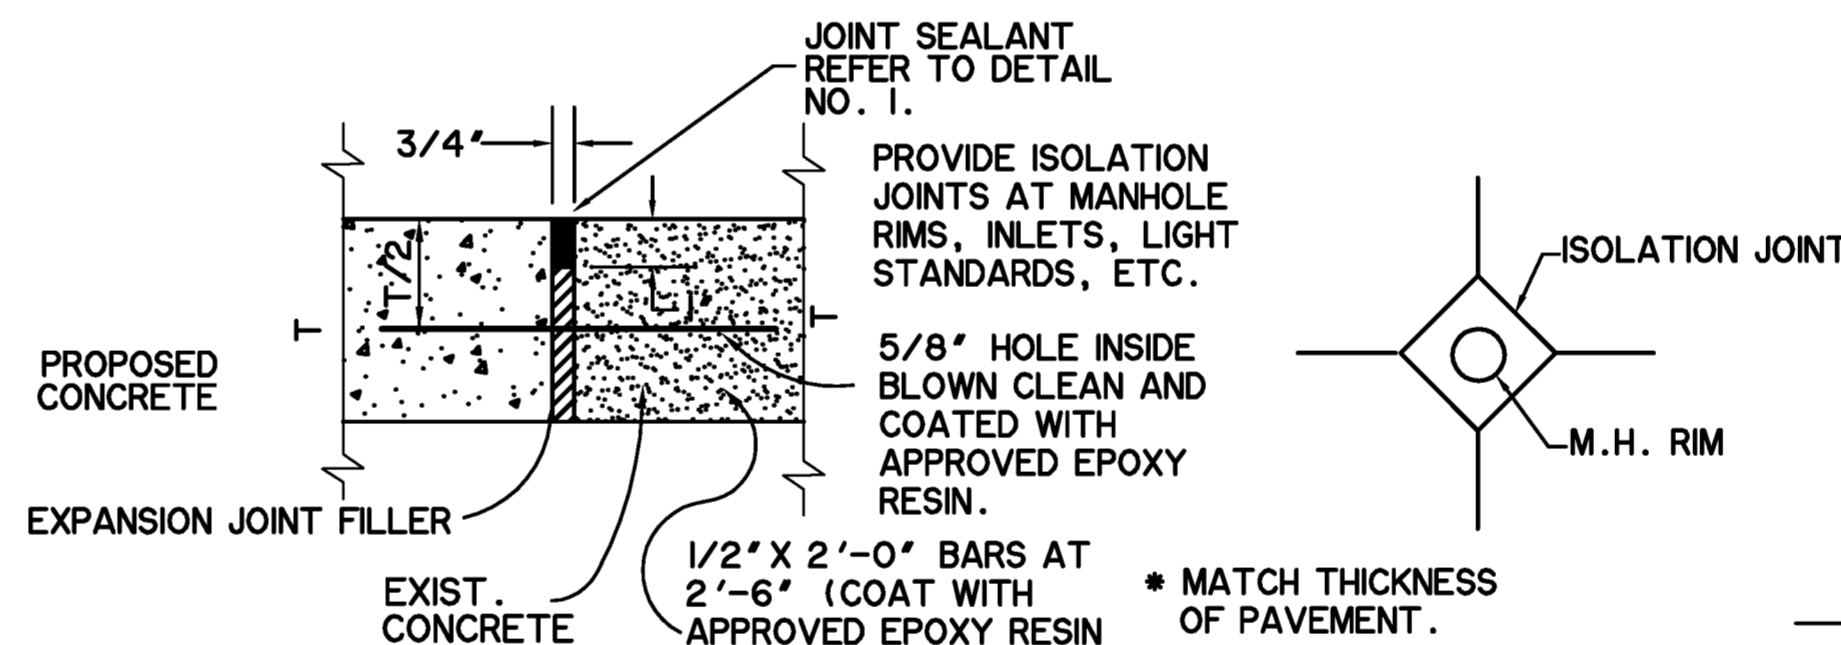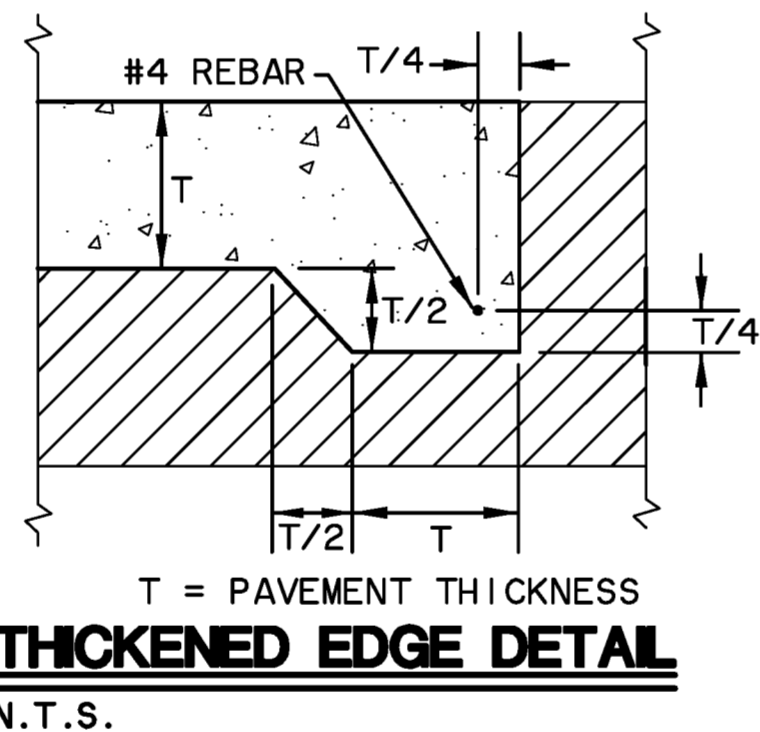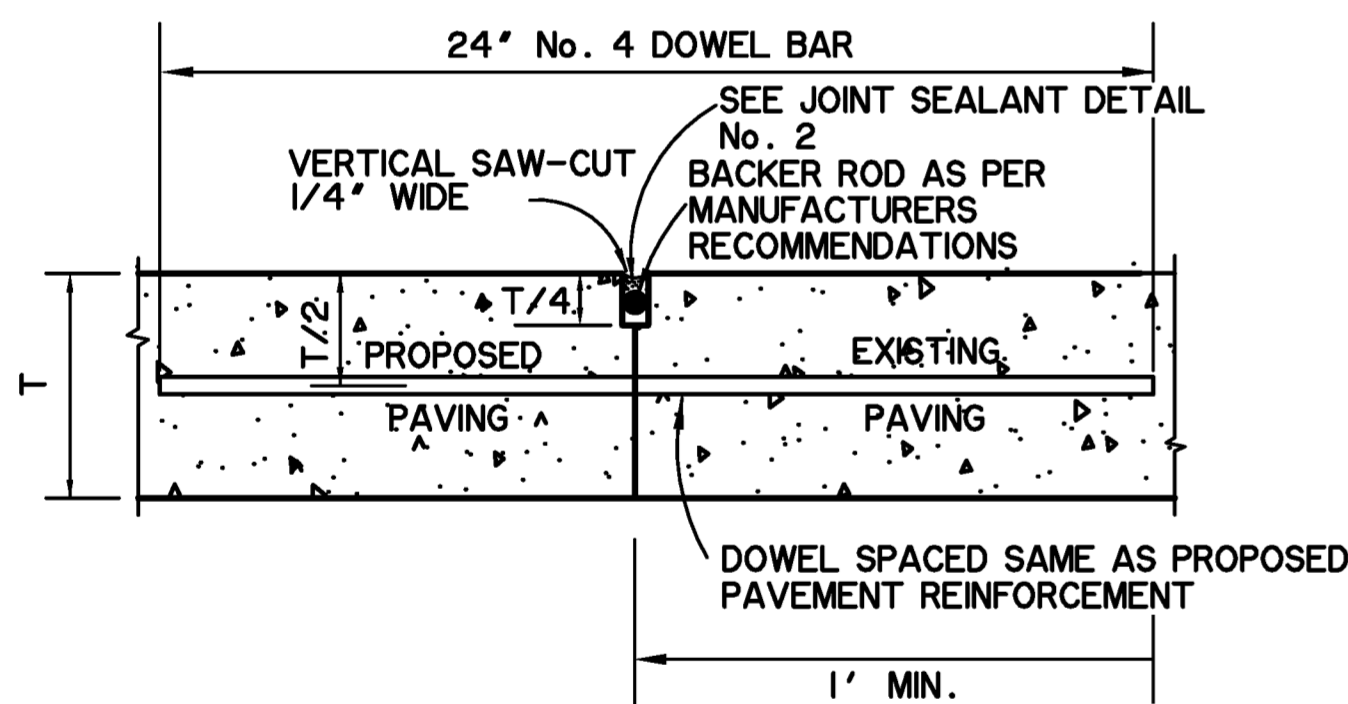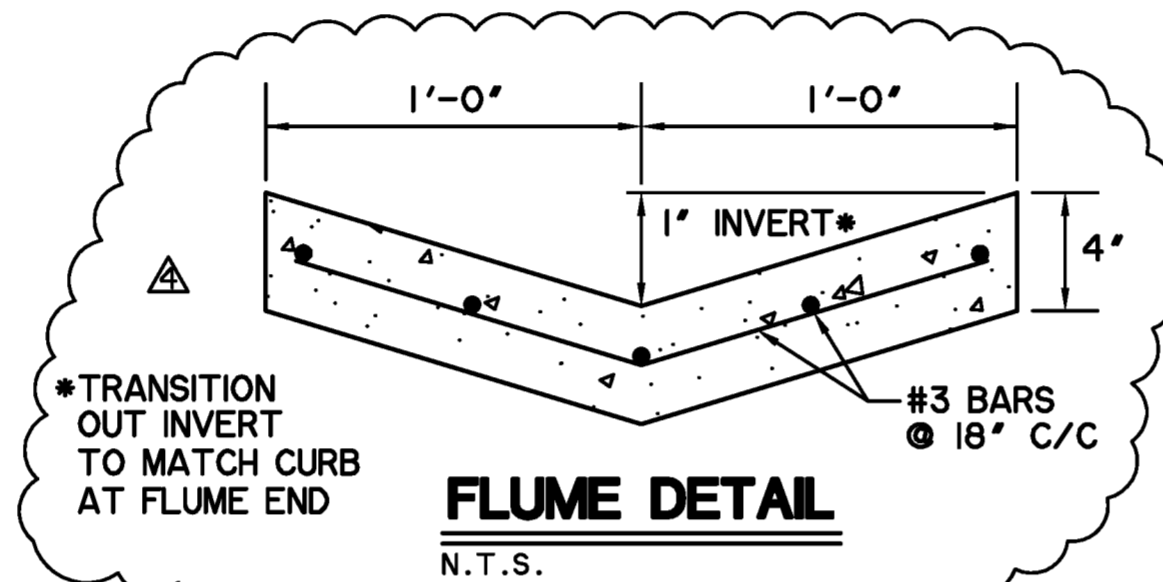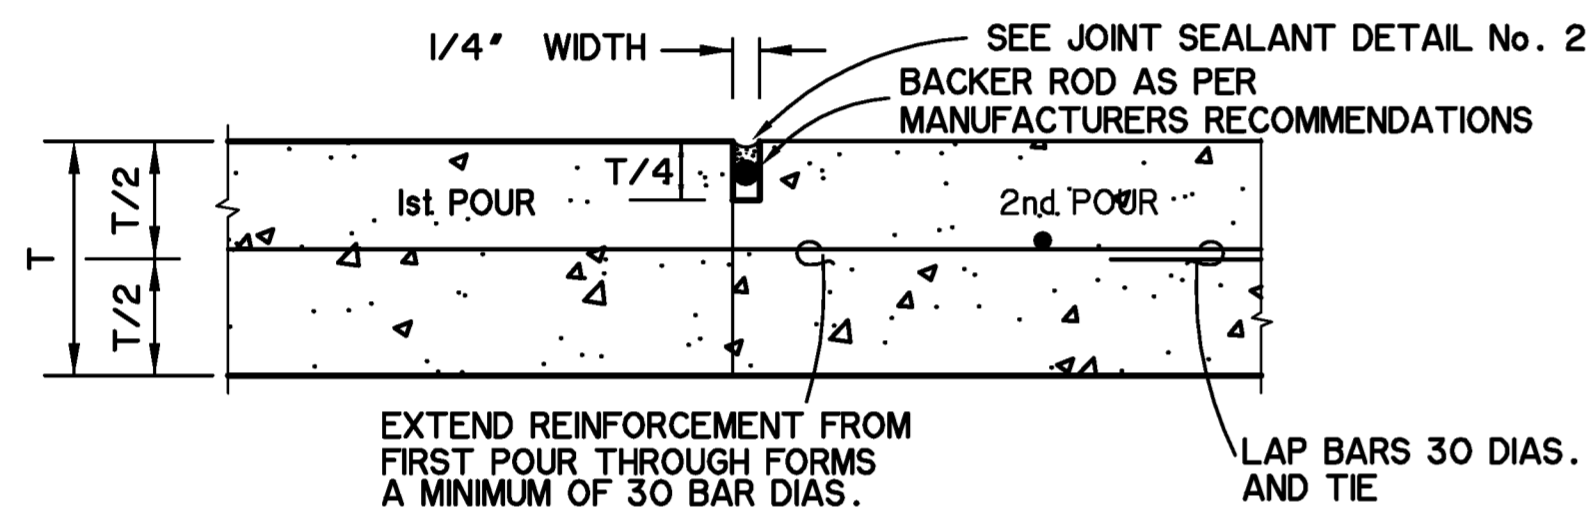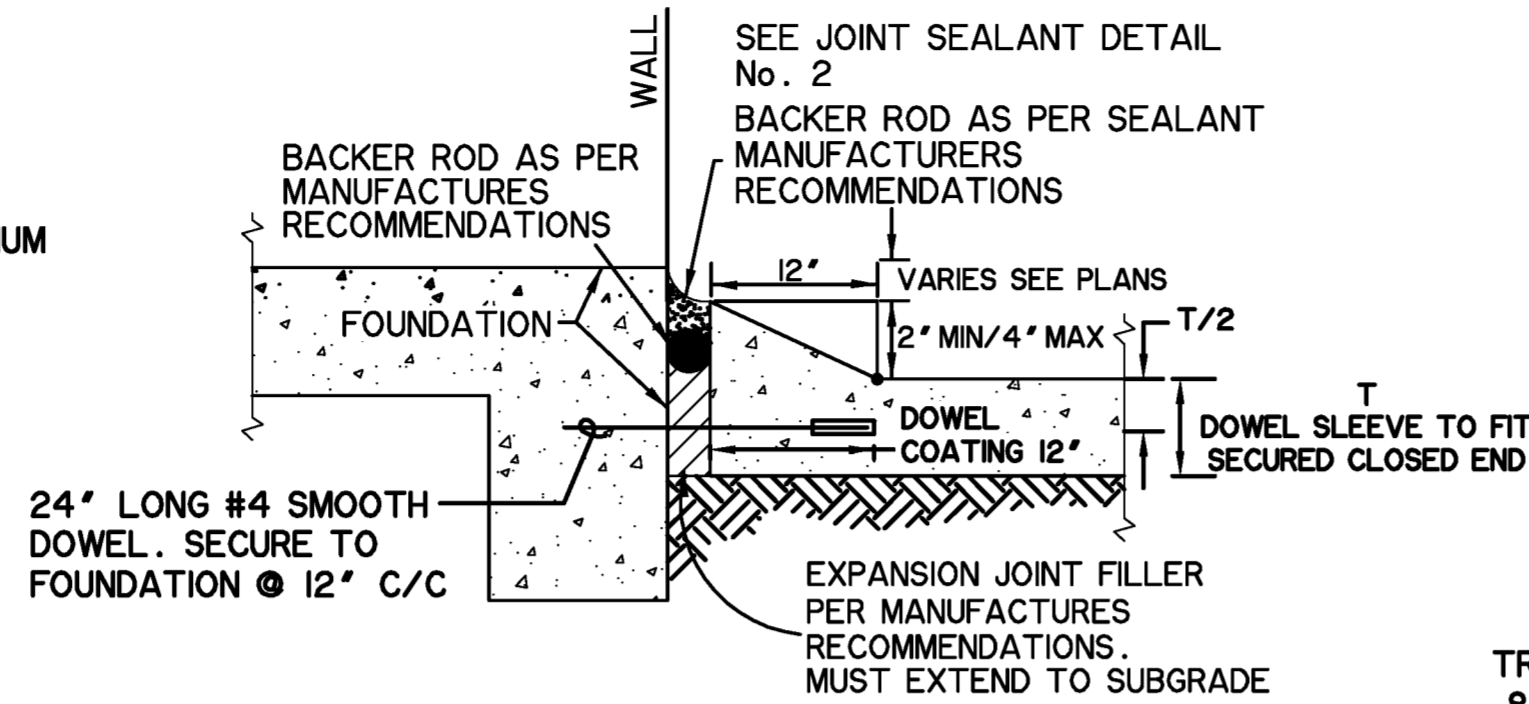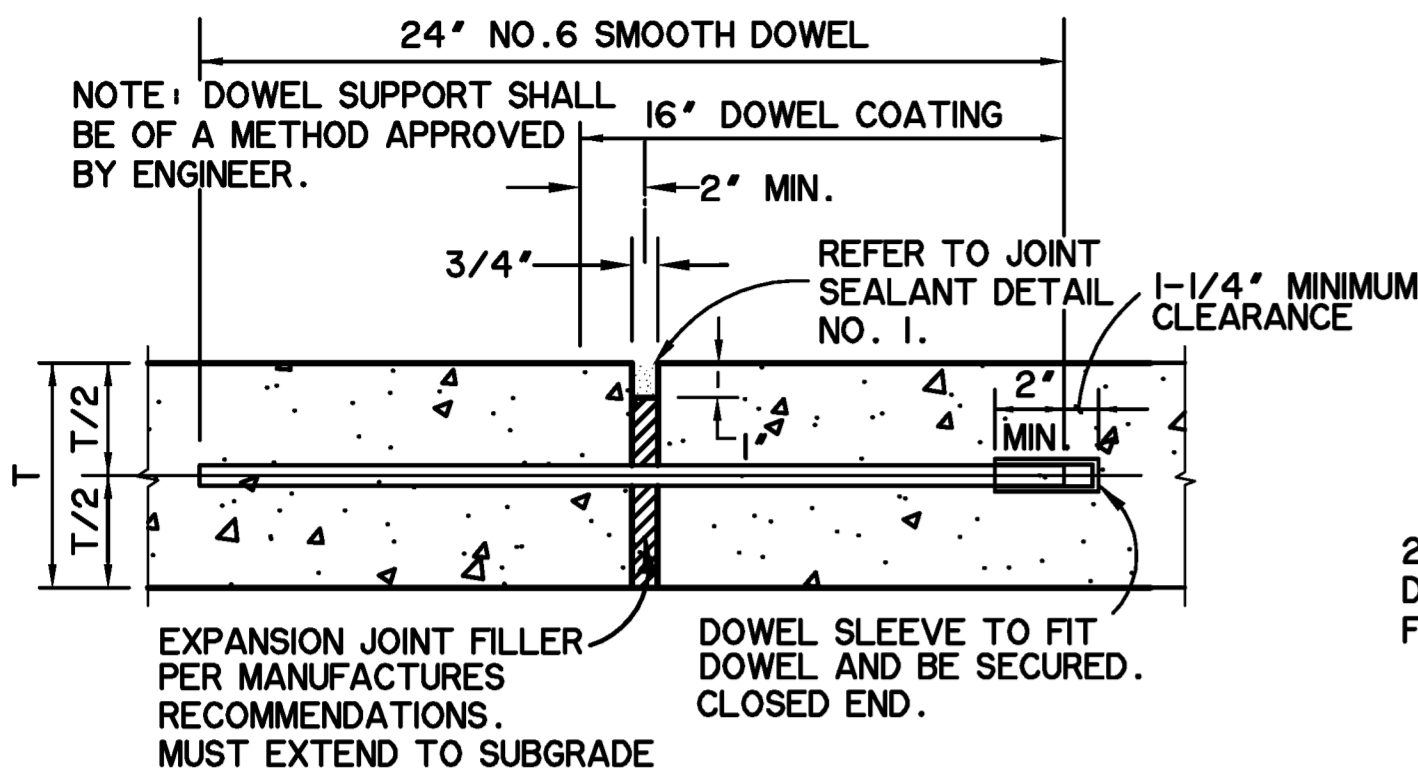

- JOINT NOTES:**  
T = PAVEMENT THICKNESS
- CONTRACTOR MAY ELECT TO USE DOWELED CURB OR MONOLITHIC CURB
  - DOWEL BARS PLACED INTO EXISTING PAVEMENT SHALL BE DRILLED INTO PAVEMENT HORIZONTALLY BY USE OF A MECHANICAL RIG. DRILLING BY HAND IS NOT ACCEPTABLE. PUSHING DOWEL BARS INTO GREEN CONCRETE IS NOT ACCEPTABLE. SECURE DOWEL BARS IN EXISTING PAVING WITH EPOXY GROUT.
  - POLYETHYLENE FOAM BACKER ROD DOES NOT SIT ON BOTTOM OF SAW-CUT JOINT. PLACE AT DEPTH INDICATED IN DETAIL.
  - IF SEALANT PROTRUDES ABOVE THE SURFACE OF THE PAVEMENT, IT MUST BE REMOVED AND REPLACED.
  - SUBMIT MANUFACTURER'S LITERATURE FOR SEALANT, DOCUMENTING PRODUCT COMPLIES WITH ASTM SPECIFICATIONS AND PROVIDING MANUFACTURER'S RECOMMENDATIONS FOR APPLICATION. FOLLOW MANUFACTURER'S RECOMMENDATIONS ON USE OF THE PRODUCT.
  - THE CONSTRUCTION JOINT IS TO BE USED BETWEEN SEPARATE POURS OF PROPOSED PAVEMENT. NOTE THAT IT REQUIRES THE REINFORCEMENT TO BE EXTENDED THROUGH THE FORM TO TIE TO THE NEXT POUR. THE BUTT JOINT IS TO BE USED BETWEEN EXISTING CONCRETE PAVEMENT (STREET OR DRIVEWAY) AND PROPOSED PAVEMENT, UNLESS AN EXPANSION JOINT IS CALLED FOR.
  - JOINT SEALANTS SHALL BE INSTALL SOON AFTER JOINTS ARE SAWED AND/OR COMPLETED. THE JOINTS SHALL BE SEALED BEFORE A RAIN EVENT OCCURS AFTER SAWING OR COMPLETING THE JOINT.
  - JOINT SEALANTS MAY BE REQUIRED BY ARCHITECT OR OWNER TO BE GREY SILICONE TYPE SEALANTS MEETING ASTM C639, ASTM C679, ASTM C792, ASTM C793, ASTM D412 AND ASTM D792.

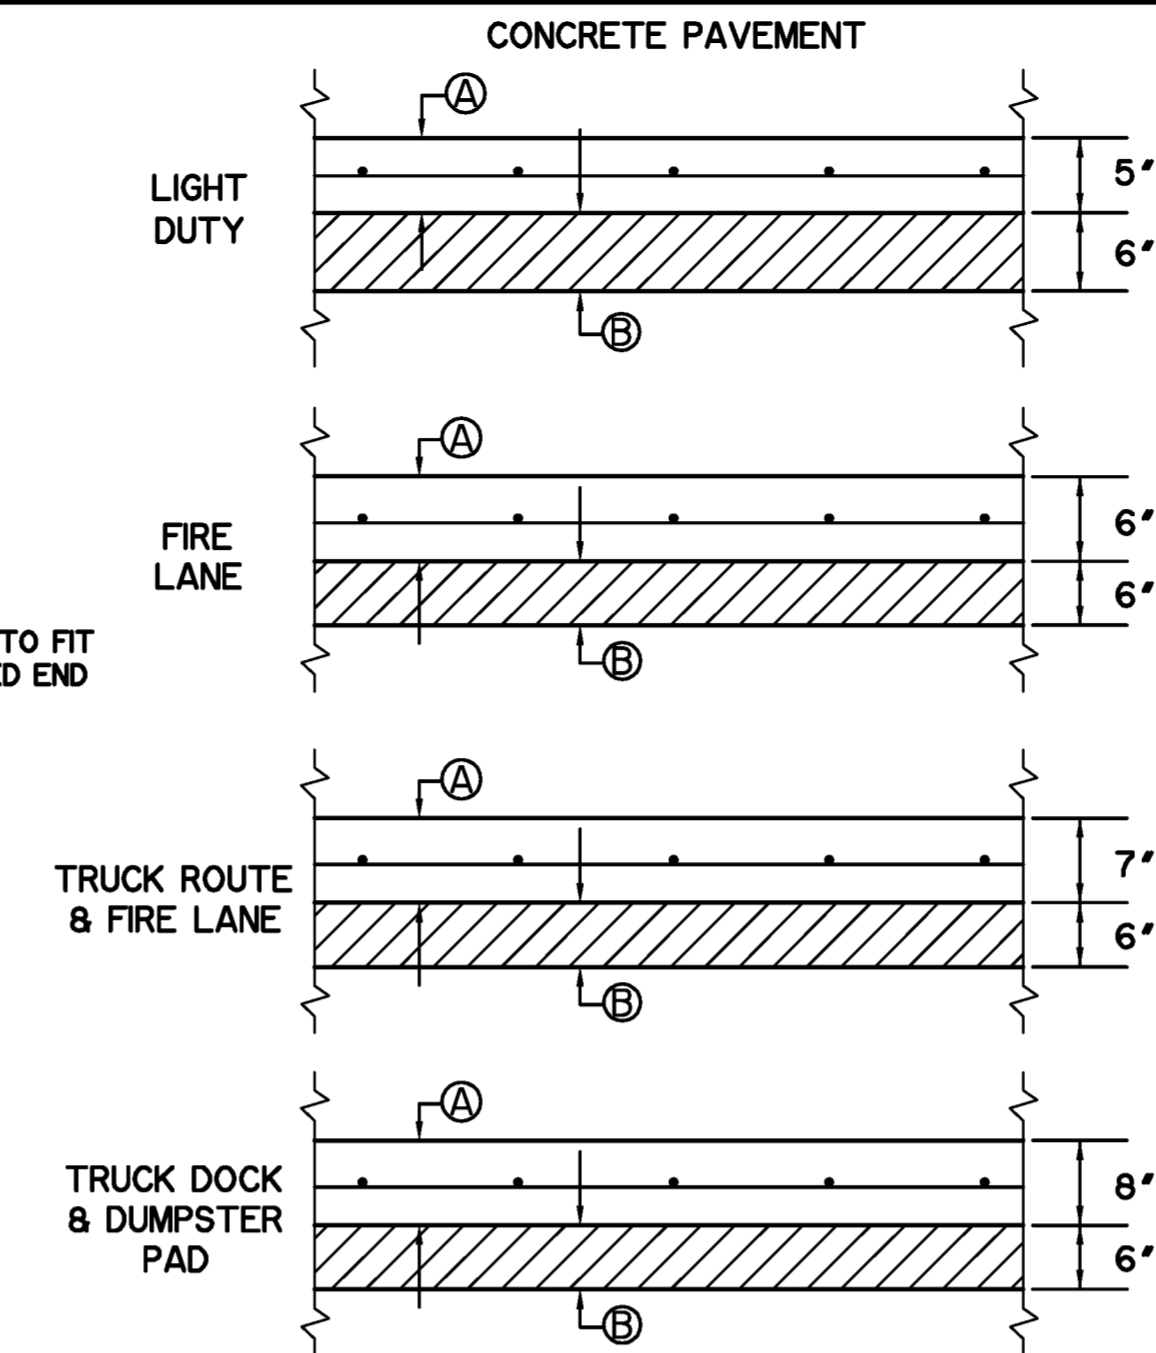


- NOTES:**
- PRIVATE ON-SITE PAVING
    - 3,600 P.S.I. CONCRETE (MIN. 6.5 SACK MIX) REINFORCED WITH #3 BARS @ 18" C/C BOTH WAYS WITH FIVE (5) PERCENT ( $\pm 1$  PERCENT) ENTRAINED AIR TO IMPROVE WORKABILITY AND DURABILITY.
    - 6" COMPACTED SUBGRADE TO BETWEEN 95% AND 100% STANDARD PROCTOR DENSITY (ASTM D698) AND BROUGHT TO A MOISTURE CONTENT BETWEEN 0% AND 4% OF THE OPTIMUM MOISTURE VALUE.
    - 6" MECHANICALLY LIME STABILIZED CLAY SUBGRADE (8% LIME APPLICATION RATE 36 lbs./S.Y.) COMPACTED TO BE BETWEEN 95% TO 100% STANDARD PROCTOR DENSITY (ASTM D698) AND BROUGHT TO A MOISTURE CONTENT BETWEEN 0% AND 4% OF THE OPTIMUM MOISTURE VALUE.
  - MATERIAL AND CONSTRUCTION METHODS SHALL CONFORM TO THE APPLICABLE PROVISIONS OF THE 3RD EDITION OF THE STANDARD SPECIFICATIONS FOR PUBLIC WORKS CONSTRUCTION PREPARED BY THE NORTH CENTRAL TEXAS COUNCIL OF GOVERNMENTS AND CITY OF ROCKWALL STANDARDS OF DESIGN AND CONSTRUCTION.
  - DO NOT PLACE SAND BENEATH PAVEMENT FOR LEVEL UP COURSE.
  - COMPACTION OF THE PAVEMENT SUBGRADES, BASES, AND NEW FILL SHALL BE VERIFIED BY FIELD MOISTURE/DENSITY TESTS MADE AT A MINIMUM FREQUENCY OF ONE TEST PER 10,000 SQUARE FEET.
  - THE CONCRETE SHALL BE DESIGNED IN ACCORDANCE WITH ACI BUILDING CODE 318 USING 4% TO 6% AIR ENTRAINMENT. THE CONCRETE DESIGN MIX SHALL BE PROVIDED TO THE PROJECT GEOTECHNICAL ENGINEER FOR REVIEW.
  - VOIDS SHALL BE BACKFILLED WITH A TOPSOIL/BERMUDA GRASS SEED BLEND TO WITHIN 1/2" OF THE CONCRETE SURFACE.

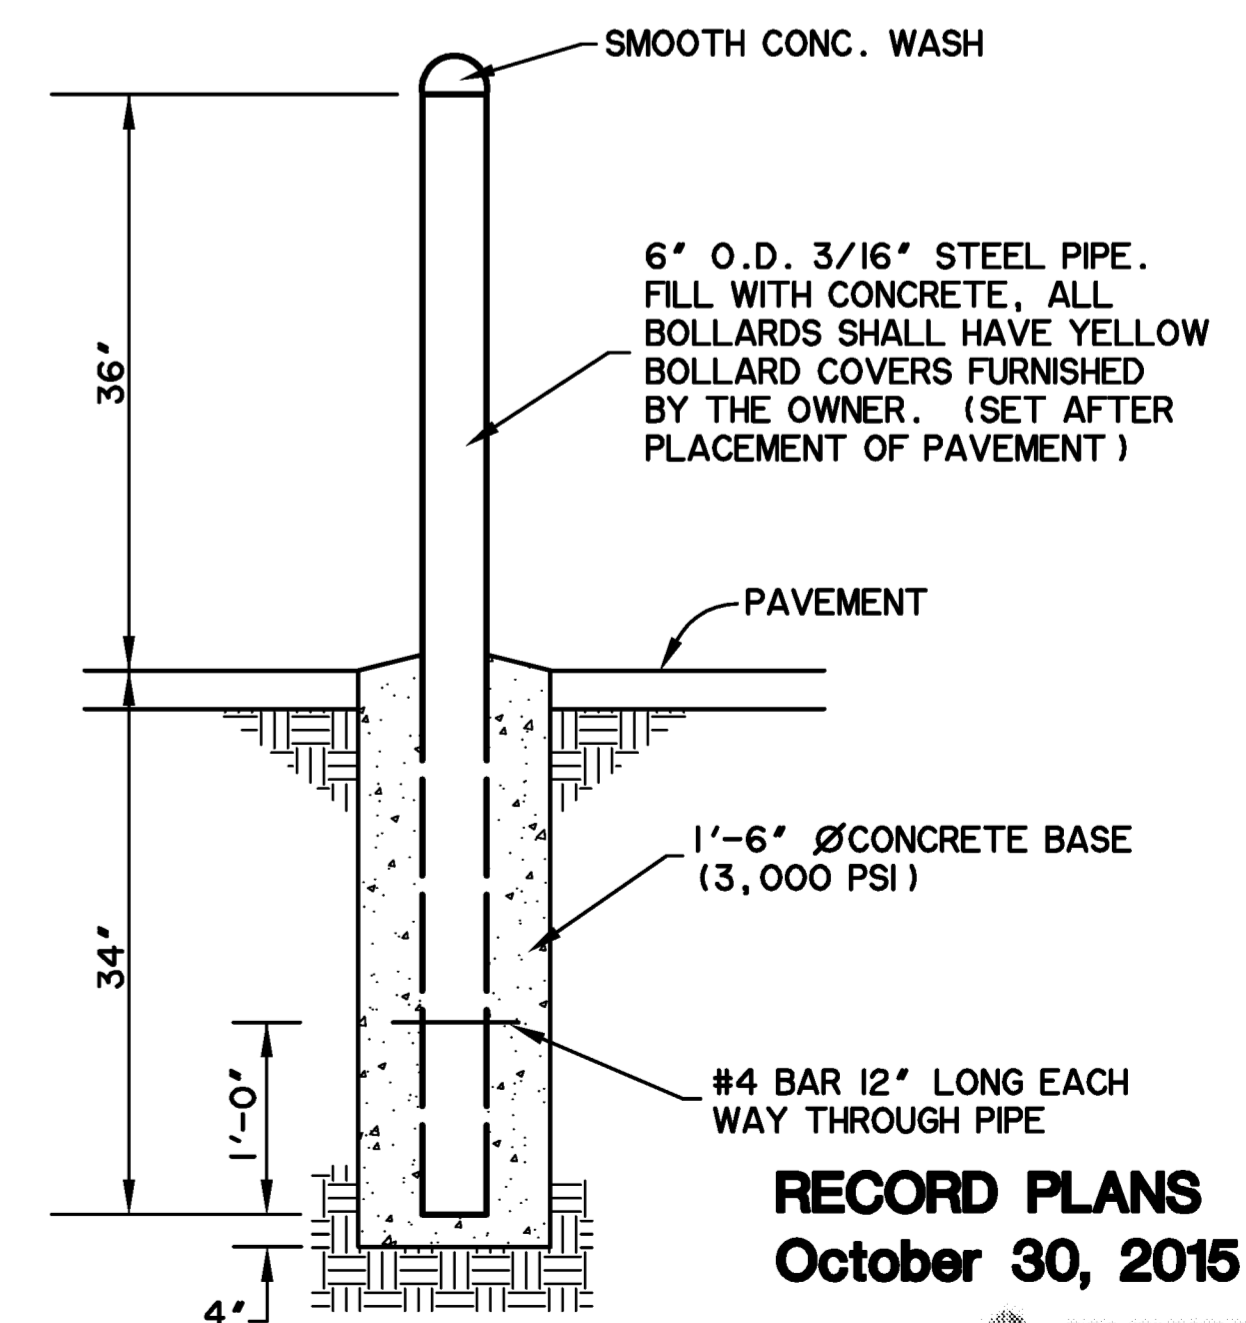

| REVISIONS             | DATE BY      |
|-----------------------|--------------|
| 4. ADDED FLUME DETAIL | 04/13/15 TVW |

PREPARED BY:  
**WIER & ASSOCIATES, INC.**  
ENGINEERS SURVEYORS LAND PLANNERS  
2201 E. LAMAR BLVD., SUITE 200E ARLINGTON, TEXAS 76006 METRO (817)467-7700  
www.wierassociates.com  
Texas Firm Registration No. F-2776

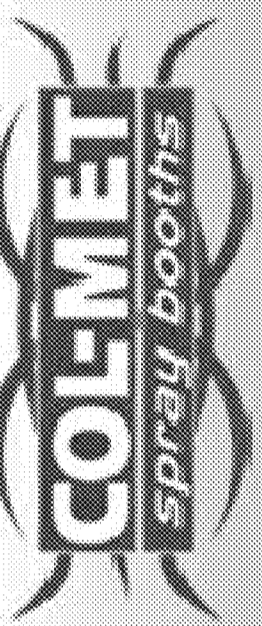

**LOT 3, BLOCK B**  
**ROCKWALL TECHNOLOGY PARK PHASE I**  
**COL-MET SPRAY BOOTHS**  
**PRIVATE PAVING DETAILS**




**RECORD PLANS**  
October 30, 2015

**CUSHMAN & WAKEFIELD**


**SCOTT + REID**  
General Contractors

COPYRIGHT ©  
WIER & ASSOCIATES, INC.  
LAST SHEET PLOT  
DATE 10/30/2015  
W# 14029  
**SHEET NO.**  
**C-P301**


PRINTED: 10/28/2015 6:09 AM FILE: WIER-PAVING-STB LAST SAVED: 10/28/2015 6:09 AM FILE: PAVING-DETAILS-2-14029.DWG

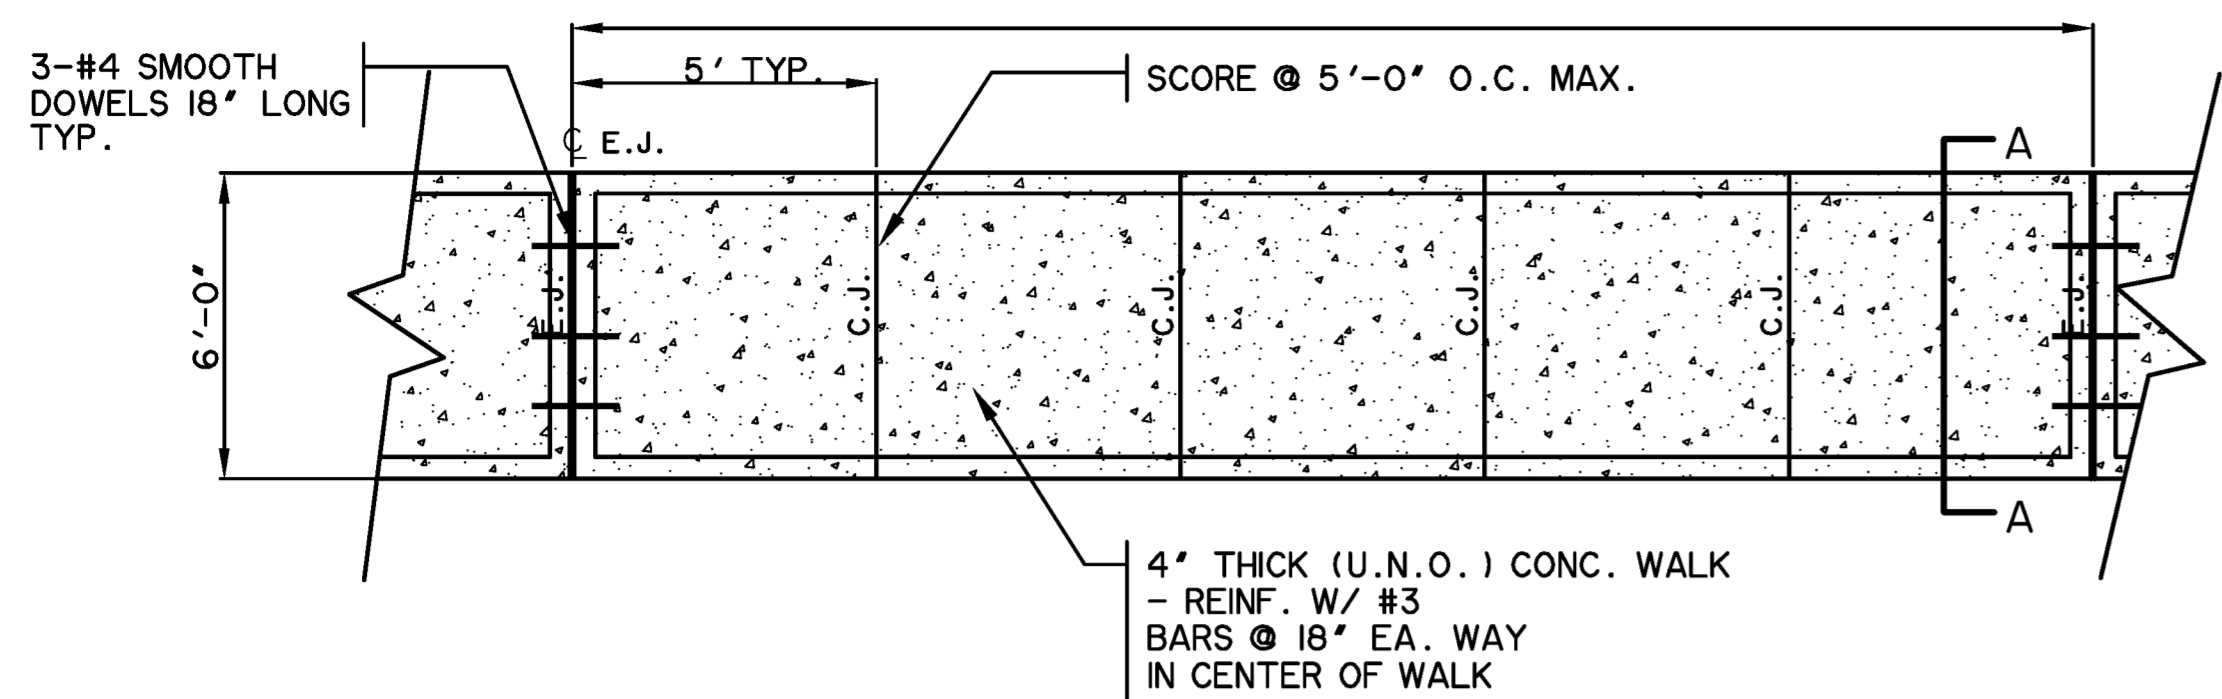


**PLAN - TYP. CONC. WALK**  
N.T.S.

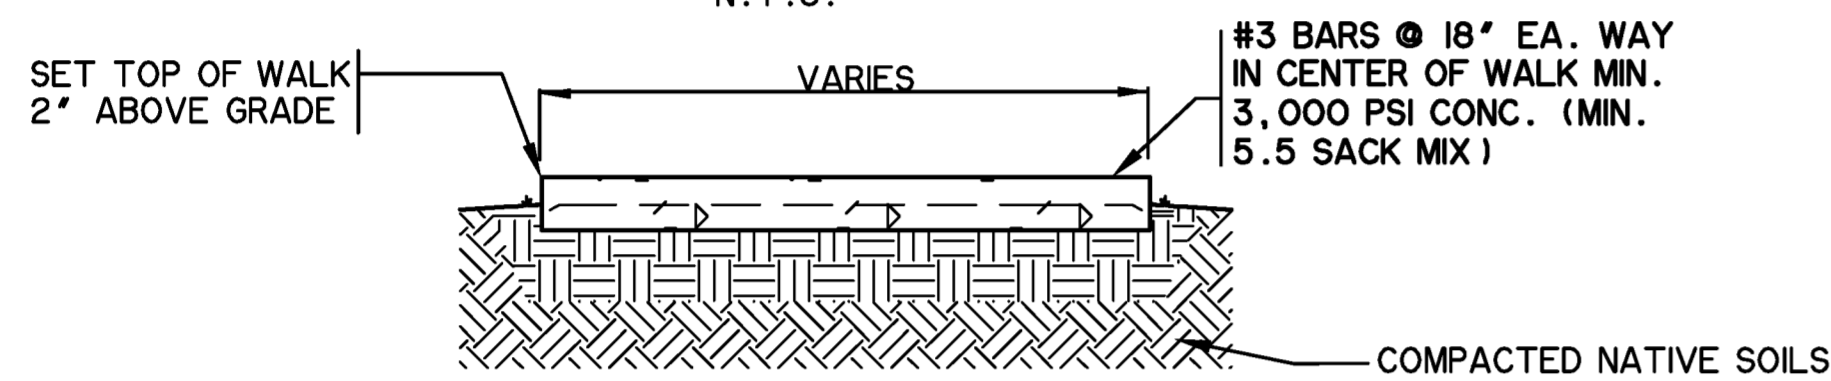

**SECTION 'A-A' - TYP. CONC. WALK**  
N.T.S.

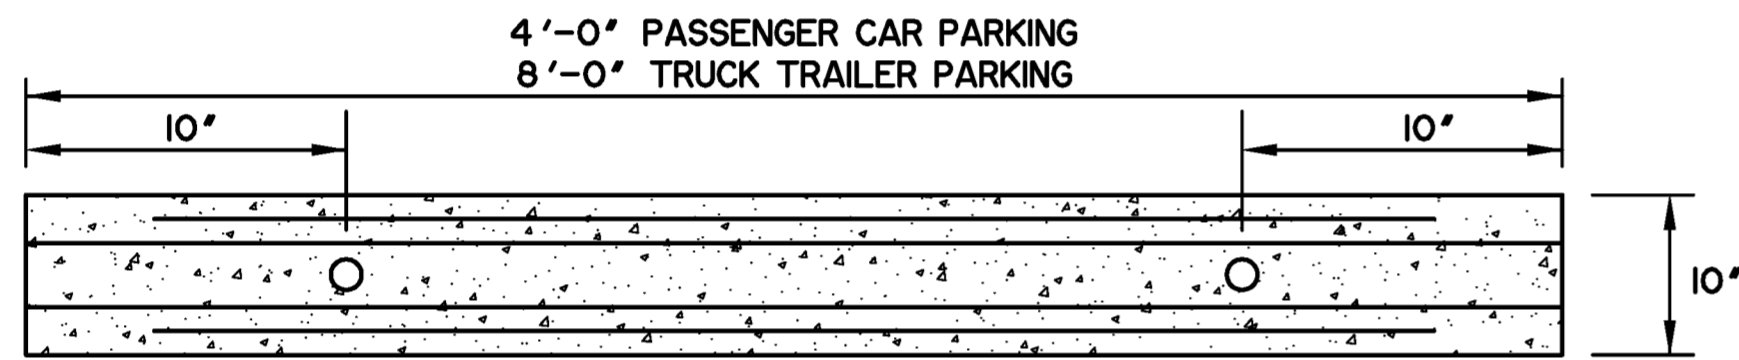


**PLAN VIEW**

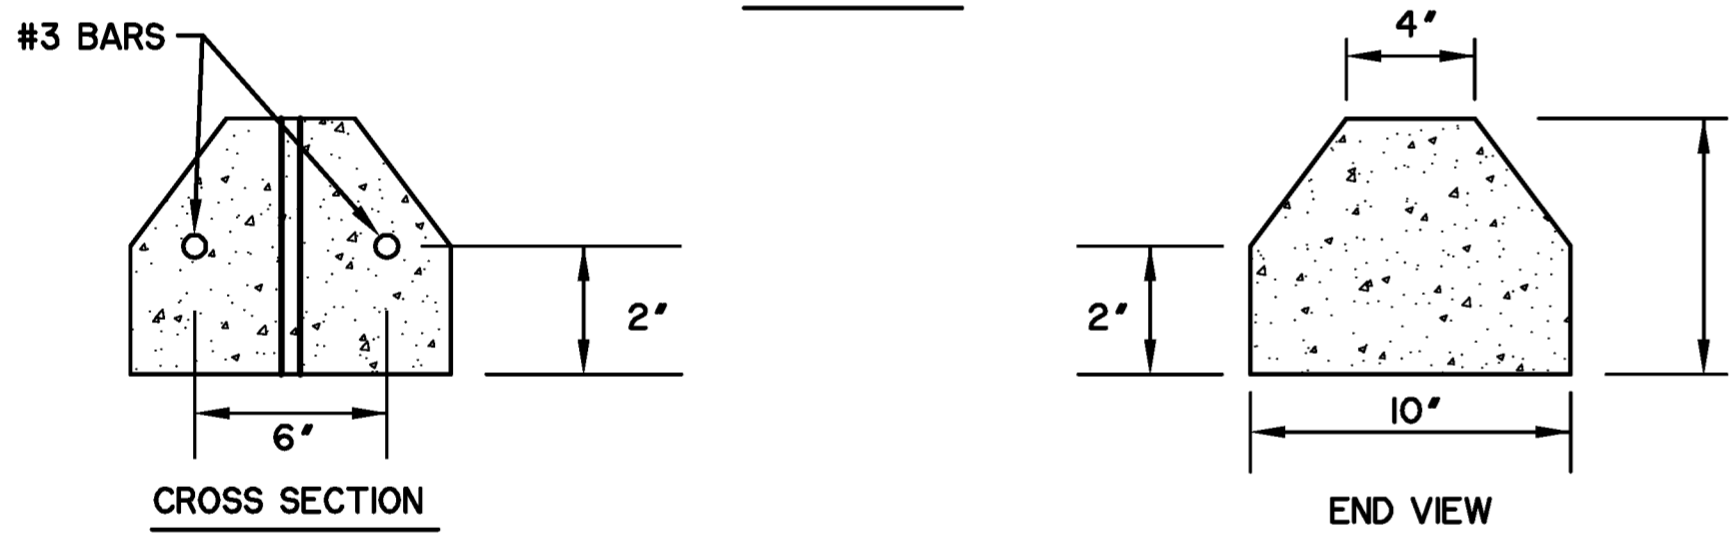

**CROSS SECTION**


**END VIEW**

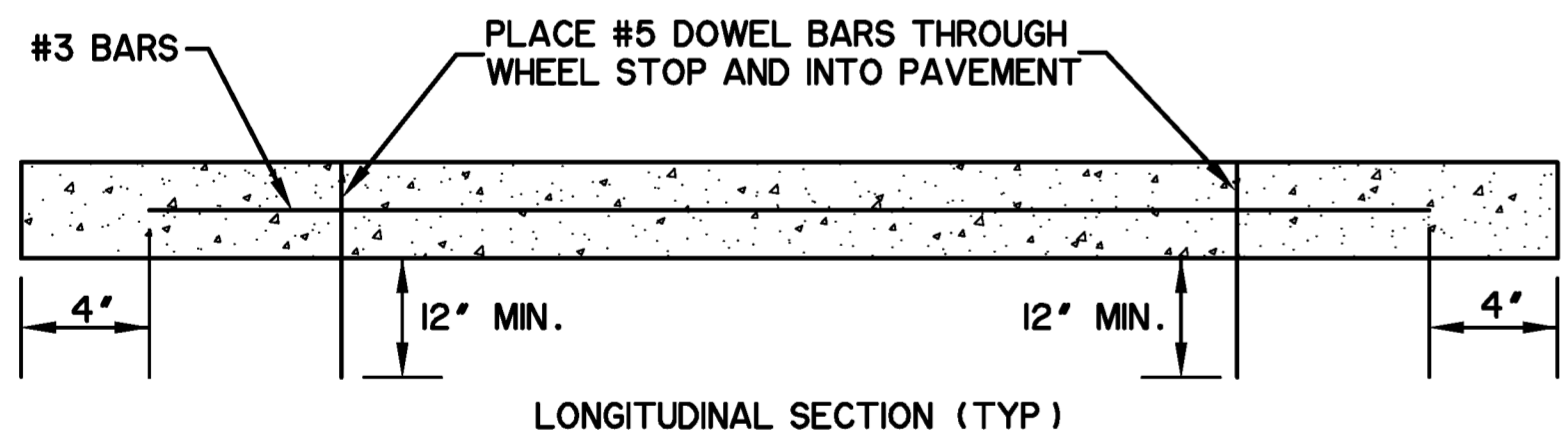


**LONGITUDINAL SECTION (TYP)**

ALL CONCRETE SHALL BE CLASS A CONCRETE IN ACCORDANCE WITH ITEM 364 OF THE TEXAS DEPARTMENT OF TRANSPORTATION STANDARD SPECIFICATIONS LATEST EDITION.


**WHEEL STOP**  
N.T.S.

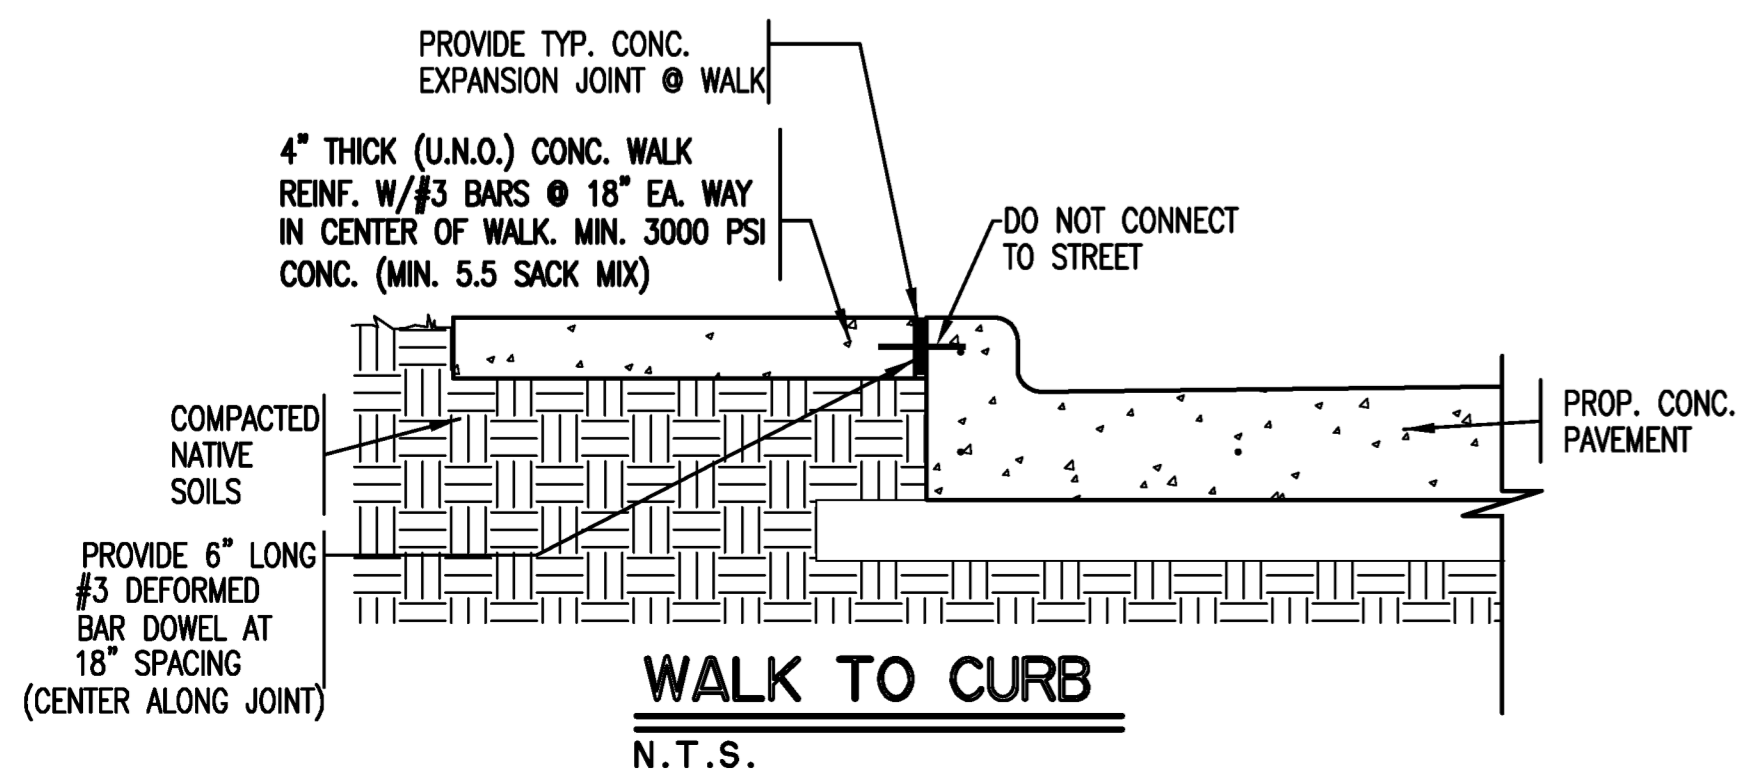

**WALK TO CURB**  
N.T.S.

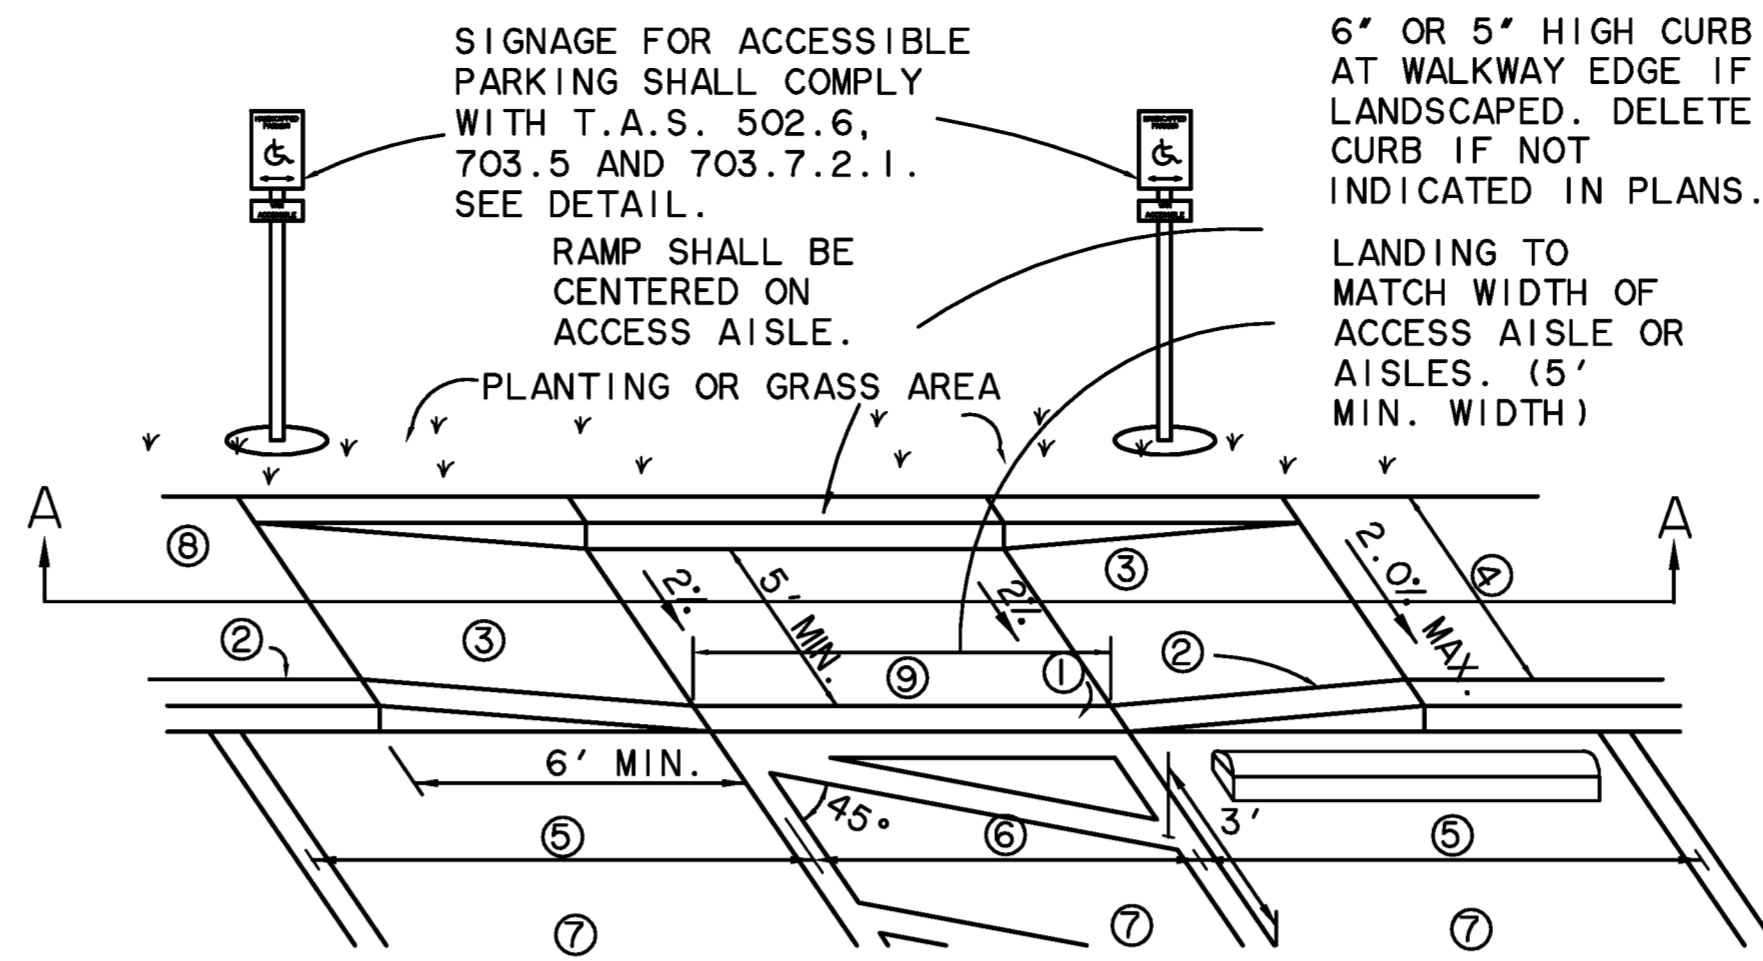


**TYPE-3 CURB RAMP**

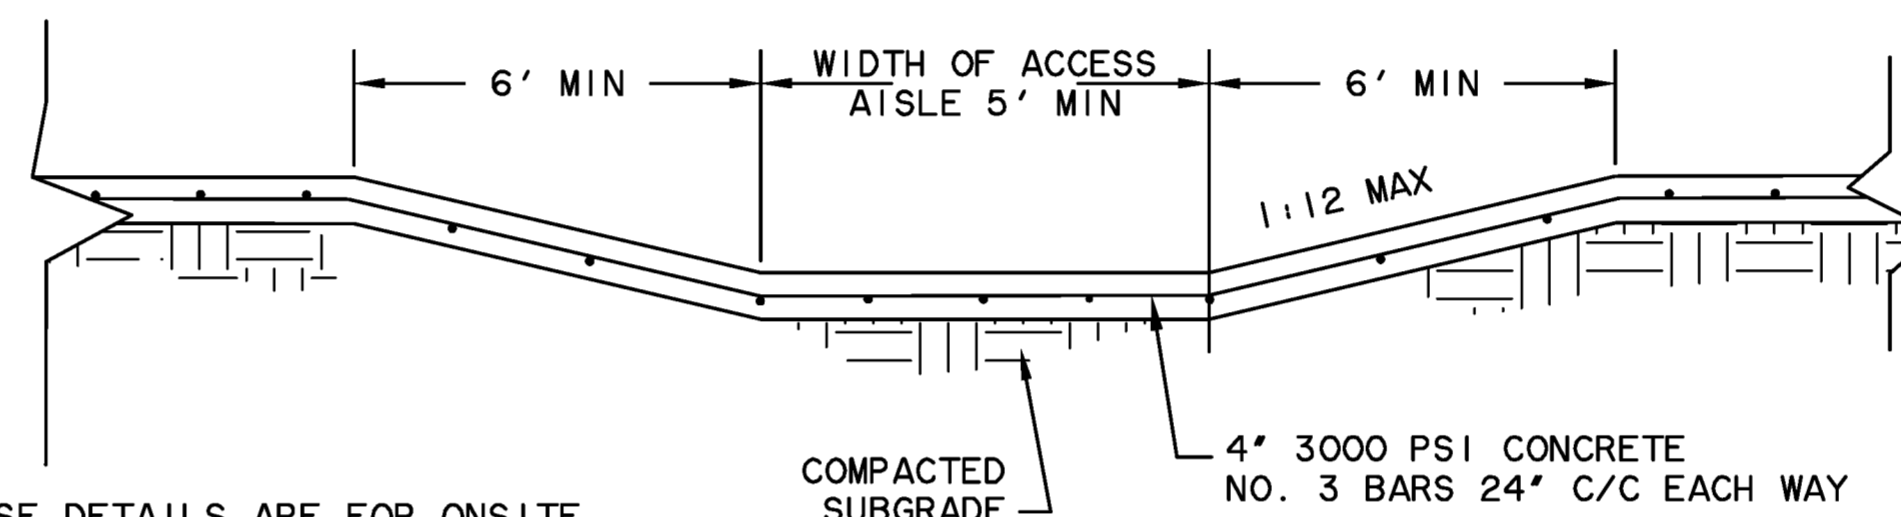

**SECTION 'A-A'**  
N.T.S.


**CURB RAMP DETAILS**  
N.T.S.

\* THESE DETAILS ARE FOR ONSITE CURB RAMPS. ALL OTHER CURB RAMPS WITHIN PUBLIC RIGHT-OF-WAY SHALL BE CONSTRUCTED IN COMPLIANCE WITH LOCAL CITY CODES AND DETAILS. CURB RAMPS WITHIN THE CITY RIGHT-OF-WAY SHALL REQUIRE TRUNCATED DOME PLATES.

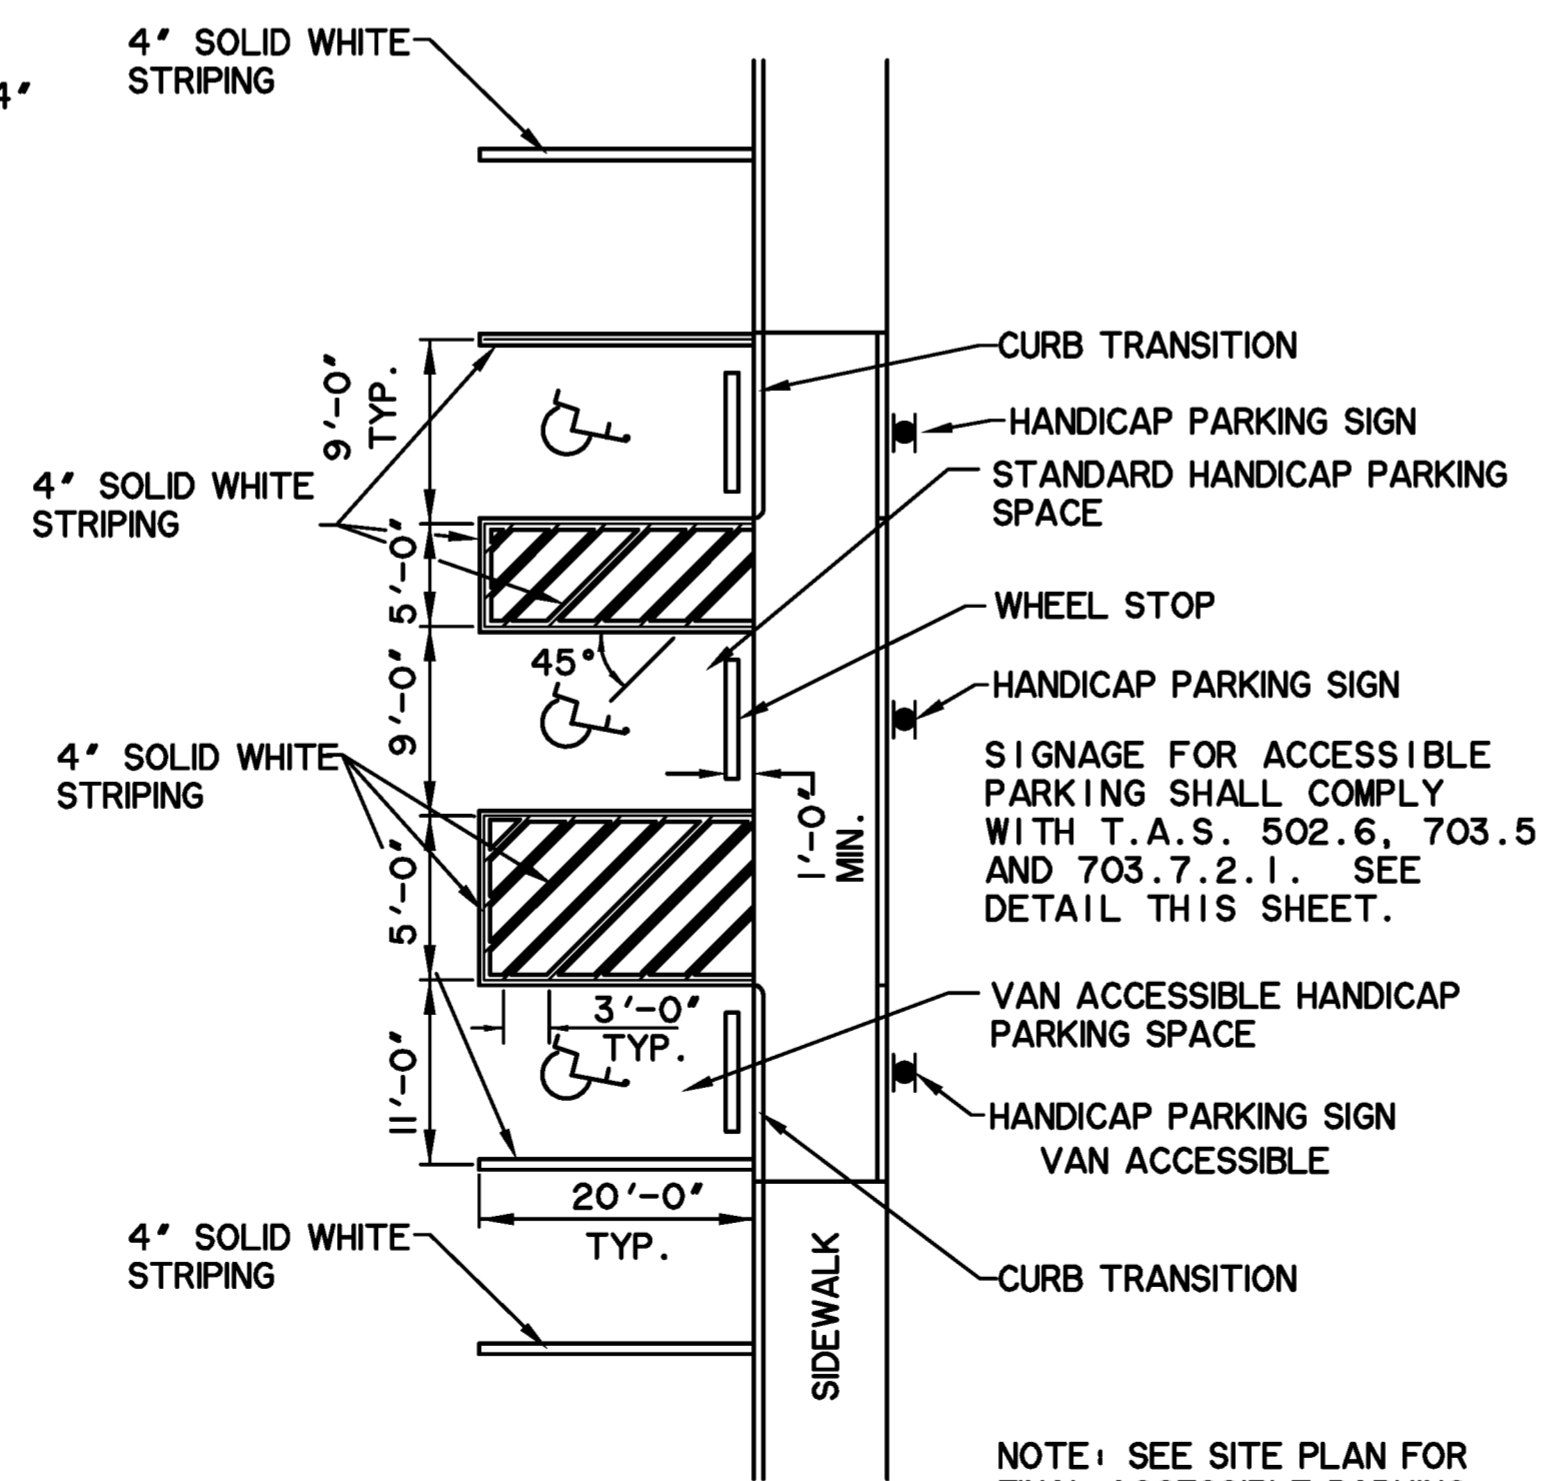

**90° PARKING**  
N.T.S.

- NOTES:
- HANDICAPPED PARKING SPACE DENOTED BY SYMBOL
  - STRIPING SHALL BE NON-REFLECTORIZED AND CONFORM TO THE STANDARD SPECIFICATIONS FOR PUBLIC WORKS CONSTRUCTION, NCTCOG. DIVISION 800, ITEM 804.2.2.

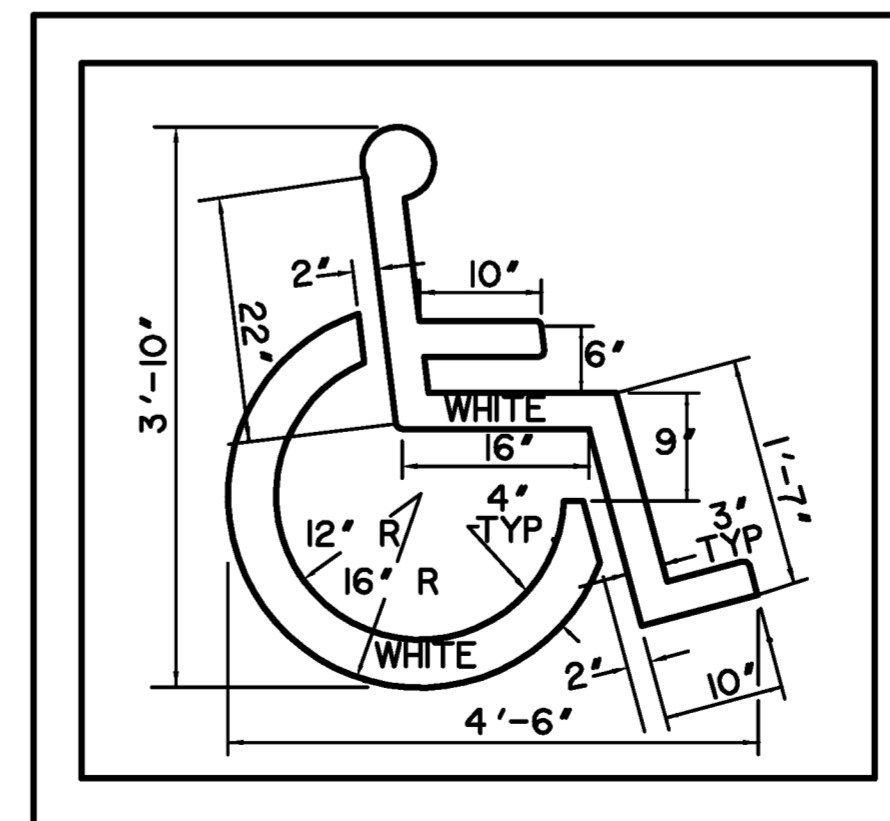


**HANDICAPPED PARKING SPACE SYMBOL**  
SEE SPACES DESIGNATED 'H'  
N.T.S.

1'-0" x 1'-6" x 0.08" ALUMINUM HANDICAPPED PARKING SIGN. SIGN TO READ "RESERVED PARKING" WITH IDENTIFICATION SYMBOL AND "VAN ACCESSIBLE" WHERE APPLICABLE. BOLT TO STEEL TUBE WITH 1/2" CADMIUM PLATED BOLTS, NUTS, AND WASHERS.

2" x 2" x .188" STEEL TUBE EXTEND INTO CONCRETE FILLED PIPE 2'-0". PROVIDE WELDED WATERTIGHT CAP.

SIGNAGE FOR ACCESSIBLE PARKING SHALL COMPLY WITH T.A.S. 502.6, 703.5, AND 703.7.2.1

NOTE: WHERE SIGN IS LOCATED IN PLANTER AREA, USE 2" x 2" TUBE STEEL FULL LENGTH AND SET IN CONCRETE 3'-0" MIN. BELOW GRADE.

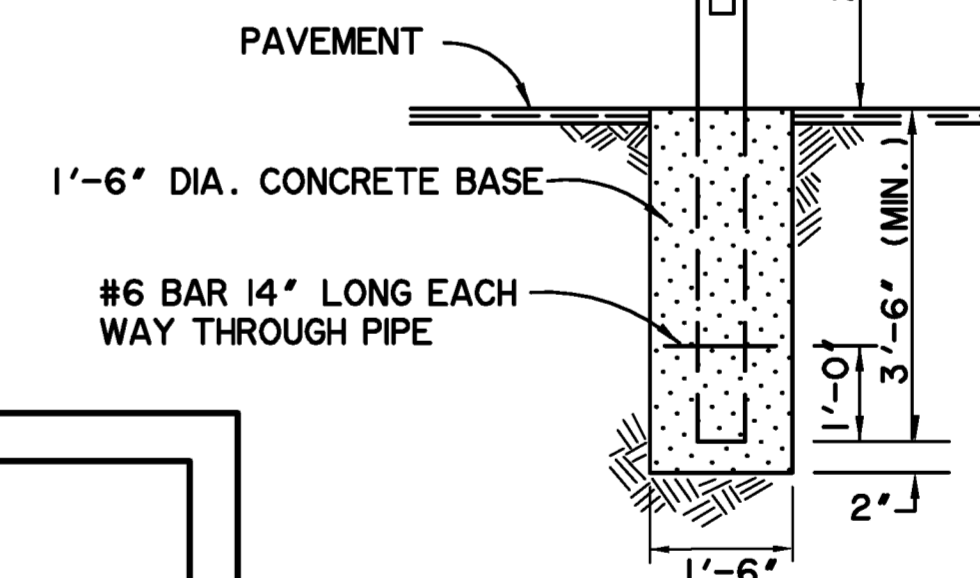

**HANDICAPPED PARKING SIGN**  
N.T.S.

NOTES:

- TOP OF CURB TO BE FLUSH WITH PAVEMENT.
- TOP OF CURB TO BE FLUSH WITH TOP OF WALK.
- CURB RAMP SLOPES SHALL NOT EXCEED 1:12 AND SHALL COMPLY WITH T.A.S. 406.2 AND 406.3.
- 36" MIN. IF PARKING STALL LENGTH IS 20' AND CURB STOPS ARE PROVIDED 2' OFF CURB OR 60" MIN. IF PARKING STALL LENGTH IS 18' WITH NO CURB STOPS. IF DIMENSION IS LESS THAN 48', THEN THE SLOPE OF THE FLARED SIDE SHALL NOT EXCEED 1:12.
- ACCESSIBLE PARKING SPACE SHALL BE 8' MIN. AND SHALL COMPLY WITH T.A.S. 502.2. OPTIONAL UNIVERSAL PARKING SPACE SHALL BE 11' WIDE AND COMPLY WITH T.A.S. FIGURE 502.2 AND 502.3.
- ACCESS AISLE SHALL BE 5' WIDE FOR TYPICAL OR UNIVERSAL ACCESSIBLE PARKING. ACCESS AISLE SHALL BE 8' WIDE FOR VAN ACCESSIBLE PARKING.
- ACCESSIBLE PARKING SPACES AND ACCESS AISLE SHALL BE LEVEL WITH SURFACE SLOPES NOT EXCEEDING 1:50 (2%) IN ALL DIRECTIONS AND SHALL COMPLY WITH T.A.S. 502.4.
- AN ACCESSIBLE ROUTE WITH A RUNNING SLOPE GREATER THAN 1:20 (5%) IS CONSIDERED A RAMP AND SHALL COMPLY WITH T.A.S. 405. THE CROSS SLOPE OF AN ACCESSIBLE ROUTE SHALL NEVER EXCEED 1:50 (2%).
- LANDING DIMENSIONS AT TOP OF RAMP OR A CHANGE IN DIRECTION SHALL BE 5'x5' MINIMUM.
- GRADES IN ACCESSIBILITY ROUTING INCLUDE CROSSING DRIVEWAYS, SHALL CONFORM TO ADA STANDARDS, NOT TO EXCEED 5.0% ALONG TRAVEL PATH WITH NOT MORE THAN 2.0% CROSSFALL.

**RECORD PLANS**  
October 28, 2015



\* THESE DETAILS ARE FOR ON-SITE SIDEWALKS. ALL OTHER SIDEWALKS AND CURB RAMPS WITHIN PUBLIC RIGHT-OF-WAY SHALL BE CONSTRUCTED IN COMPLIANCE WITH LOCAL CODES AND DETAILS.

**WIER & ASSOCIATES, INC.**  
**ENGINEERS SURVEYORS LAND PLANNERS**  
 2201 E. LAMAR BLVD., SUITE 200E ARLINGTON, TEXAS 76010 METRO (817)467-7700  
 www.wierassociates.com  
 Texas Firm Registration No. F-2776



**LOT 3, BLOCK B**  
**ROCKWALL TECHNOLOGY PARK PHASE I**  
**COL-MET SPRAY BOOTHS**  
**PRIVATE PAVING DETAILS**



COPYRIGHT ©  
 WIER & ASSOCIATES, INC.  
 LAST SHEET EDITION  
 DATE 10/28/2015  
 WA# 14029  
**SHEET NO.**  
**C-P302**

PRINTED: 10/28/2015 5:54 AM LAST SAVED: 10/28/2015 5:54 AM FILE: PHILIPG FILE: DRAINAGE-AREA-MAP-EXISTING-14029.DWG

**DRAINAGE AREA CALCULATIONS FOR EXISTING CONDITIONS**


| DRAINAGE AREA DESIGNATION | TOTAL AREA (ACRES) | C    |      | C x A | tc (min) | I (In./Hr.)  |               |               |                | Q (cfs)      |               |               |                | REMARKS  |
|---------------------------|--------------------|------|------|-------|----------|--------------|---------------|---------------|----------------|--------------|---------------|---------------|----------------|--|
|                           |                    | 0.35 | 0.90 |       |          | 5 YEAR STORM | 10 YEAR STORM | 25 YEAR STORM | 100 YEAR STORM | 5 YEAR STORM | 10 YEAR STORM | 25 YEAR STORM | 100 YEAR STORM |  |
| A-5                       | 0.46               |      | 0.46 | 0.41  | 10       | 6.10         | 7.10          | 8.30          | 9.80           | 2.5          | 2.9           | 3.4           | 4.0            |  |
| A-8                       | 0.67               |      | 0.67 | 0.60  | 10       | 6.10         | 7.10          | 8.30          | 9.80           | 3.7          | 4.3           | 5.0           | 5.9            |  |
| C-4                       | 0.75               |      | 0.75 | 0.68  | 10       | 6.10         | 7.10          | 8.30          | 9.80           | 4.1          | 4.8           | 5.6           | 6.7            |  |
| C-6                       | 0.73               |      | 0.73 | 0.66  | 10       | 6.10         | 7.10          | 8.30          | 9.80           | 4.0          | 4.7           | 5.5           | 6.5            |  |
| C-8                       | 0.62               |      | 0.62 | 0.56  | 10       | 6.10         | 7.10          | 8.30          | 9.80           | 3.4          | 4.0           | 4.6           | 5.5            |  |
| C-10                      | 0.60               |      | 0.60 | 0.54  | 10       | 6.10         | 7.10          | 8.30          | 9.80           | 3.3          | 3.8           | 4.5           | 5.3            |  |
| G-1                       | 2.68               | 2.68 |      | 0.94  | 20       | 4.90         | 5.90          | 6.70          | 8.20           | 4.6          | 5.5           | 6.3           | 7.7            | TO BE DETAINED TO EXIST. CONDITIONS WHEN DEVELOPED |
| H-2                       | 8.45               | 8.45 |      | 2.96  | 20       | 4.90         | 5.90          | 6.70          | 8.20           | 14.5         | 17.5          | 19.8          | 24.3           | TO BE DETAINED TO EXIST. CONDITIONS WHEN DEVELOPED |
| H-3                       | 5.16               | 5.16 |      | 1.81  | 20       | 4.90         | 5.90          | 6.70          | 8.20           | 8.9          | 10.7          | 12.1          | 14.8           | TO BE DETAINED TO EXIST. CONDITIONS WHEN DEVELOPED |
| H-4                       | 5.53               | 5.53 |      | 1.94  | 20       | 4.90         | 5.90          | 6.60          | 8.30           | 9.5          | 11.4          | 12.8          | 16.1           | TO BE DETAINED TO EXIST. CONDITIONS WHEN DEVELOPED |

**LEGEND**


- DENOTES WATERSHED BOUNDARY
- DENOTES MAJOR DRAINAGE AREA DIVIDE
- DENOTES MAJOR DRAINAGE AREA SUBDIVIDE
- DRAINAGE AREA DESIGNATION DRAINAGE AREA ACRES
- DESIGN POINT
- ZONING BOUNDARY LINE
- EXISTING CONTOUR
- PROPOSED CONTOUR
- PROPOSED STORM DRAIN & INLET

**NOTE:**  
EXISTING CONDITIONS DRAINAGE AREAS AND RUNOFF RATES SHOWN PER PLANS FOR ROCKWALL TECHNOLOGY PARK PHASE IV, DATED FEBRUARY 14, 2014.


\* ALL RESPONSIBILITY FOR ADEQUACY OF DESIGN REMAINS WITH THE DESIGN ENGINEER. THE CITY OF ROCKWALL, IN REVIEWING AND RELEASING THE PLANS FOR CONSTRUCTION, ASSUMES NO RESPONSIBILITY FOR ADEQUACY OR ACCURACY OF DESIGN.\*

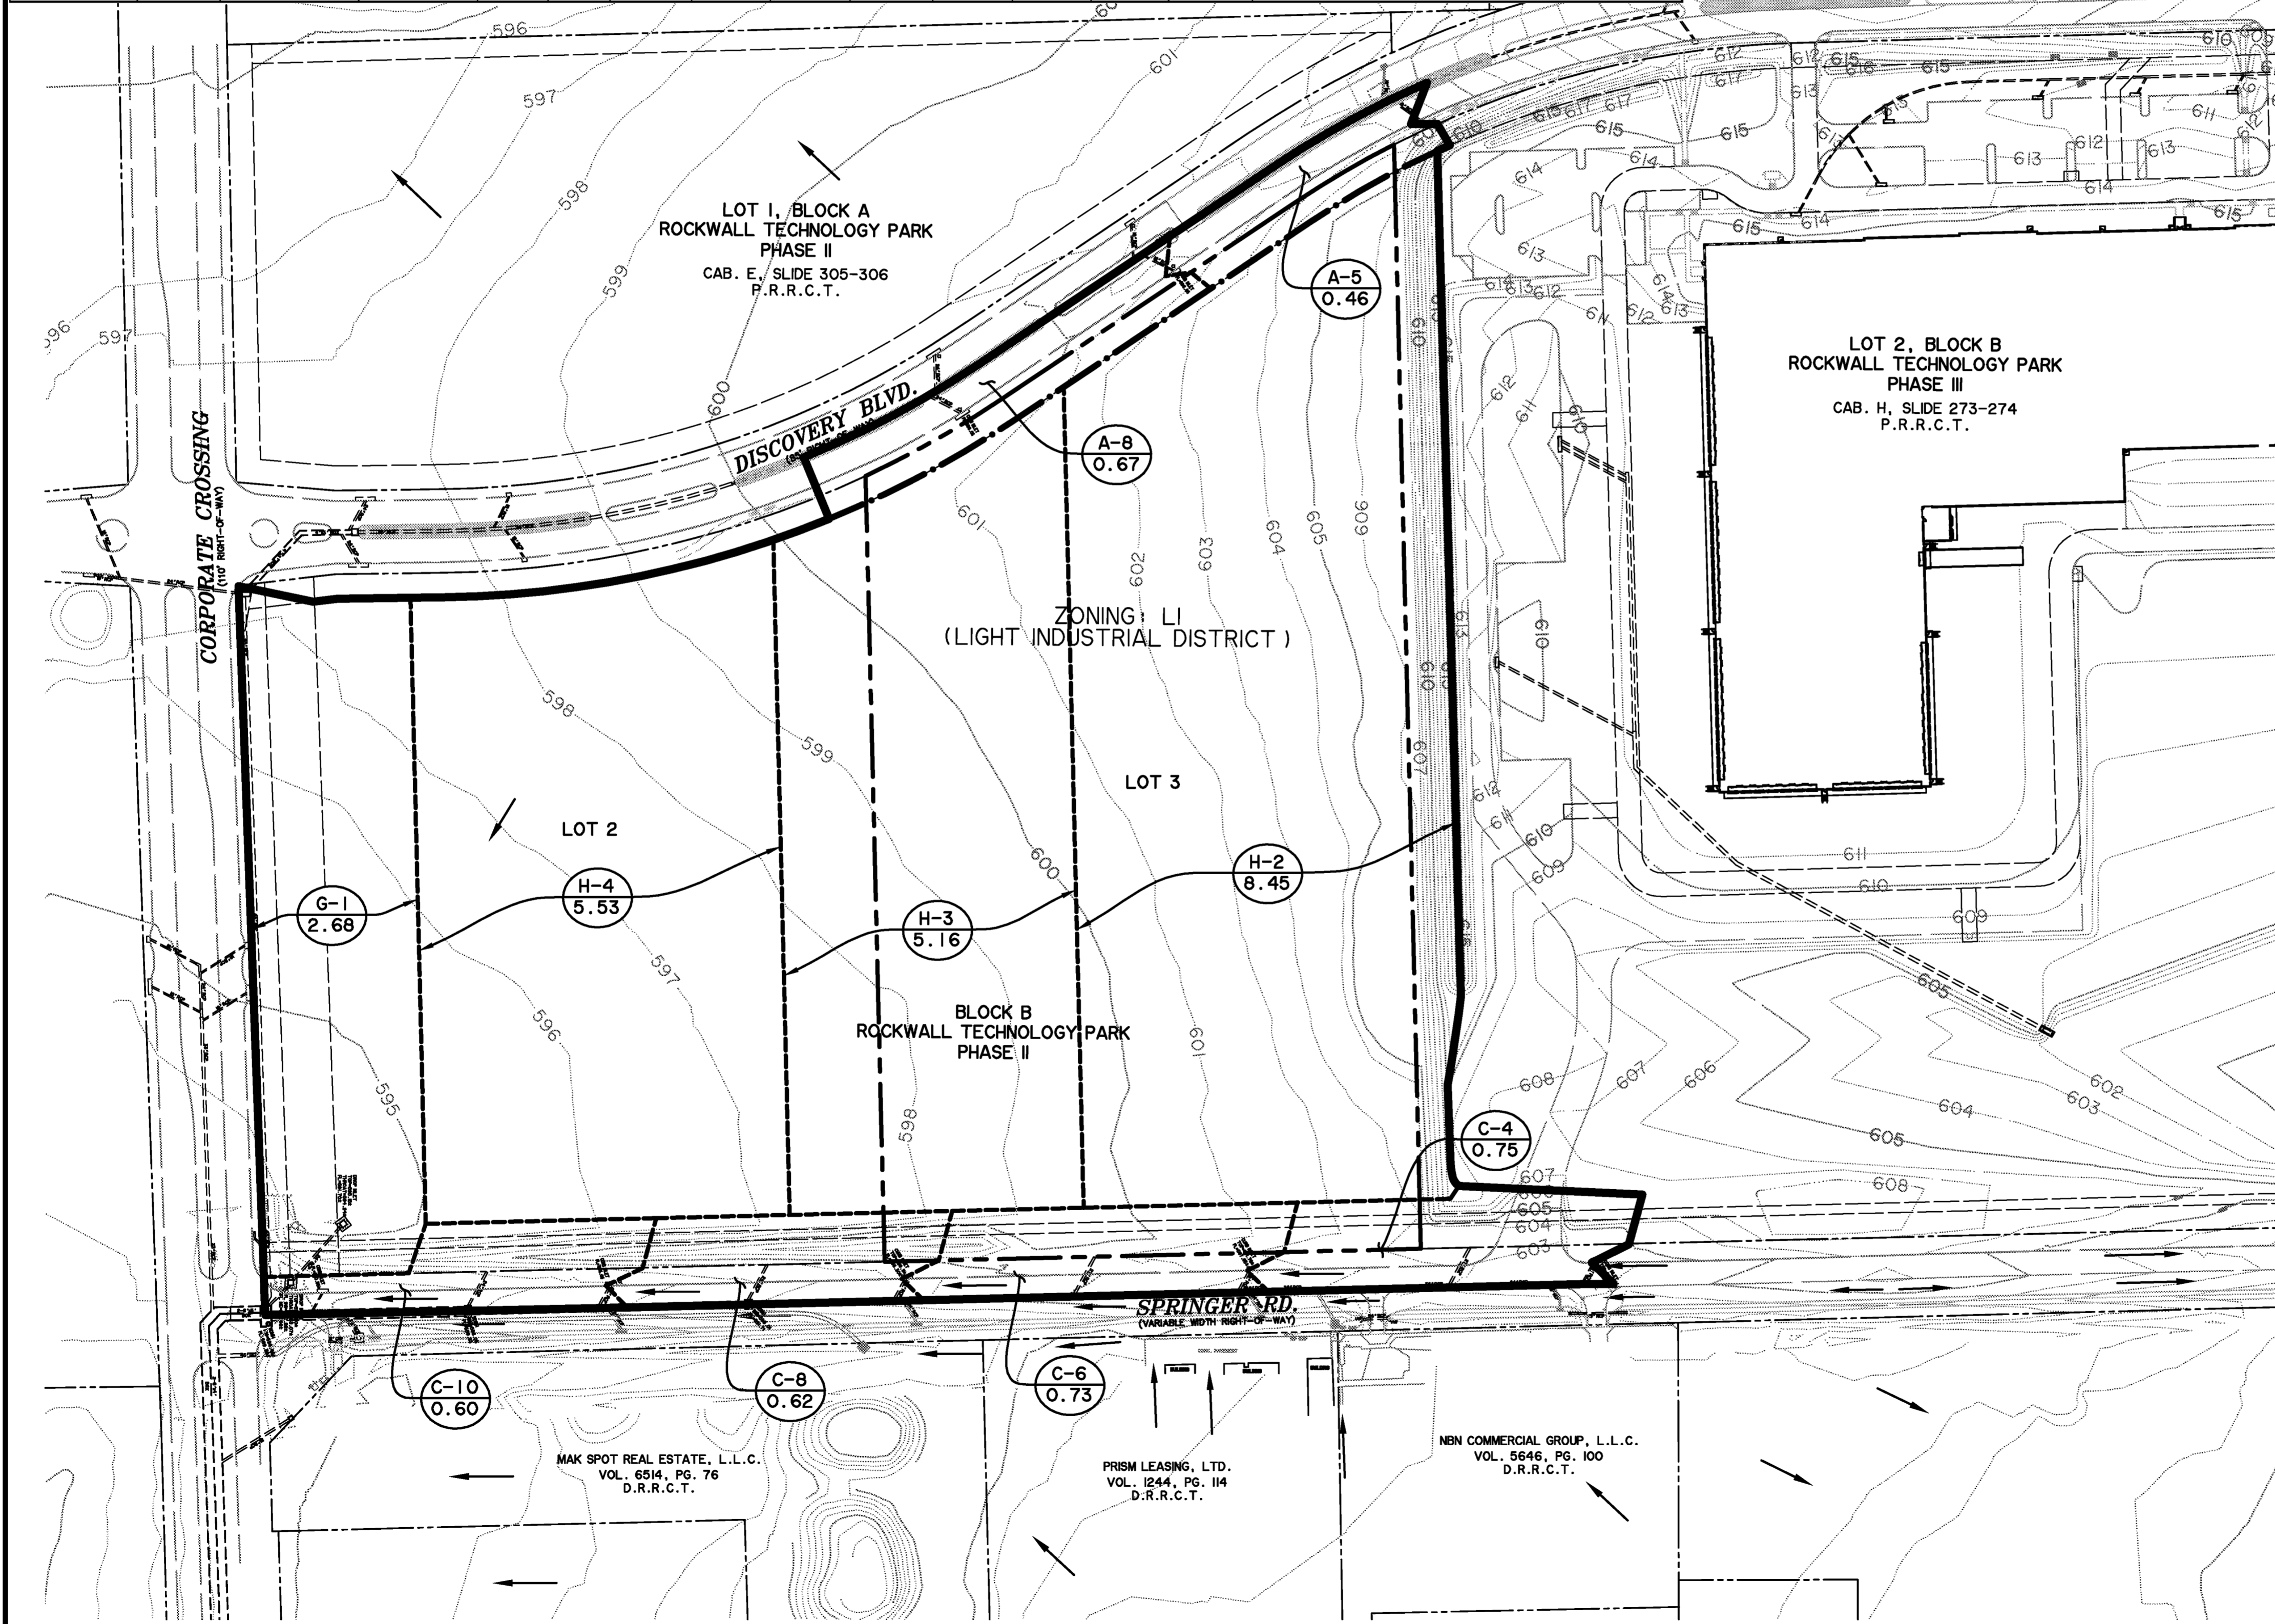

PREPARED BY:  
**WIER & ASSOCIATES, INC.**  
ENGINEERS SURVEYORS LAND PLANNERS  
2201 E. LINAR BLVD., SUITE 200E ARLINGTON, TEXAS 76006 METRO (817)467-7700  
www.wierassociates.com  
Texas Firm Registration No. F-2776

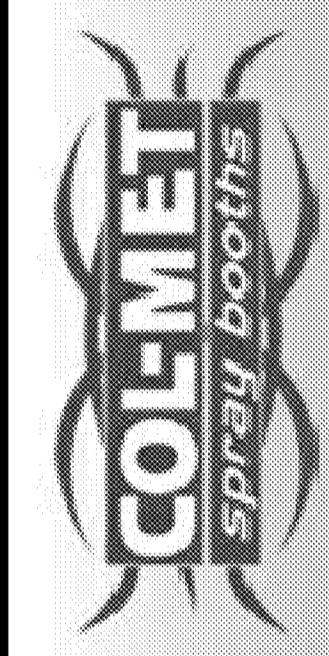

**LOT 3, BLOCK B  
ROCKWALL TECHNOLOGY PARK PHASE II  
COL-MET SPRAY BOOTHS  
EXISTING CONDITION  
DRAINAGE AREA MAP**

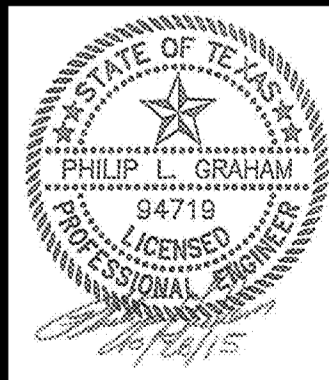

**RECORD PLANS  
October 28, 2015**




COPYRIGHT ©  
WIER & ASSOCIATES, INC.  
LAST SHEET EDIT  
DATE 10/28/2015  
WA# 14029  
**SHEET NO.  
C-D101**

PRINTED: 10/28/2015 5:53 AM LAST SAVED: 10/28/2015 5:53 AM FILE: WIER-DAMAP.STB PHILIP FILE: DRAINAGE-AREA-MAP-H029.DWG

### DRAINAGE AREA CALCULATIONS FOR DEVELOPED CONDITIONS

| DRAINAGE AREA DESIGNATION | TOTAL AREA (ACRES) | C 0.70 PARKS OPEN SPACE & FLOOD PLAIN | C 0.90 COMMERCIAL, INDUSTRIAL, MERCANTILE, RETAIL, OR RIGHT-OF-WAY | C x A | tc (min) | I (In./Hr.) 5 YEAR STORM | I (In./Hr.) 10 YEAR STORM | I (In./Hr.) 25 YEAR STORM | I (In./Hr.) 100 YEAR STORM | Q (cfs) 5 YEAR STORM | Q (cfs) 10 YEAR STORM | Q (cfs) 25 YEAR STORM | Q (cfs) 100 YEAR STORM | REMARKS  |
|---------------------------|--------------------|---------------------------------------|--|-------|----------|--------------------------|---------------------------|---------------------------|----------------------------|----------------------|-----------------------|-----------------------|------------------------|--|
| A-1                       | 1.61               | 0.18                                  | 1.43   | 1.35  | 10       | 6.10                     | 7.10                      | 8.30                      | 9.80                       | 8.2                  | 9.6                   | 11.2                  | 13.2                   | COLLECTED BY INLET A-1                             |
| A-2                       | 2.35               | 0.39                                  | 1.96   | 1.90  | 10       | 6.10                     | 7.10                      | 8.30                      | 9.80                       | 11.6                 | 13.5                  | 15.8                  | 18.6                   | COLLECTED BY INLET A-2                             |
| A-3                       | 1.08               | 0.19                                  | 0.89   | 0.87  | 10       | 6.10                     | 7.10                      | 8.30                      | 9.80                       | 5.3                  | 6.2                   | 7.2                   | 8.5                    | FLUME INTO DETENTION POND                          |
| A-4                       | 2.35               |                                       | 2.35   | 2.12  | 10       | 6.10                     | 7.10                      | 8.30                      | 9.80                       | 12.9                 | 15.1                  | 17.6                  | 20.8                   | COLLECTED BY INLET A-4                             |
| A-5                       | 1.94               |                                       | 1.94   | 1.75  | 10       | 6.10                     | 7.10                      | 8.30                      | 9.80                       | 10.7                 | 12.4                  | 14.5                  | 17.2                   | COLLECTED BY INLET A-5                             |
| A-6                       | 0.32               |                                       | 0.32   | 0.29  | 10       | 6.10                     | 7.10                      | 8.30                      | 9.80                       | 1.8                  | 2.1                   | 2.4                   | 2.8                    | FLUME INTO DETENTION POND                          |
| A-7                       | 0.39               |                                       | 0.39   | 0.35  | 10       | 6.10                     | 7.10                      | 8.30                      | 9.80                       | 2.1                  | 2.5                   | 2.9                   | 3.4                    | FLUME INTO DETENTION POND                          |
| A-8                       | 0.14               |                                       | 0.14   | 0.13  | 10       | 6.10                     | 7.10                      | 8.30                      | 9.80                       | 0.8                  | 0.9                   | 1.1                   | 1.3                    | FLUME INTO DETENTION POND                          |
| A-9                       | 0.14               |                                       | 0.14   | 0.13  | 10       | 6.10                     | 7.10                      | 8.30                      | 9.80                       | 0.8                  | 0.9                   | 1.1                   | 1.3                    | FLUME INTO DETENTION POND                          |
| A-10                      | 0.14               |                                       | 0.14   | 0.13  | 10       | 6.10                     | 7.10                      | 8.30                      | 9.80                       | 0.8                  | 0.9                   | 1.1                   | 1.3                    | FLUME INTO DETENTION POND                          |
| A-11                      | 0.23               |                                       | 0.23   | 0.21  | 10       | 6.10                     | 7.10                      | 8.30                      | 9.80                       | 1.3                  | 1.5                   | 1.7                   | 2.1                    | FLUME INTO DETENTION POND                          |
| A-12                      | 1.65               | 0.14                                  | 1.51   | 1.41  | 10       | 6.10                     | 7.10                      | 8.30                      | 9.80                       | 8.6                  | 10.0                  | 11.7                  | 13.8                   | DETENTION POND                                     |
| D.P. #1                   | 12.34              | 0.90                                  | 11.44  | 10.61 | 10       | 6.10                     | 7.10                      | 8.30                      | 9.80                       | 64.7                 | 75.3                  | 88.1                  | 104.0                  | DETENTION POND DISCHARGE POINT                     |
| OS-1a                     | 0.47               | 0.18                                  | 0.29   | 0.32  | 10       | 6.10                     | 7.10                      | 8.30                      | 9.80                       | 2.0                  | 2.3                   | 2.7                   | 3.1                    | ON-SITE AREA BYPASSING DETENTION POND              |
| OS-1b                     | 0.36               | 0.03                                  | 0.33   | 0.31  | 10       | 6.10                     | 7.10                      | 8.30                      | 9.80                       | 1.9                  | 2.2                   | 2.6                   | 3.0                    | ALTERED EXISTING CONDITION AREA "A-5". SEE NOTE 2  |
| OS-2a                     | 0.09               |                                       | 0.09   | 0.08  | 10       | 6.10                     | 7.10                      | 8.30                      | 9.80                       | 0.5                  | 0.6                   | 0.7                   | 0.8                    | ON-SITE AREA BYPASSING DETENTION POND              |
| OS-2b                     | 0.59               |                                       | 0.59   | 0.53  | 10       | 6.10                     | 7.10                      | 8.30                      | 9.80                       | 3.2                  | 3.8                   | 4.4                   | 5.2                    | ALTERED EXISTING CONDITION AREA "A-8". SEE NOTE 2  |
| OS-3                      | 0.59               |                                       | 0.59   | 0.53  | 10       | 6.10                     | 7.10                      | 8.30                      | 9.80                       | 3.2                  | 3.8                   | 4.4                   | 5.2                    | ALTERED EXISTING CONDITION AREA "C-4". SEE NOTE 2  |
| OS-4                      | 0.32               |                                       | 0.32   | 0.29  | 10       | 6.10                     | 7.10                      | 8.30                      | 9.80                       | 1.8                  | 2.1                   | 2.4                   | 2.8                    | ALTERED EXISTING CONDITION AREA "C-6". SEE NOTE 2  |
| OS-5                      | 0.55               |                                       | 0.55   | 0.50  | 10       | 6.10                     | 7.10                      | 8.30                      | 9.80                       | 3.1                  | 3.6                   | 4.2                   | 4.9                    | ALTERED EXISTING CONDITION AREA "C-8". SEE NOTE 2  |
| OS-6                      | 0.60               |                                       | 0.60   | 0.54  | 10       | 6.10                     | 7.10                      | 8.30                      | 9.80                       | 3.3                  | 3.8                   | 4.5                   | 5.3                    | ALTERED EXISTING CONDITION AREA "C-10". SEE NOTE 2 |
| OS-7                      | 2.68               | 2.68                                  |  | 0.94  | 20       | 4.90                     | 5.90                      | 6.60                      | 8.30                       | 4.6                  | 5.5                   | 6.2                   | 7.8                    | SAME AS EXISTING CONDITION AREA "G-1"              |
| OS-8                      | 1.54               | 1.54                                  |  | 0.54  | 20       | 4.90                     | 5.90                      | 6.60                      | 8.30                       | 2.6                  | 3.2                   | 3.6                   | 4.5                    | ALTERED EXISTING CONDITION AREA "H-3". SEE NOTE 2  |
| OS-9                      | 5.53               | 5.53                                  |  | 1.94  | 20       | 4.90                     | 5.90                      | 6.60                      | 8.30                       | 9.5                  | 11.4                  | 12.8                  | 16.1                   | SAME AS EXISTING CONDITION AREA "H-4"              |

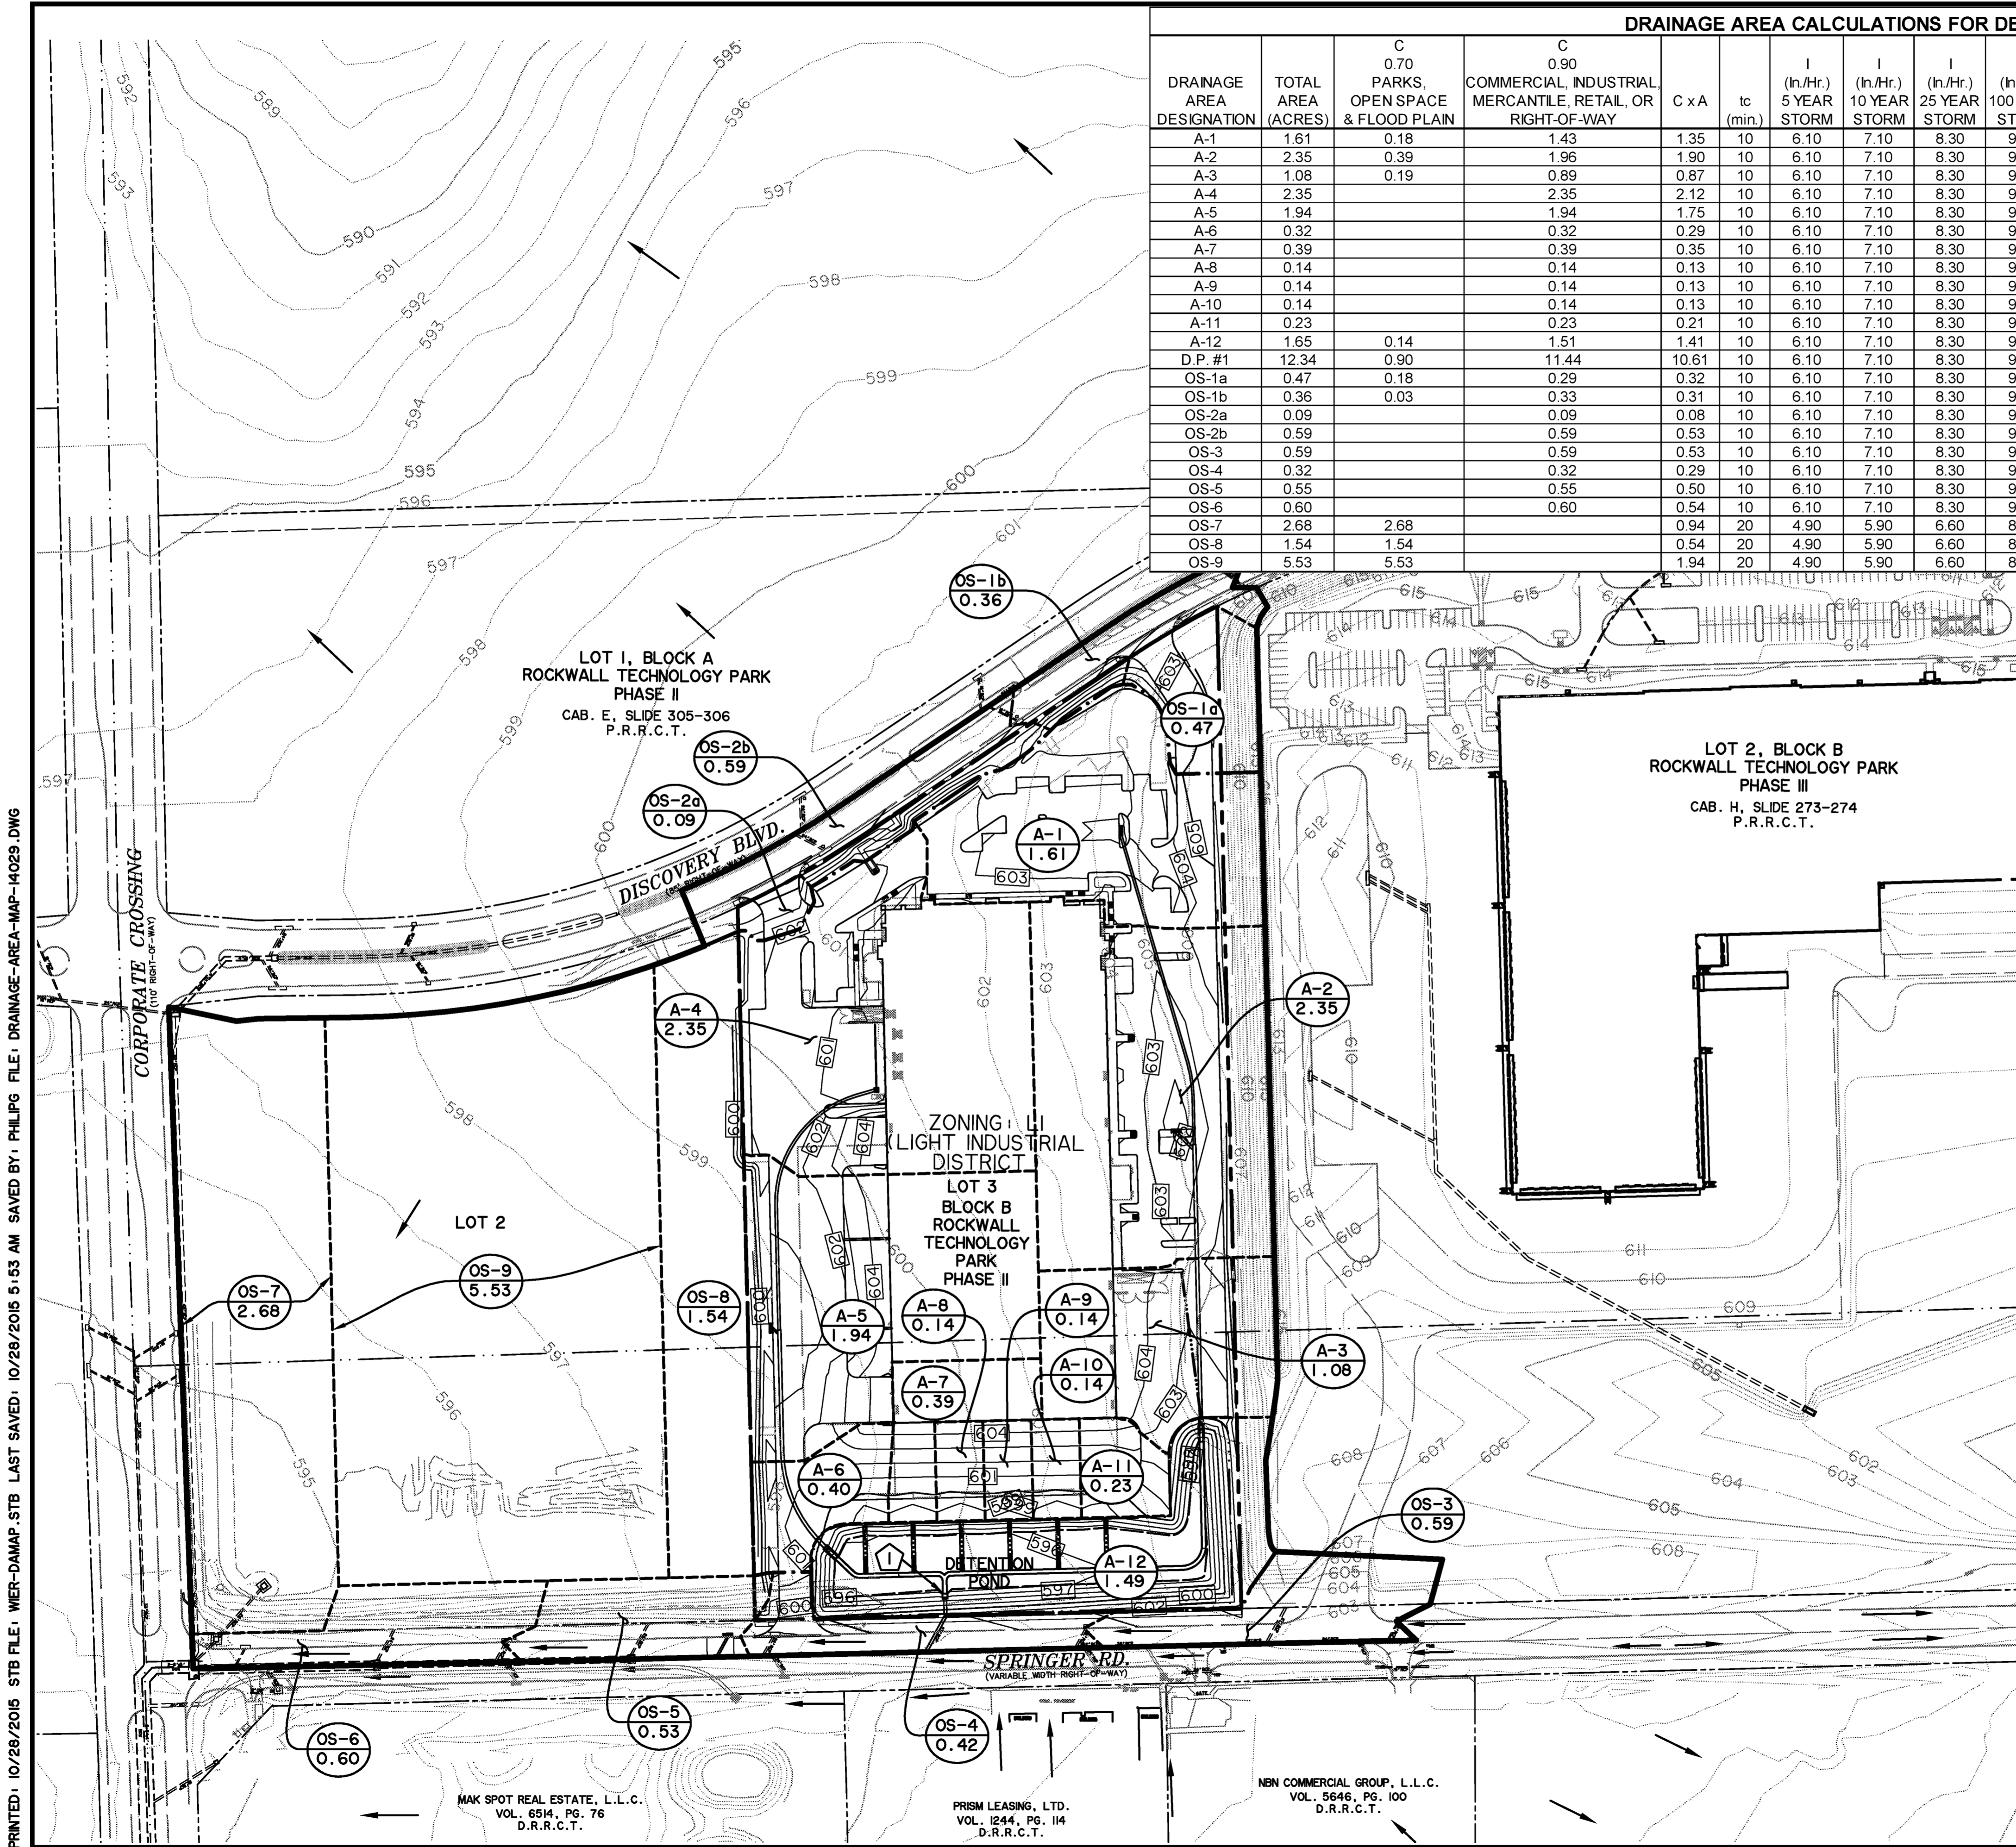

- NOTES:**
- PORTION OF DRAINAGE AREAS A-1, A-2, A-3, OS-1a & OS-1b LOCATED IN HIGH SLOPE AREA ON ADJACENT BIMBO BAKERIES LOT HAS BEEN TREATED AS PERMANENT OPEN SPACE.
  - DRAINAGE AREAS SHOWN ON PLANS FOR ROCKWALL TECHNOLOGY PARK PHASE IV DATED, FEBRUARY 2014 ALTERED BY THIS DEVELOPMENT.

#### LEGEND

- DENOTES WATERSHED BOUNDARY
- DENOTES MAJOR DRAINAGE AREA DIVIDE
- DENOTES MAJOR DRAINAGE AREA SUBDIVIDE
- DRAINAGE AREA DESIGNATION DRAINAGE AREA ACRES
- DESIGN POINT
- ZONING BOUNDARY LINE
- EXISTING CONTOUR
- PROPOSED CONTOUR
- PROPOSED STORM DRAIN & INLET


\* ALL RESPONSIBILITY FOR ADEQUACY OF DESIGN REMAINS WITH THE DESIGN ENGINEER. THE CITY OF ROCKWALL, IN REVIEWING AND RELEASING THE PLANS FOR CONSTRUCTION, ASSUMES NO RESPONSIBILITY FOR ADEQUACY OR ACCURACY OF DESIGN.\*

**RECORD PLANS**  
October 28, 2015




**CUSHMAN & WAKEFIELD**  
SCOTT + REID  
General Contractors

**WIER & ASSOCIATES, INC.**  
 ENGINEERS SURVEYORS LAND PLANNERS  
 2201 E. LAMAR BLVD., SUITE 200E ARLINGTON, TEXAS 76006 METRO (817)467-7700  
 www.wierassociates.com  
 Texas Firm Registration No. F-2776

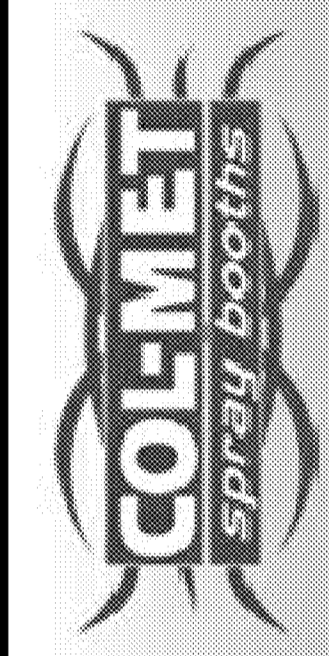

**LOT 3, BLOCK B**  
**ROCKWALL TECHNOLOGY PARK PHASE II**  
**COL-MET SPRAY BOOTHS**  
**DEVELOPED CONDITIONS**  
**DRAINAGE AREA MAP**

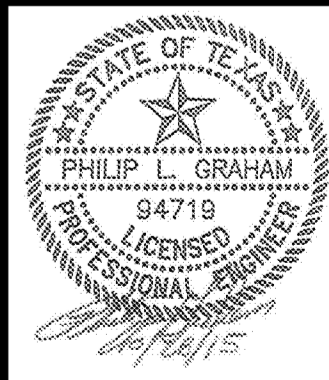


COPYRIGHT ©  
 WIER & ASSOCIATES, INC.  
 DATE 10/28/2015  
 WA# 14029  
**SHEET NO.**  
**C-D102**

PRINTED: 10/28/2015 5TB FILE: WIER-STORM DRAIN.STB LAST SAVED: 10/28/2015 6:15 AM SAVED BY: PHILIP FILE: STORM-DRAIN-DESIGN-CALCULATIONS-14029.DWG


| INLET DESIGN CALCULATIONS |               |                                |                      |                              |                       |                  |                               |                  |                         |                  |                |                                     |                    |                   |              |                |                  |   |
|---------------------------|---------------|--------------------------------|----------------------|------------------------------|-----------------------|------------------|-------------------------------|------------------|-------------------------|------------------|----------------|-------------------------------------|--------------------|-------------------|--------------|----------------|------------------|---|
| INLET No.                 | DISCHARGES TO | DESIGN STORM FREQUENCY (years) | TIME OF CONC. (min.) | RAINFALL INTENSITY (in./hr.) | DRAINAGE AREA (acres) | DRAINAGE AREA CA | FLOW FROM DRAINAGE AREA (cfs) | CARRY-OVER (cfs) | TOTAL GUTTER FLOW (cfs) | GUTTER SLOPE (%) | STREET SECTION | CROSS-SLOPE OR CROWN (ft/ft OR in.) | DEPTH OF FLOW (ft) | PONDED WIDTH (ft) | INLET LENGTH | FLOW COLLECTED | CARRY-OVER (cfs) | REMARKS   |
| A-1                       | LINE A        | 100                            | 10                   | 9.80                         | 1.61                  | 1.35             | 13.2                          | 0.0              | 13.2                    | SUMP             | PARKING LOT    | 0.0200                              | 0.26               | 13.0              | 10'          | 13.2           | 0.0              |   |
| A-2                       | LAT. A-2      | 100                            | 10                   | 9.80                         | 2.35                  | 1.90             | 18.6                          | 0.0              | 18.6                    | SUMP             | PARKING LOT    | 0.0350                              | 0.28               | 8.0               | 10'          | 18.6           | 0.0              |   |
| A-4                       | LAT. A-4      | 100                            | 10                   | 9.80                         | 2.35                  | 2.12             | 20.8                          | 0.0              | 20.8                    | SUMP             | PARKING LOT    | 0.0100                              | 0.13               | 13.0              | N/A          | 20.8           | 0.0              | TRUCK COURT TRENCH DRAIN                              |
| A-5                       | LAT. A-5      | 100                            | 10                   | 9.80                         | 1.94                  | 1.75             | 17.2                          | 0.0              | 17.2                    | SUMP             | PARKING LOT    | 0.0100                              | 0.41               | 41.0              | 10'          | 17.2           | 0.0              |   |
| OS-1b                     | -             | 100                            | 10                   | 9.80                         | 0.83                  | 0.63             | 6.1                           | 1.1              | 7.2                     | 0.78             | TRIANGULAR     | 6"                                  | 0.32               | 15.4              | 10'          | 5.5            | 1.7              | EXISTING ROCKWALL TECHNOLOGY PARK PHASE IV INLET A-5  |
| OS-2b                     | -             | 100                            | 10                   | 9.80                         | 0.68                  | 0.61             | 6.0                           | 1.7              | 7.7                     | 0.70             | TRIANGULAR     | 6"                                  | 0.15               | 7.2               | 10'          | 7.7            | 0.0              | EXISTING ROCKWALL TECHNOLOGY PARK PHASE IV INLET A-8  |
| OS-3                      | -             | 100                            | 10                   | 9.80                         | 0.59                  | 0.53             | 5.2                           | 1.5              | 6.7                     | 0.70             | TRIANGULAR     | 6"                                  | 0.34               | 16.3              | 5'           | 2.7            | 4.0              | EXISTING ROCKWALL TECHNOLOGY PARK PHASE IV INLET C-4  |
| OS-4                      | -             | 100                            | 10                   | 9.80                         | 0.32                  | 0.29             | 2.8                           | 4.0              | 6.8                     | 0.70             | TRIANGULAR     | 6"                                  | 0.34               | 16.3              | 10'          | 6.0            | 0.8              | EXISTING ROCKWALL TECHNOLOGY PARK PHASE IV INLET C-6  |
| OS-5                      | -             | 100                            | 10                   | 9.80                         | 0.55                  | 0.50             | 4.9                           | 0.8              | 5.7                     | 0.70             | TRIANGULAR     | 6"                                  | 0.32               | 15.4              | 10'          | 5.7            | 0.0              | EXISTING ROCKWALL TECHNOLOGY PARK PHASE IV INLET C-8  |
| OS-6                      | -             | 100                            | 10                   | 9.80                         | 0.60                  | 0.54             | 5.3                           | 0.0              | 5.3                     | SUMP             | TRIANGULAR     | 6"                                  | 0.10               | 4.8               | 10'          | 5.3            | 0.0              | EXISTING ROCKWALL TECHNOLOGY PARK PHASE IV INLET C-10 |

| STORM DRAIN DESIGN CALCULATIONS |                |                             |---------------------------------|----------------|-----------------------------|-----------|------|------------------|------|------------|---------------------------------|-----------------------------|--------------------------------|----------------------|------------------|-------------------|------------------------------------|----------------------------|--|--------------------------|-----------------------------------|---|---------|
| FROM                            | REACH TO       | INFLOW (INLETS & HEADWALLS) |           |      |                  |      | TOTAL 'CA' | TIME AT UPSTREAM OF REACH (min) | DESIGN STORM FREQUENCY (yr) | RAINFALL INTENSITY 'I' (in/hr) | TOTAL FLOW 'Q' (cfs) | STORM DRAIN SIZE | VELOCITY (ft/sec) | SLOPE OF FRICTION GRADIENT (ft/ft) | STRUCTURE LOSS COEFF. 'Kj' | STRUCTURE LOSS AT UPSTREAM OF REACH (ft) | FLOW TIME IN DRAIN (min) | TIME AT DOWNSTREAM OF REACH (min) | H.G. AT UPSTREAM OF REACH (ft)  | REMARKS |
|                                 |                | LENGTH (ft)                 | SOURCE    | 'CA' | INLET TIME (min) | 'CA' |            |                                 |                             |                                |                      |                  |                   |                                    |                            |  |                          |                                   |   |         |
| STORM DRAIN LINE "A"            |                |                             | INLET A-1                       | 12+75.00       | 27.65                       | INLET A-1 | 1.35 | 10.0             | 1.35 | 10.0       | 100                             | 9.80                        | 13.2                           | 27                   | 3.3              | 0.0018            | 1.25                               | 0.21                       | 0.1                                      | 10.1                     | 600.53                            |   |         |
| 12+75.00                        | 9+38.72        | 336.28                      |           | 0.00 | 0.0              | 1.35 | 10.1       | 100                             | 9.78                        | 13.2                           | 27                   | 3.3              | 0.0018            | 0.00                               | 0.00                       | 1.7                                      | 11.8                     | 600.27                            |   |         |
| INLET A-2                       | 9+38.72        | 28.17                       | INLET A-2 | 1.90 | 10.0             | 1.90 | 10.0       | 100                             | 9.80                        | 18.6                           | 30                   | 3.8              | 0.0021            | 1.25                               | 0.28                       | 0.1                                      | 10.1                     | 600.00                            |   |         |
| 9+38.72                         | 6+26.50        | 312.22                      |           | 0.00 | 0.0              | 3.25 | 11.8       | 100                             | 9.47                        | 30.8                           | 42                   | 3.2              | 0.0009            | 0.40                               | 0.09                       | 1.6                                      | 13.4                     | 599.66                            | BEGINNING H.G.=598.98 DETENTION POND 100 YEAR W.S.                                    |         |
| STORM DRAIN LINE "A-4"          |                |                             | INLET A-4                       | 4+01.94        | 330.00                      | INLET A-4 | 2.12 | 10.0             | 2.12 | 10.0       | 100                             | 9.80                        | 20.8                           | 33                   | 3.5              | 0.0015            | 1.25                               | 0.24                       | 1.6                                      | 11.6                     | 600.20                            |   |         |
| INLET A-5                       | 4+01.94        | 10.61                       | INLET A-5 | 1.75 | 10.0             | 1.75 | 10.0       | 100                             | 9.80                        | 17.2                           | 24                   | 5.5              | 0.0058            | 1.25                               | 0.59                       | 0.0                                      | 10.0                     | 600.11                            |   |         |
| 4+01.94                         | 1+47.50        | 254.44                      |           | 0.00 | 0.0              | 3.87 | 11.6       | 100                             | 9.50                        | 36.8                           | 42                   | 3.8              | 0.0013            | 0.40                               | 0.15                       | 1.2                                      | 12.8                     | 599.46                            | BEGINNING H.G.=598.98 DETENTION POND 100 YEAR W.S.                                    |         |
| DETENTION POND DISCHARGE LINE   |                |                             | POND                            | 1+00 (9+33.52) | 65.60                       | POND      | -    | -                | -    | -          | 100                             | -                           | 33.6                           | 36                   | 4.8              | 0.0025            | 1.25                               | 0.44                       | 0.2                                      | -                        | 598.63                            | BEGINNING H.G = 598.03 PER RE-ANALYSIS OF ROCKWALL TECHNOLOGY PARK STORM DRAIN SYSTEM |         |

PREPARED BY:  
**WIER & ASSOCIATES, INC.**  
**ENGINEERS SURVEYORS LAND PLANNERS**  
 2201 E. LAMAR BLVD., SUITE 200E ARLINGTON, TEXAS 76006 METRO (817)467-7700  
 Texas Firm Registration No. F-2776 www.wierassociates.com

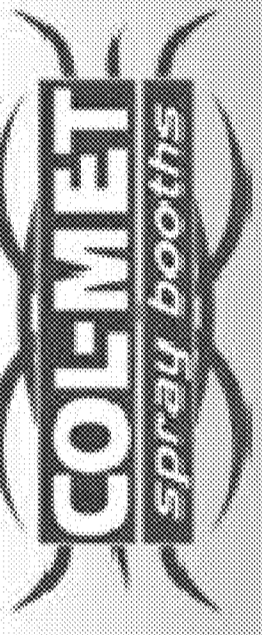

LOT 3, BLOCK B  
 ROCKWALL TECHNOLOGY PARK PHASE I  
 COL-MET SPRAY BOOTHS  
 INLET & STORM DRAIN  
 DESIGN CALCULATIONS

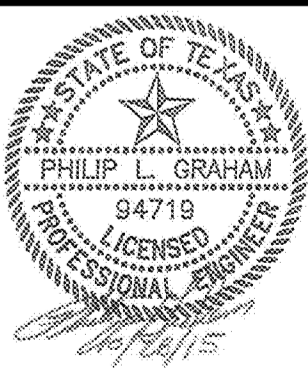

**CUSHMAN & WAKEFIELD**  
**SCOTT + REID**  
 General Contractors

**RECORD PLANS**  
**October 28, 2015**


COPYRIGHT ©  
 WIER & ASSOCIATES, INC.  
 LAST SHEET EDIT  
 DATE 10/28/2015  
 WA# 14029  
**SHEET NO.**  
**C-D103**

| REVISIONS  | DATE     | BY  |
|--|----------|-----|
| △ ADDED DRIVE CONNECTION, INLET & STORM DRAIN RELOCATION | 03/19/15 | PLG |

SEE SHEET C-D105

JOHN H. B. JONES SURVEY  
ABSTRACT NO. 125  
FFE = 605.00

JOHN A. RAMSEY SURVEY  
ABSTRACT NO. 186

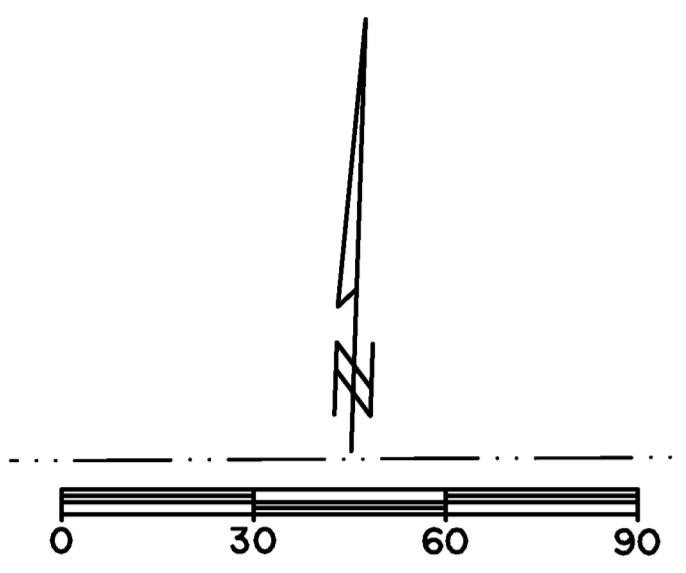


LOT 2, BLOCK B  
ROCKWALL ECONOMIC DEVELOPMENT CORPORATION  
VOL. 2224, PAGE 226  
D.R.R.C.T.

LOT 3, BLOCK B  
ZONING: LI (LIGHT INDUSTRIAL DISTRICT)  
ROCKWALL ECONOMIC DEVELOPMENT CORPORATION  
VOL. 2224, PAGE 226  
D.R.R.C.T.

ROCKWALL TECHNOLOGY PARK PHASE II  
CAB. E, SLIDE 305-306  
P.R.R.C.T.

LOT 2, BLOCK B  
ROCKWALL TECHNOLOGY PARK PHASE III  
CAB. H, SLIDE 273-274  
P.R.R.C.T.

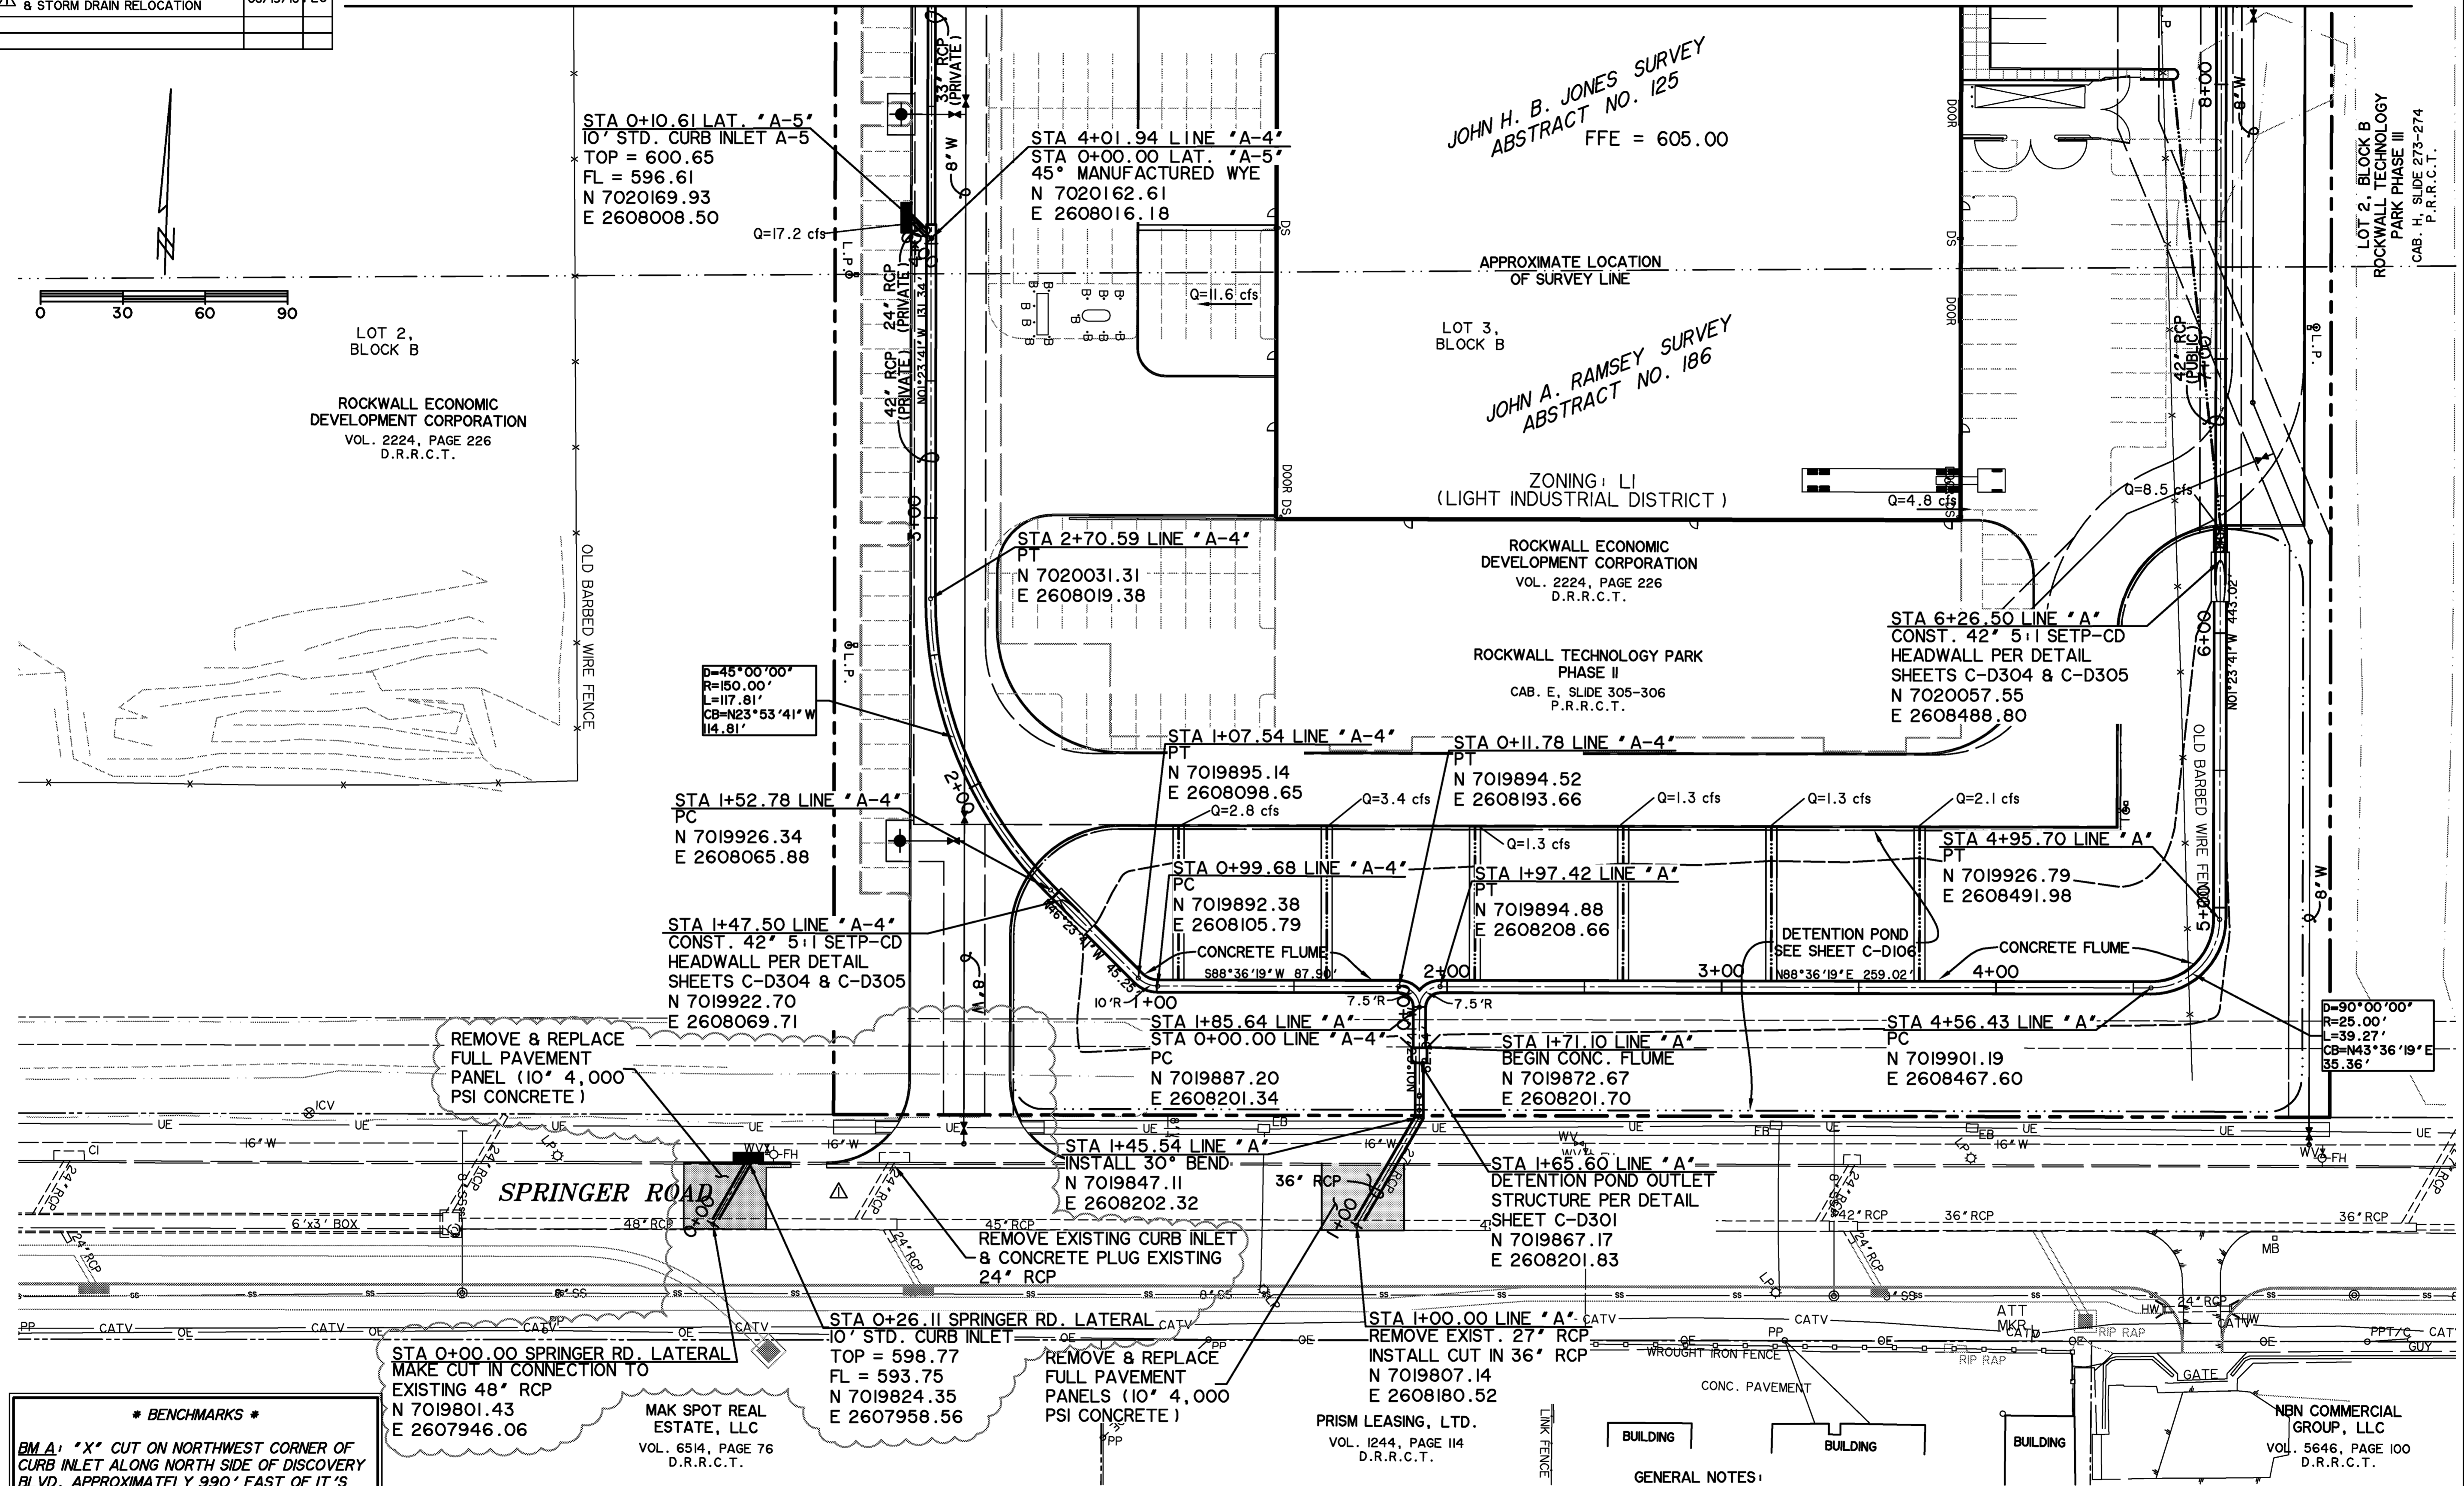

REMOVE & REPLACE FULL PAVEMENT PANEL (10' x 4,000 PSI CONCRETE)

REMOVE EXISTING CURB INLET & CONCRETE PLUG EXISTING 24" RCP

REMOVE & REPLACE FULL PAVEMENT PANELS (10' x 4,000 PSI CONCRETE)

STA 0+00.00 SPRINGER RD. LATERAL 10' STD. CURB INLET  
TOP = 598.77  
FL = 593.75  
N 7019801.43  
E 2607946.06

STA 0+26.11 SPRINGER RD. LATERAL 10' STD. CURB INLET  
TOP = 598.77  
FL = 593.75  
N 7019824.35  
E 2607958.56

STA 1+00.00 LINE 'A' CATV REMOVE EXIST. 27" RCP  
INSTALL CUT IN 36" RCP  
N 7019807.14  
E 2608180.52

**\* BENCHMARKS \***  
BM A: "X" CUT ON NORTHWEST CORNER OF CURB INLET ALONG NORTH SIDE OF DISCOVERY BLVD. APPROXIMATELY 990' EAST OF IT'S INTERSECTION WITH F.M. 549.  
601.19 FT.  
BM B: "X" CUT IN BOX IN THE CONCRETE AROUND A WATER VALVE ON THE BACK OF CURB ALONG THE NORTH SIDE OF SPRINGER RD. APPROXIMATELY 921' EAST OF IT'S INTERSECTION WITH F.M. 549.  
600.75 FT.

" ALL RESPONSIBILITY FOR ADEQUACY OF DESIGN REMAINS WITH THE DESIGN ENGINEER. THE CITY OF ROCKWALL, IN REVIEWING AND RELEASING THE PLANS FOR CONSTRUCTION, ASSUMES NO RESPONSIBILITY FOR ADEQUACY OR ACCURACY OF DESIGN."


**CAUTION !!**  
EXISTING UTILITIES ARE INDICATED ON THE PLANS FROM AVAILABLE INFORMATION. IT SHALL BE THE RESPONSIBILITY OF THE CONTRACTOR TO VERIFY THE LOCATION OF ALL UTILITIES, TO NOTIFY ALL UTILITY COMPANIES OF THE CONTRACTORS OPERATIONS, TO PROTECT ALL UTILITIES FROM DAMAGE, TO REPAIR ALL UTILITIES DAMAGED DUE TO THE CONTRACTORS OPERATIONS, AND TO NOTIFY THE ENGINEER PROMPTLY OF ALL CONFLICTS OF THE WORK WITH EXISTING UTILITIES.

- GENERAL NOTES:**
- SEE SHEET C-5001 FOR STORM DRAIN LEGEND.
  - ALL STORM DRAIN LINE "A" IS A PUBLIC LINE INCLUDING LATERAL/INLETS "A-2".
  - STORM DRAIN LINE "A-4" IS PRIVATE AND TO BE MAINTAINED / REPAIRED BY PROPERTY OWNER.
  - DETENTION POND IS TO BE MAINTAINED BY PROPERTY OWNER.


**RECORD PLANS**  
October 28, 2015



PREPARED BY:  
**WIER & ASSOCIATES, INC.**  
ENGINEERS SURVEYORS LAND PLANNERS  
2201 E. LAMAR BLVD., SUITE 200E ARLINGTON, TEXAS 76006 METRO (817) 467-7700  
Texas Firm Registration No. F-2776 www.wierassociates.com

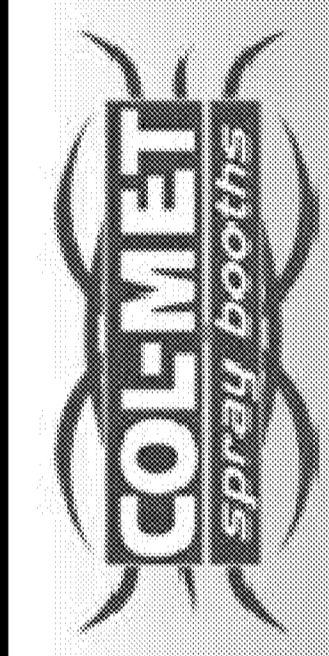


**LOT 3, BLOCK B**  
**ROCKWALL TECHNOLOGY PARK PHASE II**  
**COL-MET SPRAY BOOTHS**  
**STORM DRAIN LAYOUT**  
SOUTH

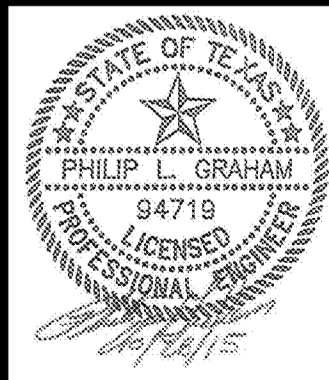

COPYRIGHT ©  
WIER & ASSOCIATES, INC.  
LAST SHEET EDITION  
DATE 10/28/2015  
WA# 14029  
**SHEET NO.**  
C-D104

PRINTED: 10/28/2015 10:28:20 AM STB FILE: WIER-STORM DRAIN-STB LAST SAVED: 10/28/2015 6:26 AM SAVED BY: PHILIP G. STORM DRAIN-PLAN-I-14029.DWG

PRINTED: 10/28/2015 6:28 AM. STB FILE: WIER-STORM DRAIN, STB LAST SAVED: 10/28/2015 6:28 AM. SAVED BY: PHILIP FILE: STORM DRAIN-PLAN-2-14029.DWG

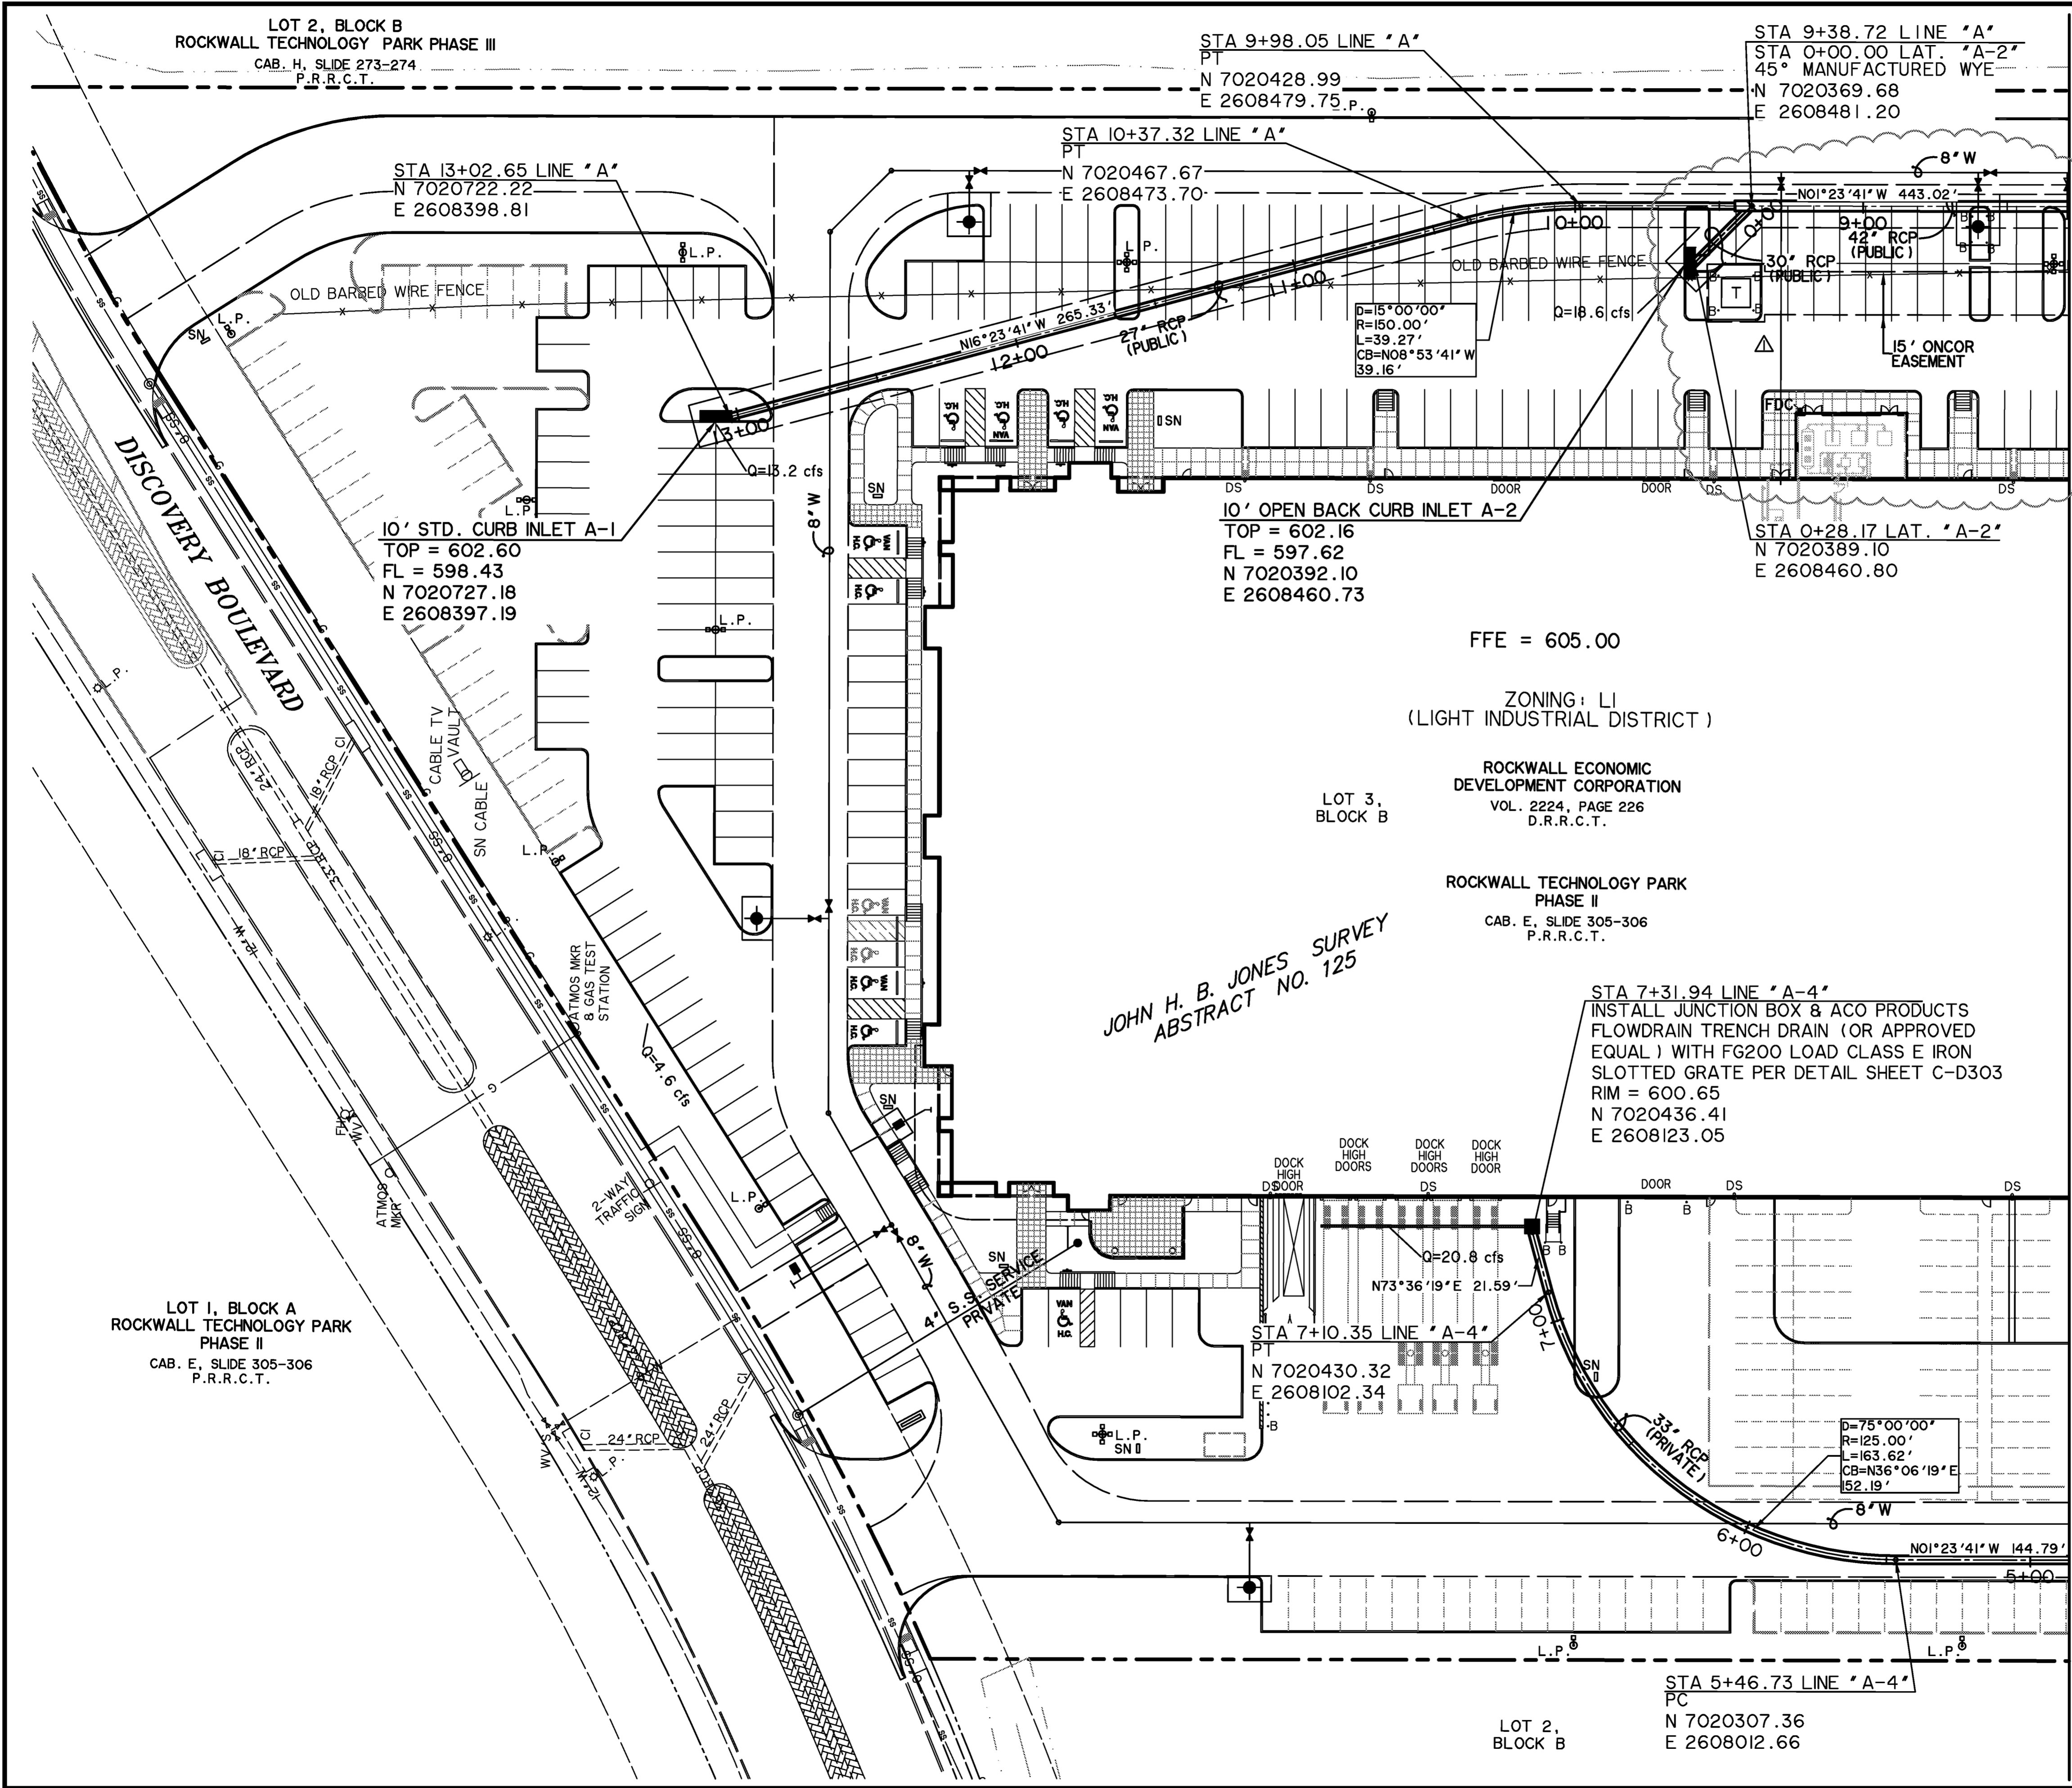

**CAUTION !!!**  
 EXISTING UTILITIES ARE INDICATED ON THE PLANS FROM AVAILABLE INFORMATION. IT SHALL BE THE RESPONSIBILITY OF THE CONTRACTOR TO VERIFY THE LOCATION OF ALL UTILITIES, TO NOTIFY ALL UTILITY COMPANIES OF THE CONTRACTORS OPERATIONS, TO PROTECT ALL UTILITIES FROM DAMAGE, TO REPAIR ALL UTILITIES DAMAGED DUE TO THE CONTRACTORS OPERATIONS, AND TO NOTIFY THE ENGINEER PROMPTLY OF ALL CONFLICTS OF THE WORK WITH EXISTING UTILITIES.

**\* BENCHMARKS \***  
**BM A:** "X" CUT ON NORTHWEST CORNER OF CURB INLET ALONG NORTH SIDE OF DISCOVERY BLVD. APPROXIMATELY 990' EAST OF IT'S INTERSECTION WITH F.M. 549. 601.19 FT.  
**BM B:** "X" CUT IN BOX IN THE CONCRETE AROUND A WATER VALVE ON THE BACK OF CURB ALONG THE NORTH SIDE OF SPRINGER RD. APPROXIMATELY 921' EAST OF IT'S INTERSECTION WITH F.M. 549. 600.75 FT.

- GENERAL NOTES:**
- SEE SHEET C-5001 FOR STORM DRAIN LEGEND.
  - ALL STORM DRAIN LINE "A" IS A PUBLIC LINE (INCLUDING LATERAL/INLET "A-2").
  - STORM DRAIN LATERAL "A-4" IS PRIVATE AND TO BE MAINTAINED / REPAIRED BY PROPERTY OWNER.

SEE SHEET C-D104

"ALL RESPONSIBILITY FOR ADEQUACY OF DESIGN REMAINS WITH THE DESIGN ENGINEER. THE CITY OF ROCKWALL, IN REVIEWING AND RELEASING THE PLANS FOR CONSTRUCTION, ASSUMES NO RESPONSIBILITY FOR ADEQUACY OR ACCURACY OF DESIGN."

| REVISIONS  | DATE     | BY  |
|--|----------|-----|
| RETAINING WALL, PAVEMENT, WATER LINE, & ONCOR EASEMENT | 01/27/15 | TVW |


**RECORD PLANS**  
 October 28, 2015

Scale: 0 30 60 90

**CUSHMAN & WAKEFIELD**

**SCOTT + REID**  
 General Contractors

PREPARED BY:  
**WIER & ASSOCIATES, INC.**  
**ENGINEERS SURVEYORS LAND PLANNERS**  
 2201 E. LINAR BLVD., SUITE 200E ARLINGTON, TEXAS 76010 METRO (817)467-7700  
 Texas Firm Registration No. F-2776 www.wierassociates.com

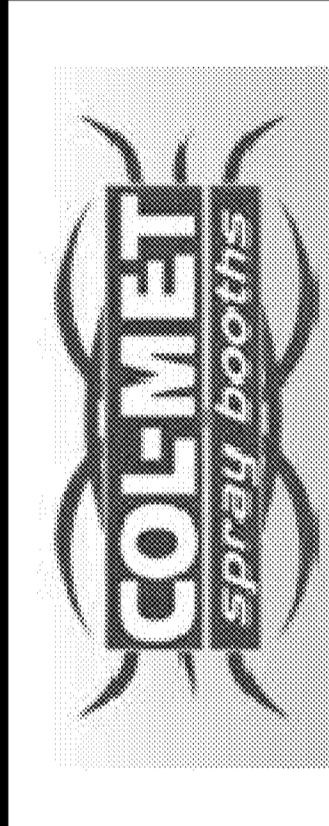

**LOT 3, BLOCK B**  
**ROCKWALL TECHNOLOGY PARK PHASE II**  
**COL-MET SPRAY BOOTHS**  
**STORM DRAIN LAYOUT**  
 NORTH



COPYRIGHT ©  
 WIER & ASSOCIATES, INC.  
 LAST SHEET FILED  
 DATE 10/28/2015  
 WA# 14029  
**SHEET NO.**  
**C-D105**

**\* BENCHMARKS \***

**BM A:** "X" CUT ON NORTHWEST CORNER OF CURB INLET ALONG NORTH SIDE OF DISCOVERY BLVD. APPROXIMATELY 990' EAST OF IT'S INTERSECTION WITH F.M. 549. 601.19 FT.



**BM B:** "X" CUT IN BOX IN THE CONCRETE AROUND A WATER VALVE ON THE BACK OF CURB ALONG THE NORTH SIDE OF SPRINGER RD. APPROXIMATELY 921' EAST OF IT'S INTERSECTION WITH F.M. 549. 600.75 FT.



**NOTES:**

1. REVEGETATE ALL DISTURBED AREAS AROUND DETENTION POND BY HYDRO-MULCH SEEDING WITH BERMUDA GRASS. PLACE 6" TOPSOIL PRIOR TO RE-VEGETATION.
2. SEE SHEET C-D301 FOR CALCULATIONS.
3. DETENTION POND SUBGRADE SHALL BE SCARIFIED TO A MINIMUM DEPTH OF 8" AND RECOMPACTED (RE-PROCESSED) TO A MINIMUM 95% ASTM D698 AT A MOISTURE CONTENT BETWEEN +2% TO +5% OF OPTIMUM. LINER MATERIALS SHALL BE PROCESSED SUCH THAT THE LARGEST PARTICLE OR CLOD IS LESS THAN 3 INCHES PRIOR TO COMPACTION.
4. DETENTION POND TO BE INSTALLED AND SHALL HAVE BOTTOM EITHER SODDED OR HAVE ANCHORED SEEDED CURLEX BLANKET PRIOR TO ANY PAVING INCLUDING SLAB.


**CAUTION !!**

EXISTING UTILITIES ARE INDICATED ON THE PLANS FROM AVAILABLE INFORMATION. IT SHALL BE THE RESPONSIBILITY OF THE CONTRACTOR TO VERIFY THE LOCATION OF ALL UTILITIES, TO NOTIFY ALL UTILITY COMPANIES OF THE CONTRACTORS OPERATIONS, TO PROTECT ALL UTILITIES FROM DAMAGE, TO REPAIR ALL UTILITIES DAMAGED DUE TO THE CONTRACTORS OPERATIONS, AND TO NOTIFY THE ENGINEER PROMPTLY OF ALL CONFLICTS OF THE WORK WITH EXISTING UTILITIES.

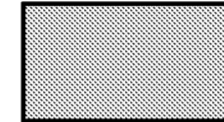
-  CONCRETE PILOT CHANNEL
-  HYDROMULCH SEED AND TOP SOIL

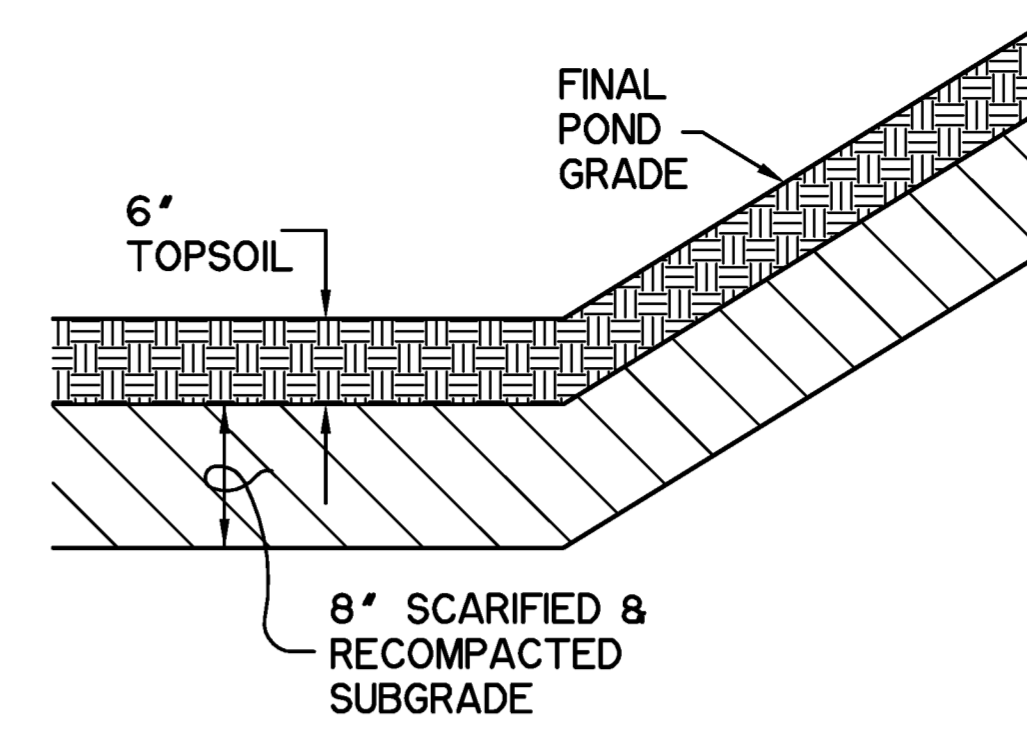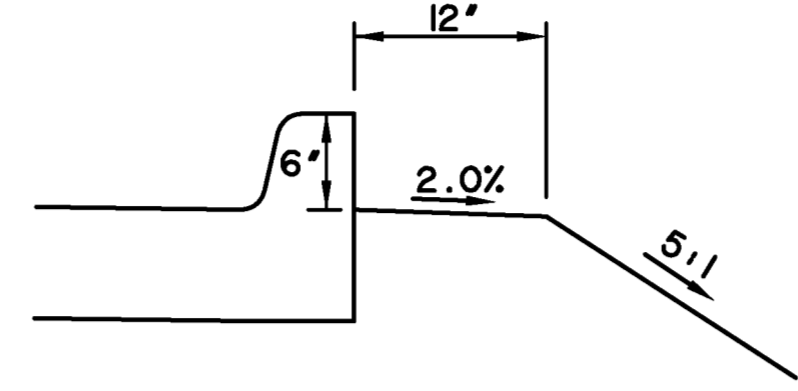

| REVISIONS                             | DATE     | BY  |
|---------------------------------------|----------|-----|
| REVISD ROCK RIPRAP TO CONCRETE SWALES | 02/11/15 | PLG |
| ADDED DRIVE & REVISED GRADING         | 03/19/15 | PLG |

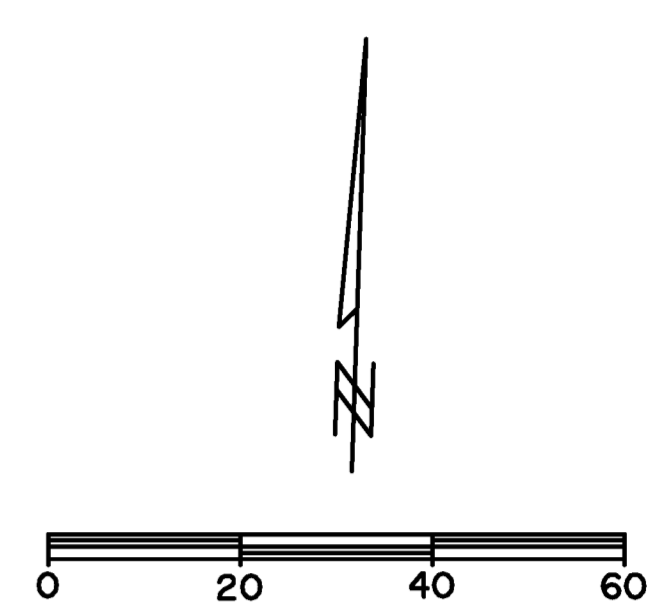

\* ALL RESPONSIBILITY FOR ADEQUACY OF DESIGN REMAINS WITH THE DESIGN ENGINEER. THE CITY OF ROCKWALL, IN REVIEWING AND RELEASING THE PLANS FOR CONSTRUCTION, ASSUMES NO RESPONSIBILITY FOR ADEQUACY OR ACCURACY OF DESIGN.\*

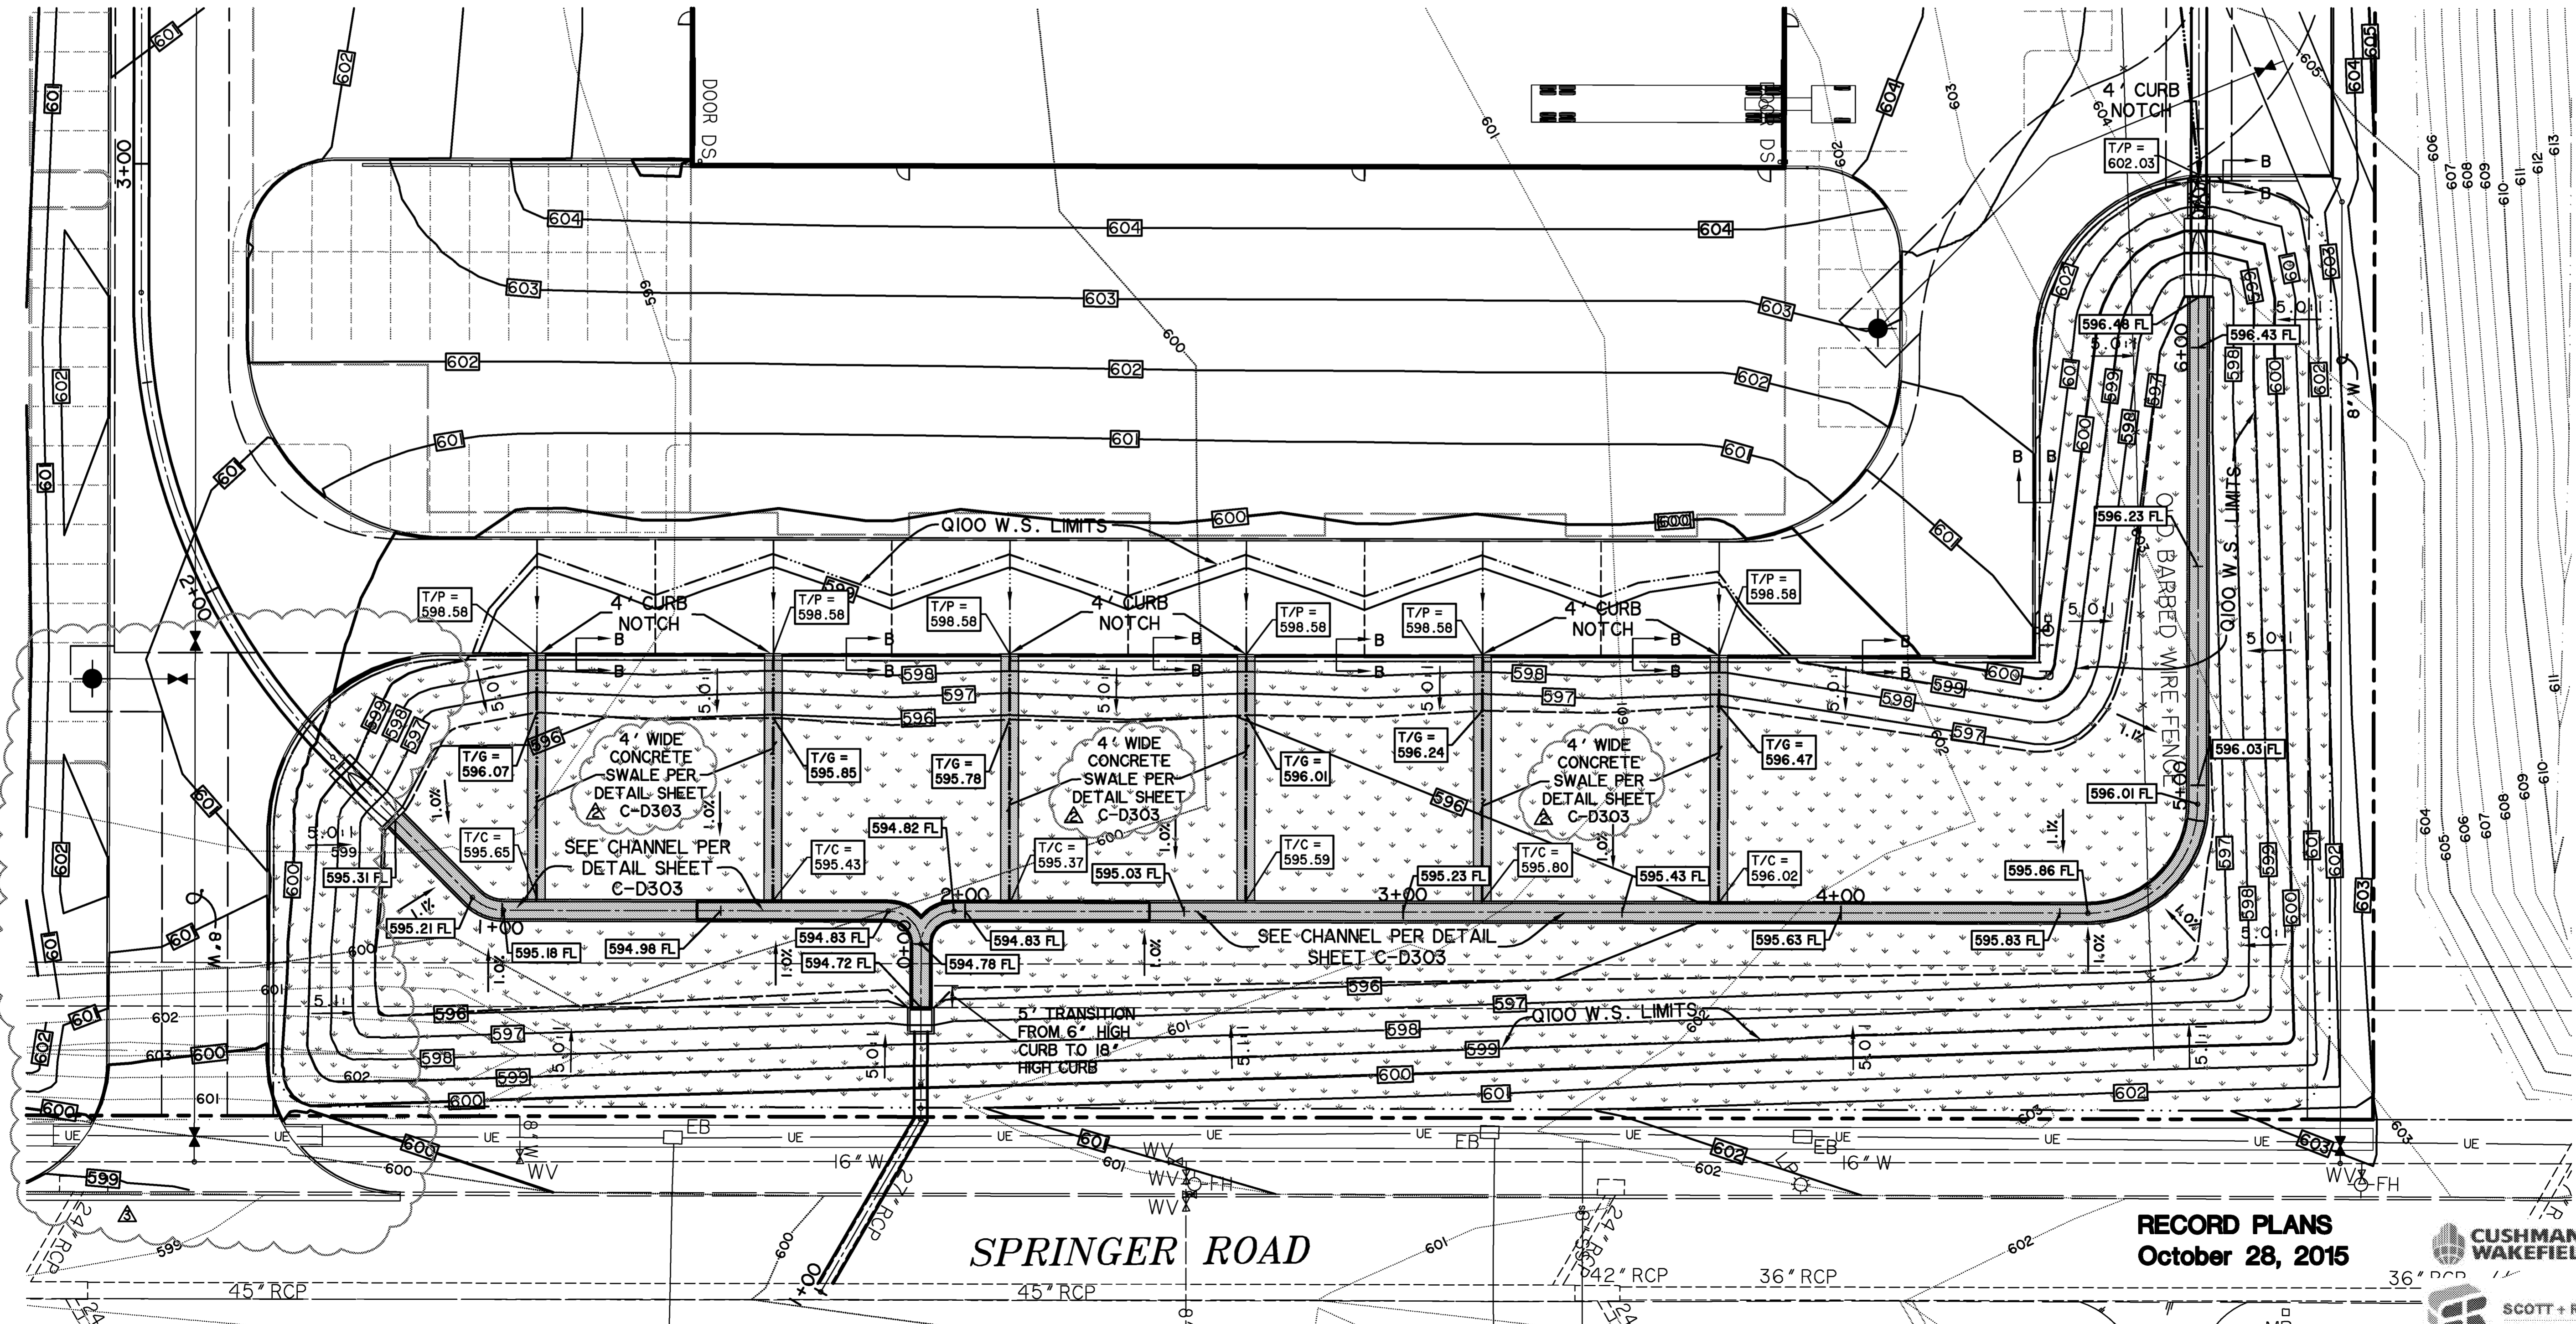


**SPRINGER ROAD**


**RECORD PLANS  
October 28, 2015**

**CUSHMAN & WAKEFIELD**  
**SCOTT + REID**  
General Contractors

PREPARED BY:  
**WIER & ASSOCIATES, INC.**  
ENGINEERS SURVEYORS LAND PLANNERS  
2201 E. LAMAR BLVD., SUITE 200E ARLINGTON, TEXAS 76006 METRO (817)467-7700  
Texas Firm Registration No. F-2776 www.wierassociates.com

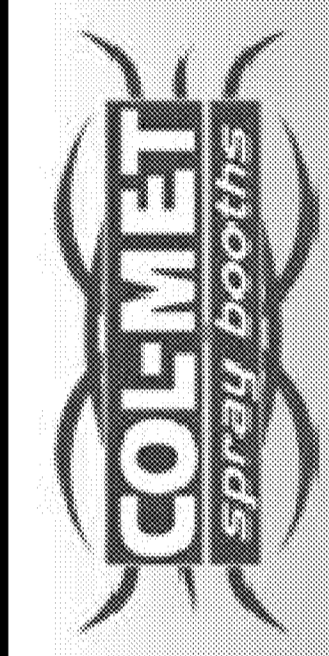

**LOT 3, BLOCK B  
ROCKWALL TECHNOLOGY PARK PHASE I  
COL-MET SPRAY BOOTHS  
DETENTION POND PLAN**




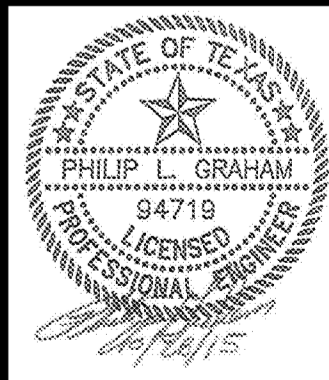


COPYRIGHT ©  
WIER & ASSOCIATES, INC.  
LAST SHEET EDITION  
DATE 10/28/2015  
WA# 14029  
**SHEET NO.  
C-D106**

PRINTED: 10/28/2015 5:52 AM FILE: WIER-EROSION-CONTROL\_STB LAST SAVED: 10/28/2015 5:52 AM FILE: PHILPG DETENTION-POND-PLAN-14029.DWG



PRINTED: 10/28/2015 10:28:20 AM STB FILE: WIER-STORM DRAIN, STB LAST SAVED: 10/28/2015 6:35 AM. SAVED BY: PHILIP FILE: STORM-DRAIN-PROFILES-14029.DWG

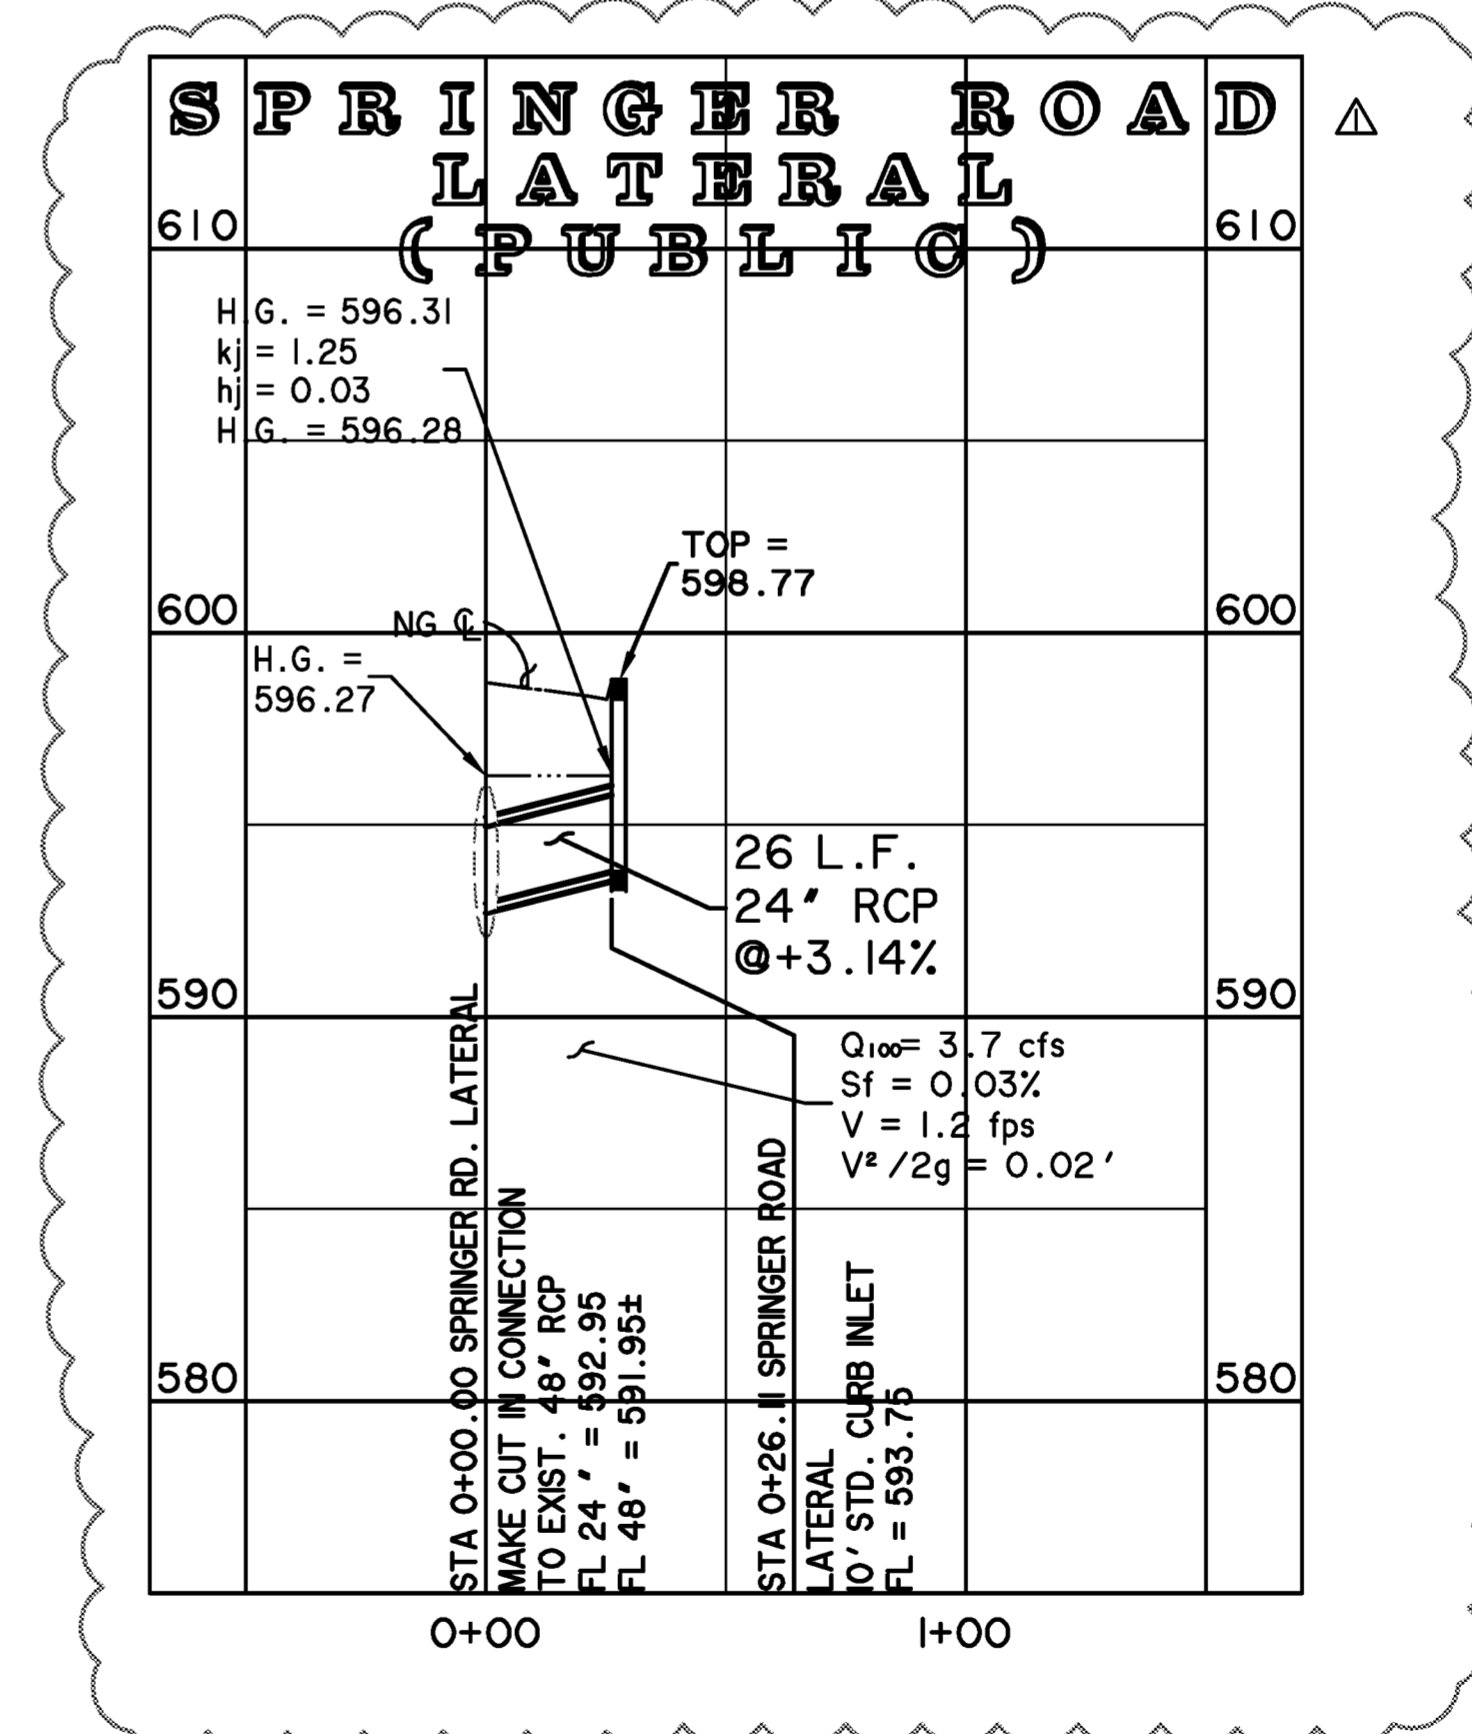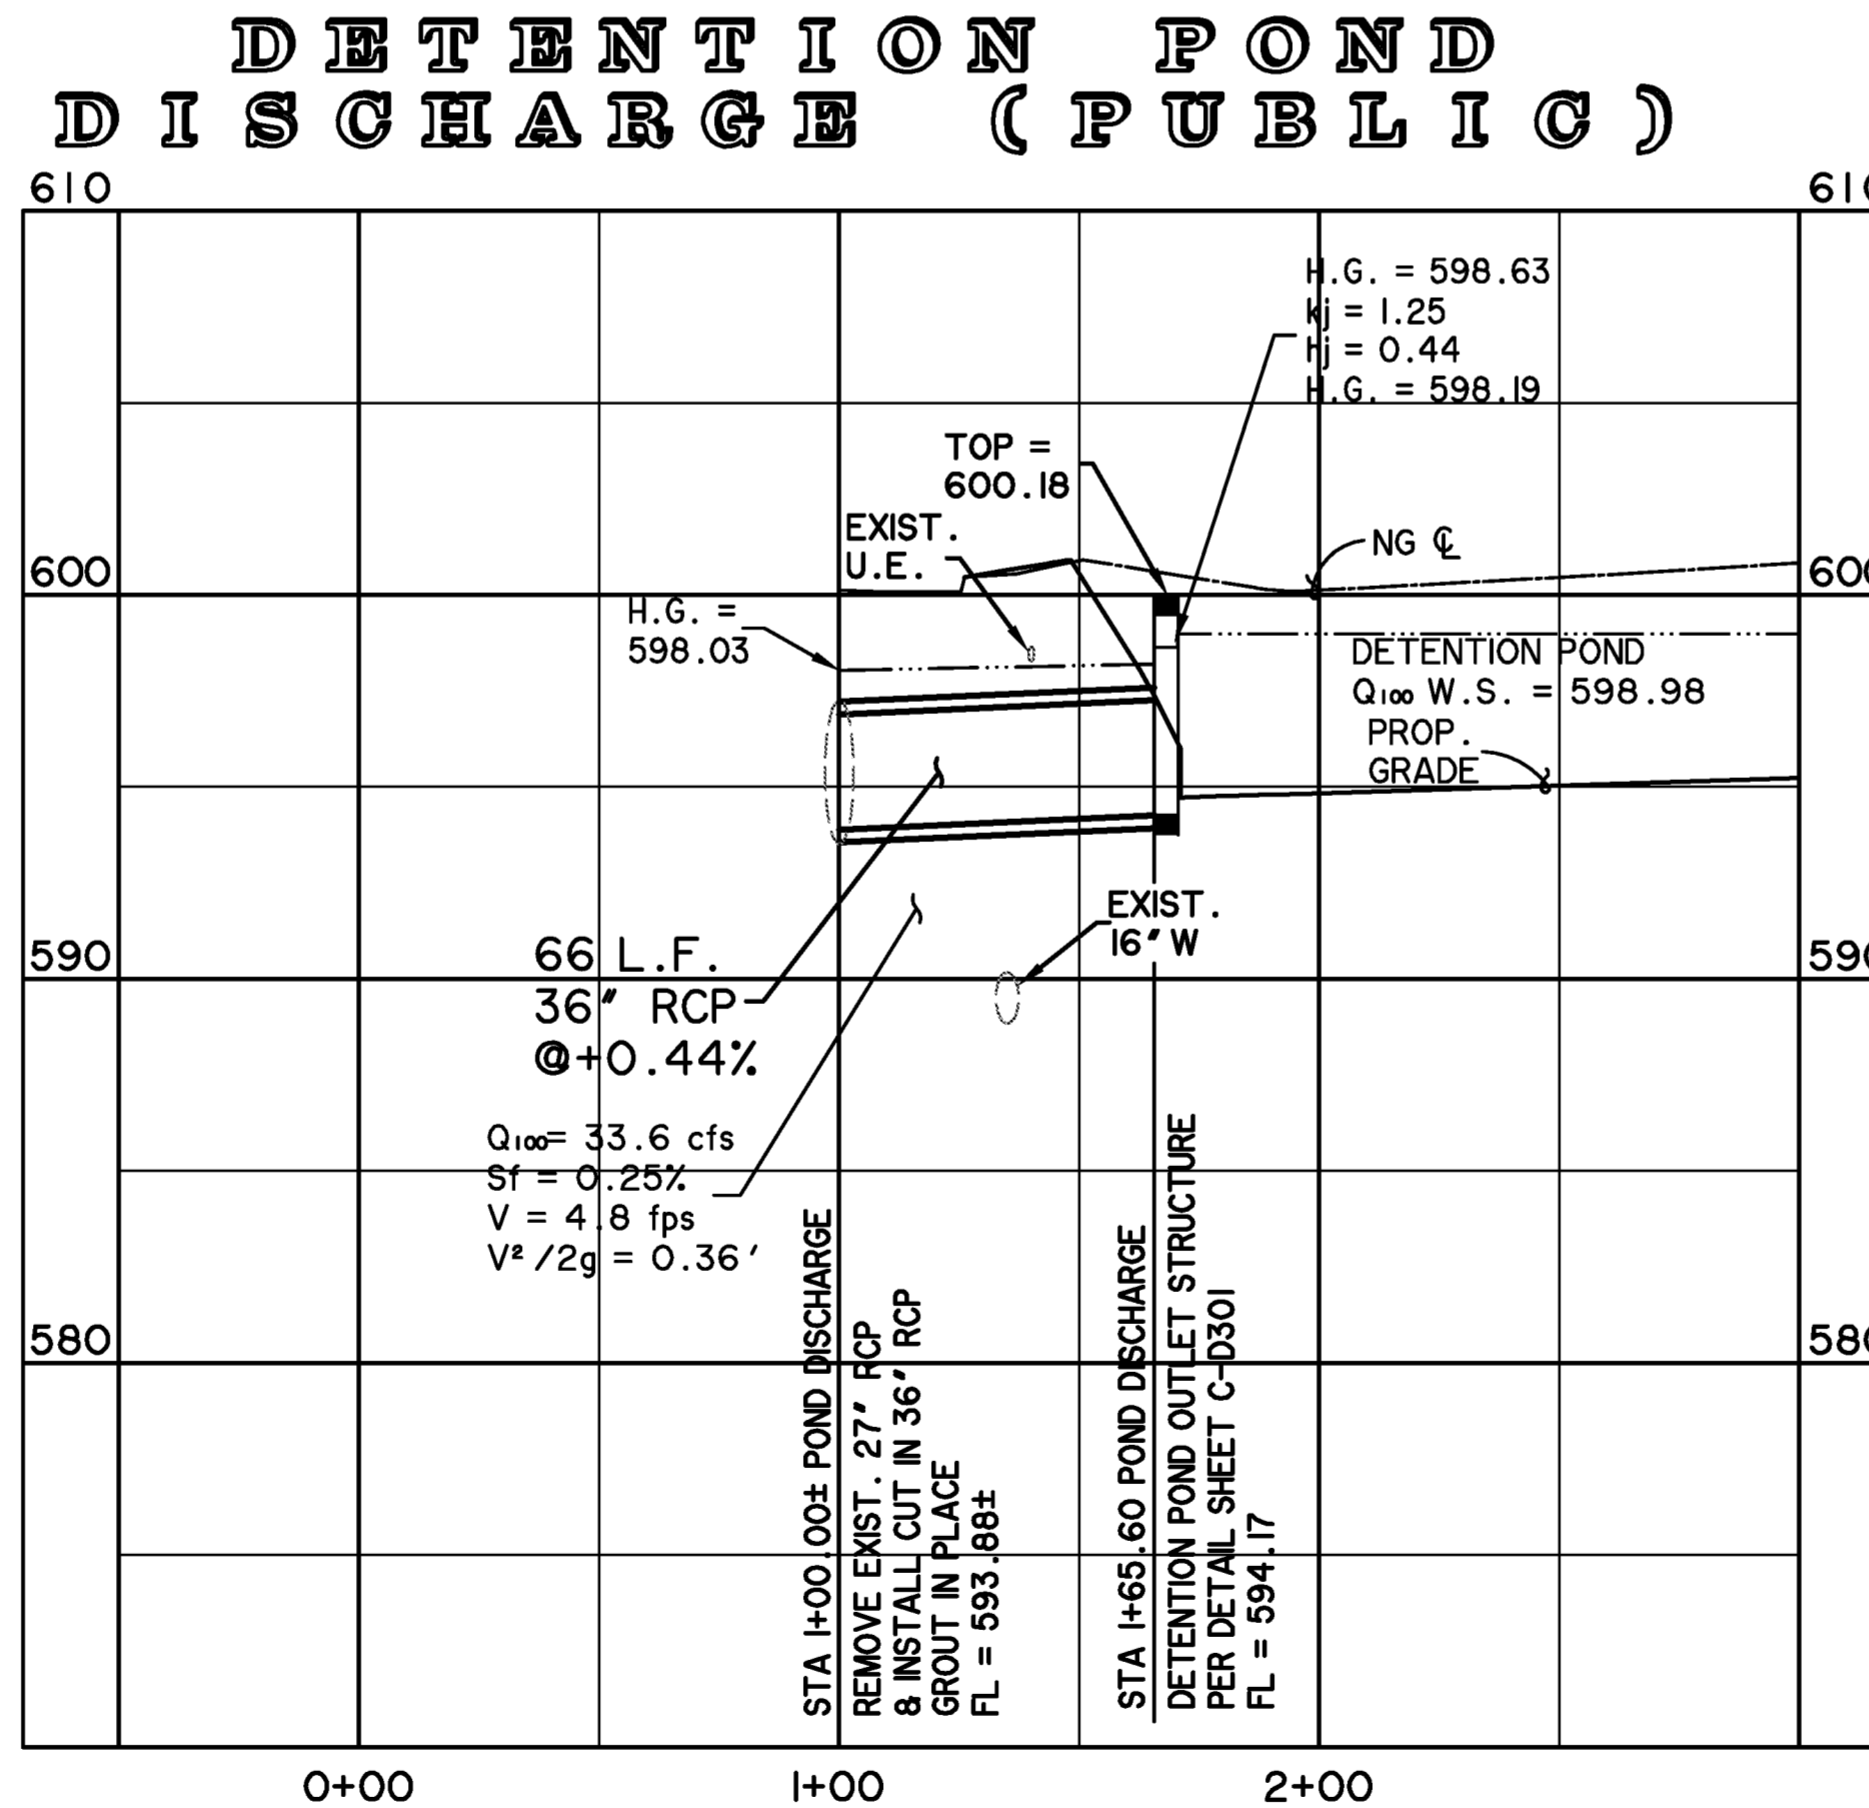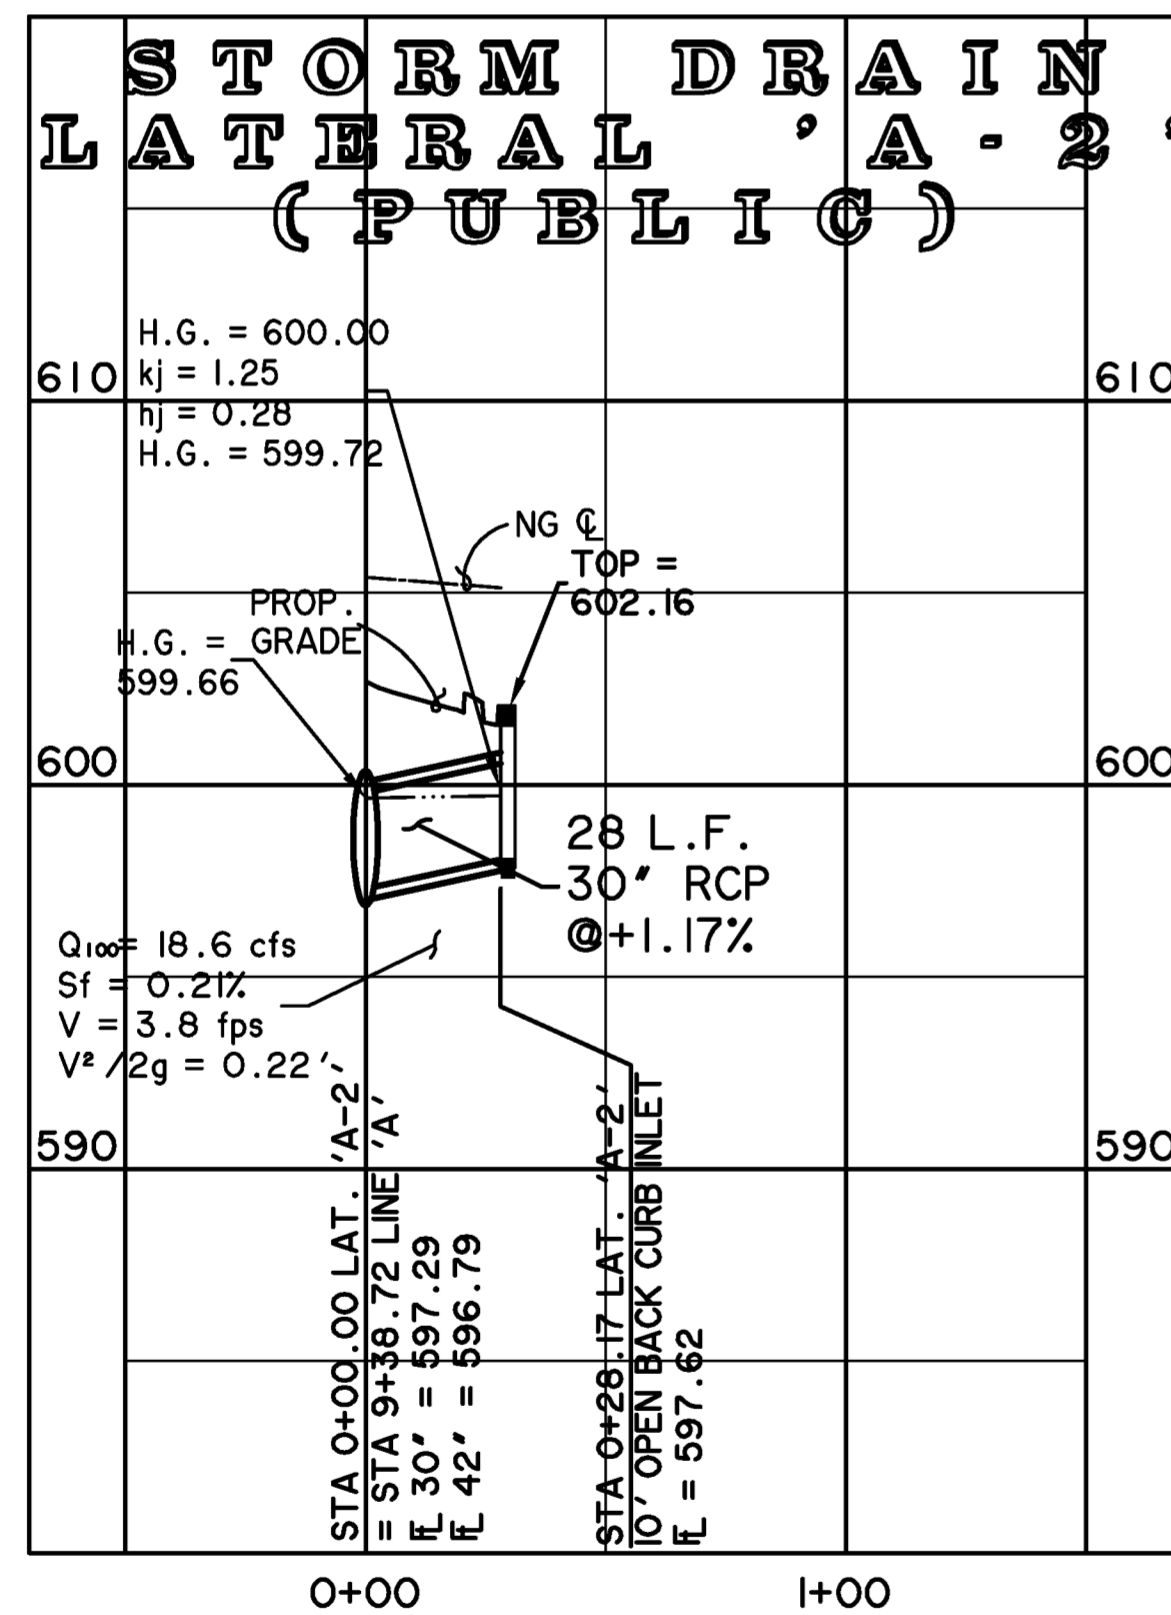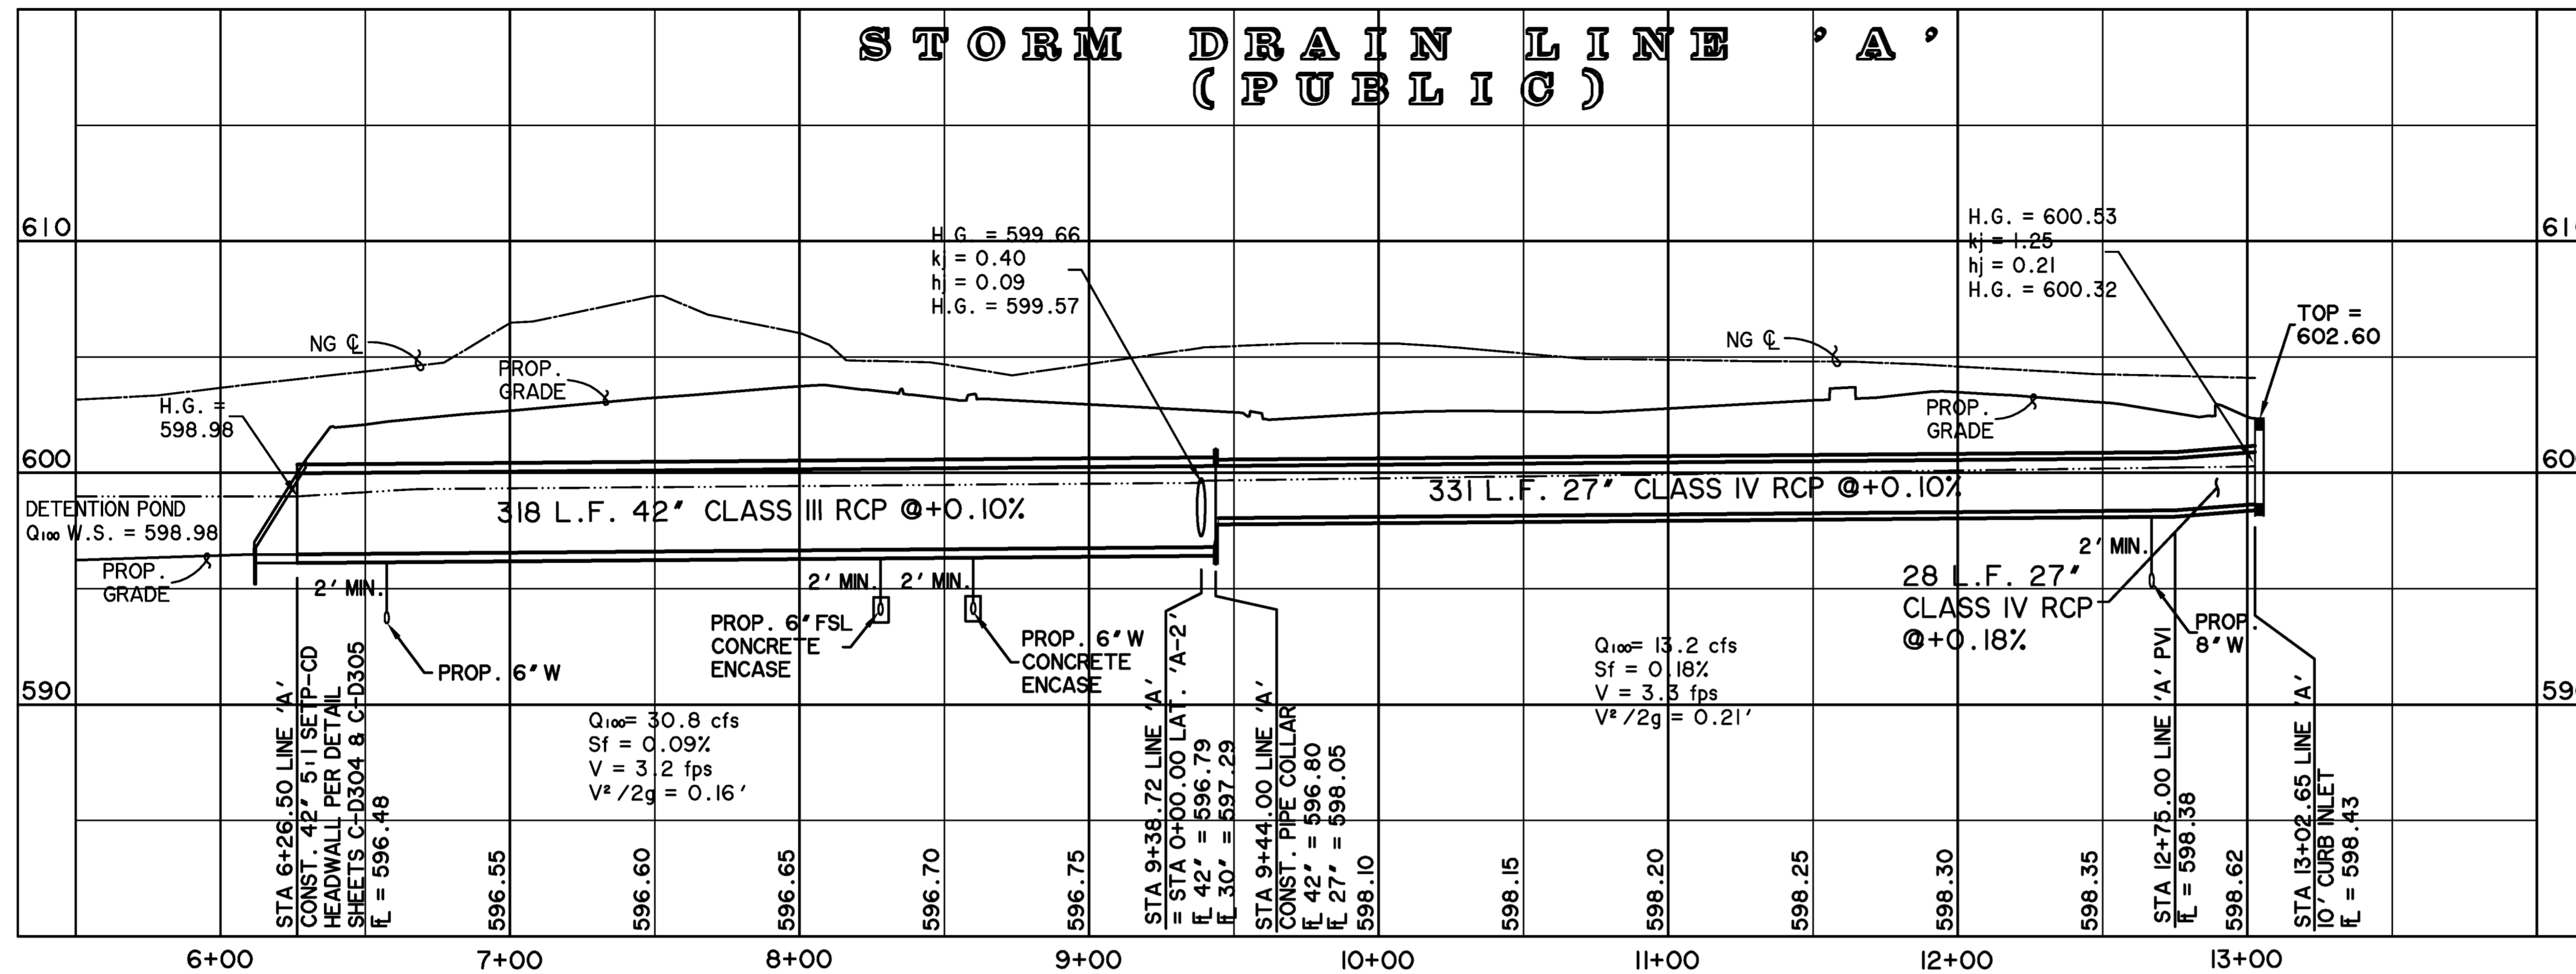

**\* BENCHMARKS \***

**BM.A:** "X" CUT ON NORTHWEST CORNER OF CURB INLET ALONG NORTH SIDE OF DISCOVERY BLVD. APPROXIMATELY 990' EAST OF IT'S INTERSECTION WITH F.M. 549. 601.19 FT.

**BM.B:** "X" CUT IN BOX IN THE CONCRETE AROUND A WATER VALVE ON THE BACK OF CURB ALONG THE NORTH SIDE OF SPRINGER RD. APPROXIMATELY 921' EAST OF IT'S INTERSECTION WITH F.M. 549. 600.75 FT.

**CAUTION !!**

EXISTING UTILITIES ARE INDICATED ON THE PLANS FROM AVAILABLE INFORMATION. IT SHALL BE THE RESPONSIBILITY OF THE CONTRACTOR TO VERIFY THE LOCATION OF ALL UTILITIES, TO NOTIFY ALL UTILITY COMPANIES OF THE CONTRACTORS OPERATIONS, TO PROTECT ALL UTILITIES FROM DAMAGE, TO REPAIR ALL UTILITIES DAMAGED DUE TO THE CONTRACTORS OPERATIONS, AND TO NOTIFY THE ENGINEER PROMPTLY OF ALL CONFLICTS OF THE WORK WITH EXISTING UTILITIES.

\* ALL RESPONSIBILITY FOR ADEQUACY OF DESIGN REMAINS WITH THE DESIGN ENGINEER. THE CITY OF ROCKWALL, IN REVIEWING AND RELEASING THE PLANS FOR CONSTRUCTION, ASSUMES NO RESPONSIBILITY FOR ADEQUACY OR ACCURACY OF DESIGN.\*


SCALE:  
HORIZ. 1" = 40'  
VERT. 1" = 5'

BAR IS ONE INCH ON ORIGINAL DRAWING. IF BAR IS NOT ONE INCH ON THIS SHEET, ADJUST SCALE.


| REVISIONS                   | DATE BY      |
|-----------------------------|--------------|
| ▲ ADDED STORM DRAIN PROFILE | 03/19/15 PLG |
|                             |              |
|                             |              |

CUSHMAN & WAKEFIELD  
SCOTT + REID  
General Contractors

PREPARED BY:  
**WIER & ASSOCIATES, INC.**  
ENGINEERS SURVEYORS LAND PLANNERS  
2201 E. LAMAR BLVD., SUITE 200E ARLINGTON, TEXAS 76006 METRO (817)467-7700  
www.wierassociates.com  
Texas Firm Registration No. F-2776

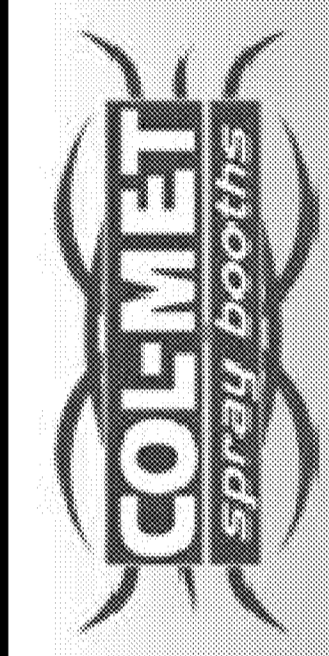



LOT 3, BLOCK B  
ROCKWALL TECHNOLOGY PARK PHASE II  
COL-MET SPRAY BOOTHS  
STORM DRAIN PROFILES

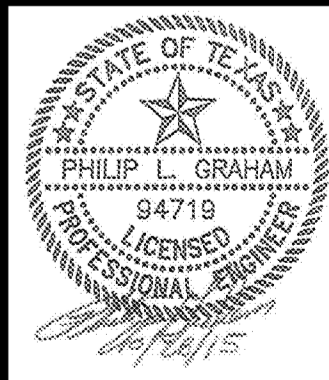

COPYRIGHT ©  
WIER & ASSOCIATES, INC.  
LAST SHEET OF 11  
DATE 10/28/2015  
WA# 14029  
**SHEET NO. C-D201**

RECORD PLANS  
October 28, 2015

PRINTED: 10/28/2015 STB FILE: WIER-STORM DRAIN, STB LAST SAVED: 10/28/2015 6:36 AM. SAVED BY: PHILIP FILE: STORM-DRAIN-PROFILES-2-14029.DWG

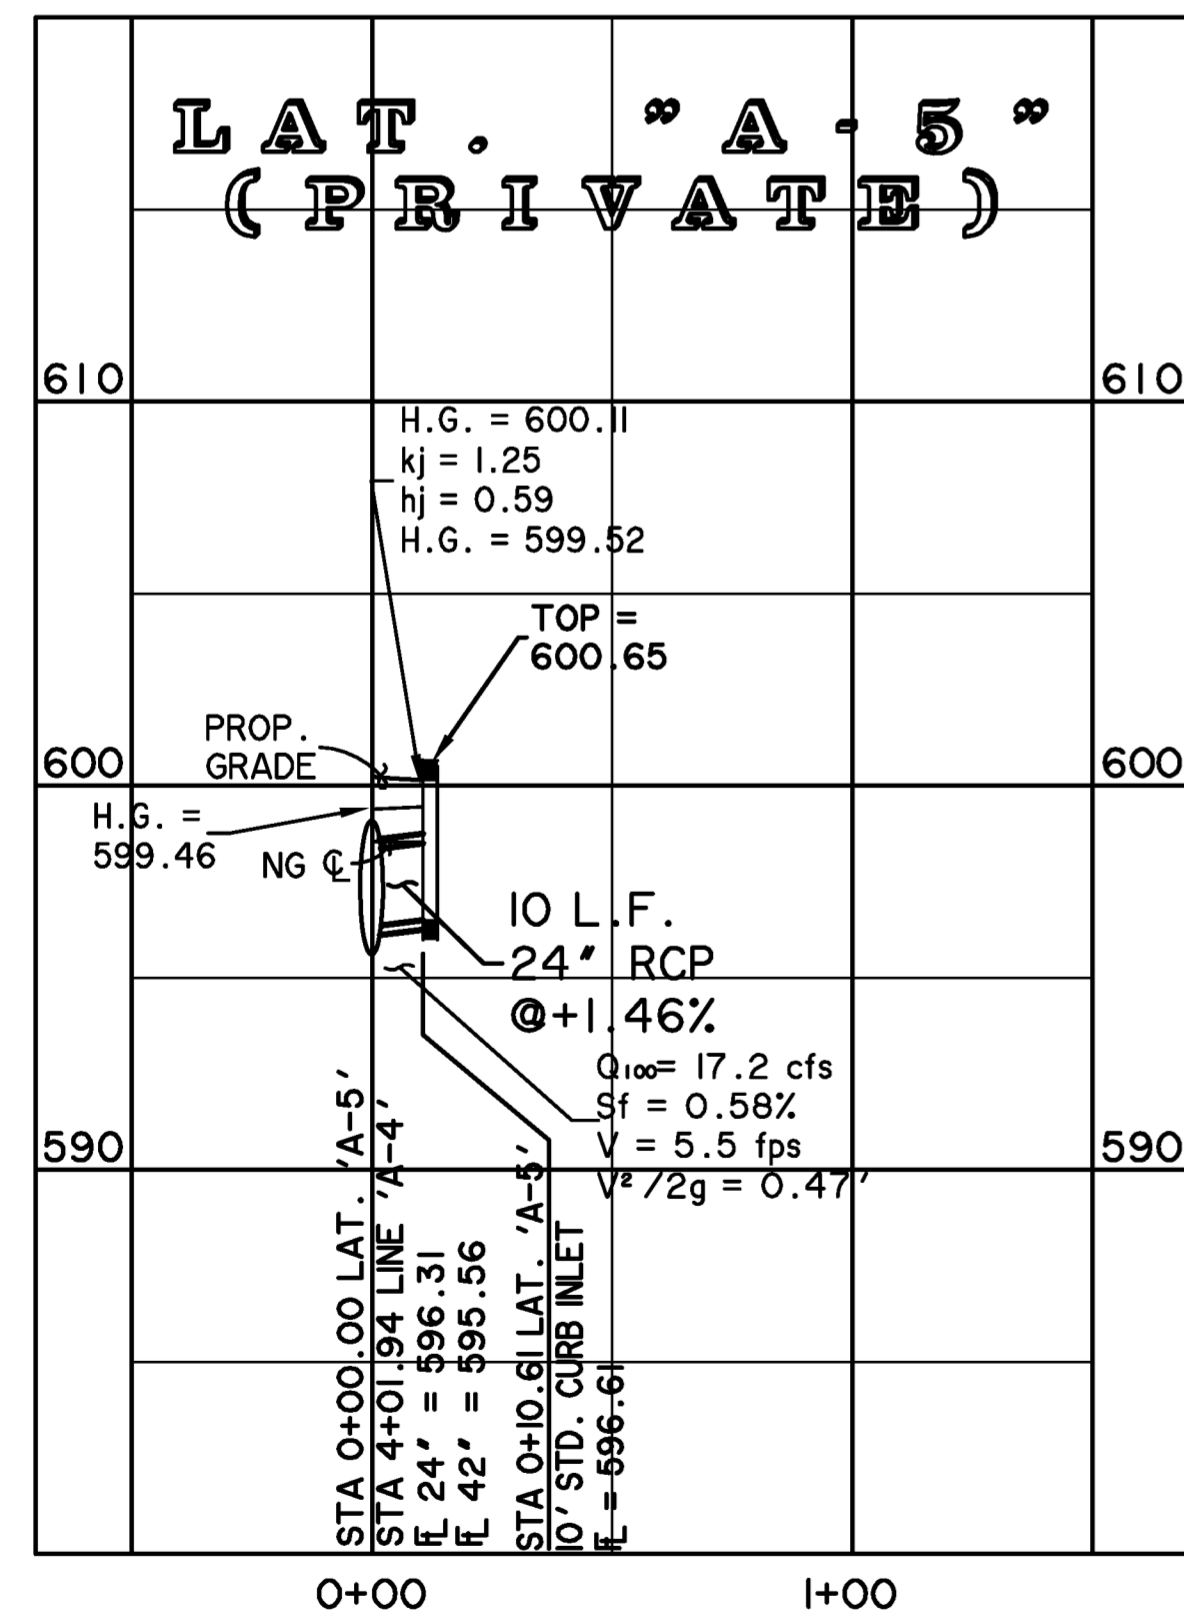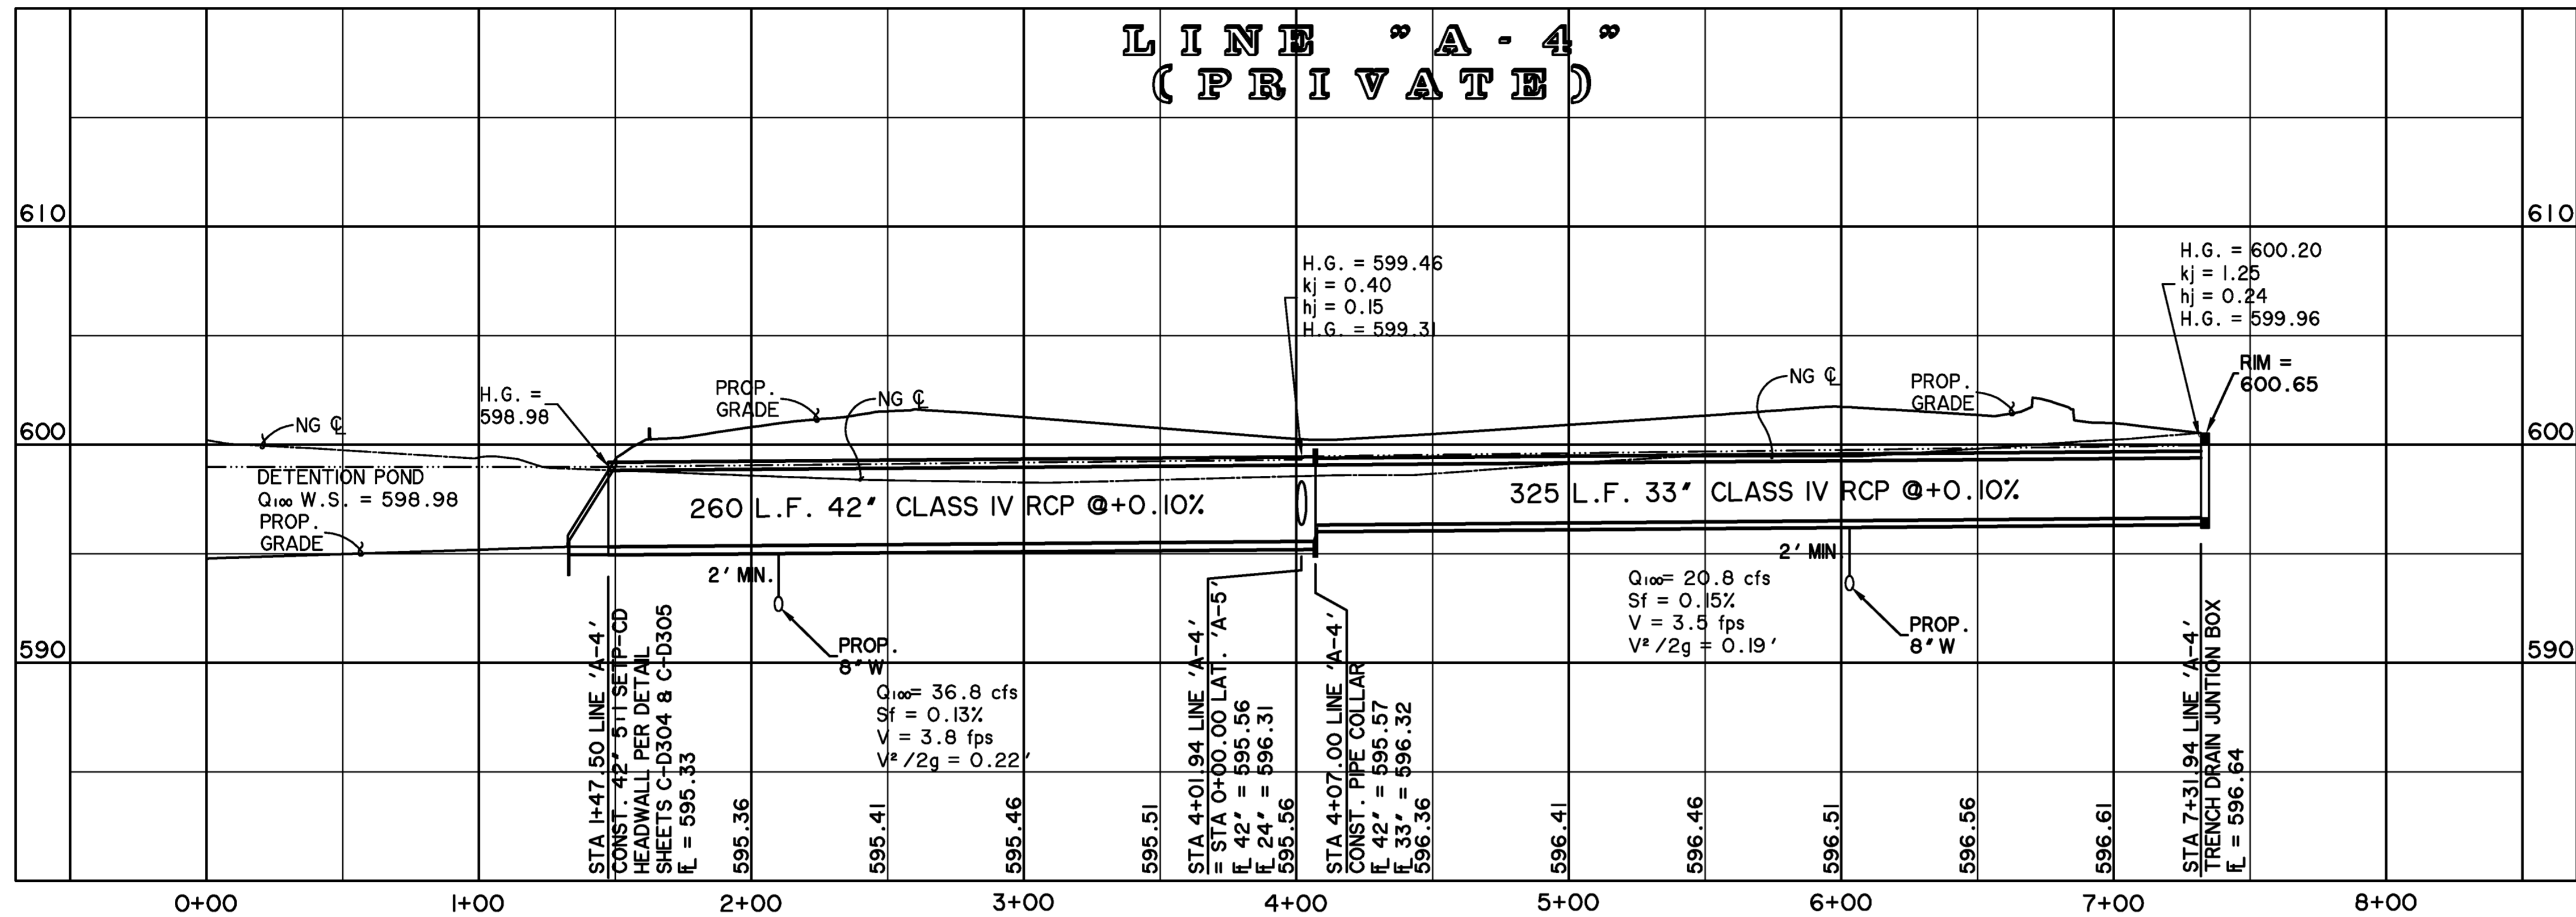

\* ALL RESPONSIBILITY FOR ADEQUACY OF DESIGN REMAINS WITH THE DESIGN ENGINEER. THE CITY OF ROCKWALL, IN REVIEWING AND RELEASING THE PLANS FOR CONSTRUCTION, ASSUMES NO RESPONSIBILITY FOR ADEQUACY OR ACCURACY OF DESIGN. \*

**\* BENCHMARKS \***  
**BM A:** "X" CUT ON NORTHWEST CORNER OF CURB INLET ALONG NORTH SIDE OF DISCOVERY BLVD. APPROXIMATELY 990' EAST OF IT'S INTERSECTION WITH F.M. 549. 601.19 FT.  
**BM B:** "X" CUT IN BOX IN THE CONCRETE AROUND A WATER VALVE ON THE BACK OF CURB ALONG THE NORTH SIDE OF SPRINGER RD. APPROXIMATELY 921' EAST OF IT'S INTERSECTION WITH F.M. 549. 600.75 FT.


**CAUTION !!**  
 EXISTING UTILITIES ARE INDICATED ON THE PLANS FROM AVAILABLE INFORMATION. IT SHALL BE THE RESPONSIBILITY OF THE CONTRACTOR TO VERIFY THE LOCATION OF ALL UTILITIES, TO NOTIFY ALL UTILITY COMPANIES OF THE CONTRACTORS OPERATIONS, TO PROTECT ALL UTILITIES FROM DAMAGE, TO REPAIR ALL UTILITIES DAMAGED DUE TO THE CONTRACTORS OPERATIONS, AND TO NOTIFY THE ENGINEER PROMPTLY OF ALL CONFLICTS OF THE WORK WITH EXISTING UTILITIES.

**RECORD PLANS**  
 October 28, 2015


SCALE:  
 HORIZ. : 1" = 40'  
 VERT. : 1" = 5'

0 1' BAR IS ONE INCH ON ORIGINAL DRAWING. IF BAR IS NOT ONE INCH ON THIS SHEET, ADJUST SCALE.

PREPARED BY:  
**WIER & ASSOCIATES, INC.**  
 ENGINEERS SURVEYORS LAND PLANNERS  
 2201 E. LAMAR BLVD., SUITE 200E ARLINGTON, TEXAS 76006 METRO (817)467-7700  
 Texas Firm Registration No. F-2776 www.wierassociates.com

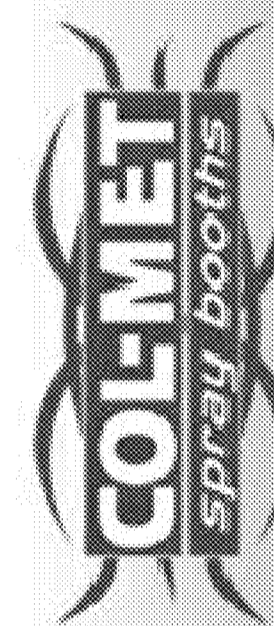

LOT 3, BLOCK B  
 ROCKWALL TECHNOLOGY PARK PHASE I  
 COL-MET SPRAY BOOTHS  
 STORM DRAIN PROFILES

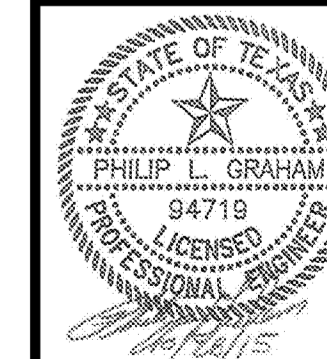


COPYRIGHT ©  
 WIER & ASSOCIATES, INC.  
 LAST SHEET EDIT  
 DATE 10/28/2015  
 WA# 14029  
**SHEET NO.**  
 C-D202






PRINTED: 10/28/2015 5TB FILE: WIER-STORM DRAIN.STB LAST SAVED: 10/28/2015 5:15:15 AM SAVED BY: PHILIPG FILE: DETENTION-POND-DETAILS-2-14029.DWG

DETENTION POND VOLUME 100 YEAR

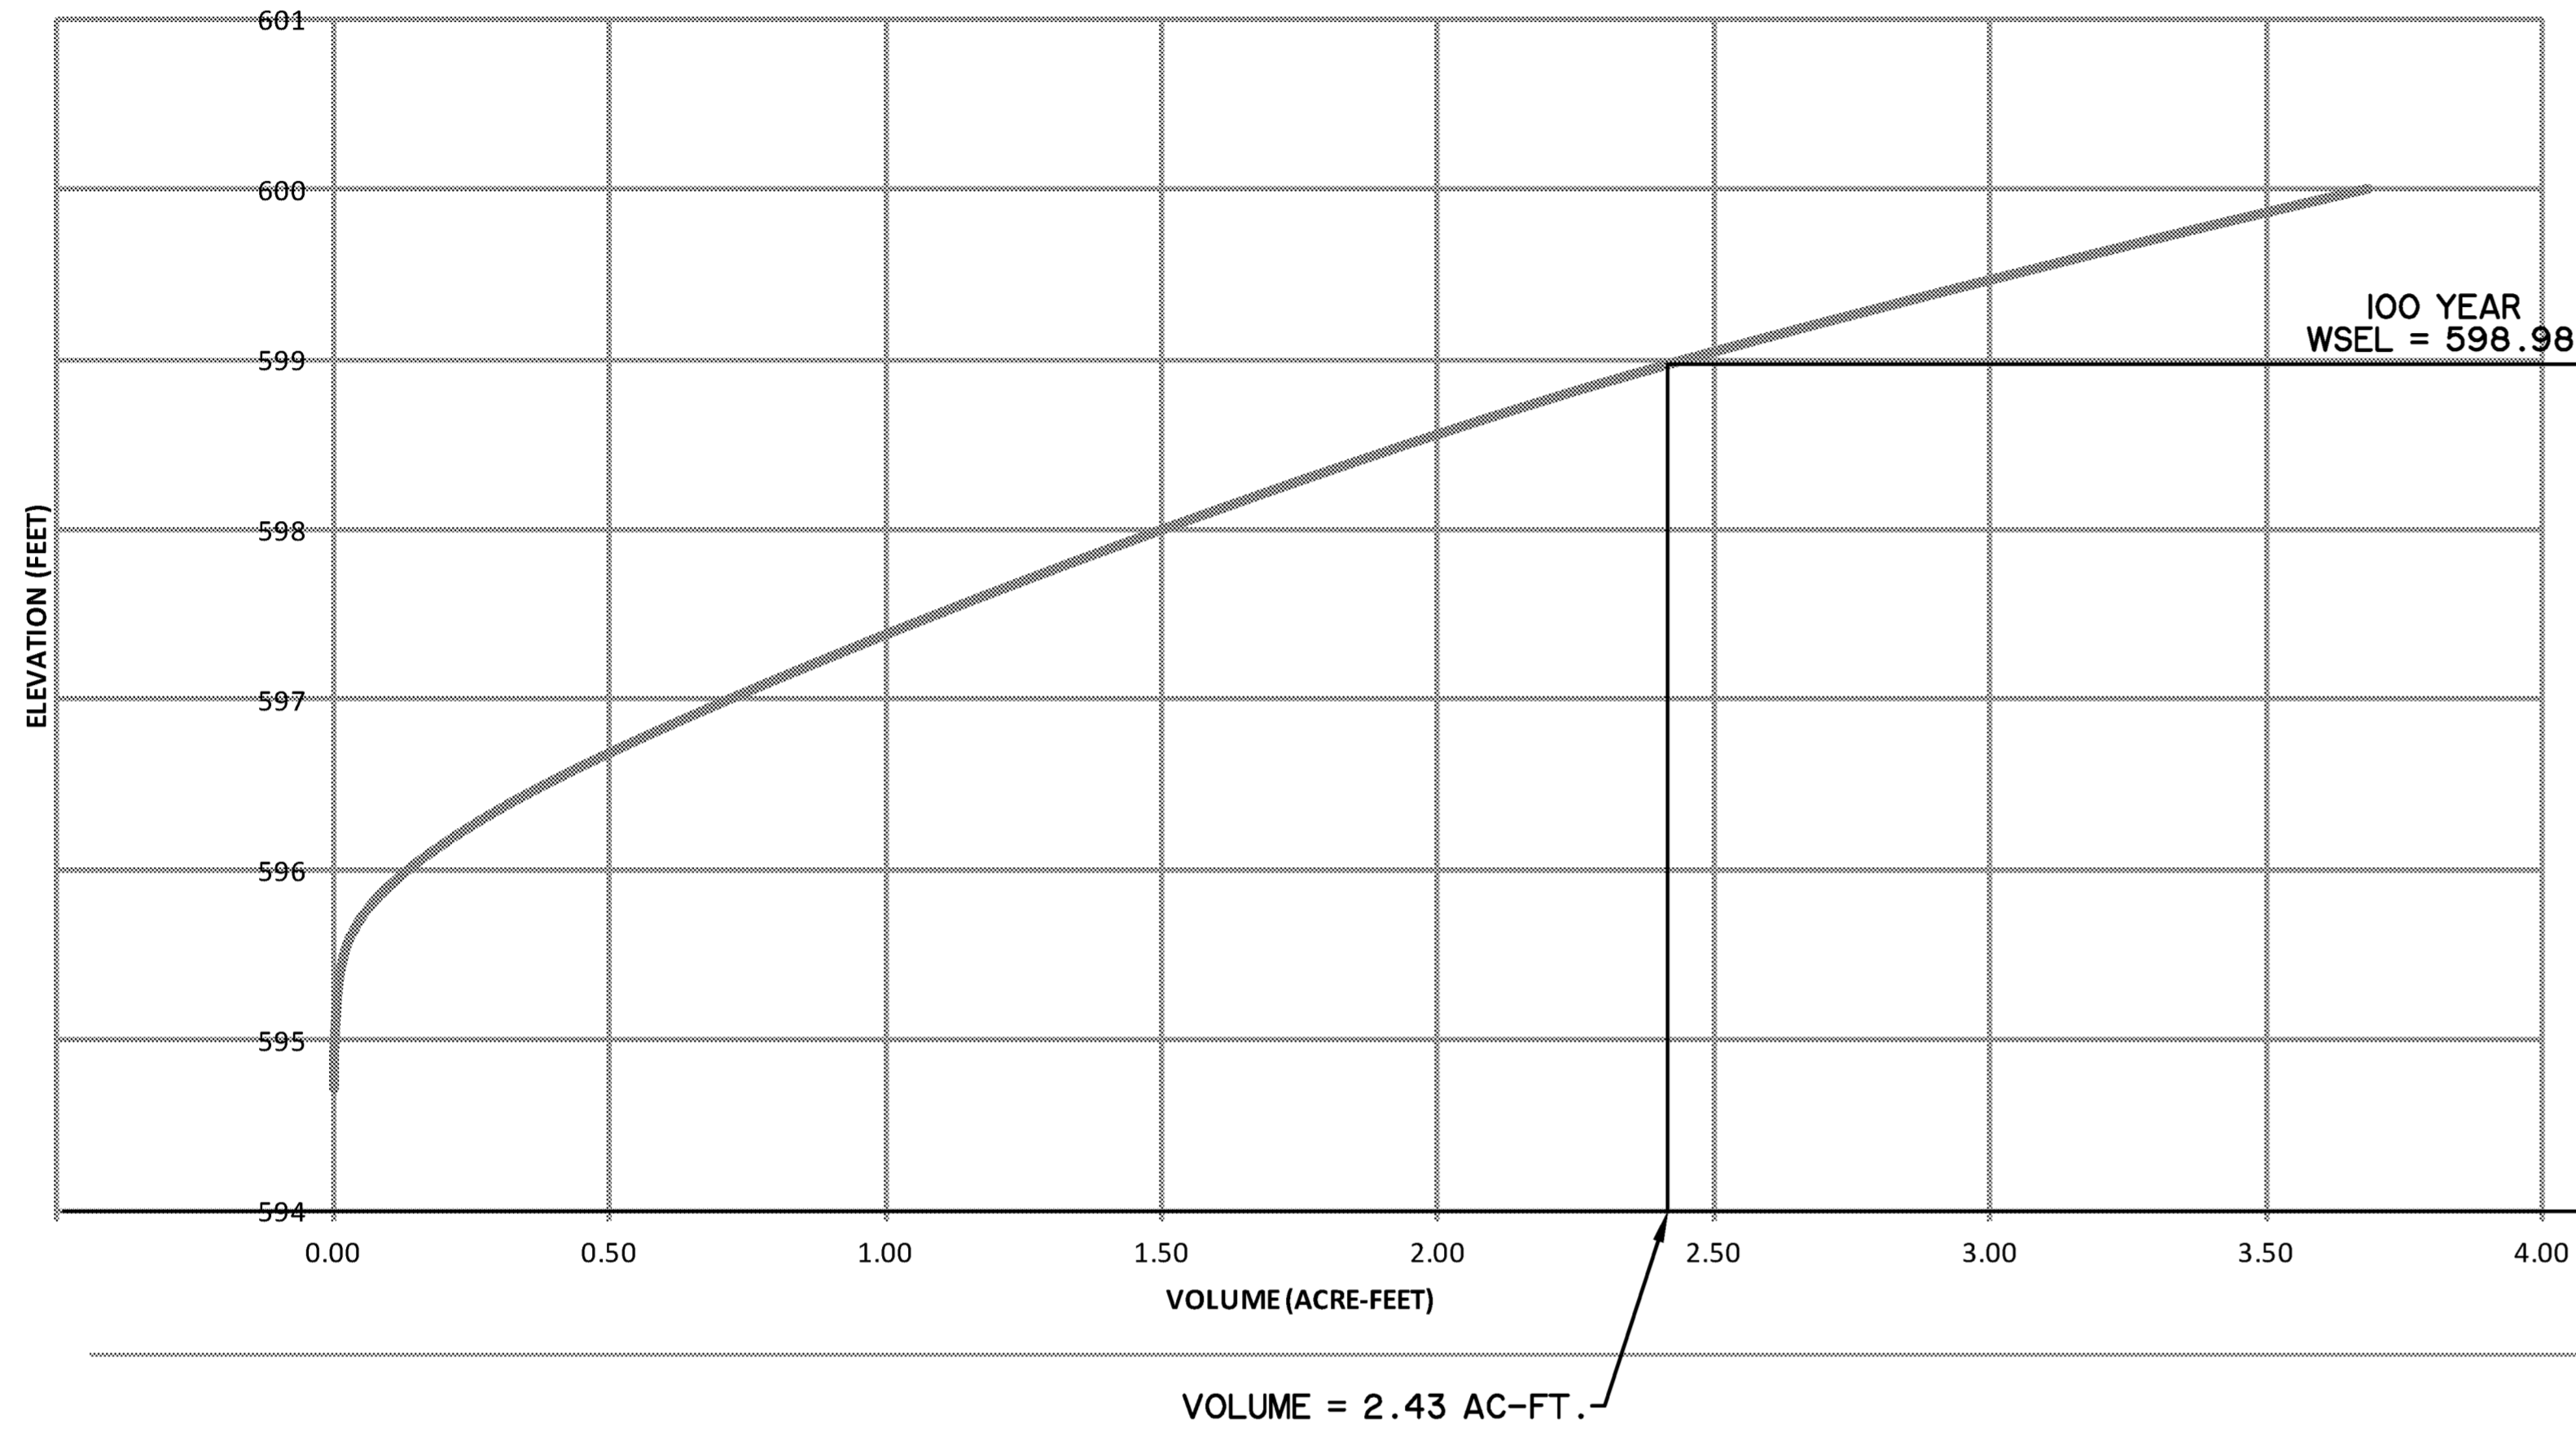


DETENTION POND OUTFLOW 100 YEAR

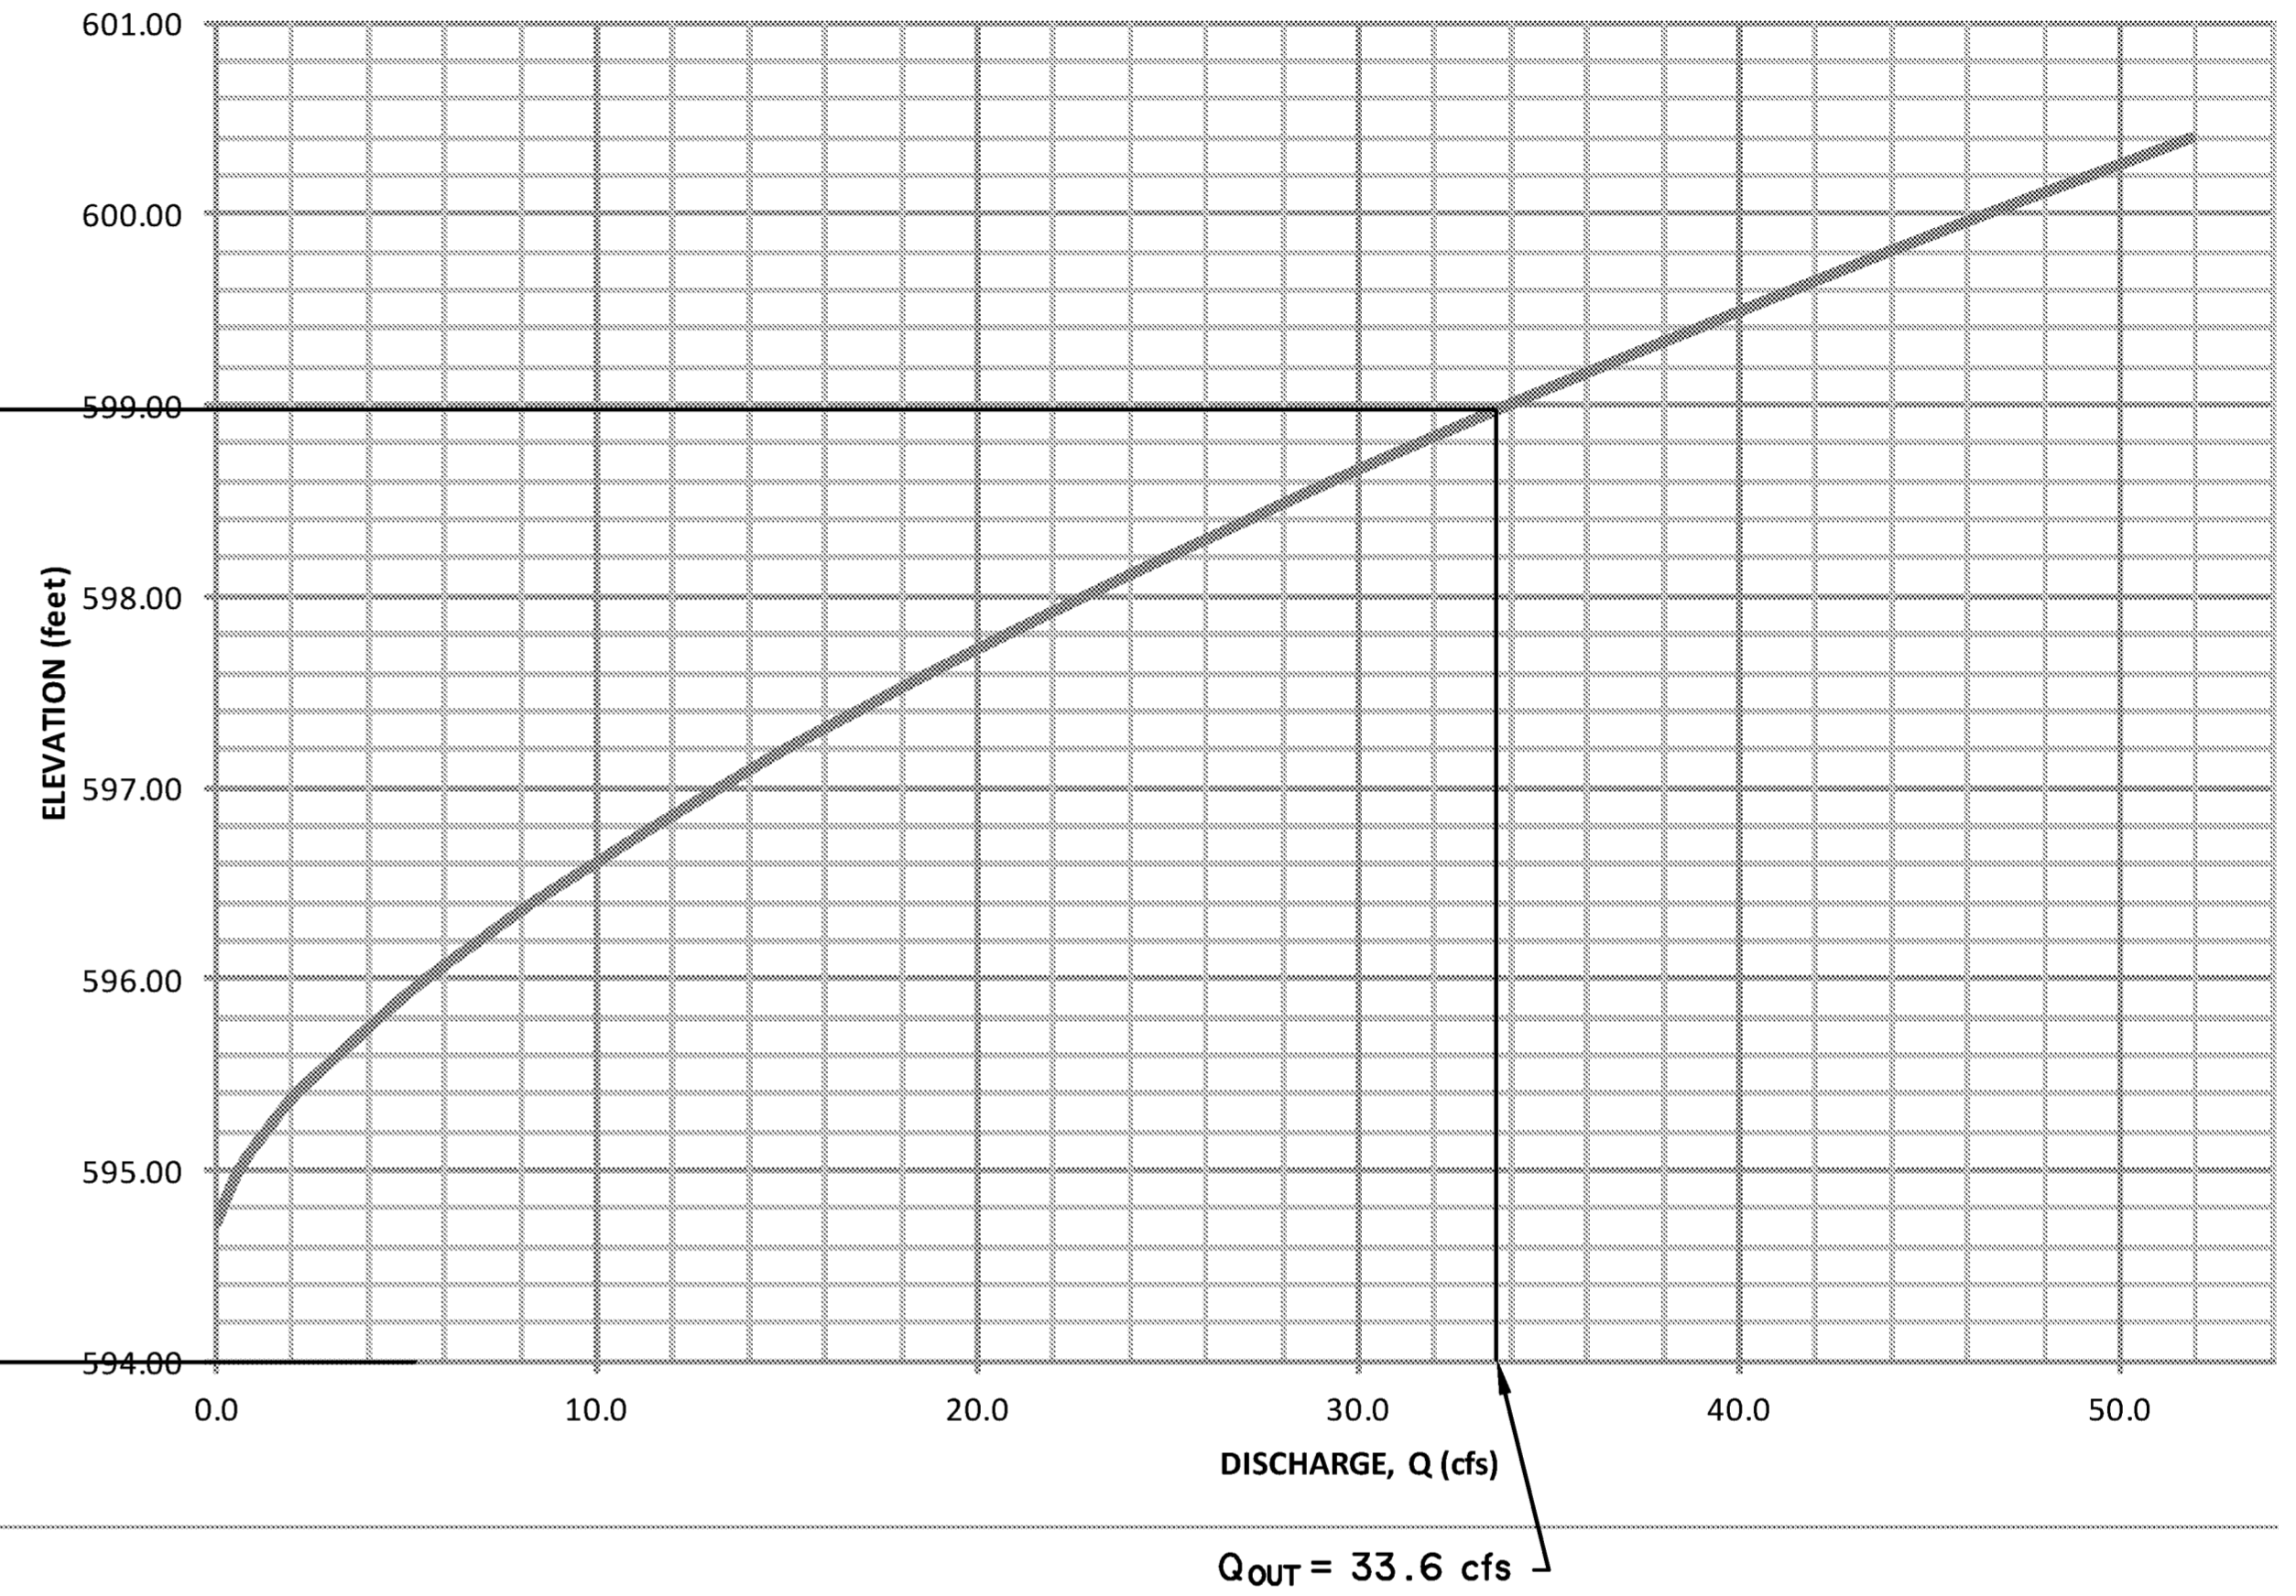


\* ALL RESPONSIBILITY FOR ADEQUACY OF DESIGN REMAINS WITH THE DESIGN ENGINEER. THE CITY OF ROCKWALL, IN REVIEWING AND RELEASING THE PLANS FOR CONSTRUCTION, ASSUMES NO RESPONSIBILITY FOR ADEQUACY OR ACCURACY OF DESIGN.\*

RECORD PLANS  
October 28, 2015

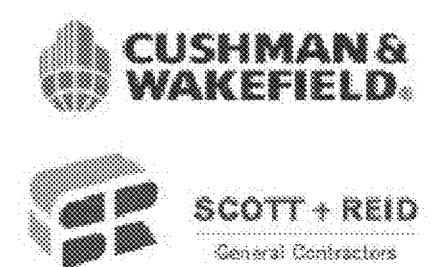

PREPARED BY:  
**WIER & ASSOCIATES, INC.**  
 ENGINEERS SURVEYORS LAND PLANNERS  
 2201 E. LAMAR BLVD., SUITE 200E ARLINGTON, TEXAS 76006 METRO (817)467-7700  
 Texas Firm Registration No. F-2776 www.wierassociates.com

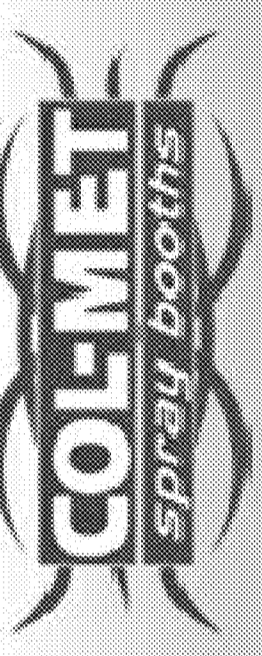


LOT 3, BLOCK B  
 ROCKWALL TECHNOLOGY PARK PHASE I  
 COL-MET SPRAY BOOTHS  
 DETENTION POND DETAILS




COPYRIGHT ©  
 WIER & ASSOCIATES, INC.  
 LAST SHEET EDIT  
 DATE 10/28/2015  
 WA# 14029  
 SHEET NO.  
 C-D302


PRINTED: 10/28/2015 5TB FILE: WIER-STORM DRAIN.STB LAST SAVED: 10/28/2015 6:16 AM SAVED BY: PHILIP FILE: STORM-DRAIN-DETAILS-14029.DWG

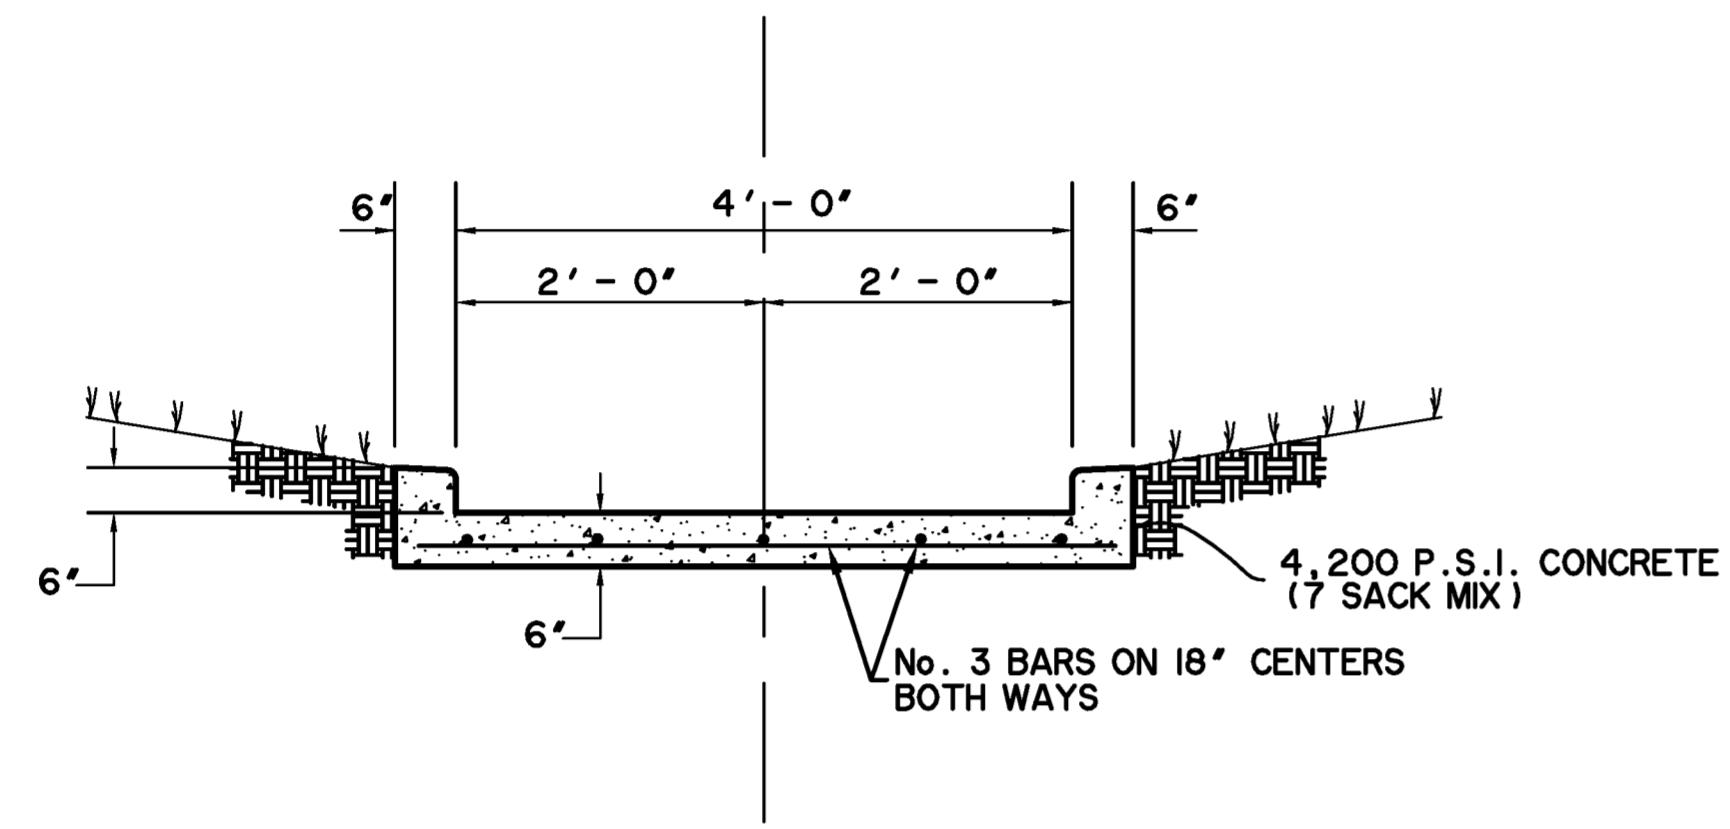

**DETENTION POND CHANNEL DETAIL**  
N.T.S.

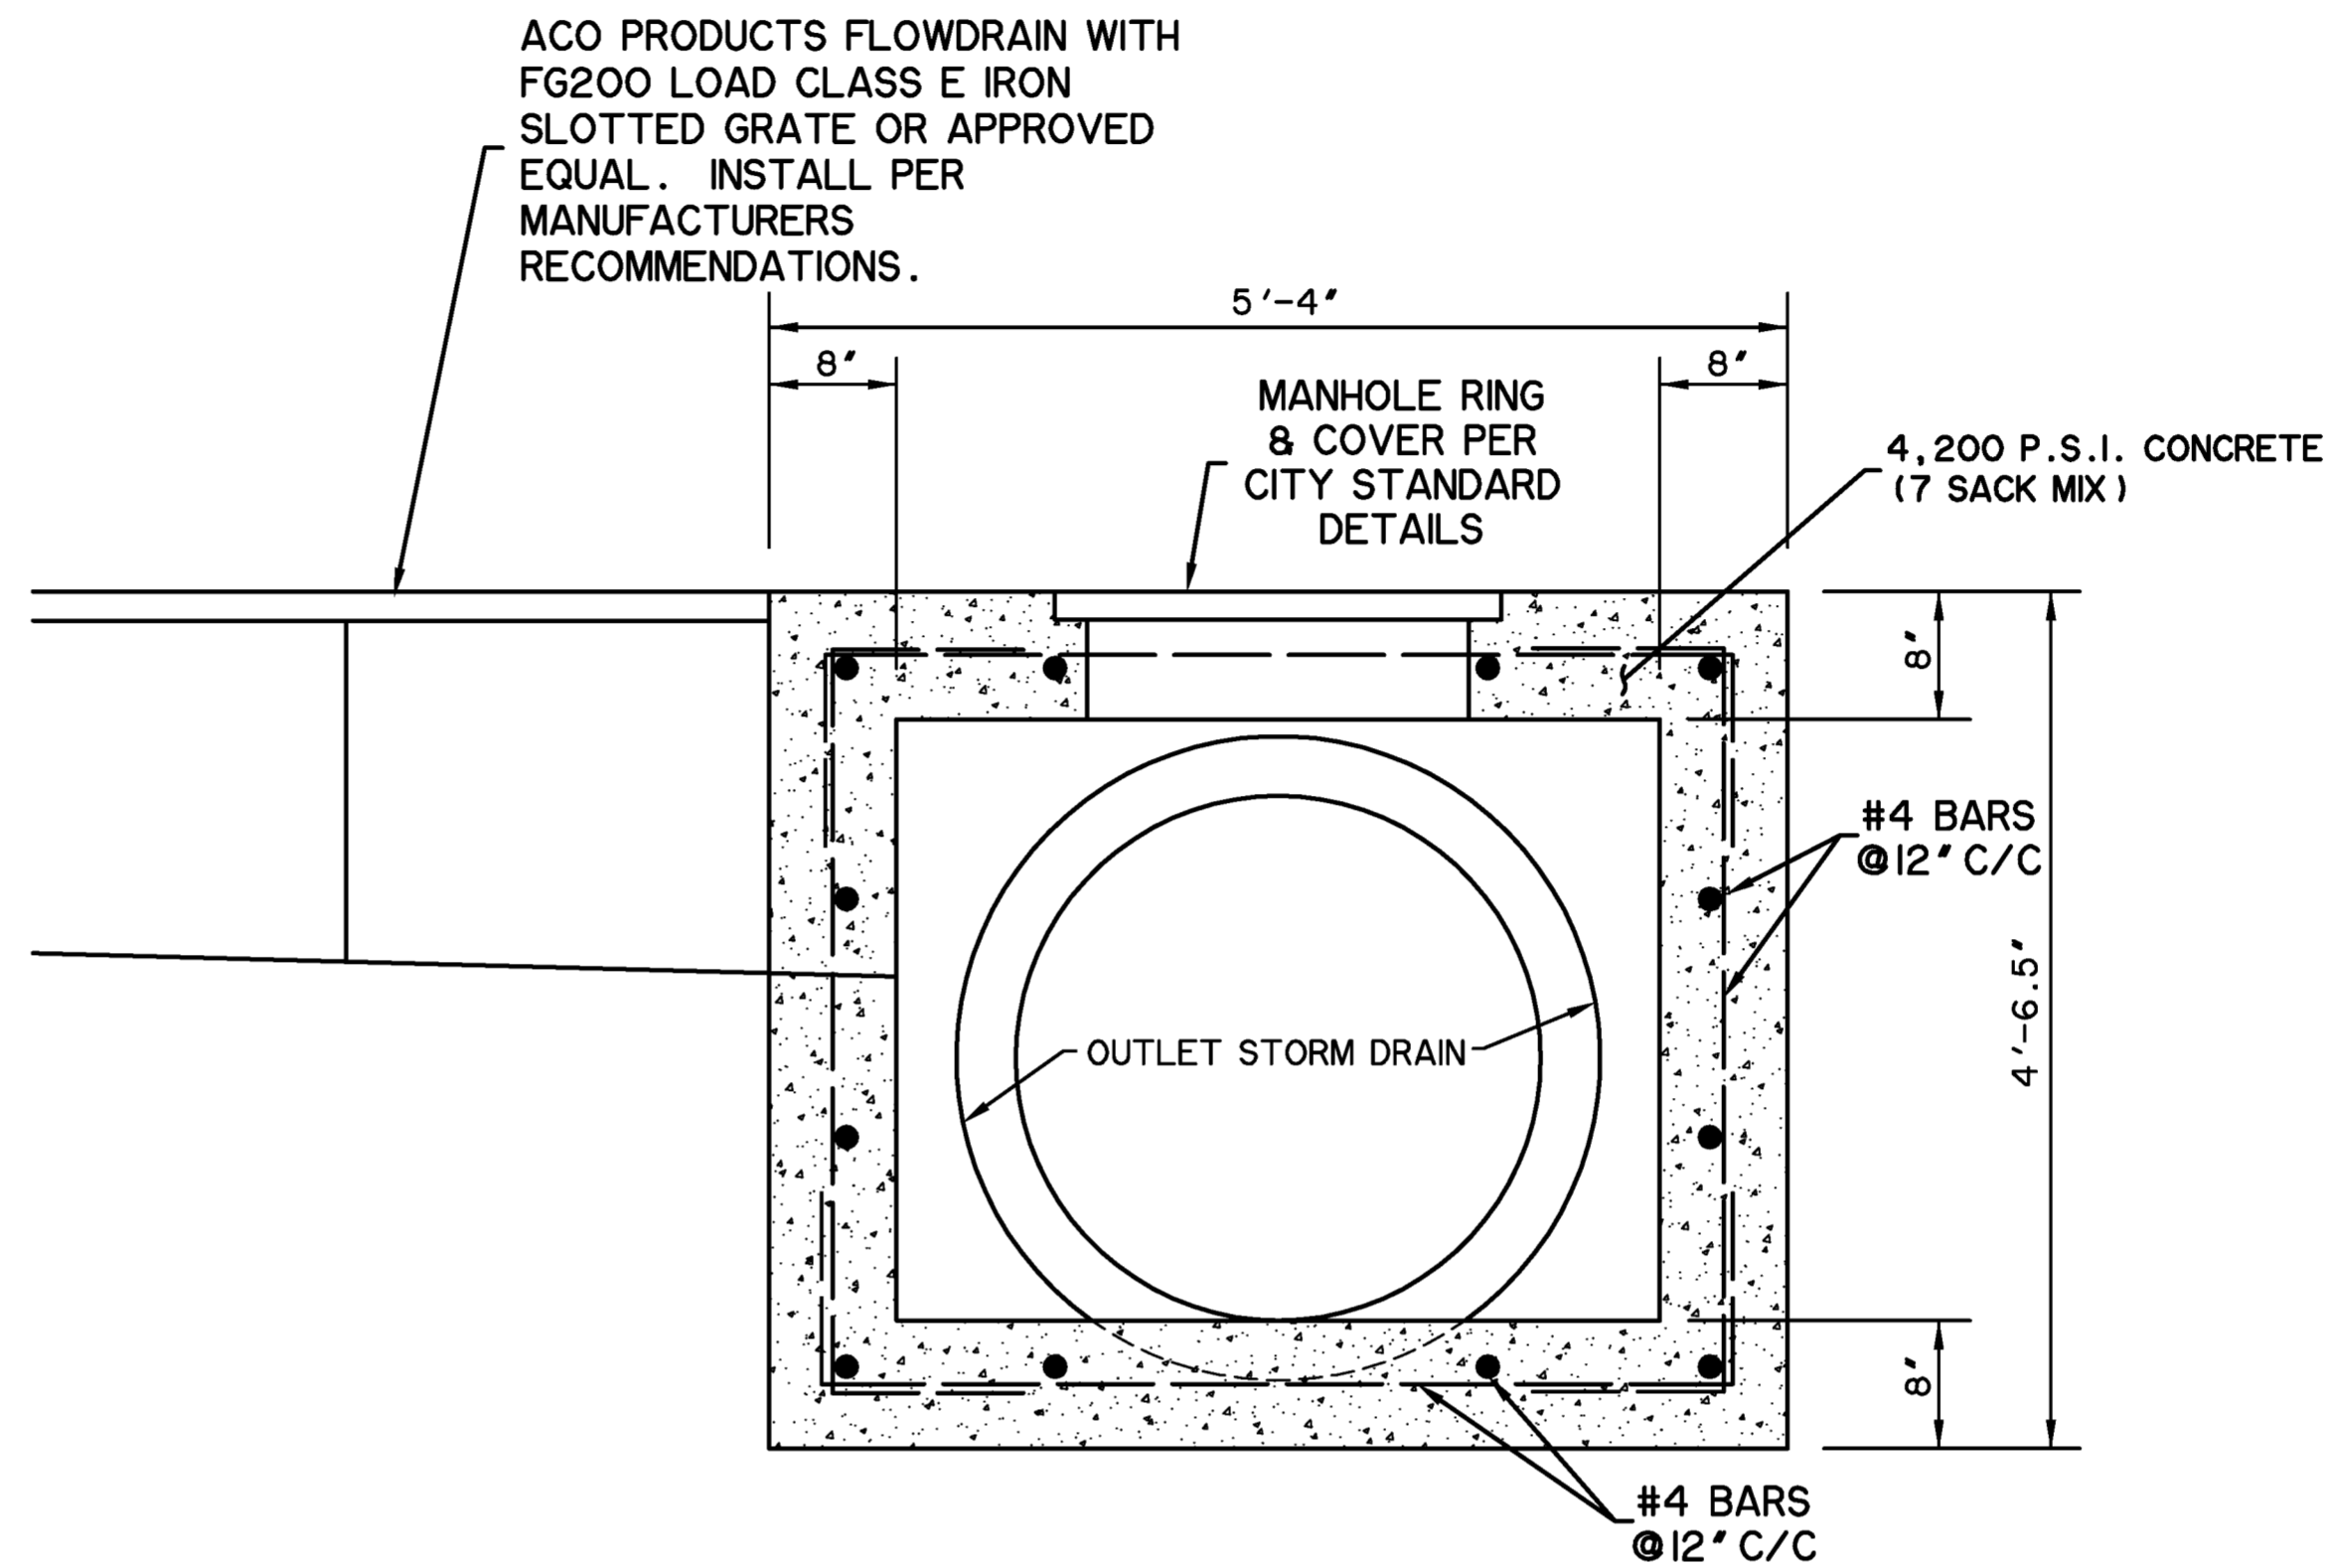


**TRENCH DRAIN & JUNCTION BOX (PRIVATE)**  
N.T.S.

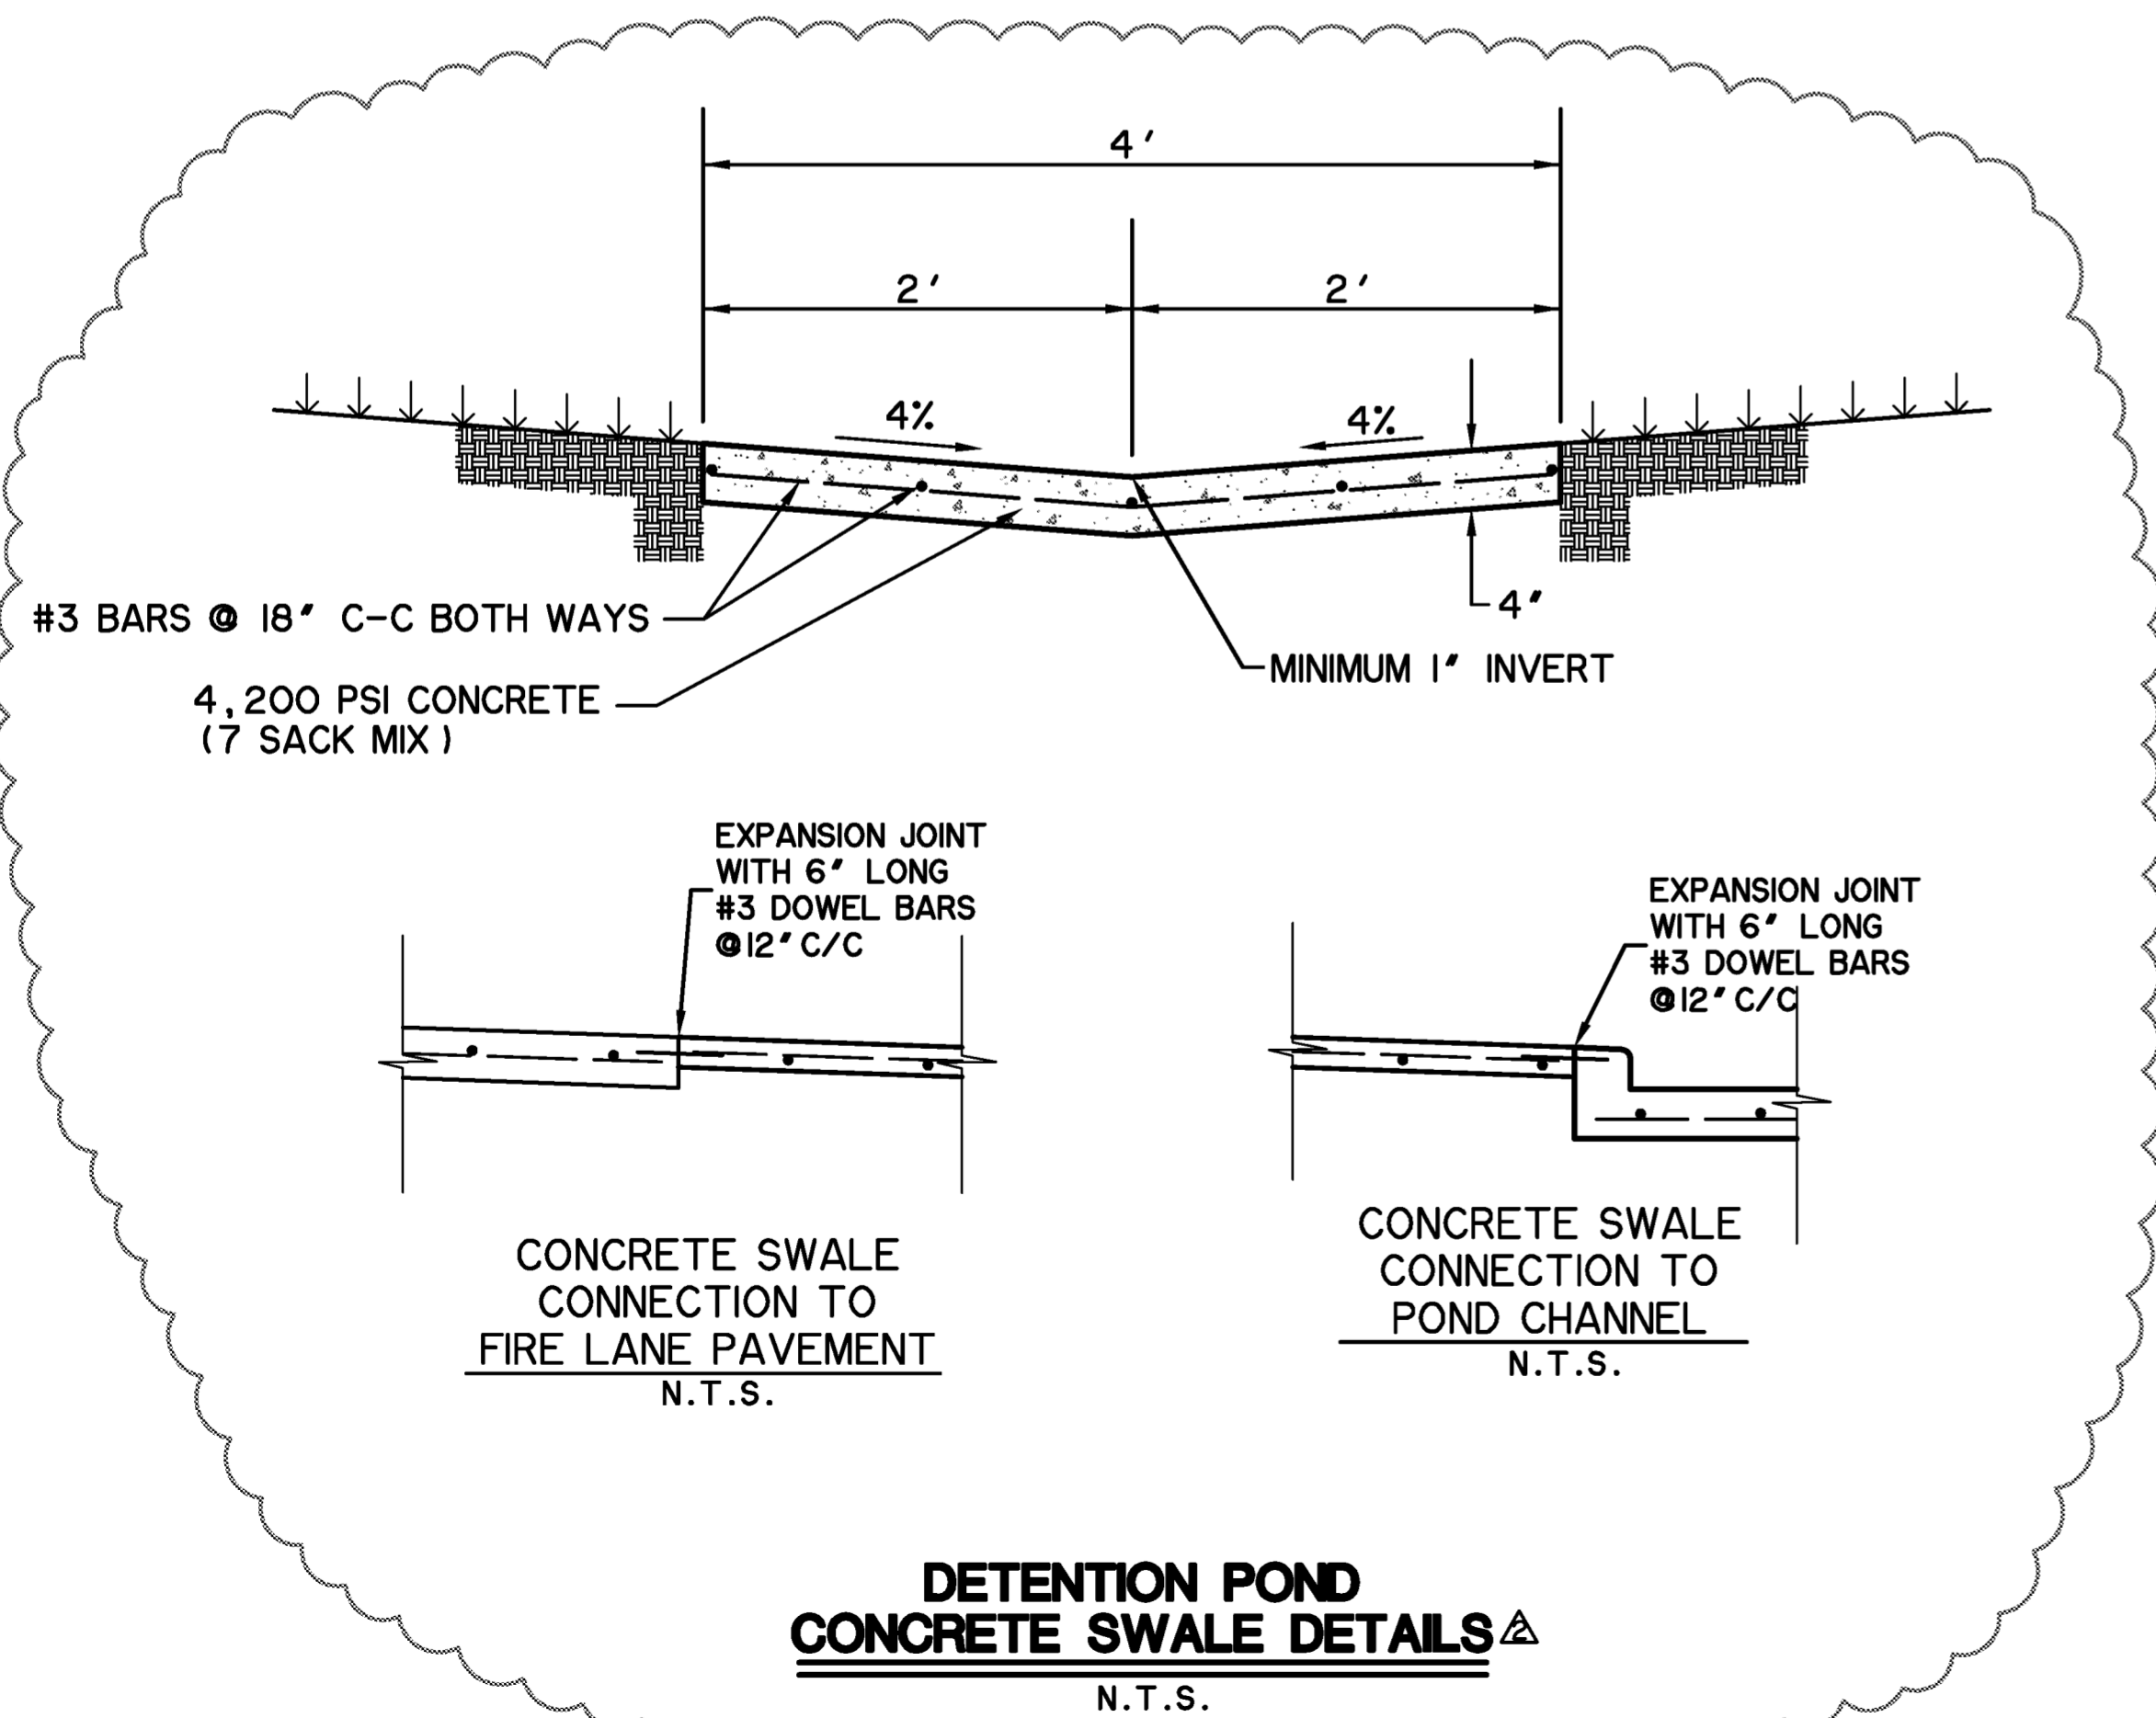


**DETENTION POND CONCRETE SWALE DETAILS**  
N.T.S.

RECORD PLANS  
October 28, 2015


| REVISIONS                     | DATE     | BY  |
|-------------------------------|----------|-----|
| ▲ ADDED CONCRETE SWALE DETAIL | 02/11/15 | PLG |
|                               |          |     |
|                               |          |     |

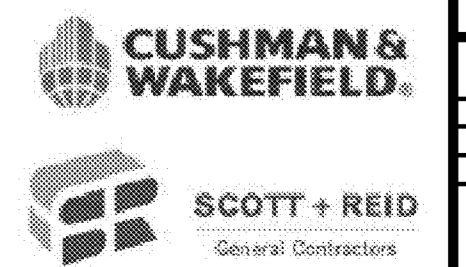

PREPARED BY:  
**WIER & ASSOCIATES, INC.**  
ENGINEERS SURVEYORS LAND PLANNERS  
2201 E. LAMAR BLVD., SUITE 200E ARLINGTON, TEXAS 76006 METRO (817)467-7700  
www.wierassociates.com  
Texas Firm Registration No. F-2776

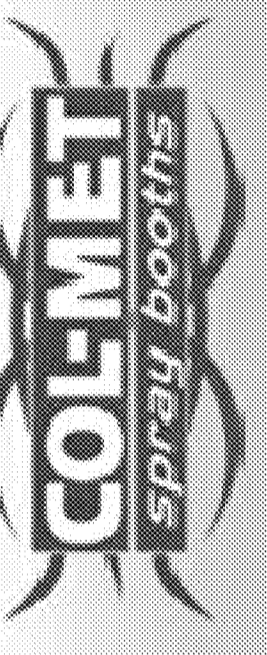

LOT 3, BLOCK B  
ROCKWALL TECHNOLOGY PARK PHASE I  
COL-MET SPRAY BOOTHS  
DRAINAGE DETAILS

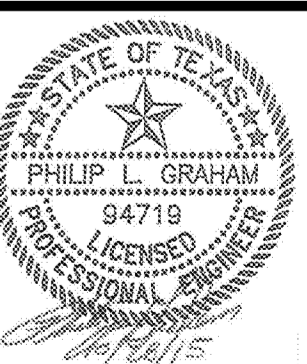


COPYRIGHT ©  
WIER & ASSOCIATES, INC.  
LAST SHEET EDIT  
DATE 10/28/2015  
WA# 14029  
**SHEET NO.**  
C-D303

DATE: FILE: **DISCLAIMER:** The use of this standard is governed by the "Texas Engineering Practice Act". No warranty of any kind is made by TxDOT for any purpose whatsoever. TxDOT assumes no responsibility for the conversion of this standard to other formats or for incorrect results or damages resulting from its use.


- ④ Riprap placed beyond the limits shown with Item 432, "Riprap".
- ⑤ Riprap in accordance with the limits shown will be paid as Concrete
- ⑥ Recommended values of side slope are 3:1, 4:1, & 6:1. All quantities, calculations, and dimensions shown herein are based on these recommended values. Slope of 3:1 or flatter is required for vehicle safety.
- ⑦ Note that actual slope of Pipe Runner may vary slightly from Side Slope of Riprap and trimmed Culvert Pipe edge.
- ⑧ Core shall be taken to ensure that Riprap concrete does not flow into the Cross Pipe so as to permit disassembly of the bolted connection to allow cleanout access.
- ⑨ After installation, the 1/2" hole shall be inspected to ensure that the top of the Pipe Runner with the Bottom Anchor Pipe is adequate.
- ⑩ At fabricator's option, a heat bend to a smooth 5" radius or a manufactured elbow (of the same material as the Runner) may be substituted for the mitered and welded joint in the Bottom Anchor Pipe.

**GENERAL NOTES:**  
 Pipe Runners are designed for a traversing load of 1,800 pounds at yield as recommended by Research Report 280-1, "Safety Treatment of Roadside Cross-Drainage Structures", Texas Transportation Institute, March 1981. The Safety End Treatments shown herein are intended for use in those installations where out of control vehicles are likely to traverse the openings approximately perpendicular to the Pipe Runners. Riprap and all necessary inverters shall be Concrete Riprap conforming to the requirements of Item 432, "Riprap". Synthetic fibers listed on the "Fibers for Concrete" Material Producer List (MPL) may be used in lieu of steel reinforcing in riprap concrete unless noted otherwise. Payment for riprap and toewall is included in the Price Bid for each Safety End Treatment. Pipe Runners, Cross Pipes, and Anchor Pipes shall conform to the requirements of ASTM A53 (Type E or S, Grade B), ASTM A500 (Grade B), or API 5LX52. Bolts and nuts shall conform to ASTM A307, All steel components, except concrete reinforcing, shall be galvanized after fabrication. Galvanizing damaged during transport or construction shall be repaired in accordance with the specifications.

**BOTTOM ANCHOR PIPE DETAILS**

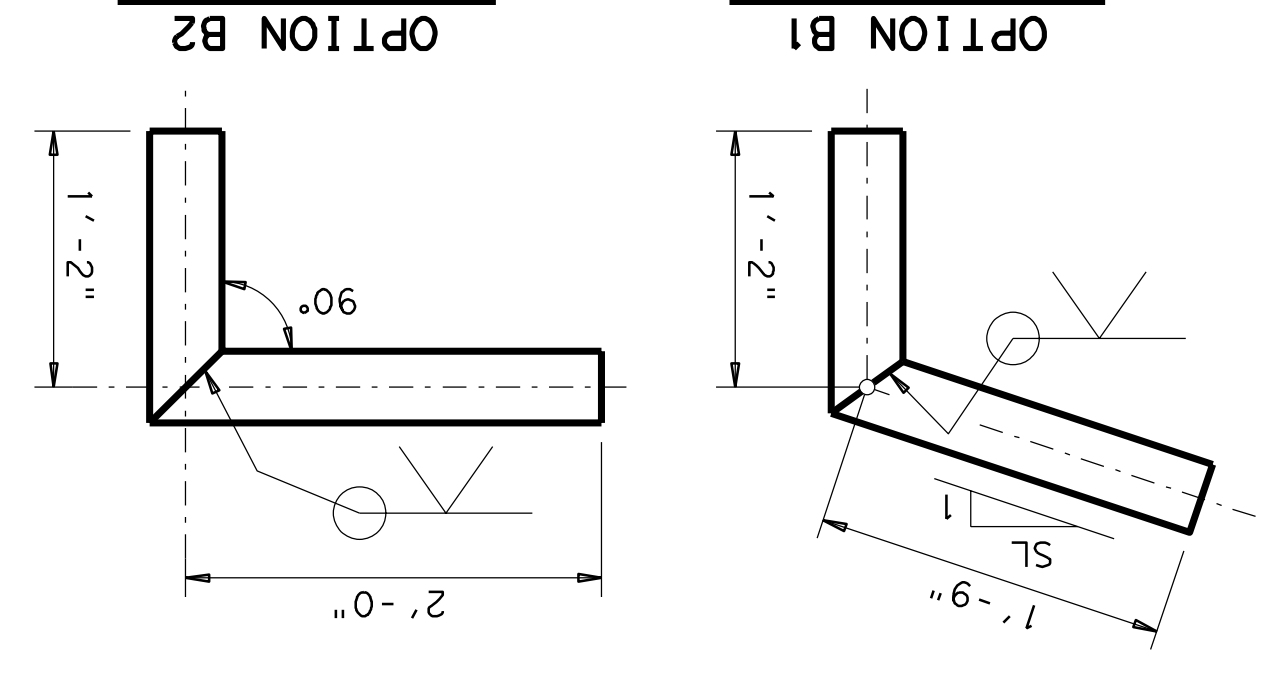


**PIPE RUNNER DETAILS**

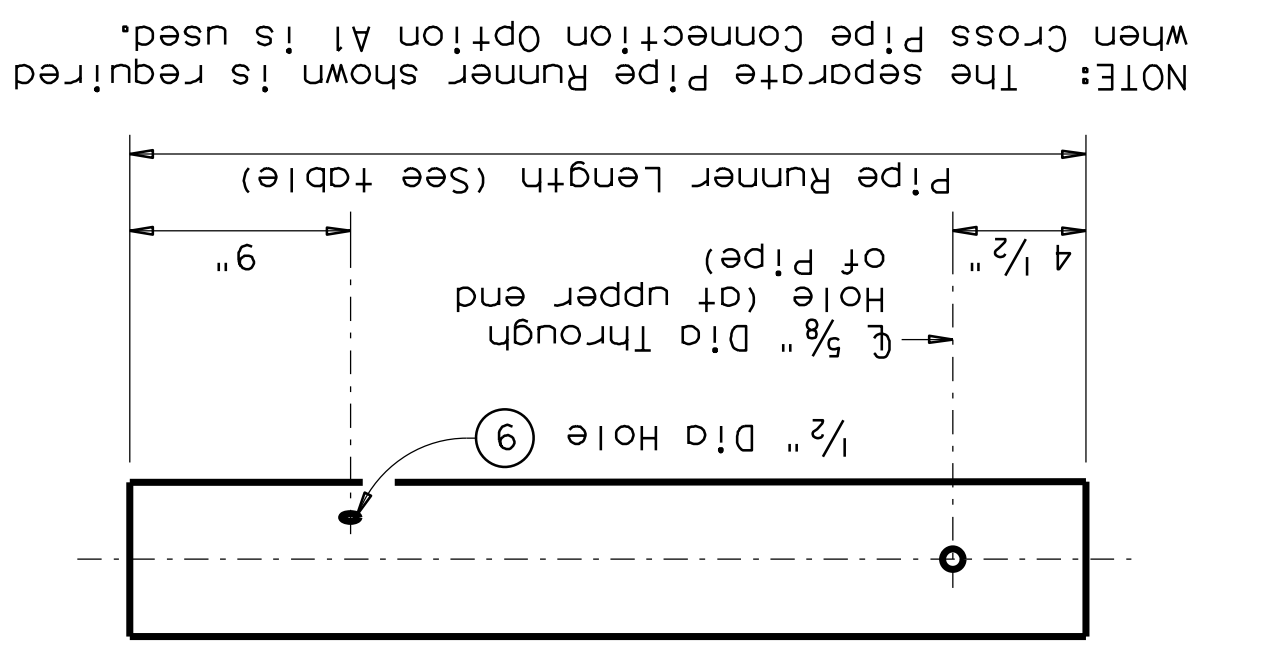


NOTE: The separate Pipe Runner shown is required when Cross Pipe Connection Option A1 is used.

**CROSS PIPE AND CONNECTIONS DETAILS**

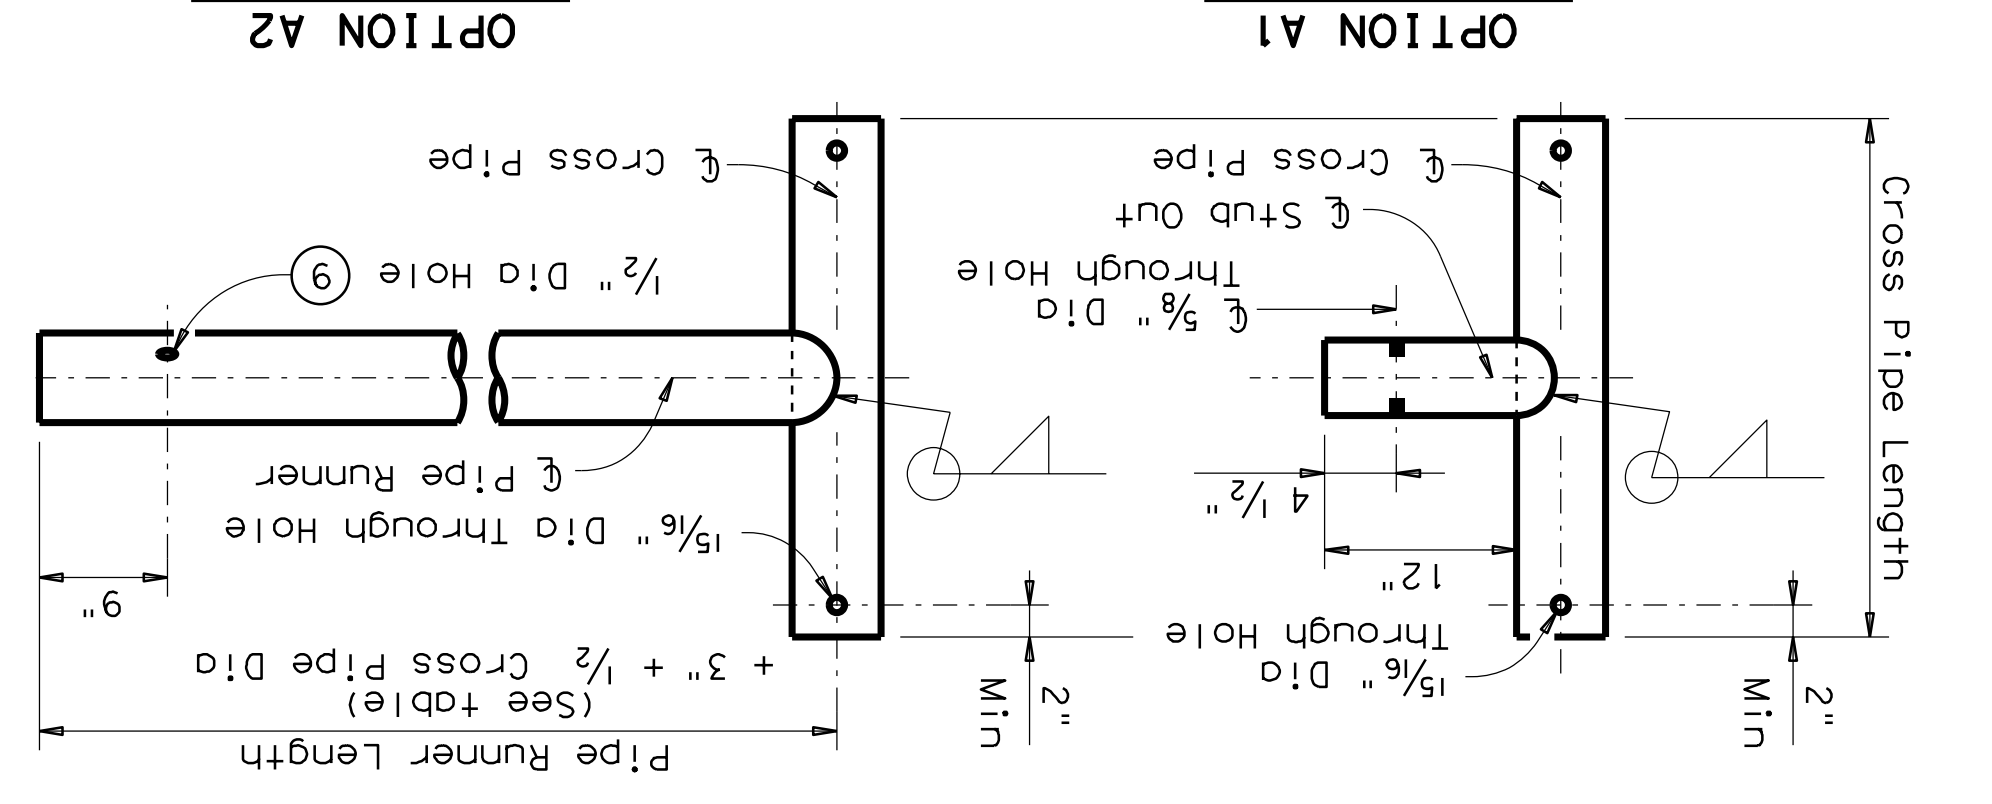


**BOTTOM ANCHOR TOEWALL DETAILS**

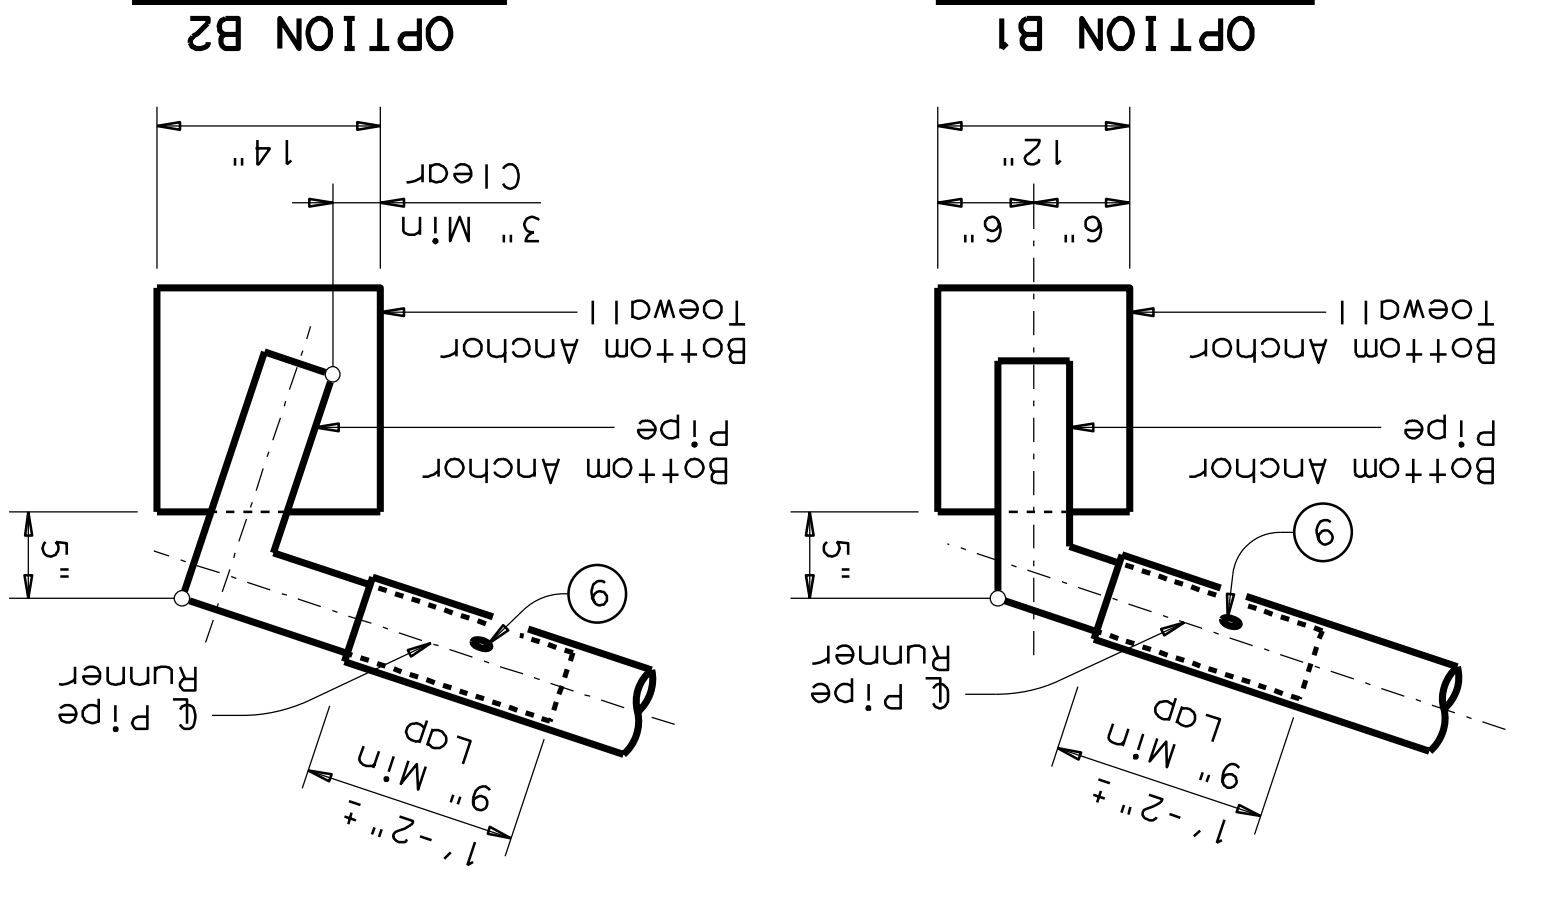


(Culvert & Riprap not shown for clarity)

**SIDE ELEVATION OF SAFETY END TREATMENT INSTALLATION**

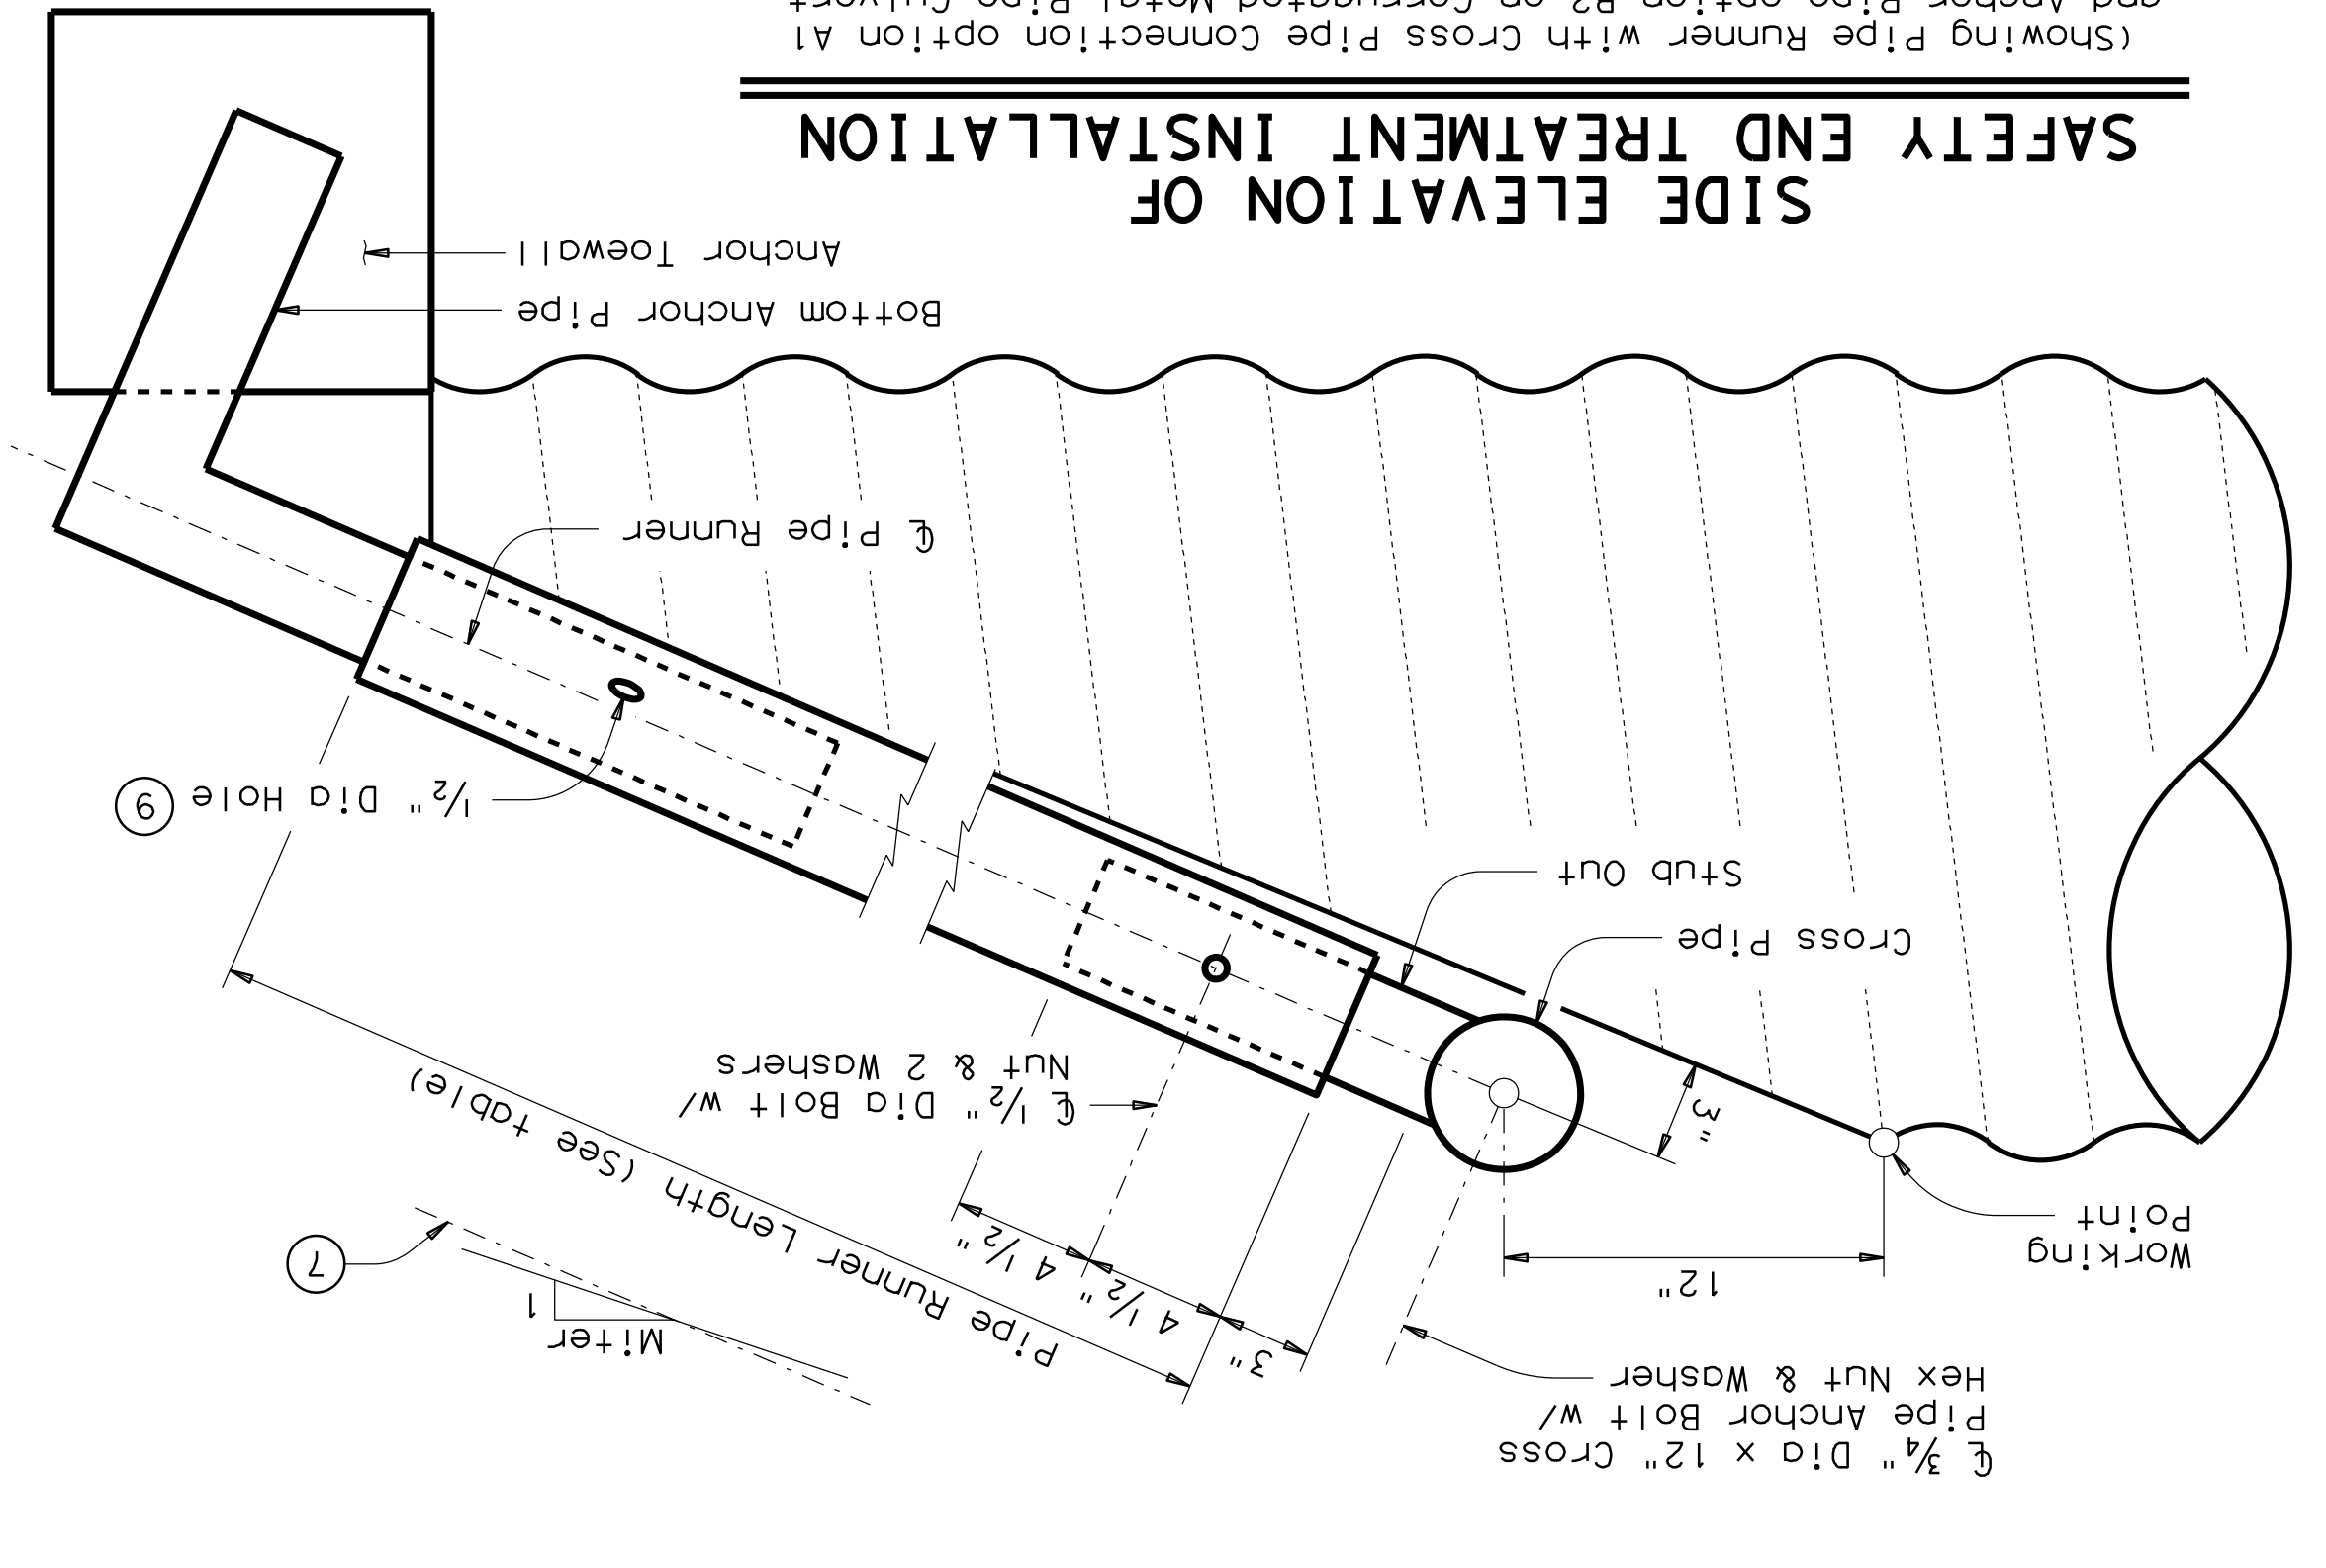


(Showing Pipe Runner with Cross Pipe Connection option A1 and Anchor Pipe option B2 on Corrugated Metal Pipe Culvert. Concrete Pipe Culvert details are similar. Riprap not shown for clarity)

**SECTION A-A**

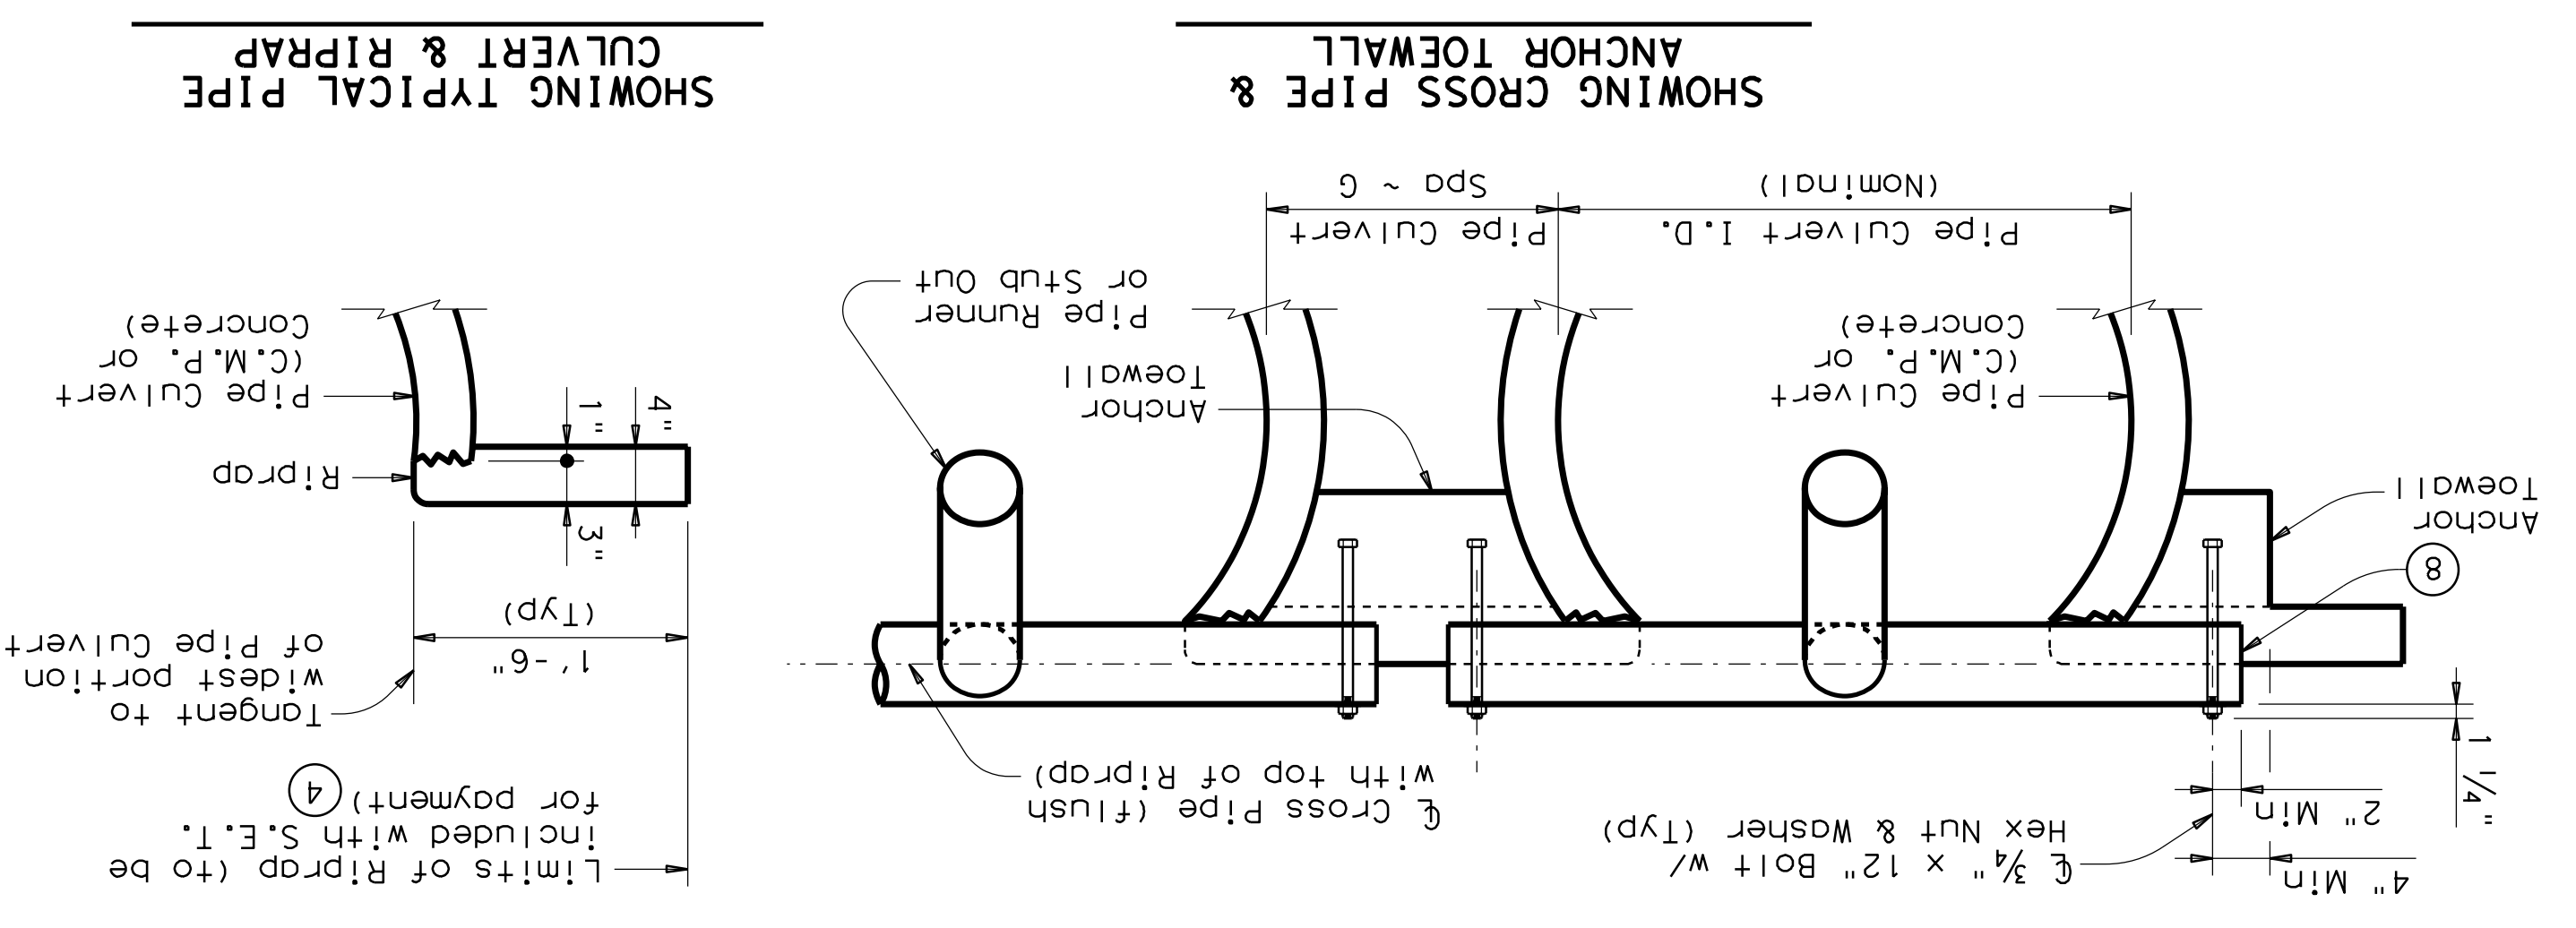


SHOWING CROSS PIPE & ANCHOR TOEWALL

**SHOWING TYPICAL PIPE CULVERT & RIPRAP**

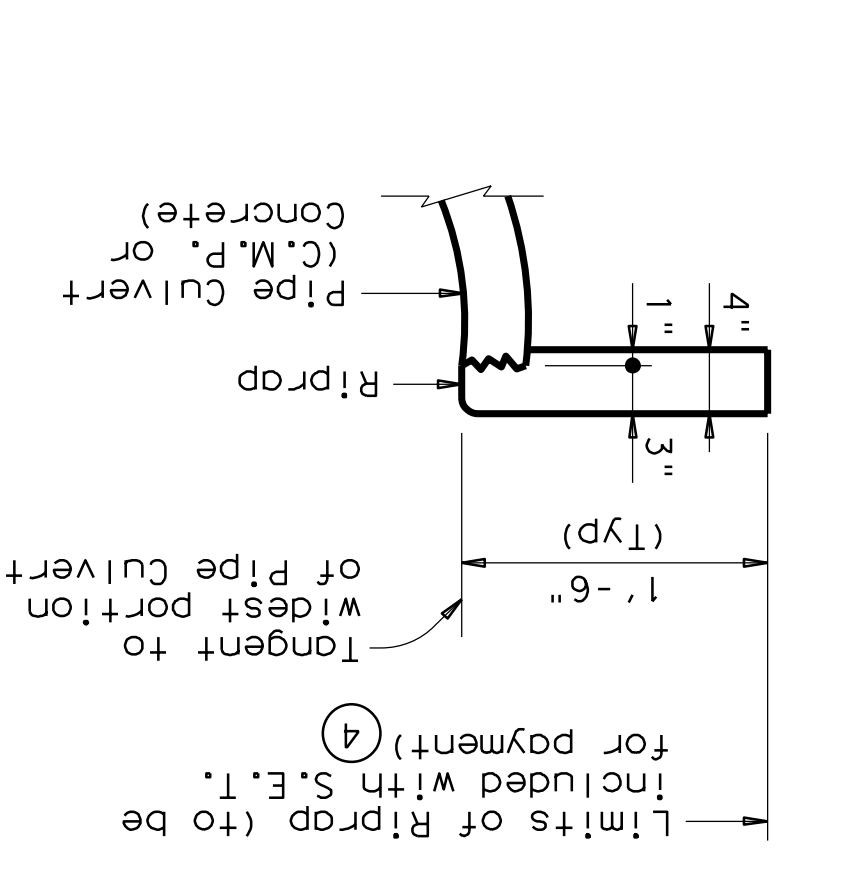

**PLAN OF SKEWED INSTALLATION**

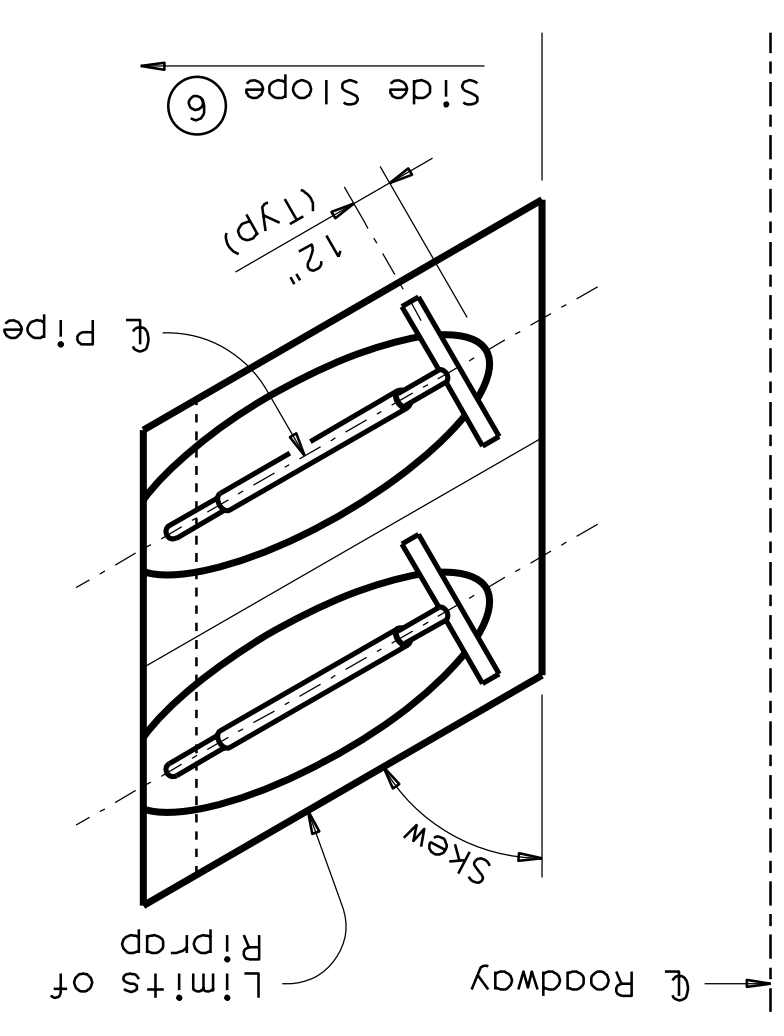

**RECORD PLANS**  
 October 28, 2015

11-10. Add note for synthetic fibers.

REVISIONS


|                        |                |              |              |                  |
|------------------------|----------------|--------------|--------------|------------------|
| FILE: setpdsae.dgn     | DN: GAF        | CK: CAT      | DM: JRP      | CR: GAF          |
| PROJECT: February 2010 | CONTRACT: SECT | JOB: HIGHWAY | COUNTY: DIST | SHEET NO: C-D305 |

**SAFETY END TREATMENT FOR 12" DIA TO 60" DIA PIPE CULVERTS TYPE II ~ CROSS DRAINAGE SETP-CD**

Texas Department of Transportation  
 Bridge Division Standard


SHEET 2 OF 2

**NOTE:** All Pipe Runners, calculations, and dimensions are based on the pipe culverts mitered as shown in this detail. Alternate styles of mitered ends will require that appropriate adjustments be made to the values presented on this standard.

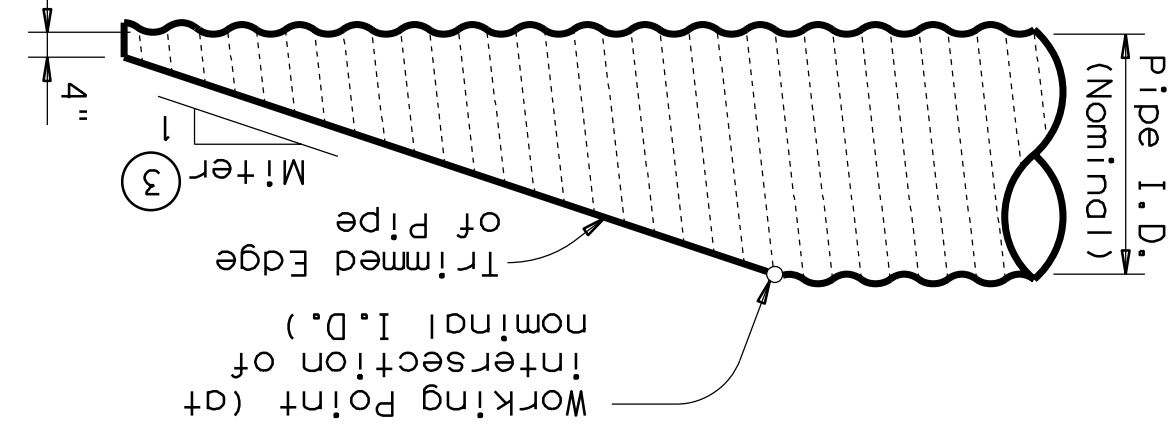


**SIDE ELEVATION OF TYPICAL PIPE CULVERT MITER**

(Showing Corrugated Metal Pipe Culvert. Details of Concrete Pipe Culvert are similar.)

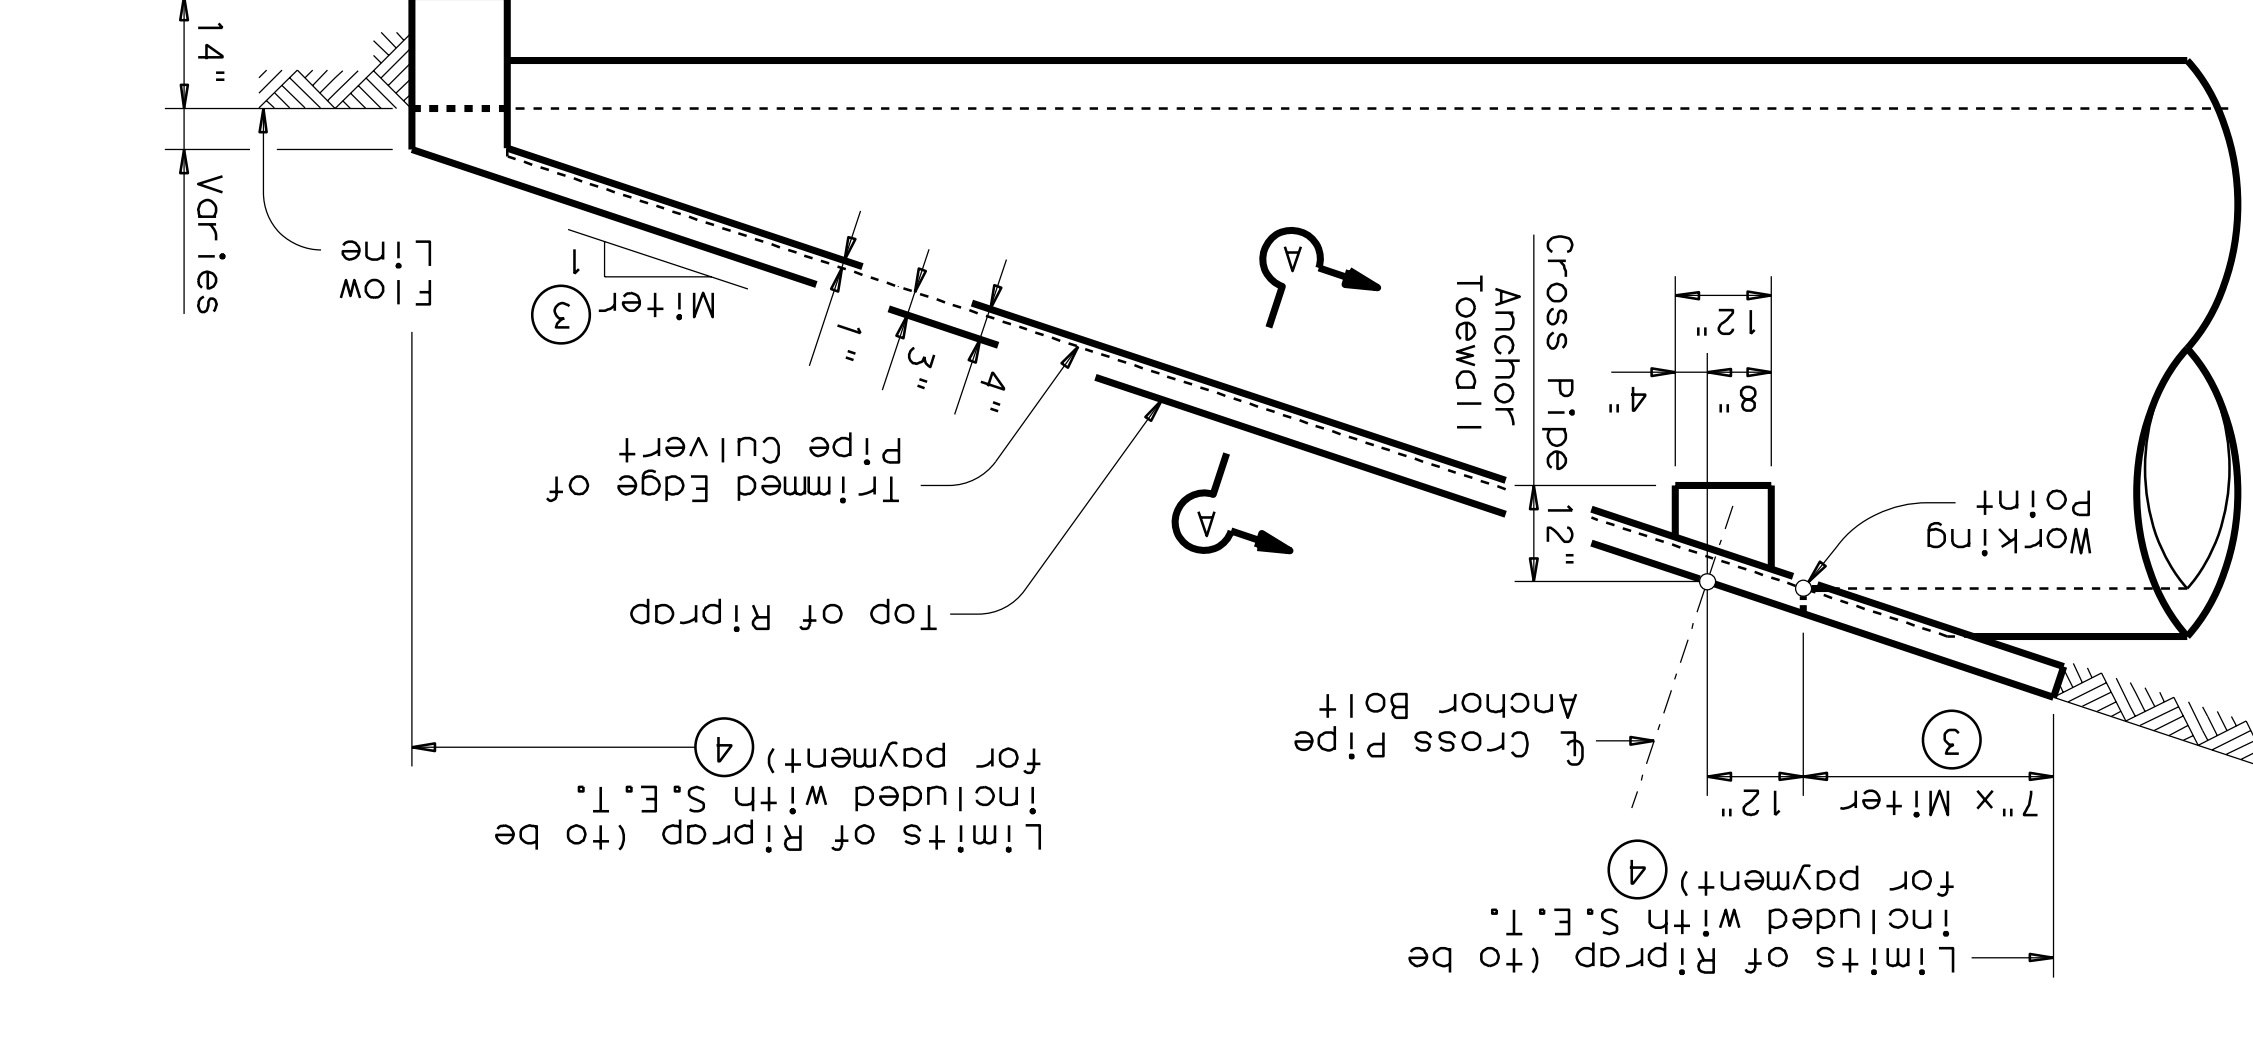

**SIDE ELEVATION OF CAST-IN-PLACE CONCRETE**

(Showing Concrete Pipe Culvert. Details of Corrugated Metal Pipe Culvert are similar. Pipe Runners not shown for clarity.)

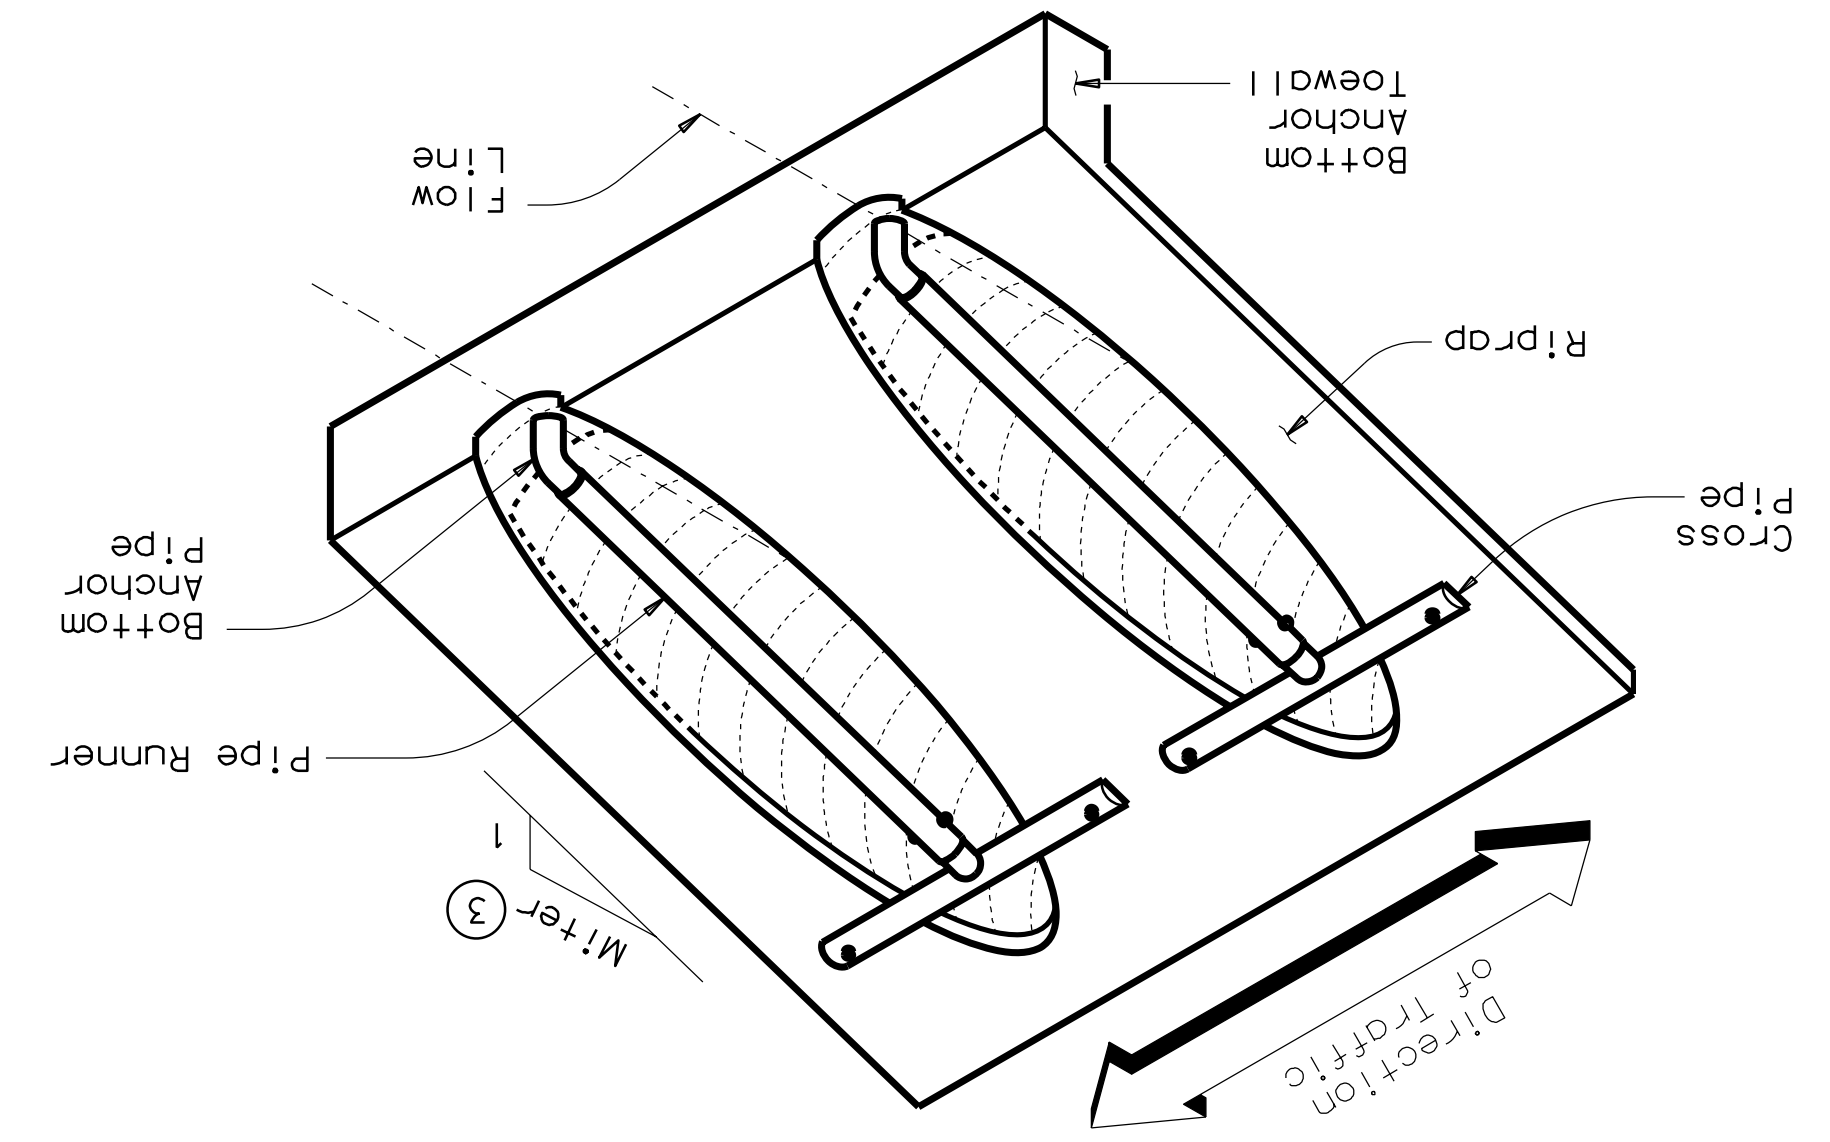

**ISOMETRIC VIEW OF TYPICAL INSTALLATION**

(Showing installation with no skew.)

① Size of Pipe Runner shall be as shown in the tables. Cross Pipe and Bottom Anchor Pipe shall be the next smaller size pipe as shown in the STANDARD PIPE SIZES table.

② This standard allows for the placement of only one pipe runner across each culvert pipe opening. In order to limit the clear opening to be traversed by an errant vehicle, the following conditions must be met:  
 For 60" culvert pipes, the skew must not exceed 0°. For 54" culvert pipes, the skew must not exceed 15°. For 48" culvert pipes, the skew must not exceed 30°. For all culvert pipe sizes 42" and less, the skew must not exceed 45°.

③ If the above conditions cannot be met, the designer should consider using a safety end treatment with flared wings. For further information, refer to the TxDOT "Roadway Design Manual".

④ Riprap placed beyond the limits shown will be paid as Concrete Miter = Slope of Mitered Pipe Culvert End

⑤ Quantities shown are for one end of one reinforced concrete pipe culvert. For multiple pipe culverts or for corrugated metal pipe culverts, quantities will need to be adjusted. Riprap quantities are for Contractor's information only.

**① CROSS PIPE LENGTHS & PIPE RUNNER LENGTHS**

| Nominal Culvert I.D. | Pipe I.D. | Cross Pipe Length | 4:1 Side Slope |          |          |          |         |          | 6:1 Side Slope |          |         |          |          |          |        |         |
|----------------------|-----------|-------------------|----------------|----------|----------|----------|---------|----------|----------------|----------|---------|----------|----------|----------|--------|---------|
|                      |           |                   | 0° Skew        | 15° Skew | 30° Skew | 45° Skew | 0° Skew | 15° Skew | 30° Skew       | 45° Skew | 0° Skew | 15° Skew | 30° Skew | 45° Skew |        |         |
| 60"                  | 3'-3"     | 6'-5"             | 13'-3"         | N/A      | N/A      | N/A      | N/A     | 17'-9"   | 15'-8"         | 16'-3"   | N/A     | N/A      | N/A      | 26'-10"  | N/A    | N/A     |
| 54"                  | 3'-0"     | 5'-11"            | 11'-8"         | 12'-1"   | N/A      | N/A      | N/A     | 15'-8"   | 16'-3"         | N/A      | N/A     | N/A      | N/A      | 23'-10"  | 24'-8" | N/A     |
| 48"                  | 2'-7"     | 5'-5"             | 10'-1"         | 10'-5"   | 11'-9"   | N/A      | N/A     | 13'-7"   | 14'-2"         | 15'-10"  | N/A     | N/A      | N/A      | 20'-9"   | 21'-6" | 24'-2"  |
| 42"                  | 2'-4"     | 4'-11"            | 8'-6"          | 8'-10"   | 9'-11"   | 12'-4"   | 12'-7"  | 11'-7"   | 12'-0"         | 13'-6"   | 16'-8"  | 17'-9"   | 18'-5"   | 20'-8"   | 21'-7" | 25'-7"  |
| 36"                  | 2'-1"     | 4'-5"             | 6'-11"         | 7'-3"    | 8'-2"    | 10'-2"   | 10'-2"  | 9'-6"    | 9'-11"         | 11'-2"   | 13'-10" | 14'-9"   | 15'-3"   | 17'-2"   | 21'-3" | 19'-2"  |
| 33"                  | 1'-11"    | 4'-2"             | 6'-2"          | 6'-5"    | 7'-3"    | 9'-1"    | 8'-6"   | 8'-6"    | 8'-10"         | 10'-0"   | 12'-5"  | 13'-3"   | 13'-9"   | 15'-5"   | 19'-2" | 17'-0"  |
| 30"                  | 1'-10"    | 3'-11"            | N/A            | N/A      | 6'-4"    | 8'-0"    | N/A     | N/A      | N/A            | 8'-9"    | 11'-0"  | N/A      | N/A      | 13'-8"   | 17'-0" | 14'-11" |
| 27"                  | 1'-8"     | 3'-8"             | N/A            | N/A      | 5'-5"    | 6'-11"   | 7'-7"   | 7'-7"    | 7'-7"          | 9'-7"    | 11'-11" | N/A      | N/A      | 14'-11"  | 17'-9" | 12'-9"  |
| 24"                  | 1'-7"     | 3'-5"             | N/A            | N/A      | 5'-10"   | 6'-10"   | N/A     | N/A      | N/A            | 8'-1"    | 10'-1"  | N/A      | N/A      | 12'-9"   | 15'-9" | 12'-9"  |
| 21"                  | 1'-6"     | 3'-4"             | N/A            | N/A      | 5'-9"    | 6'-9"    | N/A     | N/A      | N/A            | 8'-0"    | 10'-0"  | N/A      | N/A      | 12'-8"   | 15'-8" | 12'-8"  |
| 18"                  | 1'-5"     | 3'-3"             | N/A            | N/A      | 5'-8"    | 6'-8"    | N/A     | N/A      | N/A            | 7'-11"   | 10'-1"  | N/A      | N/A      | 12'-7"   | 15'-7" | 12'-7"  |
| 15"                  | 1'-4"     | 3'-2"             | N/A            | N/A      | 5'-7"    | 6'-7"    | N/A     | N/A      | N/A            | 7'-10"   | 10'-0"  | N/A      | N/A      | 12'-6"   | 15'-6" | 12'-6"  |
| 12"                  | 1'-3"     | 3'-1"             | N/A            | N/A      | 5'-6"    | 6'-6"    | N/A     | N/A      | N/A            | 7'-9"    | 9'-11"  | N/A      | N/A      | 12'-5"   | 15'-5" | 12'-5"  |

**② TYPICAL PIPE CULVERT MITERS**

| Slope | Nominal Culvert I.D. | 4:1 Side Slope |          |          |          | 6:1 Side Slope |          |          |          |
|-------|----------------------|----------------|----------|----------|----------|----------------|----------|----------|----------|
|       |                      | 0° Skew        | 15° Skew | 30° Skew | 45° Skew | 0° Skew        | 15° Skew | 30° Skew | 45° Skew |
| 0°    | 42" to 60"           | 36"            | 36"      | 36"      | 36"      | 36"            | 36"      | 36"      | 36"      |
| 15°   | 42" to 60"           | 36"            | 36"      | 36"      | 36"      | 36"            | 36"      | 36"      | 36"      |
| 30°   | 42" to 60"           | 36"            | 36"      | 36"      | 36"      | 36"            | 36"      | 36"      | 36"      |
| 45°   | 42" to 60"           | 36"            | 36"      | 36"      | 36"      | 36"            | 36"      | 36"      | 36"      |

**③ CONDITIONS WHERE PIPE RUNNERS ARE NOT REQUIRED**

| Slope | Nominal Culvert I.D. | 4:1 Side Slope |          |          |          | 6:1 Side Slope |          |          |          |
|-------|----------------------|----------------|----------|----------|----------|----------------|----------|----------|----------|
|       |                      | 0° Skew        | 15° Skew | 30° Skew | 45° Skew | 0° Skew        | 15° Skew | 30° Skew | 45° Skew |
| 0°    | 42" to 60"           | 36"            | 36"      | 36"      | 36"      | 36"            | 36"      | 36"      | 36"      |
| 15°   | 42" to 60"           | 36"            | 36"      | 36"      | 36"      | 36"            | 36"      | 36"      | 36"      |
| 30°   | 42" to 60"           | 36"            | 36"      | 36"      | 36"      | 36"            | 36"      | 36"      | 36"      |
| 45°   | 42" to 60"           | 36"            | 36"      | 36"      | 36"      | 36"            | 36"      | 36"      | 36"      |

**④ STANDARD PIPE SIZES & MAX PIPE RUNNER LENGTHS**

| Slope | Nominal Culvert I.D. | 4:1 Side Slope |          |          |          | 6:1 Side Slope |          |          |          |
|-------|----------------------|----------------|----------|----------|----------|----------------|----------|----------|----------|
|       |                      | 0° Skew        | 15° Skew | 30° Skew | 45° Skew | 0° Skew        | 15° Skew | 30° Skew | 45° Skew |
| 0°    | 42" to 60"           | 36"            | 36"      | 36"      | 36"      | 36"            | 36"      | 36"      | 36"      |
| 15°   | 42" to 60"           | 36"            | 36"      | 36"      | 36"      | 36"            | 36"      | 36"      | 36"      |
| 30°   | 42" to 60"           | 36"            | 36"      | 36"      | 36"      | 36"            | 36"      | 36"      | 36"      |
| 45°   | 42" to 60"           | 36"            | 36"      | 36"      | 36"      | 36"            | 36"      | 36"      | 36"      |

**⑤ ESTIMATED CONCRETE RIPRAP QUANTITIES (CY)**

| Nominal Culvert I.D. | Slope | 4:1 Side Slope |          |          |          | 6:1 Side Slope |          |          |          |
|----------------------|-------|----------------|----------|----------|----------|----------------|----------|----------|----------|
|                      |       | 0° Skew        | 15° Skew | 30° Skew | 45° Skew | 0° Skew        | 15° Skew | 30° Skew | 45° Skew |
| 60"                  | 0°    | 0.4            | 0.5      | 0.5      | 0.5      | 0.8            | 0.9      | 0.9      | 0.9      |
| 54"                  | 0°    | 0.5            | 0.6      | 0.6      | 0.6      | 0.9            | 1.0      | 1.0      | 1.0      |
| 48"                  | 0°    | 0.6            | 0.7      | 0.7      | 0.7      | 1.0            | 1.1      | 1.1      | 1.1      |
| 42"                  | 0°    | 0.7            | 0.8      | 0.8      | 0.8      | 1.1            | 1.2      | 1.2      | 1.2      |
| 36"                  | 0°    | 0.8            | 0.9      | 0.9      | 0.9      | 1.2            | 1.3      | 1.3      | 1.3      |
| 30"                  | 0°    | 0.9            | 1.0      | 1.0      | 1.0      | 1.3            | 1.4      | 1.4      | 1.4      |
| 24"                  | 0°    | 1.0            | 1.1      | 1.1      | 1.1      | 1.4            | 1.5      | 1.5      | 1.5      |
| 18"                  | 0°    | 1.1            | 1.2      | 1.2      | 1.2      | 1.5            | 1.6      | 1.6      | 1.6      |
| 12"                  | 0°    | 1.2            | 1.3      | 1.3      | 1.3      | 1.6            | 1.7      | 1.7      | 1.7      |
| 60"                  | 15°   | 0.4            | 0.5      | 0.5      | 0.5      | 0.8            | 0.9      | 0.9      | 0.9      |
| 54"                  | 15°   | 0.5            | 0.6      | 0.6      | 0.6      | 0.9            | 1.0      | 1.0      | 1.0      |
| 48"                  | 15°   | 0.6            | 0.7      | 0.7      | 0.7      | 1.0            | 1.1      | 1.1      | 1.1      |
| 42"                  | 15°   | 0.7            | 0.8      | 0.8      | 0.8      | 1.1            | 1.2      | 1.2      | 1.2      |
| 36"                  | 15°   | 0.8            | 0.9      | 0.9      | 0.9      | 1.2            | 1.3      | 1.3      | 1.3      |
| 30"                  | 15°   | 0.9            | 1.0      | 1.0      | 1.0      | 1.3            | 1.4      | 1.4      | 1.4      |
| 24"                  | 15°   | 1.0            | 1.1      | 1.1      | 1.1      | 1.4            | 1.5      | 1.5      | 1.5      |
| 18"                  | 15°   | 1.1            | 1.2      | 1.2      | 1.2      | 1.5            | 1.6      | 1.6      | 1.6      |
| 12"                  | 15°   | 1.2            | 1.3      | 1.3      | 1.3      | 1.6            | 1.7      | 1.7      | 1.7      |
| 60"                  | 30°   | 0.4            | 0.5      | 0.5      | 0.5      | 0.8            | 0.9      | 0.9      | 0.9      |
| 54"                  | 30°   | 0.5            | 0.6      | 0.6      | 0.6      | 0.9            | 1.0      | 1.0      | 1.0      |
| 48"                  | 30°   | 0.6            | 0.7      | 0.7      | 0.7      | 1.0            | 1.1      | 1.1      | 1.1      |
| 42"                  | 30°   | 0.7            | 0.8      | 0.8      | 0.8      | 1.1            | 1.2      | 1.2      | 1.2      |
| 36"                  | 30°   | 0.8            | 0.9      | 0.9      | 0.9      | 1.2            | 1.3      | 1.3      | 1.3      |
| 30"                  | 30°   | 0.9            | 1.0      | 1.0      | 1.0      | 1.3            | 1.4      | 1.4      | 1.4      |
| 24"                  | 30°   | 1.0            | 1.1      | 1.1      | 1.1      | 1.4            | 1.5      | 1.5      | 1.5      |
| 18"                  | 30°   | 1.1            | 1.2      | 1.2      | 1.2      | 1.5            | 1.6      | 1.6      | 1.6      |
| 12"                  | 30°   | 1.2            | 1.3      | 1.3      | 1.3      | 1.6            | 1.7      | 1.7      | 1.7      |
| 60"                  | 45°   | 0.4            | 0.5      | 0.5      | 0.5      | 0.8            | 0.9      | 0.9      | 0.9      |
| 54"                  | 45°   | 0.5            | 0.6      | 0.6      | 0.6      | 0.9            | 1.0      | 1.0      | 1.0      |
| 48"                  | 45°   | 0.6            | 0.7      | 0.7      | 0.7      | 1.0            | 1.1      | 1.1      | 1.1      |
| 42"                  | 45°   | 0.7            | 0.8      | 0.8      | 0.8      | 1.1            | 1.2      | 1.2      | 1.2      |
| 36"                  | 45°   | 0.8            | 0.9      | 0.9      | 0.9      | 1.2            | 1.3      | 1.3      | 1.3      |
| 30"                  | 45°   | 0.9            | 1.0      | 1.0      | 1.0      | 1.3            | 1.4      | 1.4      | 1.4      |
| 24"                  | 45°   | 1.0            | 1.1      | 1.1      | 1.1      | 1.4            | 1.5      | 1.5      | 1.5      |
| 18"                  | 45°   | 1.1            | 1.2      | 1.2      | 1.2      | 1.5            | 1.6      | 1.6      | 1.6      |
| 12"                  | 45°   | 1.2            | 1.3      | 1.3      | 1.3      | 1.6            | 1.7      | 1.7      | 1.7      |

**Safety End Treatment**  
**FOR 12" DIA TO 60" DIA**  
**PIPE CULVERTS**  
**TYPE II ~ CROSS DRAINAGE**  
**SETP-CD**

Texas Department of Transportation  
 Bridge Division  
 Standard

SHEET 1 OF 2

|                       |         |         |         |         |          |
|-----------------------|---------|---------|---------|---------|----------|
| FILE: setpdcse.dgn    | DW: GAF | CK: CAT | DW: JRP | CK: GAF | HIGHWAY  |
| REVISIONS             | CONT    | SECT    | JOB     | COUNTY  | SHEET NO |
| ① TxDOT February 2010 |         |         |         |         | C-D304   |

11-10: Add note for synthetic fibers.

**RECORD PLANS**  
**October 28, 2015**

PRINTED: 10/28/2015 5TB FILE: WIER-EROSION-CONTROL.STB LAST SAVED: 10/28/2015 6:05 AM SAVED BY: PHILIP FILE: GRADING-NOTES-14029.DWG

GENERAL GRADING & DRAINAGE NOTES

1. EXISTING UTILITIES AND UNDERGROUND FACILITIES INDICATED ON THESE PLANS ARE BASED ON REFERENCE INFORMATION SUPPLIED BY VARIOUS OWNERS OF THE FACILITIES. THE ENGINEER DOES NOT ACCEPT THE RESPONSIBILITY FOR THE GRAPHICAL REPRESENTATION OF THE UTILITIES SHOWN. IT SHALL BE THE RESPONSIBILITY OF THE CONTRACTOR TO LOCATE ALL EXISTING UTILITIES AND UNDERGROUND FACILITIES, BOTH HORIZONTALLY AND VERTICALLY, PRIOR TO CONSTRUCTION, TO TAKE NECESSARY PRECAUTIONS IN ORDER TO PROTECT ALL FACILITIES ENCOUNTERED, AND TO NOTIFY THE ENGINEER PROMPTLY OF ALL CONFLICTS OF THE WORK WITH EXISTING FACILITIES. THE CONTRACTOR SHALL PRESERVE AND PROTECT ALL EXISTING UTILITIES FROM DAMAGE DURING CONSTRUCTION. ANY DAMAGE BY THE CONTRACTOR TO EXISTING UTILITIES SHALL BE REPAIRED BY THE CONTRACTOR AT HIS EXPENSE. EXISTING TOPOGRAPHIC INFORMATION SHOWN IS BASED ON IN-FIELD SURVEY PREPARED BY WIER & ASSOCIATES, INC. ON MARCH 5, 2014 AND JUNE 4 AND 5, 2014. (EXCLUDES BELOW GRADE PUBLIC UTILITY LOCATIONS PROVIDED BY UTILITY COMPANY AS DESCRIBED ABOVE.)
2. NEW FINISHED CONTOURS SHOWN ARE TOP OF PAVING IN AREAS TO RECEIVE PAVEMENT AND TOP OF TOPSOIL IN AREAS TO BE SEEDED.
3. AREAS OUTSIDE OF THE PARKING LOT PERIMETERS SHOWN TO BE SEEDED SHALL RECEIVE MINIMUM FOUR (4) INCHES OF TOPSOIL (OR TO DEPTH INDICATED ON LANDSCAPE ARCHITECT PLANS). THIS TOPSOIL TO BE PLACED AND LEVELED BY THE GRADING CONTRACTOR. THIS MATERIAL MAY BE STOCKPILED DURING STRIPPING OPERATIONS.
4. ROUGH GRADING ELEVATIONS SHALL BE AS FOLLOWS:  
FOUR INCHES BELOW FINISHED CONTOURS IN SEEDED AREAS.  
THE DEPTH OF PAVEMENT, TYPICALLY SIX TO EIGHT INCHES, BELOW FINISHED CONTOURS IN PAVED AREAS, UNLESS OTHERWISE NOTED.
5. DIMENSIONS ON BUILDINGS ARE FOR GRADING PURPOSES ONLY AND ARE NOT TO BE USED TO LAYOUT FOOTINGS.
6. GRADING CONTRACTOR SHALL NOTIFY AND COOPERATE WITH ALL UTILITY COMPANIES OR FIRMS HAVING FACILITIES ON OR ADJACENT TO THE SITE BEFORE DISTURBING, ALTERING, REMOVING, RELOCATING, ADJUSTING, OR CONNECTING TO SAID FACILITIES. CONTRACTOR SHALL PAY ALL COSTS IN CONNECTION WITH THE ALTERATION OF OR RELOCATION OF THE FACILITIES. CONTRACTOR SHALL RAISE OR LOWER TOPS OF EXISTING MANHOLES AS REQUIRED TO MATCH FINISHED GRADES IN CONFORMANCE WITH CITY STANDARDS.
7. GRADING CONTRACTOR SHALL COOPERATE AND WORK WITH ALL OTHER CONTRACTORS PERFORMING WORK ON THIS PROJECT TO INSURE PROPER AND TIMELY COMPLETION OF THIS PROJECT.
8. THE GRADING CONTRACTOR SHALL USE WHATEVER MEASURES ARE REQUIRED TO PREVENT SILT AND CONSTRUCTION DEBRIS FROM FLOWING ONTO ADJACENT PROPERTIES. THIS CAN BE ACCOMPLISHED BY SMALL TEMPORARY SEDIMENT PONDS, SILT FENCES OF STEEL WIRE AND BURLAP OR BARRIERS OF CEDAR TREES AND/OR BALES OF STRAW. CONTRACTOR SHALL COMPLY WITH ALL LOCAL EROSION, CONSERVATION AND SILTATION ORDINANCES. CONTRACTOR SHALL REMOVE ALL TEMPORARY EROSION CONTROL STRUCTURES UPON COMPLETION OF PERMANENT DRAINAGE FACILITIES AND THE ESTABLISHMENT OF A STAND OF GRASS SUFFICIENT TO PREVENT EROSION.
9. FOR THE WORK ON THE STATE OR CITY RIGHT-OF-WAY, THE GRADING CONTRACTOR SHALL:
  - A. NOT STORE MATERIAL, EXCESS DIRT OR EQUIPMENT ON THE SHOULDERS OF PAVEMENT, IN CASE OF MULTI-LANE HIGHWAYS, IN THE MEDIAN STRIPS. THE PAVEMENT SHALL BE KEPT FREE FROM ANY MUD OR EXCAVATION WASTE FROM TRUCKS OR OTHER EQUIPMENT. ON COMPLETION OF THE WORK, ALL EXCESS MATERIAL SHALL BE REMOVED FROM THE RIGHT-OF-WAY.
  - B. SHALL PROVIDE ALL NECESSARY AND ADEQUATE SAFETY PRECAUTIONS SUCH AS SIGNS, FLAGS, LIGHTS, BARRICADES AND FLAGMEN AS REQUIRED BY THE LOCAL AUTHORITIES AND IN ACCORDANCE WITH THE MANUAL ON UNIFORM TRAFFIC CONTROL DEVICES. THE GRADING CONTRACTOR SHALL BE SOLELY RESPONSIBLE FOR AND HOLD HARMLESS THE TEXAS DEPARTMENT OF TRANSPORTATION, THE CITY, AND THE OWNER FROM ANY CLAIMS FOR DAMAGE DONE TO EXISTING PRIVATE PROPERTY, PUBLIC UTILITIES OR TO THE TRAVELING PUBLIC.


- C. SHALL COMPLETE THE WORK TO THE SATISFACTION OF THE CITY PUBLIC WORKS DEPARTMENT AND OBTAIN A LETTER FROM THE DEPARTMENT STATING THAT THE WORK UNDER PUBLIC JURISDICTION IS ACCEPTABLE.
- D. POST NECESSARY BONDS AS REQUIRED BY THE CITY AND/OR STATE.
10. GRADING CONTRACTOR SHALL TAKE ALL AVAILABLE PRECAUTIONS TO CONTROL DUST. CONTRACTOR SHALL CONTROL DUST BY SPRINKLING, BY APPLYING CALCIUM CHLORIDE OR BY OTHER METHODS AS DIRECTED BY ENGINEER AND/OR OWNER'S REPRESENTATIVE AT NO ADDITIONAL COST TO OWNER.
11. REFER TO PAVING DETAILS FOR TYPE OF PAVING AND BASE TO BE USED.
12. GRADING CONTRACTOR IS RESPONSIBLE FOR REMOVING ANY EXISTING STRUCTURES, FENCES, DEBRIS OR TREES REMAINING ON SITE, UNLESS NOTED OTHERWISE ON PLANS AND SHALL COORDINATE WITH GENERAL CONTRACTOR.
13. GRADING CONTRACTOR TO COMPLY WITH ALL STATE AND LOCAL SEDIMENT CONTROL AND AIR POLLUTION ORDINANCES OR RULES.
14. A QUALIFIED SOILS LABORATORY SHALL DETERMINE THE SUITABILITY OF THE EXISTING SUBGRADE AND EXISTING ON-SITE MATERIAL PRIOR TO BEGINNING ANY FILLING OPERATION.
15. UNSUITABLE EXCAVATED MATERIALS AND ALL WASTE RESULTING FROM CLEARING AND GRUBBING SHALL BE DISPOSED OF OFF-SITE BY GRADING CONTRACTOR.
16. ALL EXCAVATING IS UNCLASSIFIED AND SHALL INCLUDE ALL MATERIALS ENCOUNTERED.
17. ALL AREAS NOT COVERED BY BUILDING, PAVING OR PLANNED LANDSCAPING, SHALL BE GRASSED ON THIS LOT WITHIN 14 DAYS OF CESSATION OF CONSTRUCTION ACTIVITIES. PUBLIC STREET PARKWAYS SHALL BE GRASSED IMMEDIATELY.
18. BEFORE ANY MACHINE WORK IS DONE, CONTRACTOR SHALL STAKE OUT AND MARK THE ITEMS ESTABLISHED BY THE SITE PLAN. CONTROL POINTS SHALL BE PRESERVED AT ALL TIMES DURING THE COURSE OF THE PROJECT. LACK OF PROPER WORKING POINTS AND GRADE STAKES MAY REQUIRE CESSATION OF OPERATIONS UNTIL SUCH POINTS AND GRADES HAVE BEEN PLACED TO THE OWNER'S SATISFACTION. NO EXTENSION OF TIME WILL BE GRANTED FOR THE ABOVE.
19. TEMPORARY EROSION CONTROL DEVICES TO BE INSTALLED PRIOR TO BEGINNING OF GRADING. CONTRACTOR SHALL MAINTAIN ALL TEMPORARY EROSION CONTROL DEVICES AND SHALL REMOVE SILT FROM BERM DITCHES, SILT DAMS AND SILT FENCES AS NEEDED.
20. ALL DISTURBED AREAS SHALL BE HYDROMULCH SEEDED UNLESS OTHERWISE NOTED.
21. THE CONTRACTOR SHALL PREVENT SOIL STABILIZATION TREATMENT FROM LEAVING THE SITE BY WAY OF STORMWATER RUNOFF WHICH MAY DAMAGE DOWNSTREAM WATER COURSES, LAKES OR PONDS. ANY DAMAGE TO WILDLIFE OR FISH KILLS SHALL BE CORRECTED BY THE CONTRACTOR AT HIS EXPENSE.
22. MAINTAIN AS MUCH EXISTING VEGETATION AS POSSIBLE AS WELL AS RE-ESTABLISHING THE GROUND COVER AS EARLY AS POSSIBLE. GRASS BUFFER STRIPS SHALL BE LEFT AROUND THE PERIMETER TO AID IN FILTERING SEDIMENTATION. A DENSITY OF TEMPORARY OR PERMANENT GROUND COVER SUFFICIENT TO PREVENT EROSION SHALL BE ESTABLISHED ON ALL BERMS, SWALES AND SLOPES.
23. ALL SITE GRADING AND EARTHWORK CONSTRUCTION SHALL COMPLY TO THE GEOTECHNICAL REPORT RECOMMENDATIONS AND SHALL BE COMPACTED TO A MINIMUM 95% OF ASTM D698 USING A SHEEPSFOOT ROLLER.
24. ALL DISTURBED AREAS SHALL HAVE A MINIMUM 1" TALL GRASS COVERAGE OVER 75% TO 80% OF THE ENTIRE AREA PRIOR TO ENGINEERING ACCEPTANCE OR TO ISSUANCE OF A CERTIFICATE OF OCCUPANCY.

PARKING LOT GRADING NOTES

1. THIS GRADING PLAN DOES NOT INCLUDE CONSTRUCTION OF THE FOUNDATION FOR THE BUILDING PAD AND THE AREAS ADJACENT TO THE BUILDING. THE OWNER SHALL SELECT THE FOUNDATION DESIGN OPTION WHICH WILL ESTABLISH THE CONSTRUCTION TECHNIQUE TO BE USED FOR THE FOUNDATION PAD AND AREAS OF THE BUILDING. REFER TO THE PROJECT GEOTECHNICAL REPORT FOR FOUNDATION CONSTRUCTION RECOMMENDATIONS.
2. CONSTRUCTION OF SITE GRADING AND EMBANKMENT SHALL MEET OR EXCEED THE RECOMMENDATION PROVIDED IN THE PROJECT GEOTECHNICAL REPORT.
3. AREAS A MINIMUM FIVE FEET HORIZONTALLY OF THE PARKING PAVEMENT AND EMBANKMENT SLOPES ADJACENT TO PARKING AREA SHALL BE CONSTRUCTED AS PER THE PROJECT GEOTECHNICAL ENGINEER'S RECOMMENDATIONS. THE BELOW SPECIFICATIONS ARE MINIMUM REQUIREMENTS AND SHALL BE SUPERSEDED BY THE PROJECT GEOTECHNICAL RECOMMENDATIONS IF IN CONFLICT. THE SPECIFICATIONS ARE AS FOLLOWS:
  - A. THE AREA SHALL BE STRIPPED OF VEGETATION A MINIMUM SIX INCHES OR DEEPER AS DIRECTED BY THE PROJECT GEOTECHNICAL ENGINEER TO STABLE SUBGRADE AND PROOFROLLED. PROOFROLLING CONSISTS OF ROLLING THE ENTIRE SUBGRADE WITH A HEAVILY-LOADED TANDEM AXLE DUMP TRUCK OR OTHER APPROVED EQUIPMENT CAPABLE OF APPLYING SIMILAR WHEEL LOADS. ANY SOFT, WET OR WEAK FILL OR NATURAL SOILS WHICH DO NOT COMPACT BY PROOFROLLING SHALL BE REMOVED AND RECOMPACTED AS OUTLINED HEREIN. THE PROOFROLLING OPERATION MUST BE PERFORMED UNDER THE OBSERVATION OF A QUALIFIED GEOTECHNICAL ENGINEER OR HIS REPRESENTATIVE AND DENSITY CONTROL TESTED.
  - B. ON-SITE SOILS WITH PLASTICITY INDEX ANTICIPATED TO BE GREATER THAN 15, WHICH INCLUDES ANY DARK COLORED SURFACE CLAY SOILS, CAN BE ALSO USED AS GRADE RAISE FILL OUTSIDE THE PROPOSED BUILDING AREA. THESE CLAY SOILS SHALL BE COMPACTED TO A DRY DENSITY OF AT LEAST 95 PERCENT OF STANDARD PROCTOR DENSITY AND NOT EXCEEDING 100 PERCENT. THE COMPACTED MOISTURE CONTENT OF THE CLAYS DURING PLACEMENT SHALL BE BETWEEN OPTIMUM AND FOUR (4) PERCENTAGE POINTS ABOVE OPTIMUM.
  - C. COMPACTION SHALL BE ACCOMPLISHED BY PLACING THE FILL IN SIX TO EIGHT-INCH THICK LOOSE LIFTS AND COMPACTING EACH LIFT TO AT LEAST THE SPECIFIED MINIMUM DRY DENSITY. IT IS IMPERATIVE THAT THE FILL PARTICLE SIZE BE LESS THAN SIX INCHES IN DIAMETER. IF LARGER CLODS ARE ENCOUNTERED DURING GRADING, THESE CLODS MUST BE BROKEN DOWN PRIOR TO FINAL PLACEMENT IN THE FILL. THIS MAY REQUIRE PLACEMENT OF THE MATERIAL, AN INITIAL COMPACTIVE EFFORT TO BREAK THE CLODS DOWN, SCARIFYING, WETTING AND RECOMPACTING TO A MINIMUM 95% OF ASTM D698 USING A SHEEPSFOOT ROLLER.
  - D. IN ORDER FOR THE FILL MATERIALS TO PERFORM AS INTENDED, THE FILL MATERIAL MUST BE PLACED IN A MANNER WHICH PRODUCES A GOOD UNIFORM FILL COMPACTED WITHIN THE DENSITY AND MOISTURE RANGES OUTLINED IN THE PRECEDING PARAGRAPHS. FIELD DENSITY TESTS SHALL BE PERFORMED ON FILL SOILS TO CONFIRM THIS PERFORMANCE AS CONSTRUCTION PROGRESSES. FOR THE PROPOSED PARKING AND DRIVEWAY AREAS, TESTING AT A FREQUENCY OF NO LESS THAN ONE (1) TEST PER LIFT PER EACH 5,000 SQUARE FEET SHALL BE PROVIDED FOR FILL AND PROOFROLLING.
4. THESE SPECIFICATIONS DO NOT INCLUDE GRADING AND PREPARATION OF THE BUILDING FOUNDATION AREA. THE CONTRACTOR SHALL CONFIRM FOUNDATION CONSTRUCTION COMPACTION, MOISTURE CONTROL, SELECT FILLS AND/OR TREATMENT WITH THE OWNER, THE PROJECT GEOTECHNICAL ENGINEER AND STRUCTURAL ENGINEER.

PREPARED BY:  

**WIER & ASSOCIATES, INC.**  
 ENGINEERS SURVEYORS LAND PLANNERS  
 2201 E. LINAR BLVD., SUITE 200E ARLINGTON, TEXAS 76006 METRO (817)467-7700  
 www.wierassociates.com  
 Texas Firm Registration No. F-2776

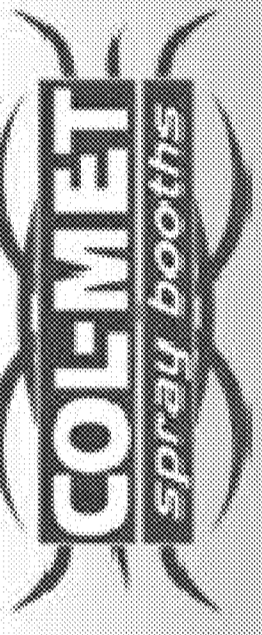

LOT 3, BLOCK B  
 ROCKWALL TECHNOLOGY PARK PHASE I  
 COL-MET SPRAY BOOTHS  
 PRIVATE GENERAL GRADING NOTES




RECORD PLANS  
 October 28, 2015

COPYRIGHT ©  
 WIER & ASSOCIATES, INC.  
 LAST SHEET OF 11  
 DATE 10/28/2015  
 WA# 14029  
 SHEET NO.  
 C-G001



PRINTED: 10/28/2015 10:28:20 AM FILE: WIER-EROSION-CONTROL.STB LAST SAVED: 10/28/2015 6:06 AM SAVED BY: PHILIP FILE: GRADING-PLAN-I-14029.DWG

SEE SHEET C-G102


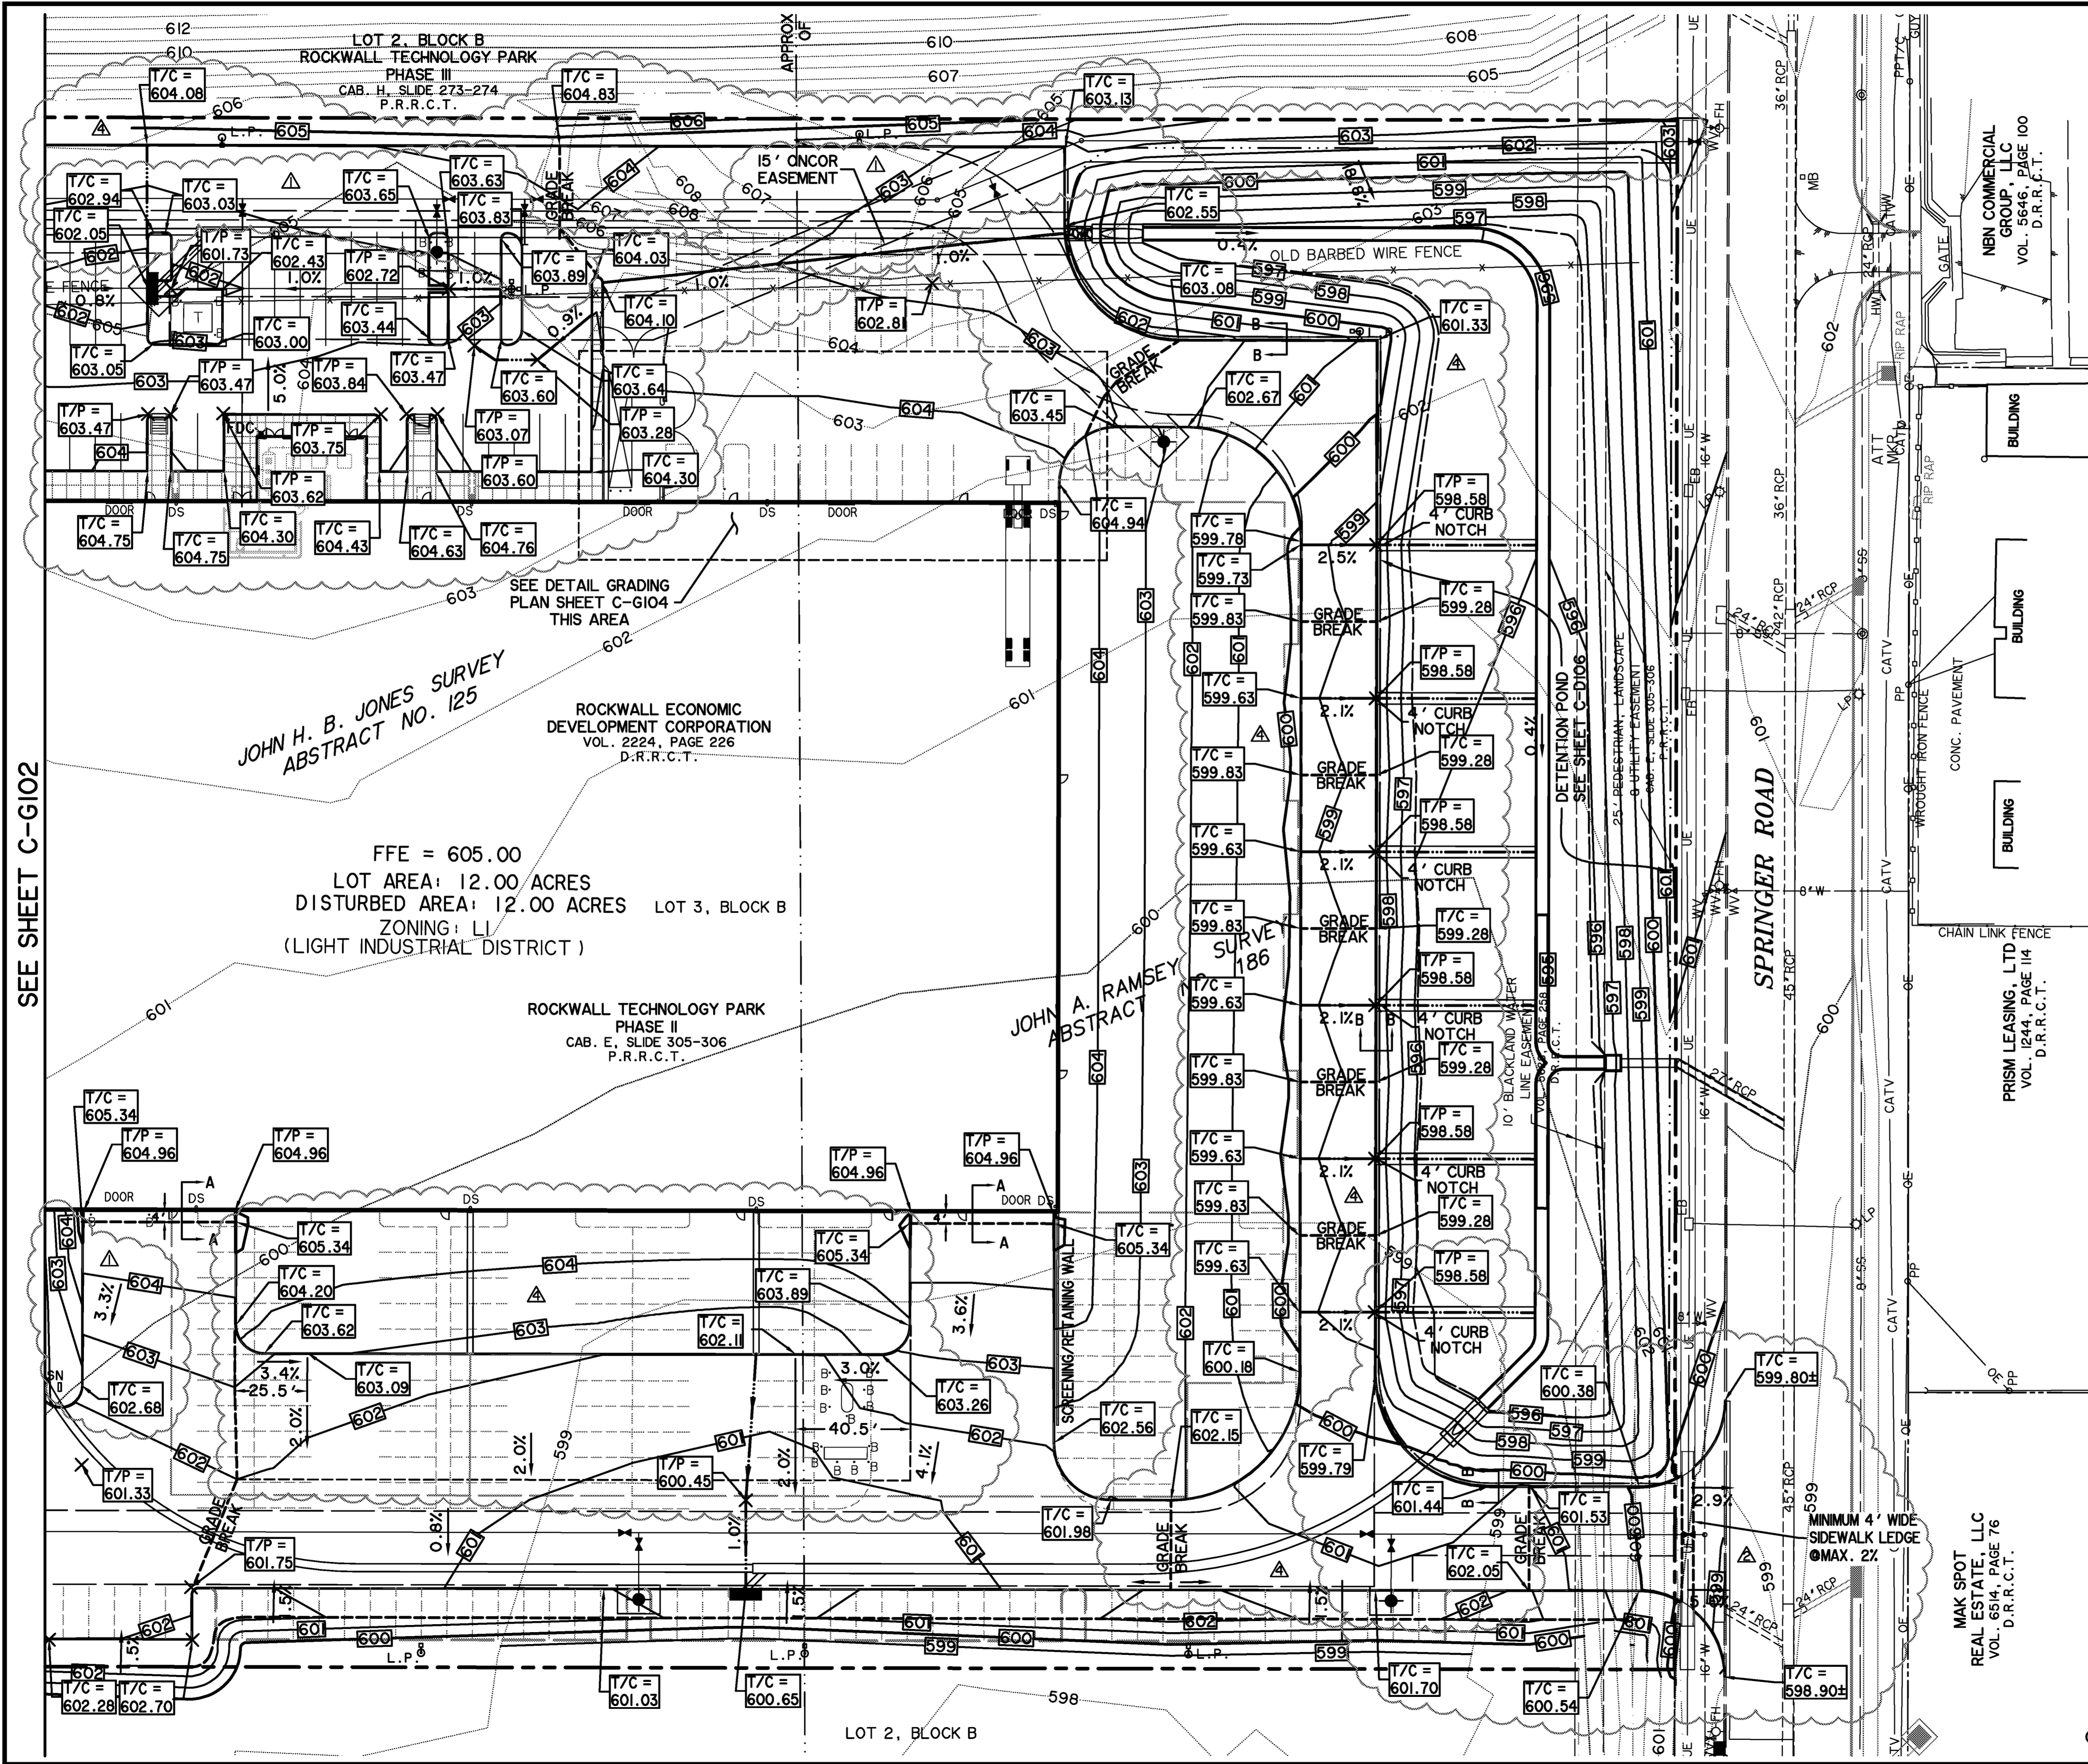


**CAUTION !!**  
 EXISTING UTILITIES ARE INDICATED ON THE PLANS FROM AVAILABLE INFORMATION. IT SHALL BE THE RESPONSIBILITY OF THE CONTRACTOR TO VERIFY THE LOCATION OF ALL UTILITIES, TO NOTIFY ALL UTILITY COMPANIES OF THE CONTRACTORS OPERATIONS, TO PROTECT ALL UTILITIES FROM DAMAGE, TO REPAIR ALL UTILITIES DAMAGED DUE TO THE CONTRACTORS OPERATIONS, AND TO NOTIFY THE ENGINEER PROMPTLY OF ALL CONFLICTS OF THE WORK WITH EXISTING UTILITIES.

**\* BENCHMARKS \***  
**BM A:** "X" CUT ON NORTHWEST CORNER OF CURB INLET ALONG NORTH SIDE OF DISCOVERY BLVD. APPROXIMATELY 990' EAST OF IT'S INTERSECTION WITH F.M. 549. 601.19 FT.  
**BM B:** "X" CUT IN BOX IN THE CONCRETE AROUND A WATER VALVE ON THE BACK OF CURB ALONG THE NORTH SIDE OF SPRINGER RD. APPROXIMATELY 921' EAST OF IT'S INTERSECTION WITH F.M. 549. 600.75 FT.

| REVISIONS   | DATE     | BY  |
|---|----------|-----|
| △ RETAINING WALL, PAVEMENT, WATER LINE, & ONCOR EASEMENT        | 01/27/15 | TVW |
| △ ADDED DRIVE CONNECTION & REVISED GRADING                      | 03/19/15 | PLG |
| △ ADDED ADDITIONAL TRUCK PARKING & RAISED FIRE LANE PAVEMENT 1' | 04/13/15 | TVW |

\* ALL RESPONSIBILITY FOR ADEQUACY OF DESIGN REMAINS WITH THE DESIGN ENGINEER. THE CITY OF ROCKWALL, IN REVIEWING AND RELEASING THE PLANS FOR CONSTRUCTION, ASSUMES NO RESPONSIBILITY FOR ADEQUACY OR ACCURACY OF DESIGN. \*

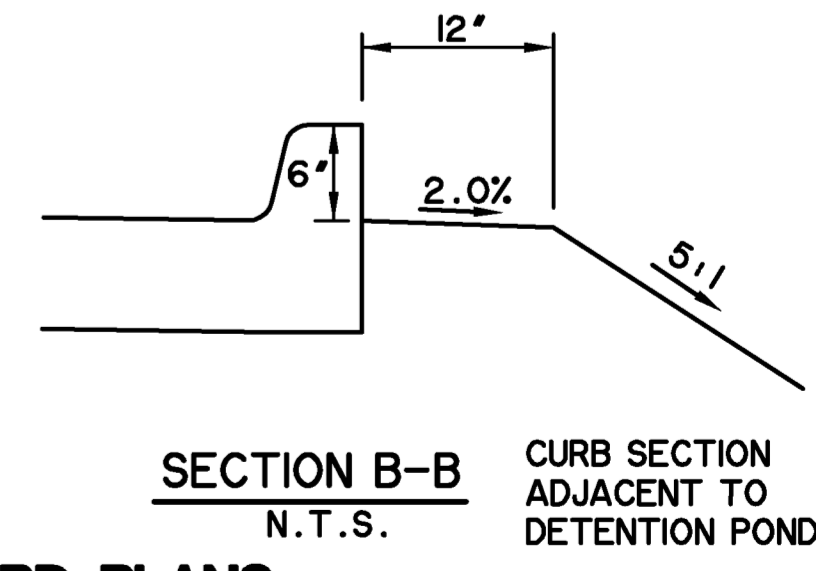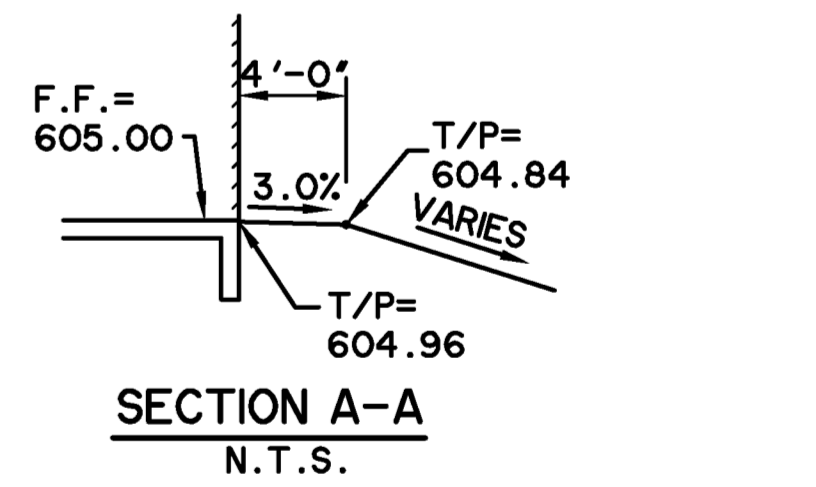


**RECORD PLANS**  
 October 28, 2015




**CUSHMAN & WAKEFIELD**  
 SCOTT + REID  
 General Contractors

PREPARED BY:  
**WIER & ASSOCIATES, INC.**  
 ENGINEERS SURVEYORS LAND PLANNERS  
 2201 E. LAMAR BLVD., SUITE 200E ARLINGTON, TEXAS 76010 METRO (817) 467-7700  
 Texas Firm Registration No. F-2776 www.wierassociates.com

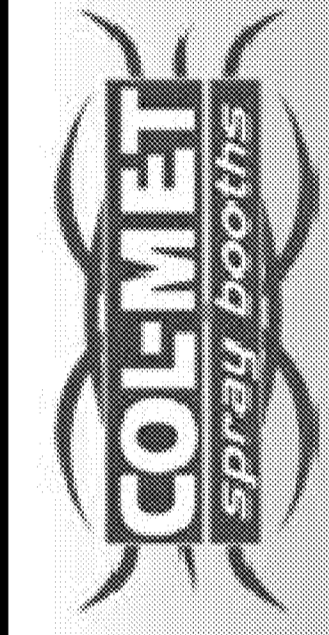


**LOT 3, BLOCK B**  
**ROCKWALL TECHNOLOGY PARK PHASE II**  
**COL-MET SPRAY BOOTHS**  
**GRADING PLAN**  
 SOUTH

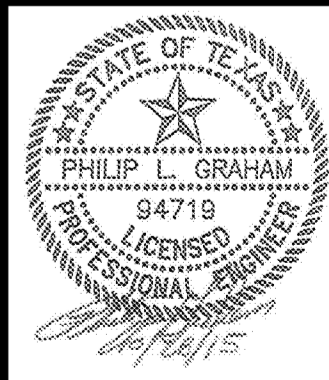

COPYRIGHT ©  
 WIER & ASSOCIATES, INC.  
 LAST SHEET 1 OF 11  
 DATE 10/28/2015  
 WAH 14029  
**SHEET NO.**  
**C-G101**

PRINTED: 10/28/2015 5:16:10 AM FILE: WIER-EROSION-CONTROL.STB LAST SAVED: 10/28/2015 6:07 AM SAVED BY: PHILIP FILE: GRADING-PLAN-2-14029.DWG

LOT 1, BLOCK A  
ROCKWALL TECHNOLOGY PARK  
PHASE II  
CAB. E, SLIDE 305-306  
P.R.R.C.T.  
  
ZONING: LI  
(LIGHT INDUSTRIAL DISTRICT)

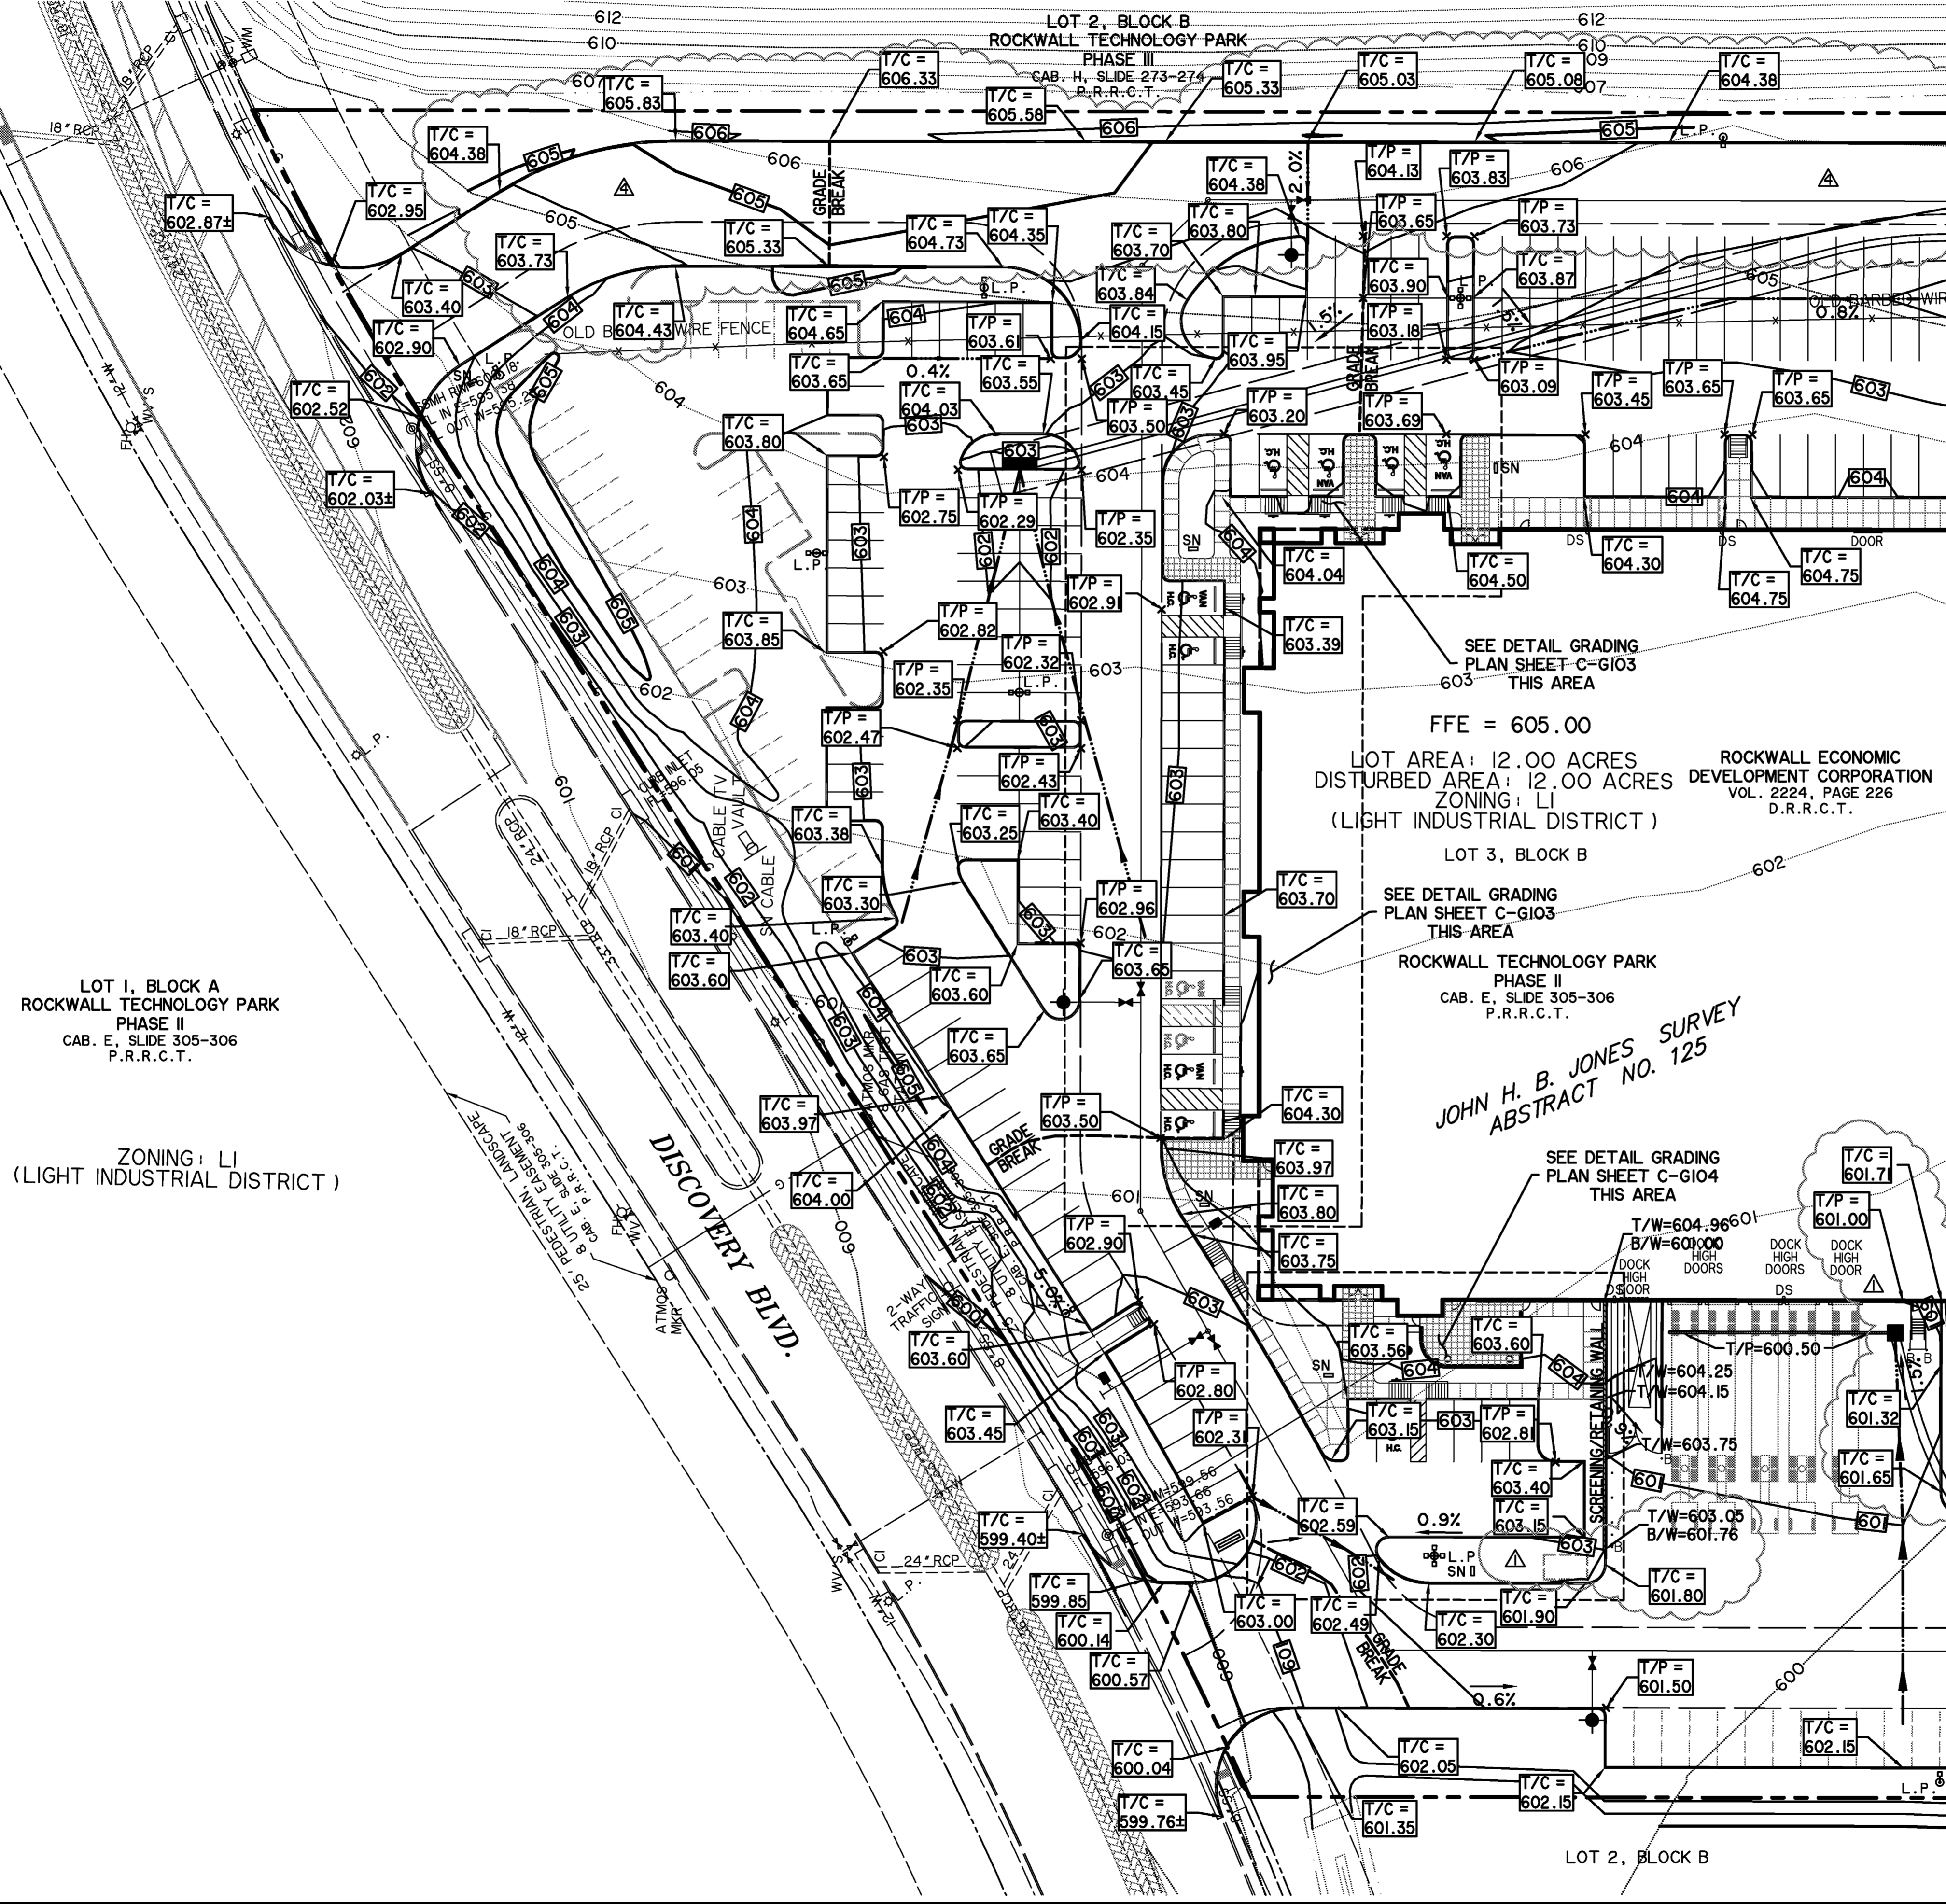

**CAUTION !!!**  
EXISTING UTILITIES ARE INDICATED ON THE PLANS FROM AVAILABLE INFORMATION. IT SHALL BE THE RESPONSIBILITY OF THE CONTRACTOR TO VERIFY THE LOCATION OF ALL UTILITIES, TO NOTIFY ALL UTILITY COMPANIES OF THE CONTRACTORS OPERATIONS, TO PROTECT ALL UTILITIES FROM DAMAGE, TO REPAIR ALL UTILITIES DAMAGED DUE TO THE CONTRACTORS OPERATIONS, AND TO NOTIFY THE ENGINEER PROMPTLY OF ALL CONFLICTS OF THE WORK WITH EXISTING UTILITIES.

GENERAL NOTES:  
1. SEE SHEET 2 FOR GRADING LEGEND.

**\* BENCHMARKS \***  
  
**BM A:** "X" CUT ON NORTHWEST CORNER OF CURB INLET ALONG NORTH SIDE OF DISCOVERY BLVD. APPROXIMATELY 990' EAST OF IT'S INTERSECTION WITH F.M. 549. 601.19 FT.  
  
**BM B:** "X" CUT IN BOX IN THE CONCRETE AROUND A WATER VALVE ON THE BACK OF CURB ALONG THE NORTH SIDE OF SPRINGER RD. APPROXIMATELY 921' EAST OF IT'S INTERSECTION WITH F.M. 549. 600.75 FT.

FFE = 605.00  
LOT AREA: 12.00 ACRES  
DISTURBED AREA: 12.00 ACRES  
ZONING: LI  
(LIGHT INDUSTRIAL DISTRICT)  
LOT 3, BLOCK B  
ROCKWALL ECONOMIC DEVELOPMENT CORPORATION  
VOL. 2224, PAGE 226  
D.R.R.C.T.

SEE SHEET C-G10


\* ALL RESPONSIBILITY FOR ADEQUACY OF DESIGN REMAINS WITH THE DESIGN ENGINEER. THE CITY OF ROCKWALL, IN REVIEWING AND RELEASING THE PLANS FOR CONSTRUCTION, ASSUMES NO RESPONSIBILITY FOR ADEQUACY OR ACCURACY OF DESIGN. \*

RECORD PLANS  
October 28, 2015


| REVISIONS   | DATE     | BY  |
|---|----------|-----|
| RETAINING WALL, PAVEMENT, WATER LINE, & ONCOR EASEMENT        | 01/27/15 | TVW |
| ADDED ADDITIONAL TRUCK PARKING & RAISED FIRE LANE PAVEMENT 1" | 04/13/15 | TVW |



PREPARED BY:  
**WIER & ASSOCIATES, INC.**  
ENGINEERS SURVEYORS LAND PLANNERS  
2201 E. LAMAR BLVD., SUITE 200E ARLINGTON, TEXAS 76010 METRO (817)467-7700  
www.wierassociates.com  
Texas Firm Registration No. F-2776

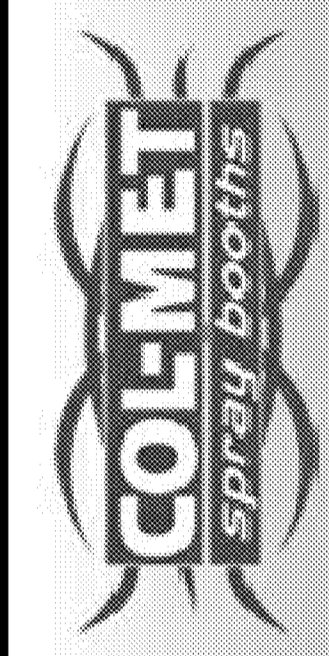


LOT 3, BLOCK B  
ROCKWALL TECHNOLOGY PARK PHASE II  
COL-MET SPRAY BOOTHS  
GRADING PLAN  
NORTH

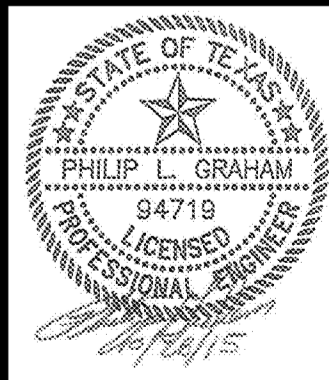

COPYRIGHT ©  
WIER & ASSOCIATES, INC.  
LAST SHEET EDIT  
DATE 10/28/2015  
WA# 14029  
**SHEET NO.**  
C-G102

PRINTED: 10/28/2015 10:28/2015 6:05 AM LAST SAVED: 10/28/2015 6:05 AM FILE: GRADING-DETAIL-PLAN-14029.DWG

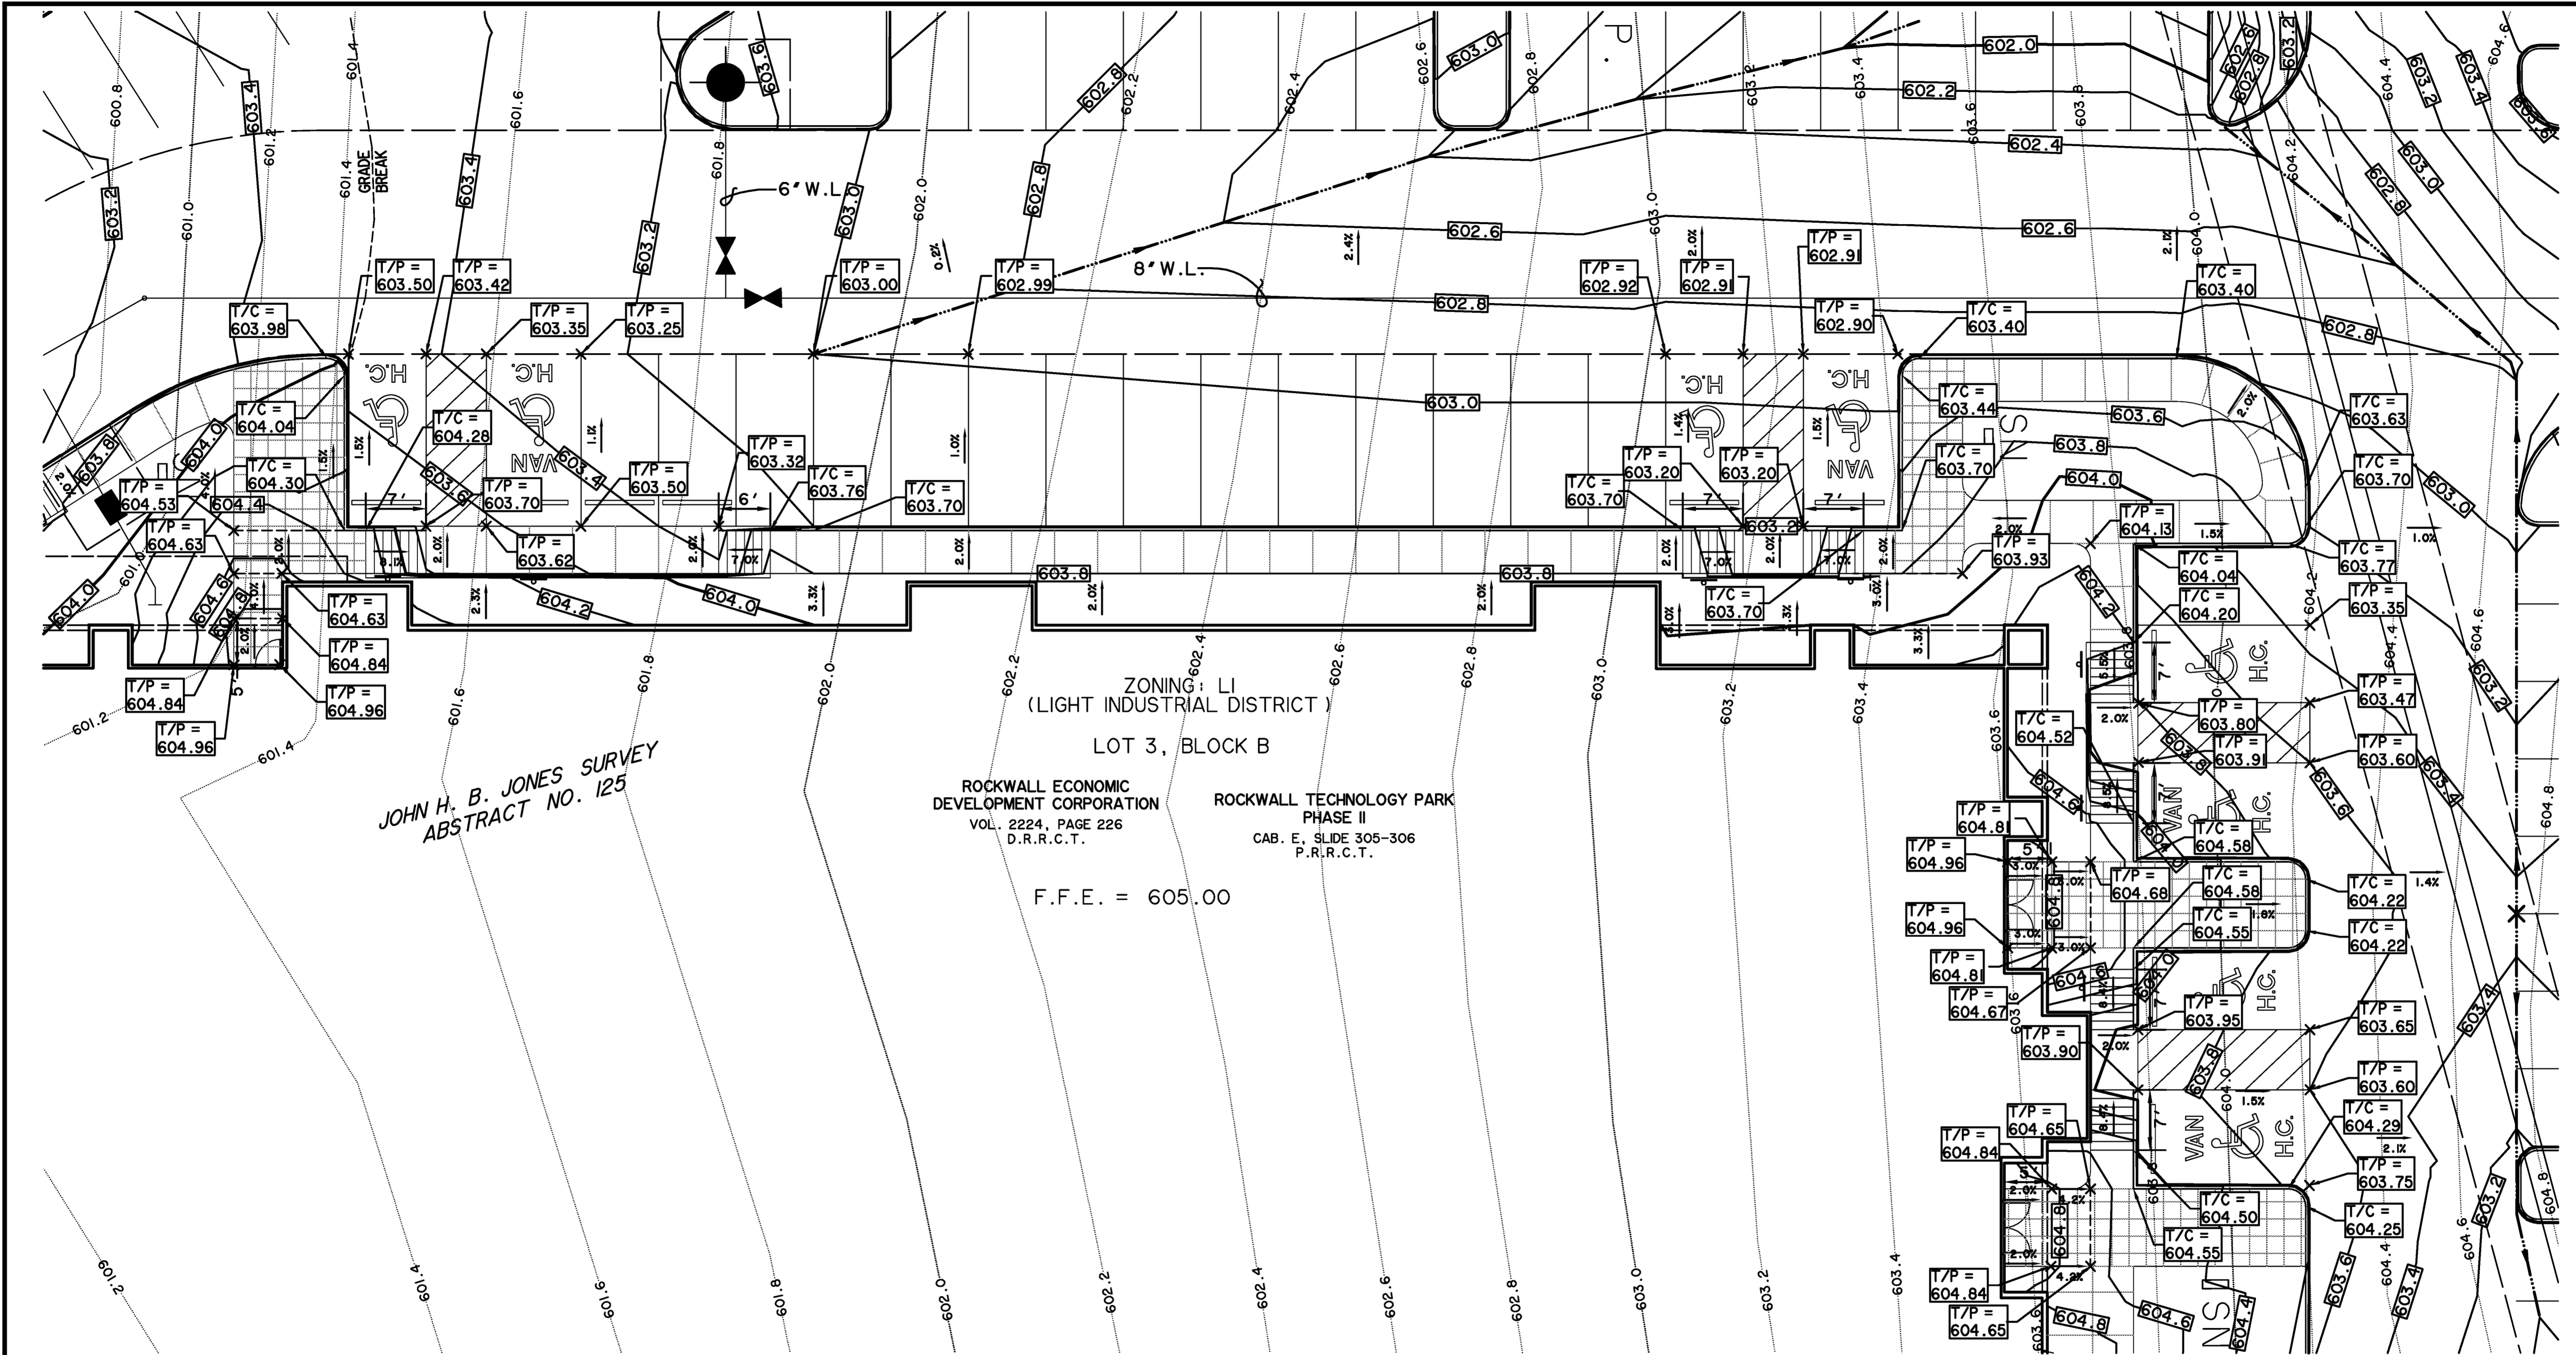

JOHN H. B. JONES SURVEY  
ABSTRACT NO. 125


ZONING: LI  
(LIGHT INDUSTRIAL DISTRICT)  
LOT 3, BLOCK B  
ROCKWALL ECONOMIC  
DEVELOPMENT CORPORATION  
VOL. 2224, PAGE 226  
D.R.R.C.T.  
ROCKWALL TECHNOLOGY PARK  
PHASE II  
CAB. E, SLIDE 305-306  
P.R.R.C.T.  
F.F.E. = 605.00

**\* BENCHMARKS \***  
**BM A:** "X" CUT ON NORTHWEST CORNER OF CURB INLET ALONG NORTH SIDE OF DISCOVERY BLVD. APPROXIMATELY 990' EAST OF IT'S INTERSECTION WITH F.M. 549.  
601.19 FT.  
**BM B:** "X" CUT IN BOX IN THE CONCRETE AROUND A WATER VALVE ON THE BACK OF CURB ALONG THE NORTH SIDE OF SPRINGER RD. APPROXIMATELY 921' EAST OF IT'S INTERSECTION WITH F.M. 549.  
600.75 FT.

**CAUTION !!**  
EXISTING UTILITIES ARE INDICATED ON THE PLANS FROM AVAILABLE INFORMATION. IT SHALL BE THE RESPONSIBILITY OF THE CONTRACTOR TO VERIFY THE LOCATION OF ALL UTILITIES, TO NOTIFY ALL UTILITY COMPANIES OF THE CONTRACTORS OPERATIONS, TO PROTECT ALL UTILITIES FROM DAMAGE, TO REPAIR ALL UTILITIES DAMAGED DUE TO THE CONTRACTORS OPERATIONS, AND TO NOTIFY THE ENGINEER PROMPTLY OF ALL CONFLICTS OF THE WORK WITH EXISTING UTILITIES.

\* ALL RESPONSIBILITY FOR ADEQUACY OF DESIGN REMAINS WITH THE DESIGN ENGINEER. THE CITY OF ROCKWALL, IN REVIEWING AND RELEASING THE PLANS FOR CONSTRUCTION, ASSUMES NO RESPONSIBILITY FOR ADEQUACY OR ACCURACY OF DESIGN. \*


**RECORD PLANS**  
**October 28, 2015**

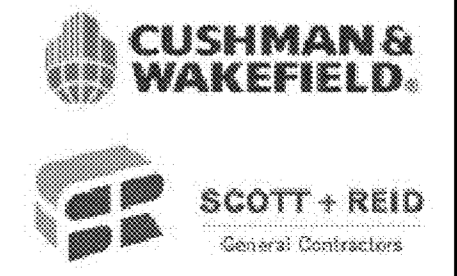

PREPARED BY:  
**WIER & ASSOCIATES, INC.**  
ENGINEERS SURVEYORS LAND PLANNERS  
2201 E. LAMAR BLVD., SUITE 200E ARLINGTON, TEXAS 76006 METRO (817)467-7700  
www.wierassociates.com  
Texas Firm Registration No. F-2776




**LOT 3, BLOCK B**  
**ROCKWALL TECHNOLOGY PARK PHASE II**  
**COL-MET SPRAY BOOTHS**  
**GRADING PLAN DETAIL**

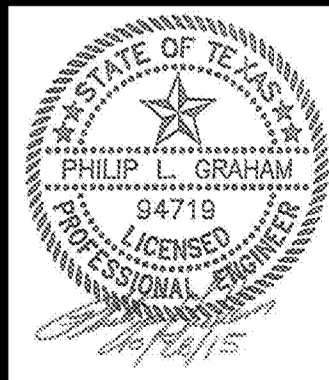


COPYRIGHT ©  
WIER & ASSOCIATES, INC.  
LAST SHEET EDIT  
DATE 10/28/2015  
WA# 14029  
**SHEET NO.**  
**C-103**

PRINTED: 10/28/2015 10:28/2015 6:03 AM FILE: WIER-EROSION-CONTROL.STB LAST SAVED: 10/28/2015 6:03 AM FILE: GRADING-DETAIL-PLAN-2-14029.DWG

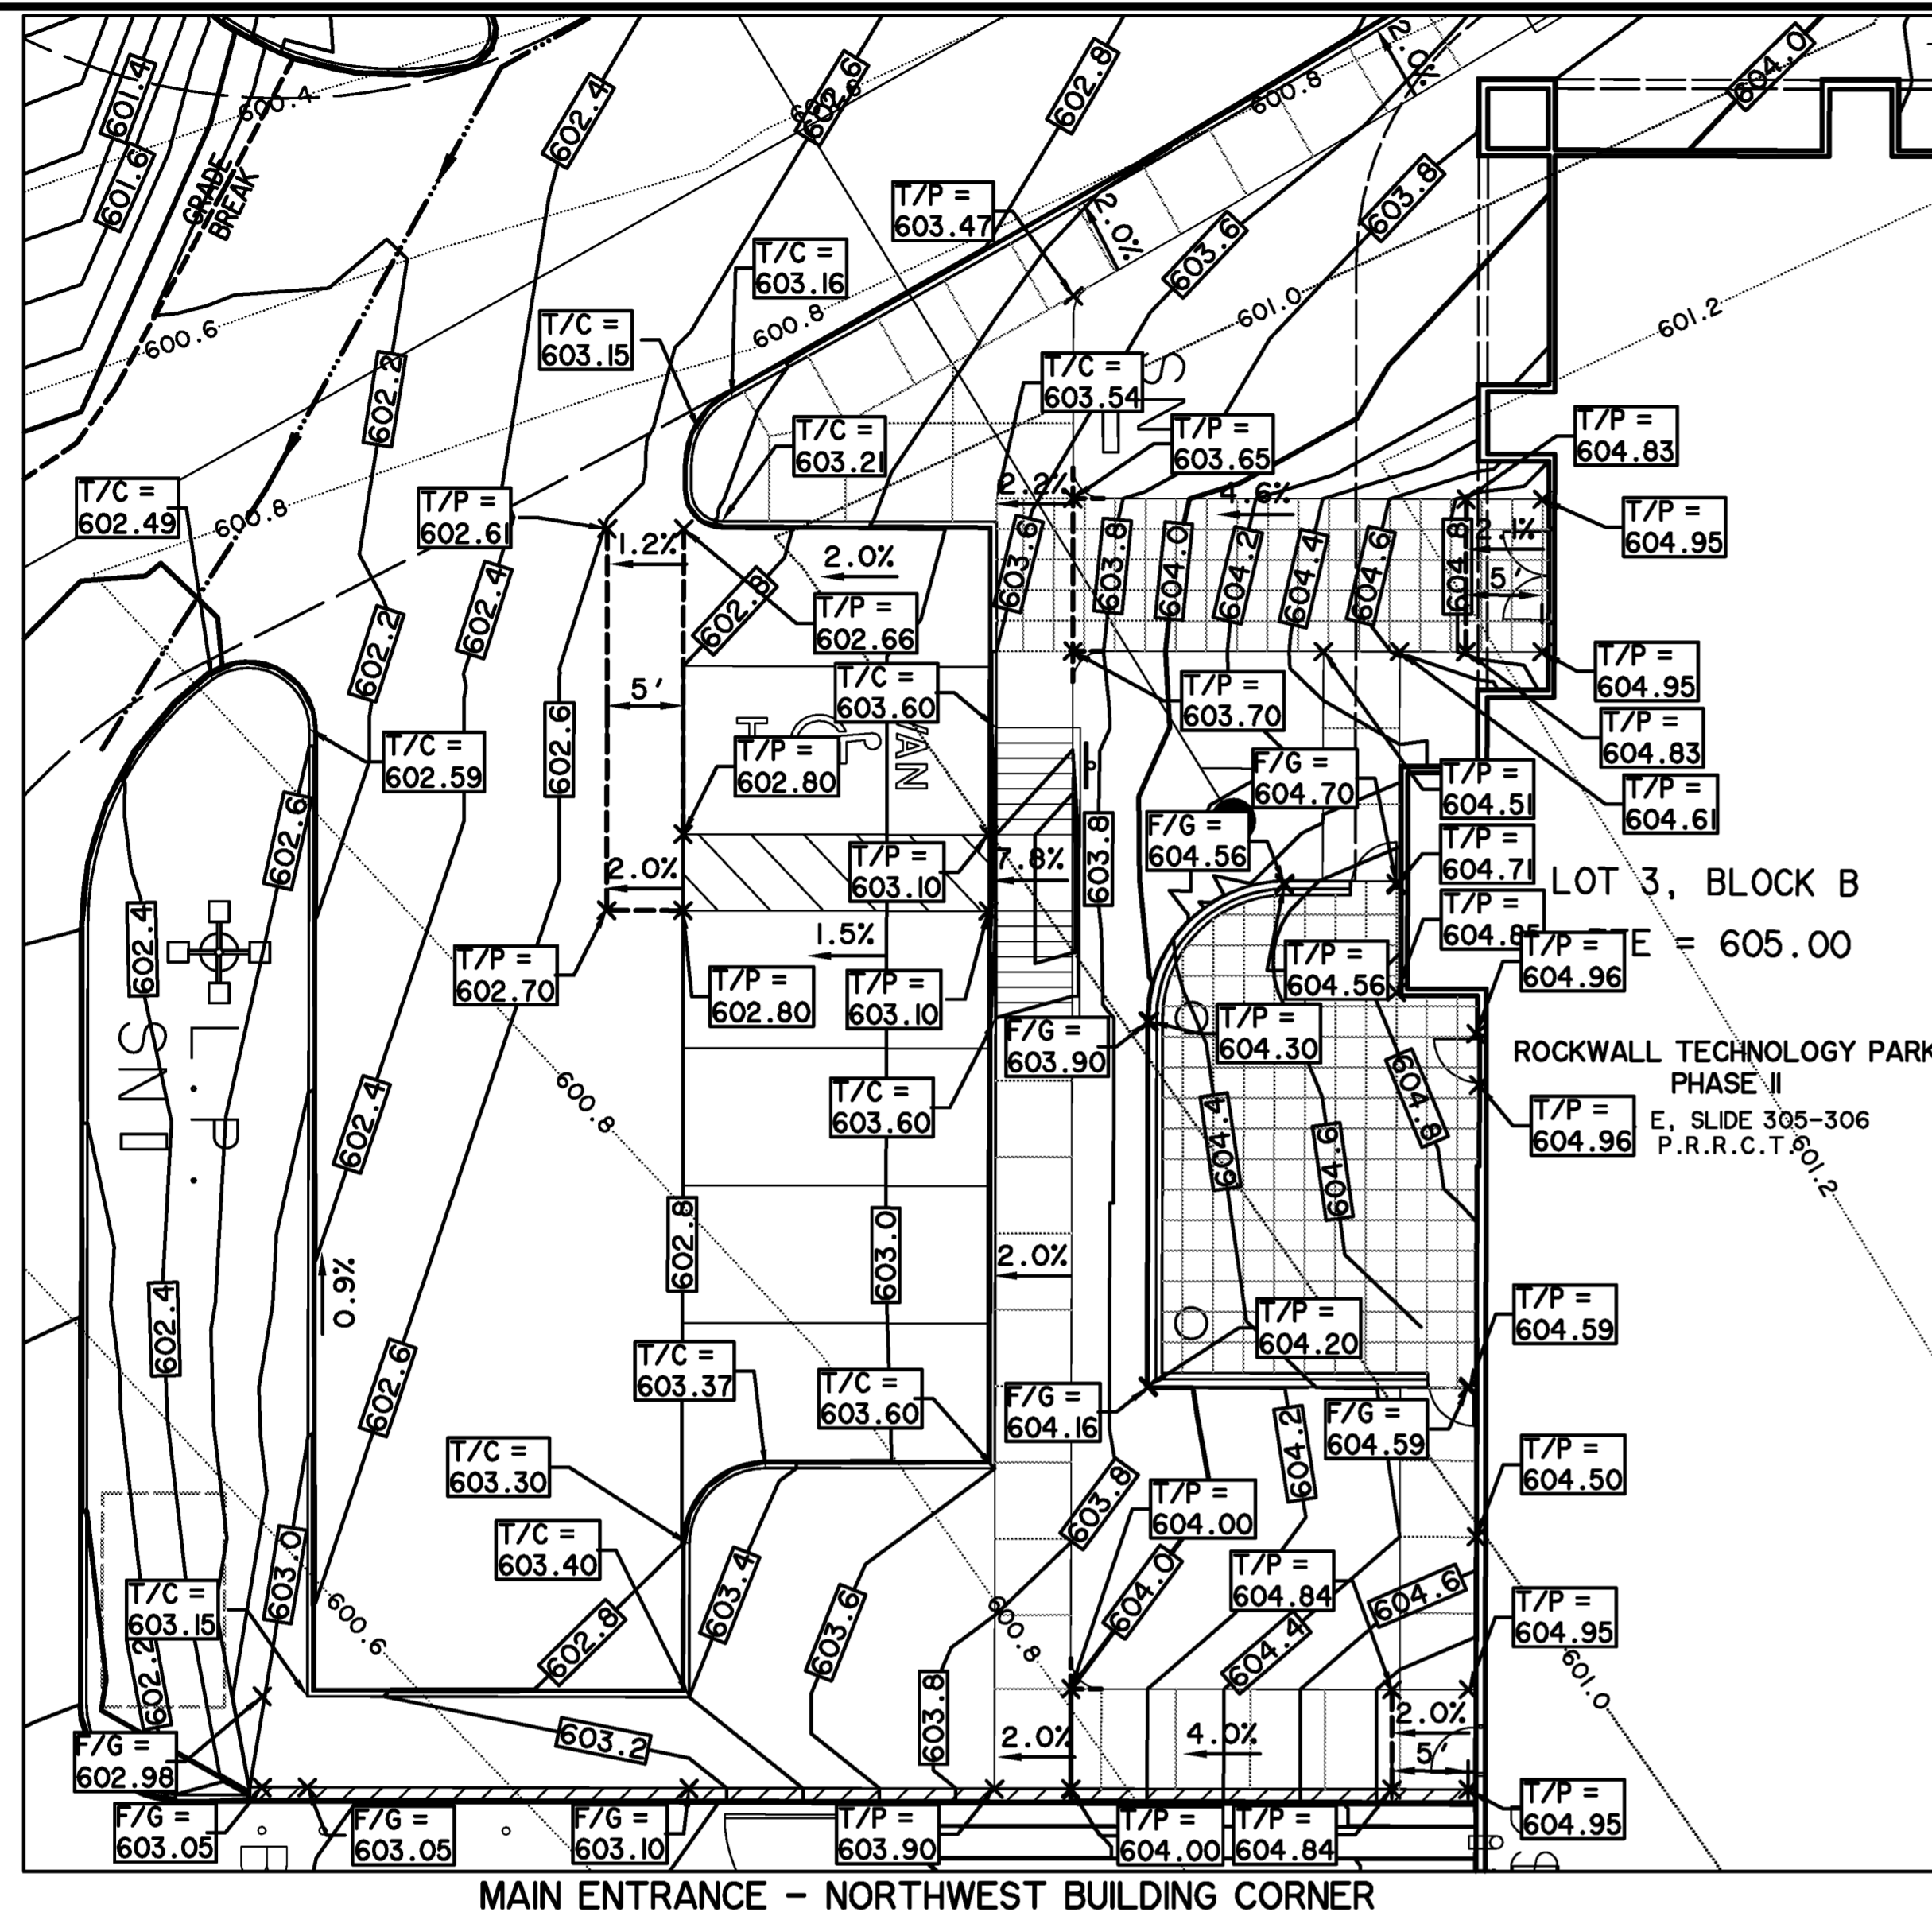

MAIN ENTRANCE - NORTHWEST BUILDING CORNER


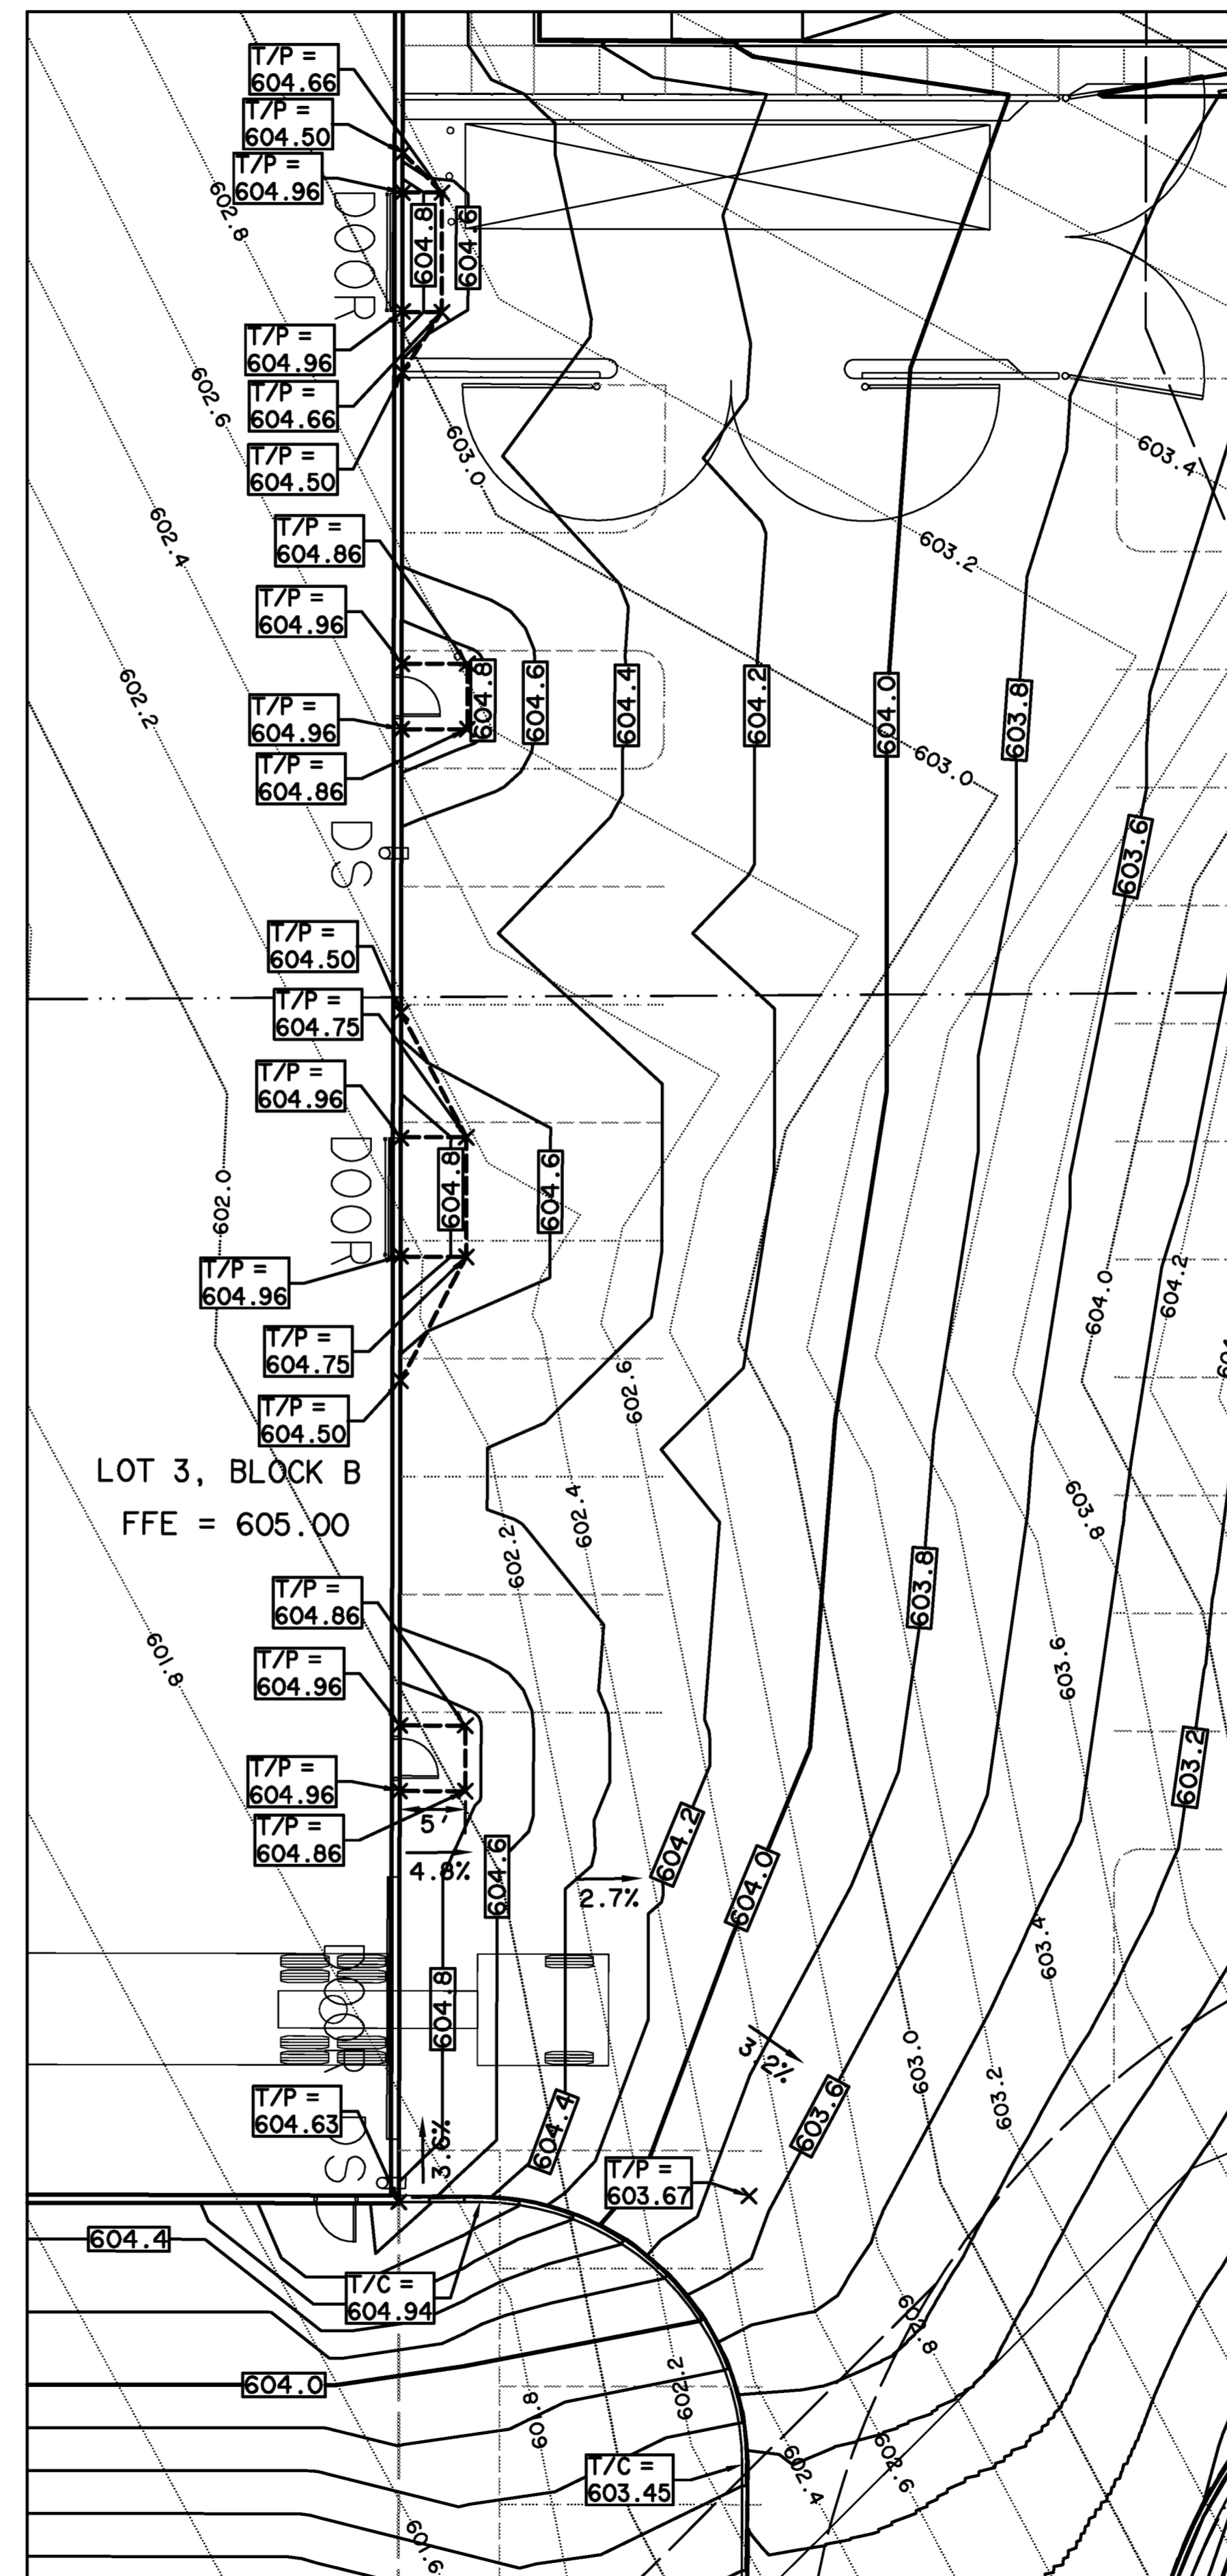


DRIVE THROUGH BAY - SOUTHEAST BUILDING CORNER


**CAUTION !!!**  
EXISTING UTILITIES ARE INDICATED ON THE PLANS FROM AVAILABLE INFORMATION. IT SHALL BE THE RESPONSIBILITY OF THE CONTRACTOR TO VERIFY THE LOCATION OF ALL UTILITIES, TO NOTIFY ALL UTILITY COMPANIES OF THE CONTRACTORS OPERATIONS, TO PROTECT ALL UTILITIES FROM DAMAGE, TO REPAIR ALL UTILITIES DAMAGED DUE TO THE CONTRACTORS OPERATIONS, AND TO NOTIFY THE ENGINEER PROMPTLY OF ALL CONFLICTS OF THE WORK WITH EXISTING UTILITIES.

**\* BENCHMARKS \***  
**BM A:** "X" CUT ON NORTHWEST CORNER OF CURB INLET ALONG NORTH SIDE OF DISCOVERY BLVD. APPROXIMATELY 990' EAST OF IT'S INTERSECTION WITH F.M. 549. 601.19 FT.  
**BM B:** "X" CUT IN BOX IN THE CONCRETE AROUND A WATER VALVE ON THE BACK OF CURB ALONG THE NORTH SIDE OF SPRINGER RD. APPROXIMATELY 921' EAST OF IT'S INTERSECTION WITH F.M. 549. 600.75 FT.


" ALL RESPONSIBILITY FOR ADEQUACY OF DESIGN REMAINS WITH THE DESIGN ENGINEER. THE CITY OF ROCKWALL, IN REVIEWING AND RELEASING THE PLANS FOR CONSTRUCTION, ASSUMES NO RESPONSIBILITY FOR ADEQUACY OR ACCURACY OF DESIGN."

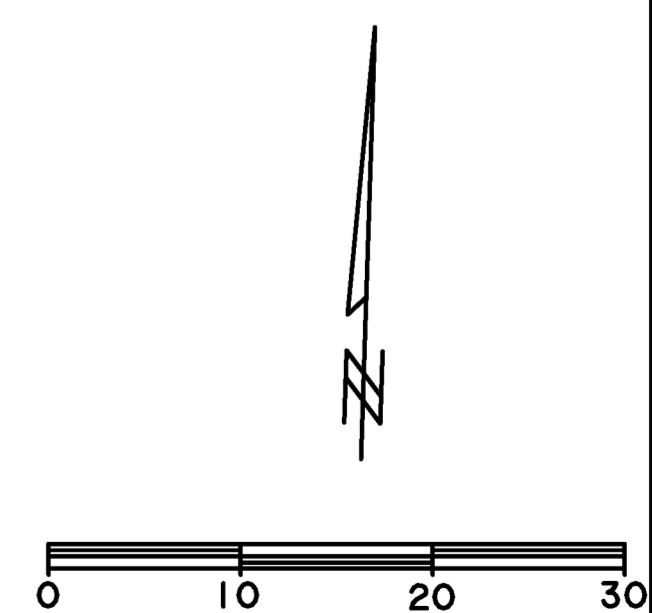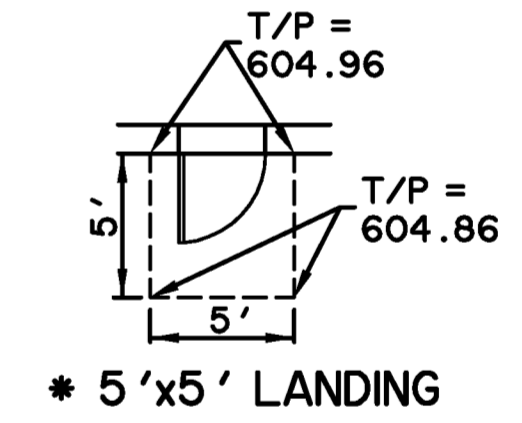

PREPARED BY:  
**WIER & ASSOCIATES, INC.**  
ENGINEERS SURVEYORS LAND PLANNERS  
2201 E. LINN RD., SUITE 200E ARLINGTON, TEXAS 76010 METRO (817)467-7700  
www.wierassociates.com  
Texas Firm Registration No. F-2776

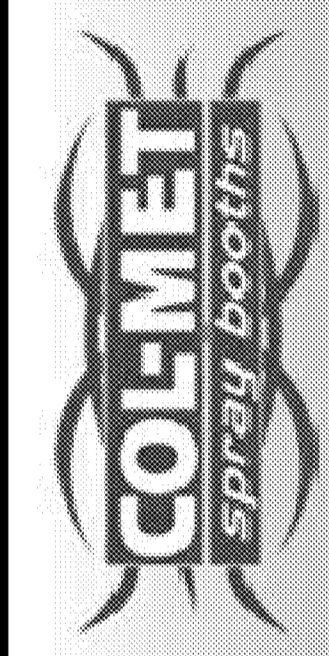

**LOT 3, BLOCK B**  
**ROCKWALL TECHNOLOGY PARK PHASE II**  
**COL-MET SPRAY BOOTHS**  
**GRADING PLAN DETAIL**

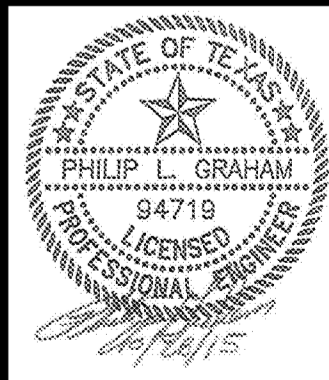

**RECORD PLANS**  
**October 28, 2015**  
CUSHMAN & WAKEFIELD  
SCOTT + REID  
General Contractors

COPYRIGHT ©  
WIER & ASSOCIATES, INC.  
LAST SHEET EDIT  
DATE 10/28/2015  
WA# 14029  
**SHEET NO.**  
**C-G104**

UTILITY NOTES


1. THIS SHEET IS FOR SANITARY SEWER, WATER LINE AND STORM DRAINAGE CONSTRUCTION ONLY. DO NOT USE FOR GRADING CONSTRUCTION.
2. ALL PIPE LENGTHS ARE HORIZONTAL DISTANCES AND ARE APPROXIMATE.
3. ALL WATER AND SANITARY SEWER BULKHEADS TO TERMINATE APPROXIMATELY FIVE FEET OUTSIDE THE BUILDING UNLESS OTHERWISE NOTED. THE END OF THESE SERVICE LINES SHALL BE TIGHTLY PLUGGED OR CAPPED AND MARKED UNTIL SUCH TIME AS CONNECTION IS MADE INSIDE BUILDING.
4. CONTRACTOR SHALL PROVIDE ALL THE MATERIALS AND APPURTENANCES NECESSARY FOR THE COMPLETE INSTALLATION OF THE UTILITIES. ALL PIPE AND FITTINGS SHALL BE INSPECTED BY THE WATER DEPARTMENT INSPECTOR PRIOR TO BEING COVERED. THE INSPECTOR MUST ALSO BE PRESENT DURING PRESSURE TESTING AND DISINFECTION OF MAINS AND HIS SIGNATURE OF APPROVAL IS REQUIRED.
5. ALL WORK SHALL COMPLY WITH ALL APPLICABLE CODES, REGULATIONS AND/OR LOCAL STANDARDS IMPOSED BY LOCAL UTILITY AND THE CITY.
6. CONTRACTOR SHALL MAKE ARRANGEMENTS WITH THE LOCAL UTILITY AUTHORITY FOR CONNECTION TO THE EXISTING MAINS.
7. ALL FIRE HYDRANTS ARE SIX-INCH DIAMETER WITH A 6-INCH DIAMETER LINE AND A SIX-INCH DIAMETER SHUT OFF VALVE. FIRE HYDRANTS SHALL BE SET SUCH THAT NOZZLE CONNECTIONS FACE THE FIRE LANE. FIRE HYDRANTS SHALL BE SET MINIMUM THREE FEET TO FIVE FEET BACK OF CURB.
8. ALL WATER LINES SHALL HAVE A MINIMUM COVER OF 42 INCHES ABOVE TOP OF PIPE, UNLESS NOTED OTHERWISE.
9. CONTRACTOR SHALL ADJUST LOCATION OF PROPOSED WATER LINES AS REQUIRED TO AVOID CONFLICTS WITH STORM SEWER OR OTHER UTILITIES.
10. THRUST BLOCKS SHALL BE PROVIDED AT ALL "TEES, ELBOWS AND BENDS" OF SUFFICIENT SIZE TO COMPLY WITH MINIMUM STANDARDS OF N.F.P.A.-24 FOR EXISTING SOIL CONDITIONS.
11. BASED ON SECTION 704.2 OF THE CURRENT EDITION OF THE UNIFORM PLUMBING CODE, CLEANOUTS ARE REQUIRED AT A MAXIMUM SPACING OF 75 FEET ON UTILITY LEAD-INS TO BUILDING. CONTRACTOR TO PROVIDE CLEANOUTS WITHIN FIVE FEET OF BUILDING.
12. ALL GATE VALVES TO BE PROVIDED WITH CAST IRON BOXES. SIZE OF GATE VALVE (WHERE TAP IS MADE INTO EXISTING WATER LINE) WILL BE DETERMINED BY THE WATER DEPARTMENT.
13. SHOULD LATENT SOIL CONDITIONS NECESSITATE, CONTRACTOR SHALL INSTALL SPECIAL SUPPORTS FOR PIPING AND/OR APPURTENANCES INCLUDING THE REMOVAL OF UNSUITABLE MATERIAL AND BACKFILLING WITH GRAVEL OR OTHER MATERIAL. CONTRACTOR SHALL PERFORM ANY SUCH WORK AS DIRECTED BY THE CIVIL ENGINEER AND/OR SOILS ENGINEER AT NO ADDITIONAL COST TO THE OWNER.
14. THE SITE UTILITY CONTRACTOR SHALL COOPERATE AND WORK WITH OTHER CONTRACTORS ON THE SITE.
15. ALL MANHOLES OVER FIVE FEET IN DEPTH SHALL HAVE A STANDARD ECCENTRIC CONE.
16. ALL MATERIALS SHALL BE U.L. LISTED AND FACTORY MUTUAL APPROVED UNLESS DIRECTED OTHERWISE BY THE ENGINEER.
17. EXISTING UTILITIES AND UNDERGROUND FACILITIES INDICATED ON THESE PLANS ARE BASED ON REFERENCE INFORMATION SUPPLIED BY VARIOUS OWNERS OF THE FACILITIES. THE ENGINEER DOES NOT ACCEPT THE RESPONSIBILITY FOR THE GRAPHICAL REPRESENTATION OF THE UTILITIES SHOWN, IT SHALL BE THE RESPONSIBILITY OF THE CONTRACTOR TO LOCATE ALL EXISTING UTILITIES AND UNDERGROUND FACILITIES, BOTH HORIZONTALLY AND VERTICALLY, PRIOR TO CONSTRUCTION, TO TAKE NECESSARY PRECAUTIONS IN ORDER TO PROTECT ALL FACILITIES ENCOUNTERED, AND TO NOTIFY THE ENGINEER PROMPTLY OF ALL CONFLICTS OF THE WORK WITH EXISTING FACILITIES. THE CONTRACTOR SHALL PRESERVE AND PROTECT ALL EXISTING UTILITIES FROM DAMAGE DURING CONSTRUCTION. ANY DAMAGE BY THE CONTRACTOR TO EXISTING UTILITIES SHALL BE REPAIRED BY THE CONTRACTOR AT HIS EXPENSE.
18. UTILITY CONTRACTOR SHALL VERIFY WITH LOCAL AND STATE AUTHORITIES THAT ALL EXISTING STREET LIGHT AND TRAFFIC SIGNAL WIRES HAVE BEEN LOCATED PRIOR TO CONSTRUCTION.
19. PIPE THREE INCHES AND SMALLER SHALL BE TYPE K COPPER. FITTINGS SHALL BE COPPER OR CAST BRONZE. JOINTS SHALL BE SOLDER OR FLARE TUBE TYPE.
20. UTILITY LEAD-INS TO BUILDING SHALL NOT BE INSTALLED UNTIL BUILDING PLANS ARE COMPLETED AND LOCATIONS ESTABLISHED ON THE ARCHITECTURAL PLUMBING PLANS. LEAD-INS MAY CHANGE 15 FEET HORIZONTALLY AND THREE FEET VERTICALLY PRIOR TO INSTALLATIONS AT NO ADDITIONAL COST TO OWNER. LOCATION, SIZE AND INVERT ELEVATIONS OF SANITARY SEWER SHALL BE COORDINATED WITH THE APPROVED PLUMBING PLANS FOR THE BUILDING.
21. ALL TRENCHES SHALL BE CONSTRUCTED IN ACCORDANCE WITH THE OCCUPATIONAL SAFETY AND HEALTH ACT OF 1970 AND THE STANDARDS THEREIN AND APPLICABLE STATE AND LOCAL REGULATIONS.
22. CONTRACTOR SHALL REFER TO SITE GEOTECHNICAL REPORT FOR RECOMMENDATIONS ON COMPACTING AND BACKFILLING TRENCHES. IF NO TRENCH COMPACTION RECOMMENDATIONS ARE PROVIDED, TRENCHES BENEATH OR WITHIN FIVE FEET OF PAVEMENT SHALL BE COMPACTED TO 95% OF STANDARD PROCTOR DENSITY AT A MOISTURE CONTENT BETWEEN OPTIMUM TO FIVE PERCENT ABOVE OPTIMUM. TRENCHES OUTSIDE OF PAVED AREAS SHALL BE COMPACTED TO A MINIMUM 95% OF STANDARD PROCTOR DENSITY AT A MOISTURE CONTENT BETWEEN OPTIMUM TO FIVE PERCENT ABOVE OPTIMUM.
23. TRENCHES SHALL BE TESTED FOR COMPACTION AT A MINIMUM OF ONE TEST PER 300 LINEAR FEET PER LAYER.
24. TRENCHES ENTERING THE BUILDING SHALL BE BACKFILLED WITH CLAY SOIL MATERIAL WITH P.I. EXCEEDING 30 WITHIN FIVE FEET OF THE BUILDING.
25. ANY WATER OR SANITARY SEWER SERVICE LOCATED OUTSIDE OF A STREET RIGHT-OF-WAY, ALLEY OR EASEMENT SHALL BE INSTALLED BY A PLUMBER AND BE INSPECTED BY CODE ENFORCEMENT.
26. FIRE SPRINKLER LINE SHALL BE SIZED AND INSTALLED BY A STATE LICENSED FIRE SPRINKLER CONTRACTOR.
27. ALL PUBLIC WATER LINES SHALL BE CLASS 200 DR14.
28. BLUE EMS DISK SHALL BE INSTALLED ON WATER LINES AT EVERY CHANGE IN DIRECTION, VALVE, FIRE HYDRANT AND SERVICE.

PRINTED: 10/28/2015 5TB FILE: WIER-WATER & SEWER.STB LAST SAVED: 10/28/2015 6:19 AM SAVED BY: PHILIP FILE: UTILITY-NOTES-14029.DWG


RECORD PLANS  
October 28, 2015



PREPARED BY:  
**WIER & ASSOCIATES, INC.**  
ENGINEERS SURVEYORS LAND PLANNERS  
2201 E. LAMAR BLVD., SUITE 200E ARLINGTON, TEXAS 76006 METRO (817)467-7700  
www.wierassociates.com  
Texas Firm Registration No. F-2776

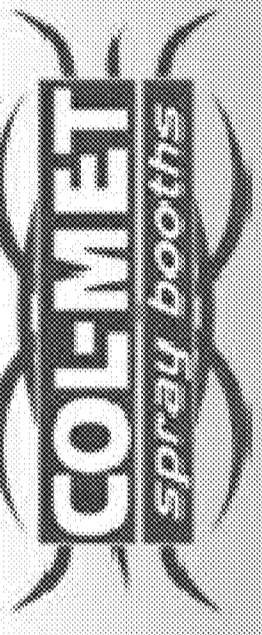


LOT 3, BLOCK B  
ROCKWALL TECHNOLOGY PARK PHASE II  
COL-MET SPRAY BOOTHS  
UTILITY NOTES

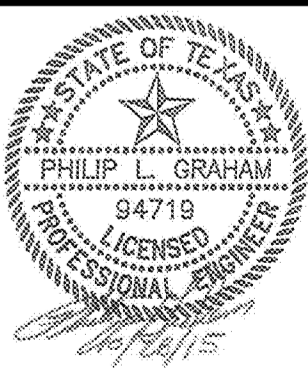

COPYRIGHT ©  
WIER & ASSOCIATES, INC.  
LAST SHEET EDIT  
DATE 10/28/2015  
WA# 14029  
SHEET NO.  
C-U001


SEE SHEET C-U102

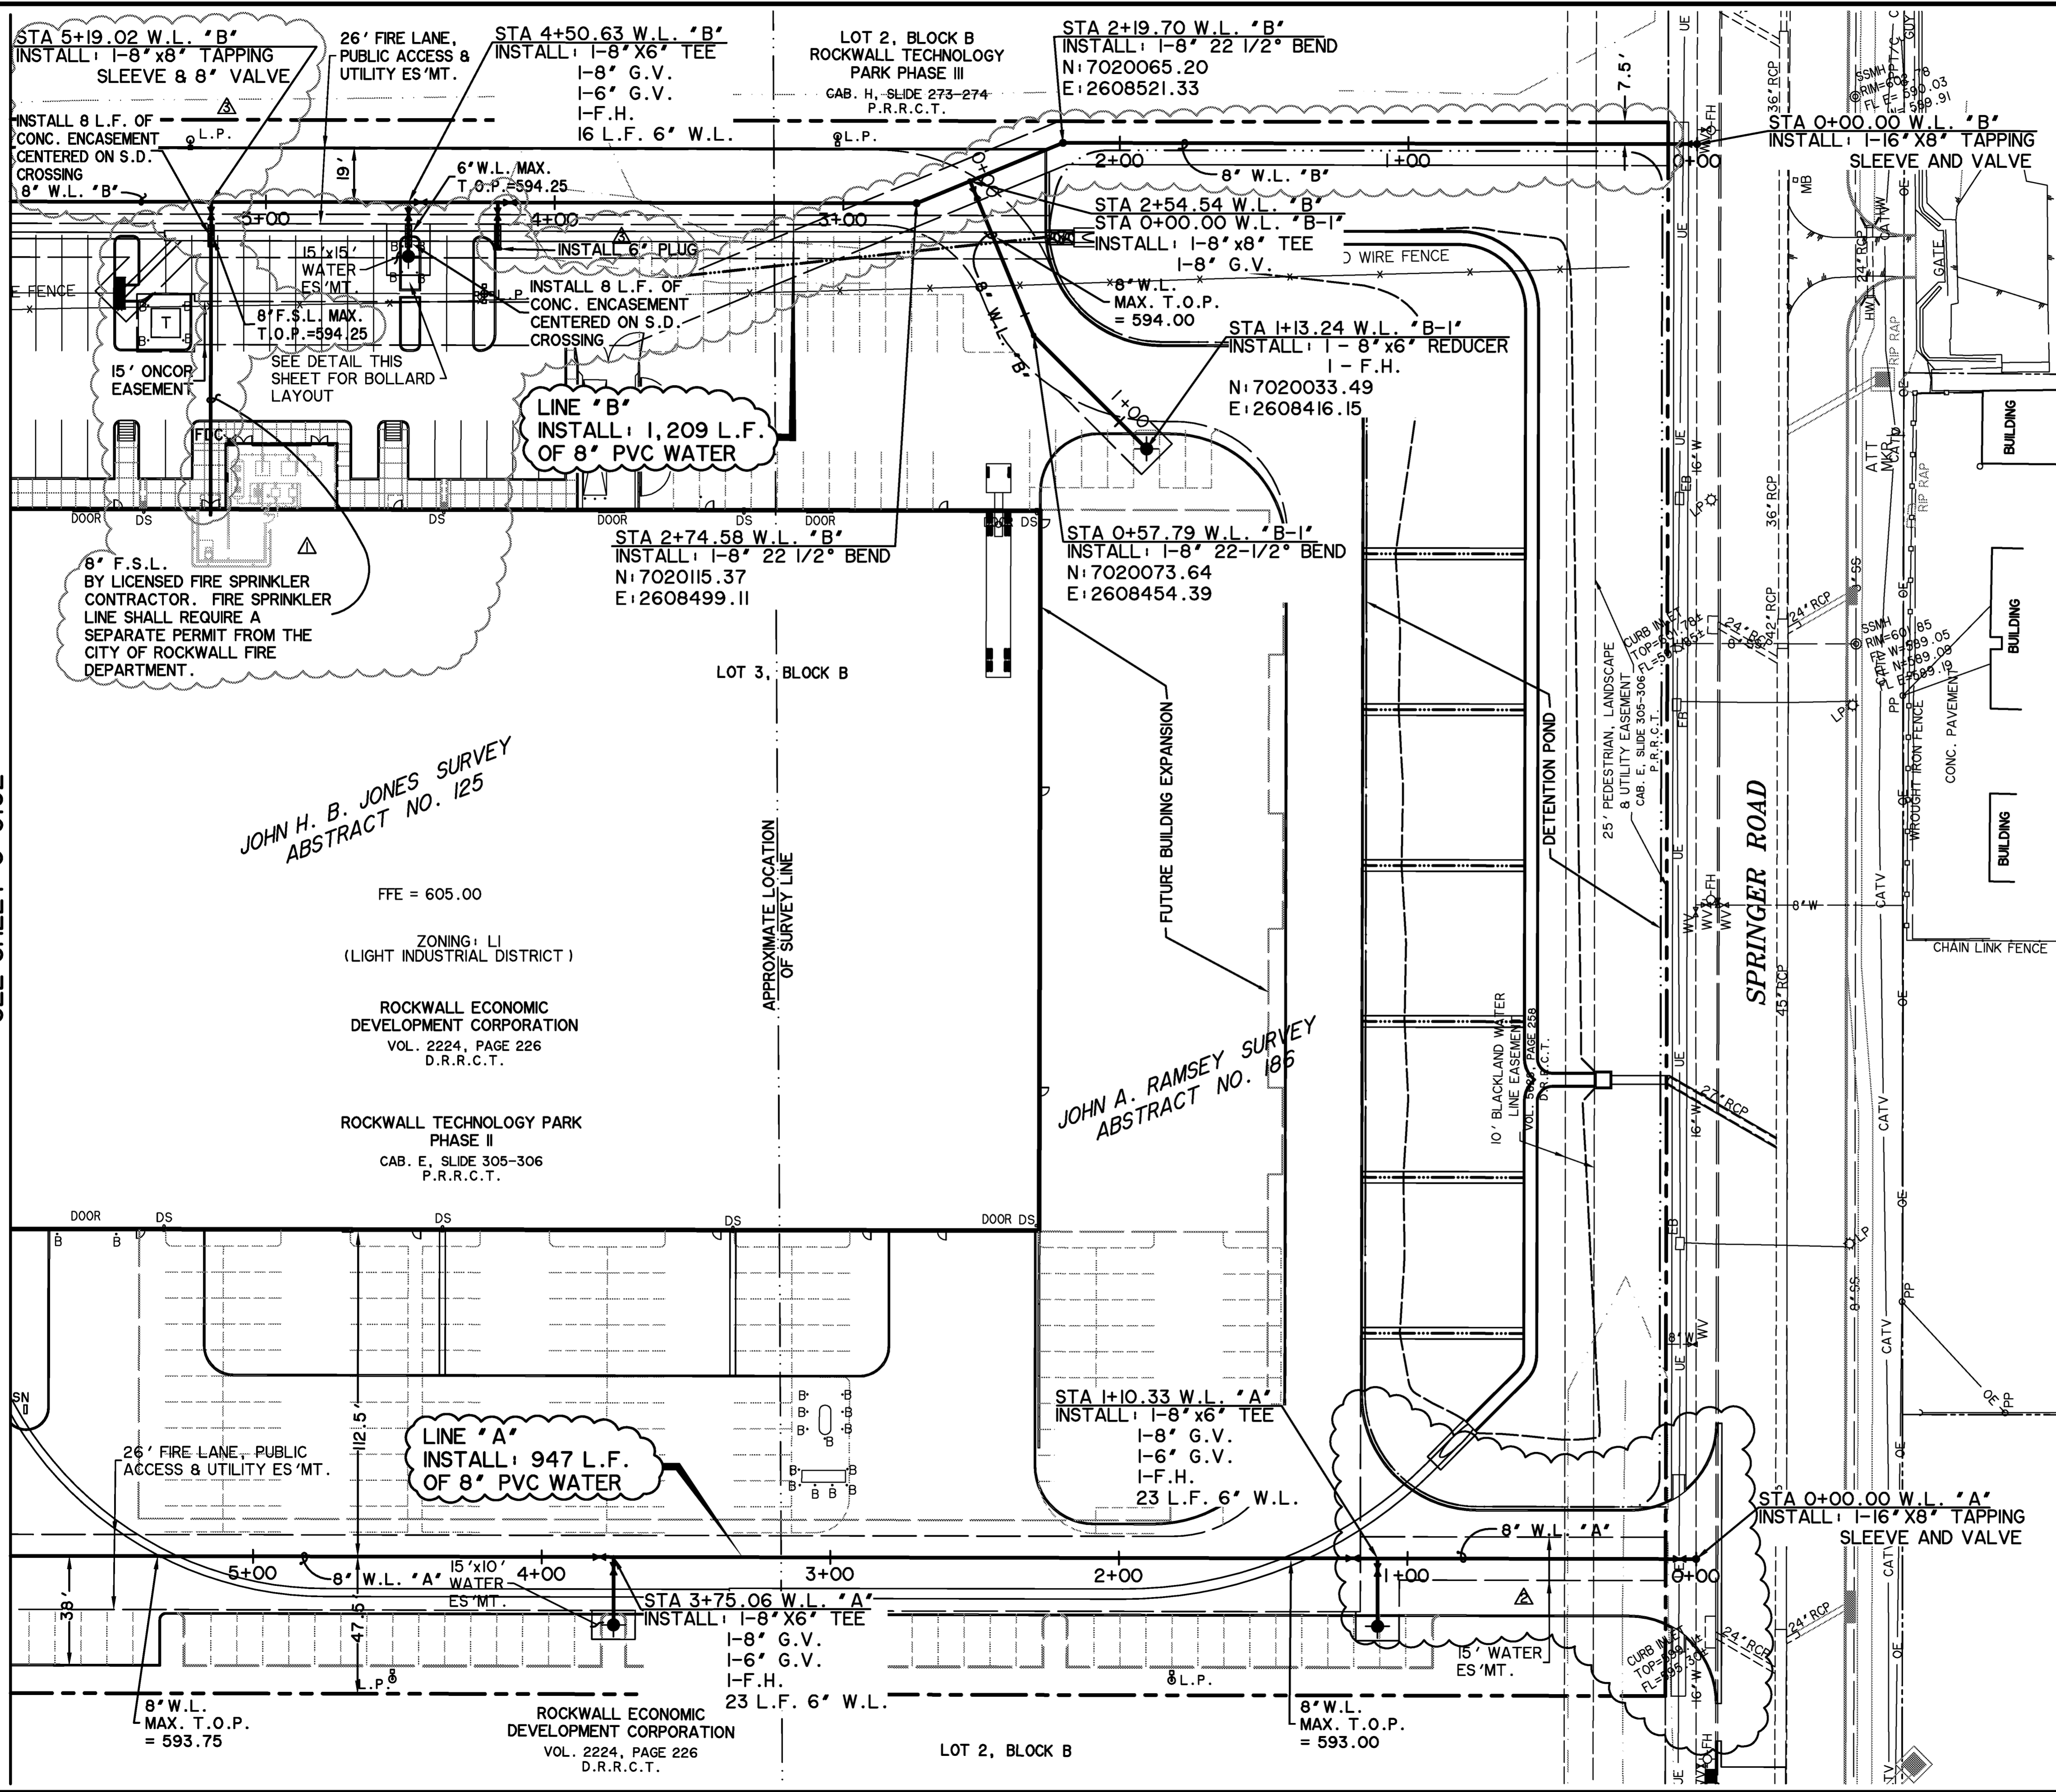

**CAUTION !!!**  
 EXISTING UTILITIES ARE INDICATED ON THE PLANS FROM AVAILABLE INFORMATION. IT SHALL BE THE RESPONSIBILITY OF THE CONTRACTOR TO VERIFY THE LOCATION OF ALL UTILITIES, TO NOTIFY ALL UTILITY COMPANIES OF THE CONTRACTORS OPERATIONS, TO PROTECT ALL UTILITIES FROM DAMAGE, TO REPAIR ALL UTILITIES DAMAGED DUE TO THE CONTRACTORS OPERATIONS, AND TO NOTIFY THE ENGINEER PROMPTLY OF ALL CONFLICTS OF THE WORK WITH EXISTING UTILITIES.

**GENERAL NOTES:**  
 1. SEE SHEET C-S001 FOR UTILITY LEGEND.

**\* BENCHMARKS \***  
**BM A:** "X" CUT ON NORTHWEST CORNER OF CURB INLET ALONG NORTH SIDE OF DISCOVERY BLVD. APPROXIMATELY 990' EAST OF IT'S INTERSECTION WITH F.M. 549. 601.19 FT.  
**BM B:** "X" CUT IN BOX IN THE CONCRETE AROUND A WATER VALVE ON THE BACK OF CURB ALONG THE NORTH SIDE OF SPRINGER RD. APPROXIMATELY 921' EAST OF IT'S INTERSECTION WITH F.M. 549. 600.75 FT.

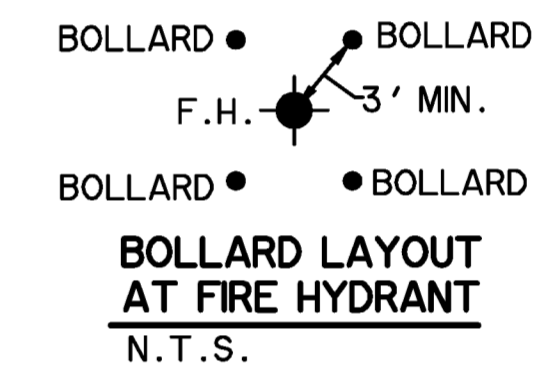

\* ALL RESPONSIBILITY FOR ADEQUACY OF DESIGN REMAINS WITH THE DESIGN ENGINEER. THE CITY OF ROCKWALL, IN REVIEWING AND RELEASING THE PLANS FOR CONSTRUCTION, ASSUMES NO RESPONSIBILITY FOR ADEQUACY OR ACCURACY OF DESIGN. \*


\* ALL SANITARY SEWER WORK DESIGNATED AS "PRIVATE" IN THIS SET OF PLANS SHALL BE INSTALLED IN ACCORDANCE WITH THE INTERNATIONAL PLUMBING CODE, PERMITTED AND INSPECTED BY THE CITY BUILDING INSPECTION DEPARTMENT AND INSTALLED BY A LICENSED PLUMBER. \*

| REVISIONS  | DATE     | BY  |
|--|----------|-----|
| RETAINING WALL, PAVEMENT, WATER LINE, & ONCOR EASEMENT | 01/27/15 | TVW |
| ADDED DRIVE CONNECTION                                 | 03/19/15 | PLG |
| REVISED F.S.L. CONNECTION                              | 03/26/15 | PLG |


**RECORD PLANS**  
 October 28, 2015

**CUSHMAN & WAKEFIELD**  
**SCOTT + REID**  
 General Contractors

PREPARED BY:  
**WIER & ASSOCIATES, INC.**  
**ENGINEERS SURVEYORS & LAND PLANNERS**  
 2201 E. LINAR BLVD., SUITE 200E ARLINGTON, TEXAS 76010 METRO (817)467-7700  
 www.wierassociates.com  
 Texas Firm Registration No. F-2776

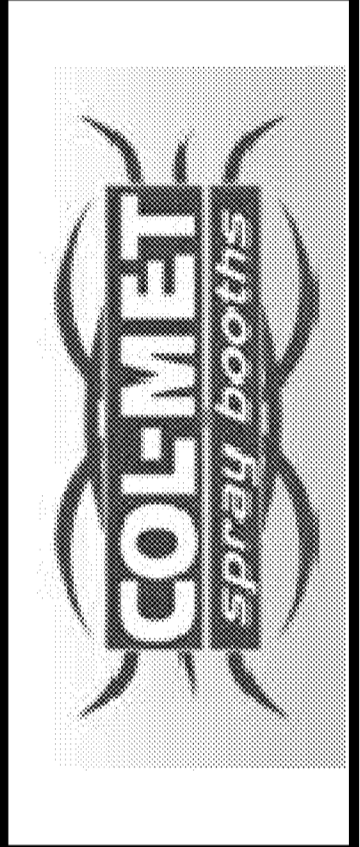

**LOT 3, BLOCK B**  
**ROCKWALL TECHNOLOGY PARK PHASE II**  
**COL-MET SPRAY BOOTHS**  
**UTILITY PLAN SOUTH**

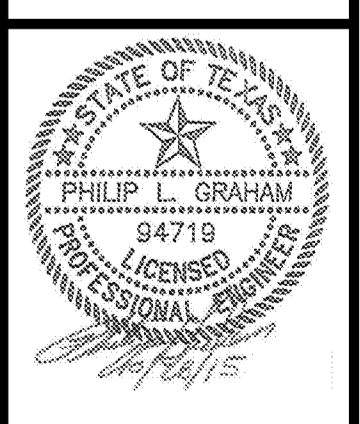

COPYRIGHT ©  
 WIER & ASSOCIATES, INC.  
 LAST SHEET EDIT  
 DATE 10/28/2015  
 WA# 14029  
**SHEET NO.**  
**C-U101**

PRINTED: 10/28/2015 STB FILE: WIER-WATER & SEWER.STB LAST SAVED: 10/28/2015 6:24 AM. SAVED BY: PHILIP FILE: UTILITY-PLAN-2-14029.DWG

LOT 1, BLOCK A  
ROCKWALL TECHNOLOGY  
PARK PHASE II  
CAB. E, SLIDE 305-306  
P.R.R.C.T.  
  
ZONING: LI  
(LIGHT INDUSTRIAL DISTRICT)

LOT 3, BLOCK B  
ROCKWALL TECHNOLOGY PARK PHASE II  
CAB. E, SLIDE 305-306  
P.R.R.C.T.

ZONING: LI  
(LIGHT INDUSTRIAL DISTRICT)

CAB. H, SLIDE 273-274  
P.R.R.C.T.

STA 8+58.00 W.L. 'B'  
INSTALL: 1-8" 45° BEND  
N: 7020689.29  
E: 2608463.87

STA 7+98.81 W.L. 'B'  
INSTALL: 1-8" X6" TEE  
1-8" G.V.  
1-6" G.V.  
1-F.H.  
18 L.F. 6" W.L.

STA 8+27.93 W.L. 'B'  
INSTALL: 1-8" 45° BEND  
N: 7020668.56  
E: 2608485.64

LINE 'B'  
INSTALL: 1,209 L.F.  
OF 8" PVC WATER

STA 11+63.95 W.L. 'B'  
INSTALL: 1-8" 30° BEND  
N: 7020681.85  
E: 2608158.01

STA 10+96.43 W.L. 'B'  
INSTALL: 1-8" X6" TEE  
1-6" G.V.  
1-F.H.  
18 L.F. 6" W.L.

STA 11+79 W.L. 'B'  
INSTALL: 2" DOMESTIC  
BACKFLOW WATER METERS  
WITH DOUBLE-CHECK  
ASSEMBLY PER CITY  
STANDARD DETAILS

STA 12+00 W.L. 'B'  
INSTALL: 2" IRRIGATION WATER  
SERVICE, METER BOX & BACKFLOW  
PREVENTOR PER CITY STANDARD  
DETAILS

STA 8+83.81 W.L. 'A'  
= STA 12+08.51 W.L. 'B'  
INSTALL: 1-8" G.V.  
N: 7020658.99  
E: 2608119.75

STA 1+17.94 S.S. SERVICE  
INSTALL: 1-4" PLUG  
FL 4" = 596.26  
N: 7020597.75  
E: 2608120.94

STA 1+10.00 S.S. SERVICE  
INSTALL: S.S.C.O.  
FL 4" = 596.10  
N: 7020597.56  
E: 2608113.00

STA 6+99.06 W.L. 'A'  
INSTALL: 1-8" X6" TEE  
1-6" G.V.  
1-F.H.  
22 L.F. 6" W.L.

STA 0+00.00 S.S. SERVICE  
CONNECT TO EXISTING S.S.M.H.  
FL 4" = 593.90  
N: 7020689.73  
E: 2608052.96

LINE 'A'  
INSTALL: 947 L.F.  
OF 8" PVC WATER

STA 7+65.37 W.L. 'A'  
INSTALL: 1-8" 45° BEND  
1-8" 11-1/4" BEND  
N: 7020598.24  
E: 2608018.08

LOT 2,  
BLOCK B

VOL. 2224, PAGE 226  
D.R.R.C.T.

**CAUTION !!!**  
EXISTING UTILITIES ARE INDICATED ON THE PLANS FROM AVAILABLE INFORMATION. IT SHALL BE THE RESPONSIBILITY OF THE CONTRACTOR TO VERIFY THE LOCATION OF ALL UTILITIES, TO NOTIFY ALL UTILITY COMPANIES OF THE CONTRACTORS OPERATIONS, TO PROTECT ALL UTILITIES FROM DAMAGE, TO REPAIR ALL UTILITIES DAMAGED DUE TO THE CONTRACTORS OPERATIONS, AND TO NOTIFY THE ENGINEER PROMPTLY OF ALL CONFLICTS OF THE WORK WITH EXISTING UTILITIES.

GENERAL NOTES:  
1. SEE SHEET C-5001 FOR UTILITY LEGEND.

**\* BENCHMARKS \***

**BM A:** "X" CUT ON NORTHWEST CORNER OF CURB INLET ALONG NORTH SIDE OF DISCOVERY BLVD. APPROXIMATELY 990' EAST OF IT'S INTERSECTION WITH F.M. 549. 601.19 FT.

**BM B:** "X" CUT IN BOX IN THE CONCRETE AROUND A WATER VALVE ON THE BACK OF CURB ALONG THE NORTH SIDE OF SPRINGER RD. APPROXIMATELY 921' EAST OF IT'S INTERSECTION WITH F.M. 549. 600.75 FT.

\* ALL RESPONSIBILITY FOR ADEQUACY OF DESIGN REMAINS WITH THE DESIGN ENGINEER. THE CITY OF ROCKWALL, IN REVIEWING AND RELEASING THE PLANS FOR CONSTRUCTION, ASSUMES NO RESPONSIBILITY FOR ADEQUACY OR ACCURACY OF DESIGN. \*

\* ALL SANITARY SEWER WORK DESIGNATED AS "PRIVATE" IN THIS SET OF PLANS SHALL BE INSTALLED IN ACCORDANCE WITH THE INTERNATIONAL PLUMBING CODE, PERMITTED AND INSPECTED BY THE CITY BUILDING INSPECTION DEPARTMENT AND INSTALLED BY A LICENSED PLUMBER. \*

| REVISIONS  | DATE     | BY  |
|--|----------|-----|
| RETAINING WALL, PAVEMENT, WATER LINE, & ONCOR EASEMENT | 01/27/15 | TVW |


**RECORD PLANS**  
October 28, 2015



**CUSHMAN & WAKEFIELD**

**SCOTT + REID**  
General Contractors

PREPARED BY:  
**WIER & ASSOCIATES, INC.**  
ENGINEERS SURVEYORS LAND PLANNERS  
2201 E. LINAR BLVD., SUITE 200E ARLINGTON, TEXAS 76010 METRO (817)467-7700  
www.wierassociates.com  
Texas Firm Registration No. F-2776

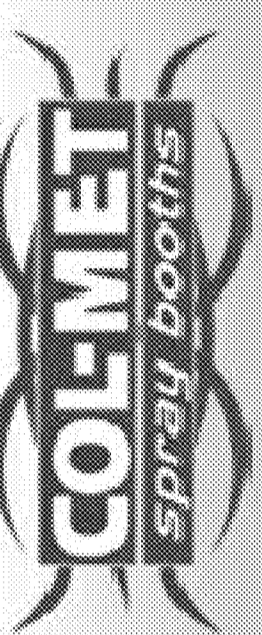

**LOT 3, BLOCK B**  
**ROCKWALL TECHNOLOGY PARK PHASE II**  
**COL-MET SPRAY BOOTHS**  
**UTILITY PLAN**  
NORTH



COPYRIGHT ©  
WIER & ASSOCIATES, INC.  
LAST SHEET EDIT  
DATE: 10/28/2015  
W# 14029  
**SHEET NO.**  
**C-U102**

EROSION CONTROL NOTES

SITE AND OR PROJECT DESCRIPTION DATA


1. CONTRACTOR TO INSTALL PIPE SEDIMENT FILLER AT END OF EACH WORK DAY TO PREVENT ENTRY OF SEDIMENT INTO PROPOSED STORM SEWERS DURING CONSTRUCTION.
2. ALL STAGING AREAS, VEHICLE PARKING AREAS, STOCKPILES, SPOILS, ETC. SHALL BE LOCATED SUCH THAT THEY DO NOT ADVERSELY AFFECT THE STORM WATER QUALITY.
3. ON-SITE FUEL STORAGE TANKS SHALL BE PROTECTED BY A BERMED OR OTHERWISE SPILL PROTECTED AREA.
4. A CENTRAL PIT/WASH BASIN SHOULD BE CONSTRUCTED ON-SITE FOR THE PURPOSE OF TRUCK WASHING.
5. A MAINTENANCE PROGRAM SHALL BE DEVELOPED USING BEST MANAGEMENT PRACTICES FOR THIS PROJECT.
6. IN ORDER TO KEEP DISTURBANCE TO A MINIMUM. VEGETATION SHOULD BE RE-ESTABLISHED ON ALL DENUDED AREAS IN A TIMELY MANNER.
7. GENERAL CONTRACTOR AND OWNER/DEVELOPER ARE RESPONSIBLE FOR PREVENTING SEDIMENT OR OTHER POLLUTANTS FROM LEAVING THE SITE. CARE SHALL BE EXERCISED TO PREVENT THE FLOW OR OFF-SITE TRACKING OF SEDIMENT OR OTHER POLLUTANT TO ADJACENT ROADWAYS, INLETS, STORM SEWERS AND DRAINAGE DITCHES.
8. ALL SURFACE AREAS DISTURBED WITHIN OR ADJACENT TO CONSTRUCTION LIMITS MUST BE PERMANENTLY STABILIZED. STABILIZATION IS OBTAINED WHEN THE SITE IS COVERED WITH IMPERVIOUS STRUCTURES, PAVING OR A UNIFORM PERENNIAL VEGETATION COVER. THE PERENNIAL VEGETATION MUST HAVE A COVERAGE DENSITY OF AT LEAST 70 PERCENT. STABILIZATION IS REQUIRED BEFORE TERMINATING MAINTENANCE AND REMOVAL OF EROSION CONTROL MEASURES.
9. ALL PERIMETER EROSION CONTROL MEASURES AND ROCK STABILIZED EXIT MUST BE IN PLACE BEFORE STARTING SOIL DISTURBING ACTIVITIES.
10. THE GENERAL CONTRACTOR OR OWNER SHALL INSPECT EROSION CONTROL MEASURES AT LEAST ONCE EACH WEEK AND WITHIN 24 HOURS AFTER A STORM EVENT OF 1/2 INCH OR GREATER. RECORDS OF EACH INSPECTION SHOULD BE RETAINED ON SITE WITH THE SWPPP. CONTRACTOR TO REPLACE OR REPAIR DAMAGED MEASURES AS NECESSARY. EROSION CONTROL MEASURES THAT PROVE TO BE INEFFECTIVE SHALL BE REPLACED WITH MORE EFFECTIVE MEASURES OR ADDITIONAL MEASURES WITHIN SEVEN (7) CALENDAR DAYS.
11. GENERAL CONTRACTOR AND OWNER/DEVELOPER SHALL SUBMIT NOTICE OF INTENT (NOI) AND NOTICE OF TERMINATION (NOT) FORMS TO THE EPA AND COPIES TO THE CITY OF AMARILLO ENGINEERING. ALL EPA ASSIGNED PERMIT NUMBERS SHALL BE COPIED TO THE CITY WHEN THEY ARE AVAILABLE.
12. FOR ALTERNATIVE STABILIZATION AND EROSION CONTROL MEASURES, REFER TO THE EROSION AND SEDIMENT CONTROL GUIDELINES IN DEVELOPING AREAS IN TEXAS AND TEXAS HANDBOOK SECTION 17. EROSION CONTROL PRACTICES PUBLISHED BY THE SOIL CONSERVATION SERVICE.
13. IF "SUMP" PUMPS ARE USED TO REMOVE WATER FROM EXCAVATED AREAS, CONTRACTOR TO FILTER THE DISCHARGE TO REMOVE SEDIMENT AND OTHER POLLUTANTS BEFORE THE WATER ENTERS STORM DRAIN FACILITIES OR LEAVES THE SITE.
14. ROCK STABILIZED ACCESS SHALL BE CONSTRUCTED AT ALL POINTS USED AS AN EXIT FROM THE CONSTRUCTION SITE.
15. CONTRACTOR TO LIMIT ANY PROPOSED LIME STABILIZATION OPERATIONS TO THAT WHICH CAN BE MIXED AND COMPACTED BY THE END OF EACH WORK DAY. SILT FENCE IS NOT EFFECTIVE IN FILTERING LIME SINCE THE GRAIN SIZE IS SIGNIFICANTLY SMALLER THAN THE OPENING IN THE FABRIC.
16. STORE ALL TRASH AND BUILDING MATERIAL IN AN ENCLOSURE UNTIL PROPER DISPOSAL AT OFF-SITE FACILITIES.
17. SURFACE STABILIZATION MEASURES MUST BE INITIATED WITHIN 14 DAYS IN ANY AREA WHERE CONSTRUCTION ACTIVITY TEMPORARILY OR PERMANENTLY CEASES FOR A PERIOD OF 21 DAYS OR MORE.

1. NATURE OF THE CONSTRUCTION ACTIVITY:  
THE CONSTRUCTION ACTIVITY CONSISTS OF GRADING, DRAINAGE WATER, SANITARY SEWER AND PAVEMENT IMPROVEMENTS TO CONVERT THE SITE FROM OPEN PROPERTY TO COMMERCIAL.
2. POTENTIAL POLLUTANTS AND SOURCES:  
THE POTENTIAL SOURCES OF POLLUTION IDENTIFIED CONSIST OF STORM WATER RUNOFF FROM CONSTRUCTION ACTIVITIES. THERE ARE NO NON-STORM WATER DISCHARGES THAT ARE KNOWN TO EXIST AT THIS SITE. A SELF CONTAINED PORTABLE FACILITY WILL BE KEPT ON-SITE DURING CONSTRUCTION FOR HUMAN WASTE. CONSTRUCTION FUEL STORAGE IS NOT ANTICIPATED TO BE PROVIDED AT THE SITE. IF FUEL IS STORED AT THE SITE A BERM WILL BE PLACED AROUND THE FUEL TANK.  
CONTRACTOR SHALL MAINTAIN ALONG WITH THE SIGNED EFFECTIVE COPY OF SWP3 DRAWINGS AN UPDATEABLE LIST IDENTIFYING ALL POTENTIAL SOURCES OF POLLUTION INCLUDING PORTA-POTTYS, FUEL TANKS, STAGING AREAS, WASTE CONTAINERS, CHEMICAL STORAGE AREAS, CONCRETE CURE, PAINTS SOLVENTS, ETC., AND A DESCRIPTION OF THE LOCATION.
3. SEQUENCE OF MAJOR CONSTRUCTION ACTIVITIES:  
THE PROJECT SEQUENCE SHALL GENERALLY CONFORM TO THE FOLLOWING:  
PHASE I ESTIMATED START DATE: \_\_\_\_\_ ESTIMATED DURATION: \_\_\_\_\_  
A. CONSTRUCT TEMPORARY CONSTRUCTION ENTRANCE, ROCK BERMS, SEDIMENTATION BASIN, BERMS/SWALES AND SILT FENCE ACCORDING TO THE APPROXIMATE LOCATION AND DETAIL SHOWN ON EROSION CONTROL PLAN SHEETS.  
B. BEGIN CLEARING AND GRADING OF SITE. GRADE OFF-SITE REGIONAL DETENTION POND AND TEMPORARILY USE AS SEDIMENTATION POND.  
C. SEED AND RE-VEGETATE SLOPES WHERE SHOWN.  
PHASE II ESTIMATED START DATE: \_\_\_\_\_ ESTIMATED DURATION: \_\_\_\_\_  
A. KEEP ALL STORM WATER POLLUTION PREVENTION MEASURES IN PLACE.  
B. INSTALL WATER, SANITARY SEWER AND STORM DRAIN AS SPECIFIED ON PLAN SHEETS.  
C. CONSTRUCT TEMPORARY SILT FENCE INLET TREATMENT AROUND OPEN STORM DRAIN INLETS WHERE INDICATED ON EROSION CONTROL PLANS.  
D. CONSTRUCT ALL STORM WATER POLLUTION PREVENTION DEVICES SHOWN ON EROSION CONTROL PLANS FOR PHASE TWO CONSTRUCTION.  
PHASE III ESTIMATED START DATE: \_\_\_\_\_ ESTIMATED DURATION: \_\_\_\_\_  
A. KEEP ALL STORM WATER POLLUTION PREVENTION MEASURES IN PLACE.  
B. STABILIZE SUBGRADE.  
C. INSTALL SITE PAVING AND SIDEWALKS AS SPECIFIED ON PLAN SHEETS.  
D. CONSTRUCT STORM DRAIN INLET TREATMENT AS SPECIFIED ON EROSION CONTROL PLANS FOR PHASE THREE CONSTRUCTION.  
E. REVEGETATE ALL DISTURBED AREAS.  
PHASE IV ESTIMATED START DATE: \_\_\_\_\_ ESTIMATED DURATION: \_\_\_\_\_  
A. LANDSCAPE CONTRACTOR SHALL RE-VEGETATE ALL AREAS RESERVED FOR LANDSCAPE VEGETATIVE COVERS.
4. AREA ESTIMATES:  
TOTAL AREA ONSITE: 12.0 ACRES  
ESTIMATED DISTURBED AREA ON-SITE: 12.0 ACRES  
ESTIMATED DISTURBED AREA OFF-SITE: 2.5 ACRES
5. ESTIMATED RUNOFF COEFFICIENT AFTER CONSTRUCTION IS COMPLETED:  
UNDEVELOPED C = 0.35  
DEVELOPED C = 0.90

6. SOIL TYPE AT SITE:  
DARK BROWN TO LIGHT BROWN AND GRAY FAT CLAY (CH) AND SHALY CLAY TO DEPTHS OF 10 TO 22 FEET WITH GRAY SHALE BENEATH THE SURFACE CLAY SOILS. REFER TO GEOTECHNICAL REPORT BY RONE ENGINEERING (PROJECT No. 14-19061) PROVIDED IN THE CIVIL SPECIFICATIONS.
7. GENERAL LOCATION MAP AND DETAILED SITE MAP:  
REFER TO DRAINAGE AREA MAPS, EROSION CONTROL PLAN SHEETS AND GRADING PLAN SHEETS FOR DRAINAGE PATTERNS AND APPROXIMATE SLOPES ANTICIPATED AFTER MAJOR GRADING ACTIVITIES, AREAS WHERE SOIL DISTURBANCE WILL OCCUR, SOILS DISTURBANCE AREAS, STRUCTURAL CONTROL MEASURES, NATURAL VEGETATIVE FILTERING, RE-VEGETATION, IMPROVED STABILIZATION METHODS, SURFACE WATERS INCLUDING WETLANDS, DIRECT DISCHARGE POINTS TO SURFACE WATER BODIES.
8. TPDES GENERAL PERMIT NUMBERS:  
OWNER \_\_\_\_\_  
CONTRACTOR SCOTT + REID GENERAL CONTRACTORS, INC.  
N.O.I. SUBMITTAL DATES:  
OWNER \_\_\_\_\_  
CONTRACTOR \_\_\_\_\_

PRINTED: 10/28/2015 5TB FILE: WIER-EROSION-CONTROL.STB LAST SAVED: 10/28/2015 6:00 AM SAVED BY: PHILIP G. FILE: EROSION-CONTROL-NOTES-14029.DWG


**WIER & ASSOCIATES, INC.**  
 ENGINEERS SURVEYORS LAND PLANNERS  
 2201 E. LAMAR BLVD., SUITE 200E ARLINGTON, TEXAS 76006 METRO (817)467-7700  
 www.wierassociates.com  
 Texas Firm Registration No. F-2776

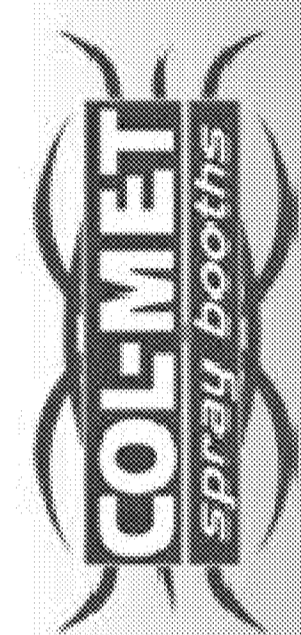

**LOT 3, BLOCK B**  
**ROCKWALL TECHNOLOGY PARK PHASE II**  
**COL-MET SPRAY BOOTHS**  
**EROSION CONTROL NOTES**




**RECORD PLANS**  
**October 28, 2015**

COPYRIGHT ©  
 WIER & ASSOCIATES, INC.  
 LAST SHEET OF 11  
 DATE 10/28/2015  
 WA# 14029  
**SHEET NO.**  
**C-E001**



PRINTED: 10/28/2015 10:28/2015 6:01 AM LAST SAVED: 10/28/2015 6:01 AM FILE: WIER-EROSION-CONTROL-STB PHILIPG FILE: EROSION-CONTROL-PLAN-I-14029.DWG

SEE SHEET C-E102

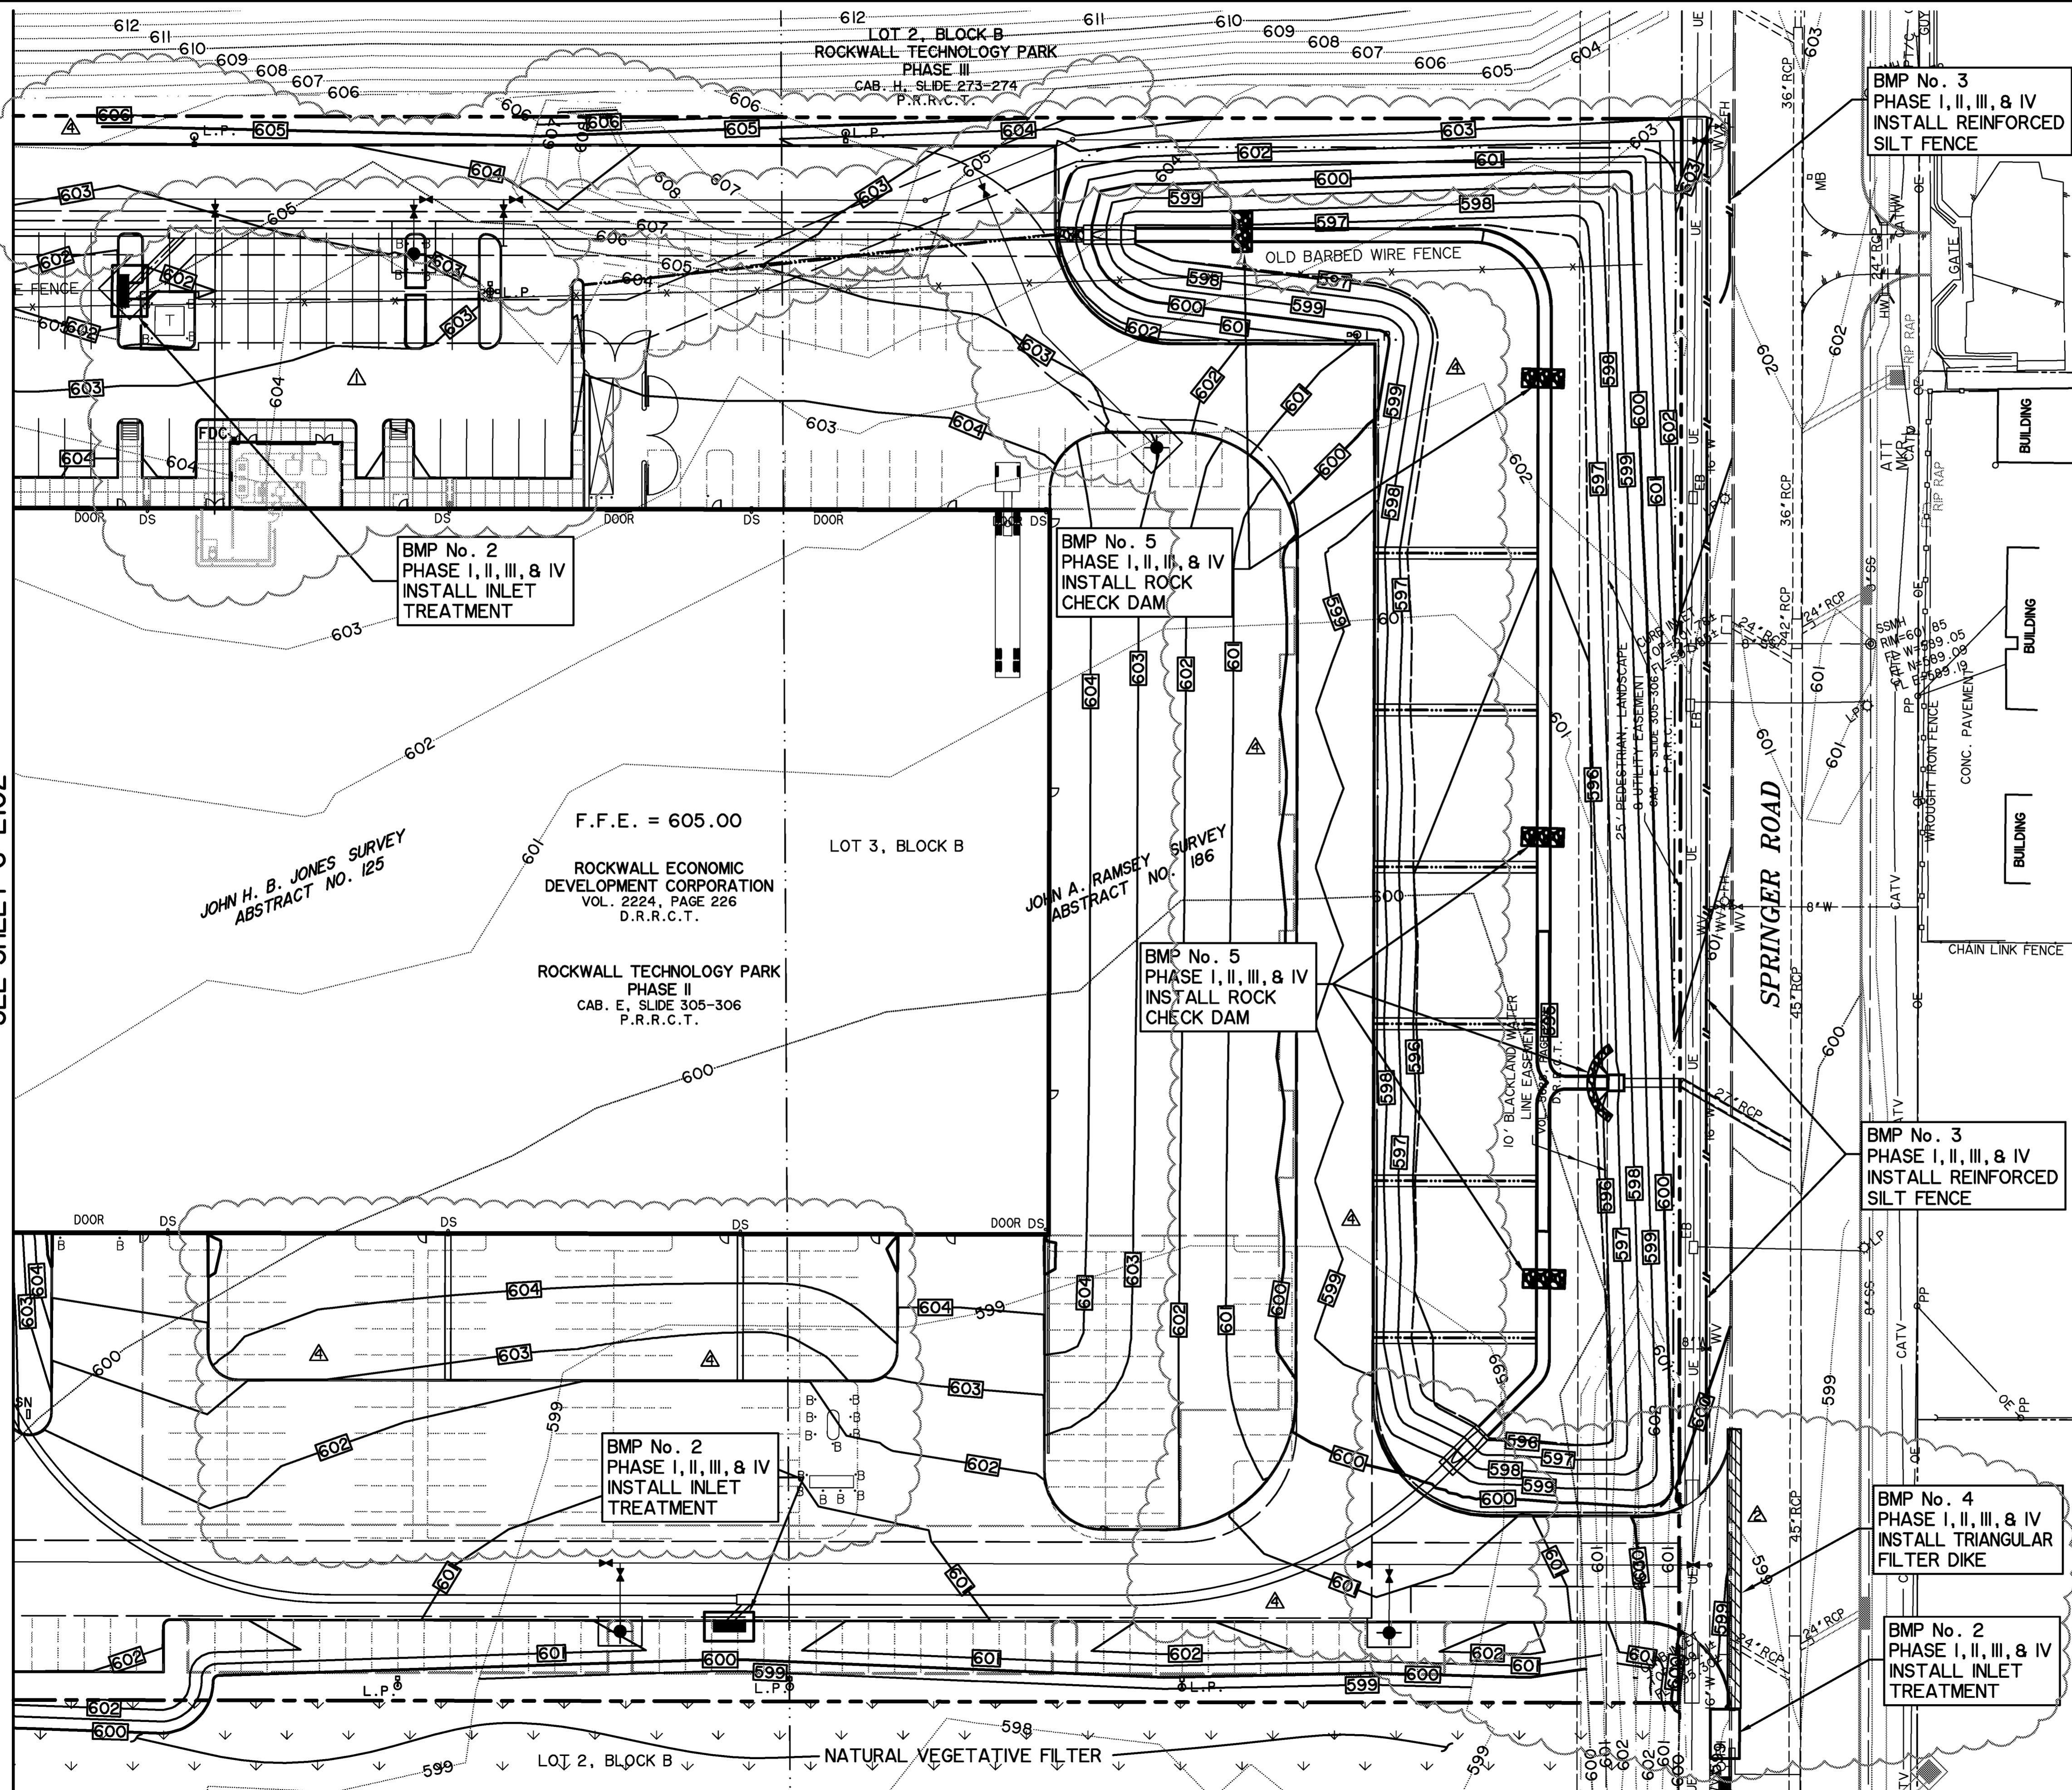


**CAUTION !!**  
EXISTING UTILITIES ARE INDICATED ON THE PLANS FROM AVAILABLE INFORMATION. IT SHALL BE THE RESPONSIBILITY OF THE CONTRACTOR TO VERIFY THE LOCATION OF ALL UTILITIES, TO NOTIFY ALL UTILITY COMPANIES OF THE CONTRACTORS OPERATIONS, TO PROTECT ALL UTILITIES FROM DAMAGE, TO REPAIR ALL UTILITIES DAMAGED DUE TO THE CONTRACTORS OPERATIONS, AND TO NOTIFY THE ENGINEER PROMPTLY OF ALL CONFLICTS OF THE WORK WITH EXISTING UTILITIES.

SEE SHEET C-S001 FOR TOPOGRAPHIC LEGEND

\* ALL RESPONSIBILITY FOR ADEQUACY OF DESIGN REMAINS WITH THE DESIGN ENGINEER. THE CITY OF ROCKWALL, IN REVIEWING AND RELEASING THE PLANS FOR CONSTRUCTION, ASSUMES NO RESPONSIBILITY FOR ADEQUACY OR ACCURACY OF DESIGN.

**RECORD PLANS**  
October 28, 2015

| REVISIONS   | DATE     | BY  |
|---|----------|-----|
| ▲ RETAINING WALL, PAVEMENT, WATER LINE, & ONCOR EASEMENT      | 01/27/15 | TVW |
| ▲ ADD DRIVE CONNECTION, REVISE GRADING & EROSION CONTROL      | 03/19/15 | PLG |
| ▲ ADD ADDITIONAL TRUCK PARKING & RAISED FIRE LANE PAVEMENT 1' | 04/13/15 | TVW |

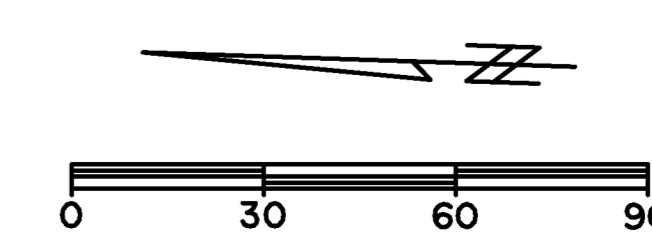

**CUSHMAN & WAKEFIELD**  
SCOTT + REID  
General Contractors

PREPARED BY:  
**WIER & ASSOCIATES, INC.**  
ENGINEERS SURVEYORS LAND PLANNERS  
2201 E. LAMAR BLVD., SUITE 200E ARLINGTON, TEXAS 76006 METRO (817)467-7700  
Texas Firm Registration No. F-2776 www.wierassociates.com




**LOT 3, BLOCK B**  
**ROCKWALL TECHNOLOGY PARK PHASE I**  
**COL-MET SPRAY BOOTHS**  
**EROSION CONTROL PLAN**  
SOUTH



COPYRIGHT ©  
WIER & ASSOCIATES, INC.  
LAST SHEET EROSION CONTROL PLAN  
DATE 10/28/2015  
WA# 14029  
**SHEET NO. C-E101**

PRINTED: 10/28/2015 10:28:20 AM FILE: WIER-EROSION-CONTROL-STB LAST SAVED: 10/28/2015 6:02 AM FILE: PHILIPG FILE: EROSION-CONTROL-PLAN-2-14029.DWG

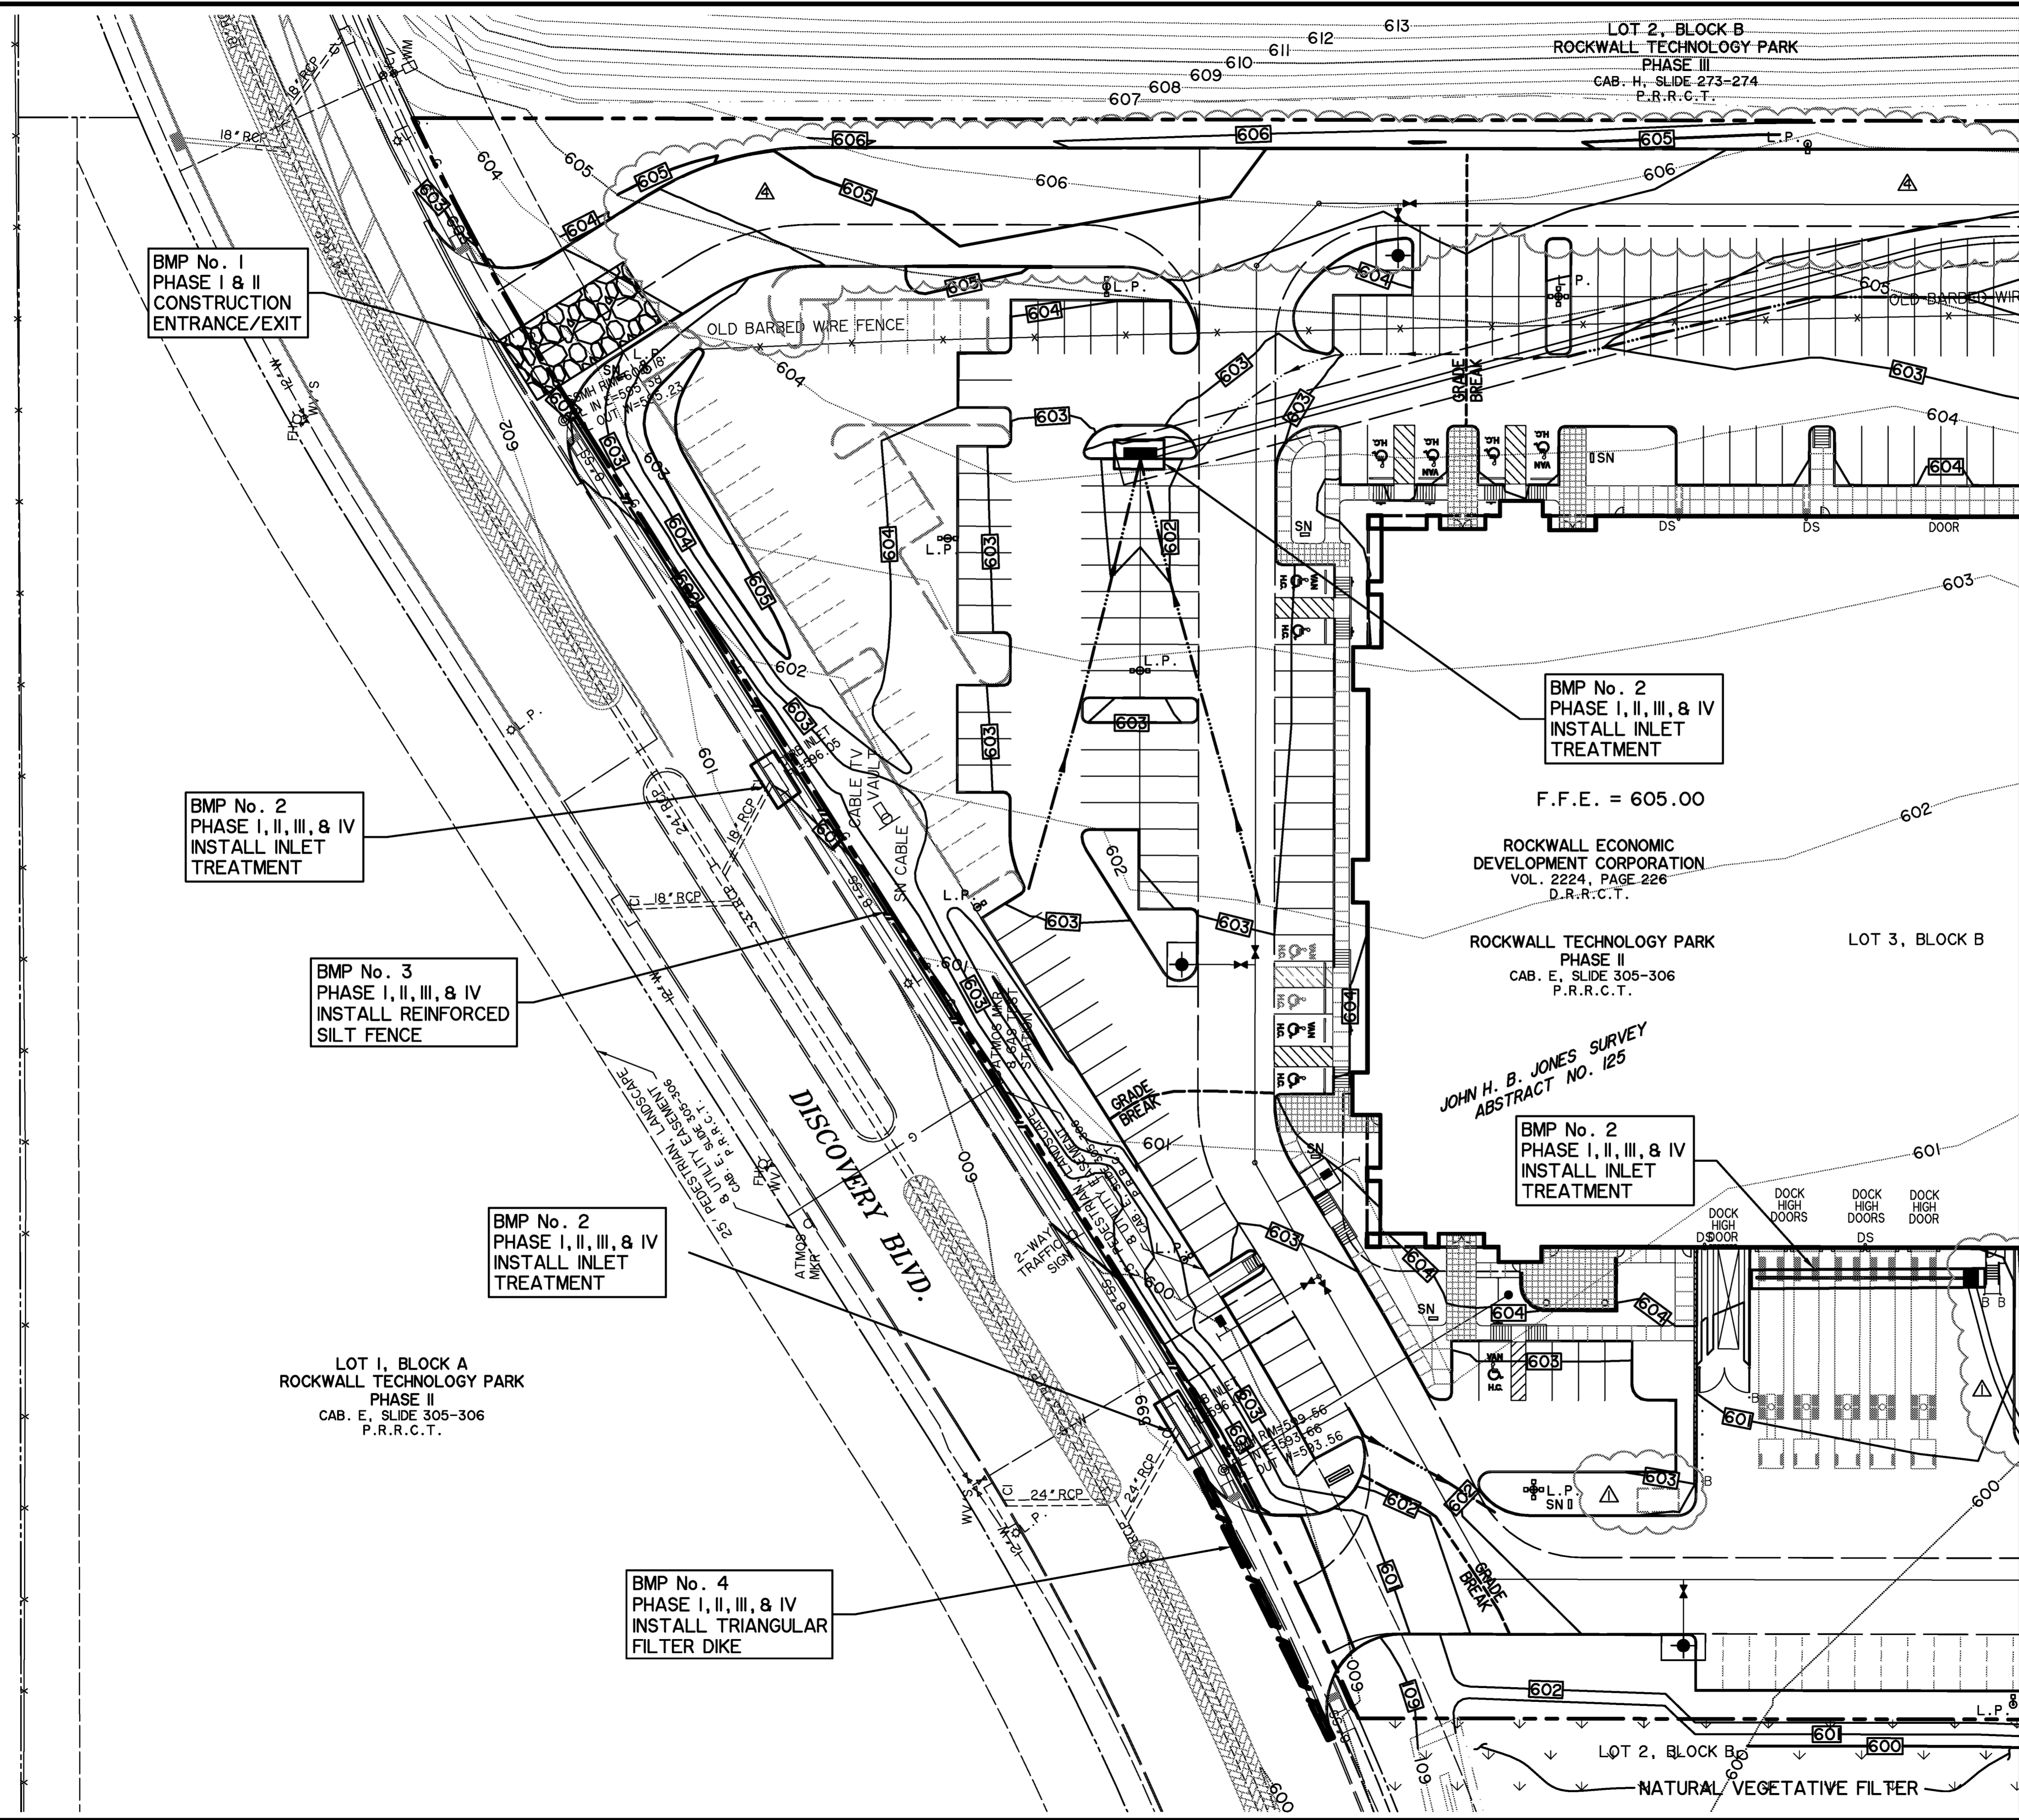

BMP No. 1  
PHASE I & II  
CONSTRUCTION  
ENTRANCE/EXIT

BMP No. 2  
PHASE I, II, III, & IV  
INSTALL INLET  
TREATMENT

BMP No. 3  
PHASE I, II, III, & IV  
INSTALL REINFORCED  
SILT FENCE

BMP No. 2  
PHASE I, II, III, & IV  
INSTALL INLET  
TREATMENT

LOT 1, BLOCK A  
ROCKWALL TECHNOLOGY PARK  
PHASE II  
CAB. E. SLIDE 305-306  
P.R.R.C.T.

BMP No. 4  
PHASE I, II, III, & IV  
INSTALL TRIANGULAR  
FILTER DIKE

LOT 2, BLOCK B  
ROCKWALL TECHNOLOGY PARK  
PHASE III  
CAB. H. SLIDE 273-274  
P.R.R.C.T.

BMP No. 2  
PHASE I, II, III, & IV  
INSTALL INLET  
TREATMENT

F.F.E. = 605.00  
ROCKWALL ECONOMIC  
DEVELOPMENT CORPORATION  
VOL. 2224, PAGE 226  
D.R.R.C.T.

ROCKWALL TECHNOLOGY PARK  
PHASE II  
CAB. E. SLIDE 305-306  
P.R.R.C.T.

JOHN H. B. JONES SURVEY  
ABSTRACT NO. 125

BMP No. 2  
PHASE I, II, III, & IV  
INSTALL INLET  
TREATMENT

DOCK  
HIGH  
DOORS  
DOCK  
HIGH  
DOORS  
DOCK  
HIGH  
DOOR

RECORD PLANS  
October 28, 2015


| REVISIONS   | DATE     | BY  |
|---|----------|-----|
| RETAINING WALL, PAVEMENT, WATER LINE, & ONCOR EASEMENT        | 01/27/15 | TVW |
| ADDED ADDITIONAL TRUCK PARKING & RAISED FIRE LANE PAVEMENT 1" | 04/13/15 | TVW |

**CAUTION 11**  
EXISTING UTILITIES ARE INDICATED ON THE PLANS FROM AVAILABLE INFORMATION. IT SHALL BE THE RESPONSIBILITY OF THE CONTRACTOR TO VERIFY THE LOCATION OF ALL UTILITIES, TO NOTIFY ALL UTILITY COMPANIES OF THE CONTRACTORS OPERATIONS, TO PROTECT ALL UTILITIES FROM DAMAGE, TO REPAIR ALL UTILITIES DAMAGED DUE TO THE CONTRACTORS OPERATIONS, AND TO NOTIFY THE ENGINEER PROMPTLY OF ALL CONFLICTS OF THE WORK WITH EXISTING UTILITIES.

SEE SHEET C-S001 FOR TOPOGRAPHIC LEGEND


\* ALL RESPONSIBILITY FOR ADEQUACY OF DESIGN REMAINS WITH THE DESIGN ENGINEER. THE CITY OF ROCKWALL, IN REVIEWING AND RELEASING THE PLANS FOR CONSTRUCTION, ASSUMES NO RESPONSIBILITY FOR ADEQUACY OR ACCURACY OF DESIGN.

SEE SHEET C-E101

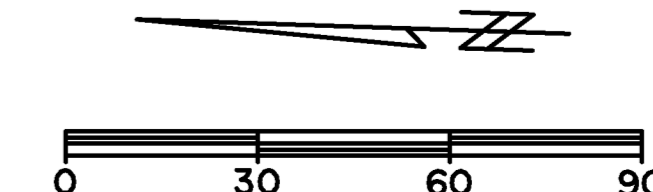


CUSHMAN & WAKEFIELD  
SCOTT + REID  
General Contractors

PREPARED BY:  
**WIER & ASSOCIATES, INC.**  
ENGINEERS SURVEYORS LAND PLANNERS  
2201 E. LAMAR BLVD., SUITE 200E ARLINGTON, TEXAS 76010 METRO (817) 467-7700  
www.wierassociates.com  
Texas Firm Registration No. F-2776

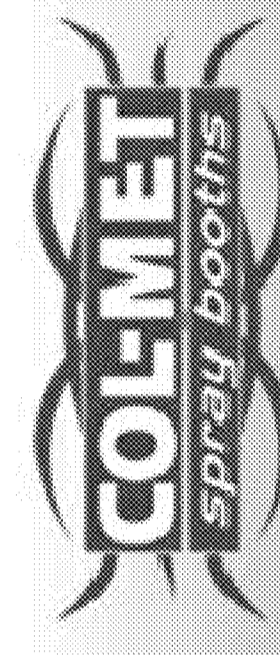

LOT 3, BLOCK B  
ROCKWALL TECHNOLOGY PARK PHASE I  
COL-MET SPRAY BOOTHS  
EROSION CONTROL PLAN  
NORTH

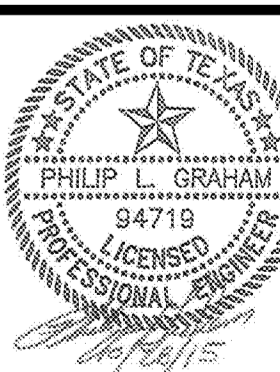

COPYRIGHT ©  
WIER & ASSOCIATES, INC.  
LAST SHEET 1 OF 11  
DATE 10/28/2015  
WA# 14029  
SHEET NO.  
C-E102

### Stabilized Construction Entrance

**Applications**

- Perimeter Control
- Slope Protection
- Sediment Trapping
- Channel Protection
- Temporary Stabilization
- Permanent Stabilization
- Waste Management
- Housekeeping Practices

**Targeted Constituents**

- Sediment
- Nutrients Toxic Materials
- Oil & Grease
- Floatable Materials
- Other Construction Wastes

**Implementation Requirements**

- Capital Costs
- Maintenance
- Training
- Suitability for Slopes > 5%

**Legend**

- Significant Impact
- Medium Impact
- Low Impact
- Unknown or Questionable Impact

**Fe = N/A**

**S-9**

North Central Texas Council of Governments

**DESCRIPTION**  
A stabilized construction entrance consists of a pad consisting of crushed stone, recycled concrete or other rock like material on top of geotextile filter cloth to facilitate the removal of sediment and other debris from construction equipment prior to exiting the construction site. This directly addresses the problem of silt and mud deposition in roadways used for construction site access. For added effectiveness, a wash rack area can be incorporated into the design to further reduce sediment tracking (See Wheel Wash, Fact Sheet S-10).

**PRIMARY USE**  
Stabilized construction entrances are used primarily for sites in which significant truck traffic occurs on a daily basis. It reduces the need to remove sediment from streets. If used properly, it also directs the majority of traffic to a single location, reducing the number and quantity of disturbed areas on the site and providing protection for other structural controls through traffic control.

**APPLICATIONS**  
Stabilized construction entrances are a required part of the erosion control plan for all construction sites. If possible, controlled entrances should be incorporated into small lot construction due to the large percentage of disturbed area on the site and the high potential for offsite tracking of silt and mud.

**DESIGN CRITERIA**

- Stabilized construction entrances are to be constructed such that drainage across the entrance is directed to a controlled, stabilized outlet on site with provisions for storage, proper filtration, and removal of wash water.
- The entrance must be sloped away from the paved surface so that storm water is not allowed to leave the site onto roadways.
- Minimum width of entrance shall be 15 feet.
- Stone shall be placed in a layer of at least 12-inches thickness. The stone shall be a minimum of 4 to 6 inch coarse aggregate.
- Prevent shortcutting of the full length of the construction entrance by installing barriers as necessary.

### Stabilized Construction Entrance

**Legend**

- Significant Impact
- Medium Impact
- Low Impact
- Unknown or Questionable Impact

**Fe = N/A**

**S-9**

North Central Texas Council of Governments

**DESCRIPTION**

- The geotextile fabric must meet the following minimum criteria:
  - Tensile Strength, ASTM D4832 Test Method for Grab Breaking Load and Elongation of Geotextiles, 300-lbs.
  - Puncture Strength, ASTM D4833 Test Method for Index Puncture Resistance of Geotextiles, Geomembranes, and Related Products, 120-lbs.
  - Mullen Burst Rating, ASTM D3786 Standard Test Method for Hydraulic Bursting Strength of Textile Fabrics-Diaphragm Bursting Strength Tester Method, 600-psi.
  - Apparent Opening Size, ASTM D4751 Test Method for Determining Apparent Opening Size of a Geotextile, U.S. Sieve No. 40 (max).
- When necessary, vehicles must be cleaned to remove sediment prior to entrance onto paved roads, streets, or parking lots. When washing is required, it shall be done on a constructed wheel wash facility that drains into an approved sediment trap or sediment basin or other sedimentation/filtration device.
- Minimum dimensions for the entrance shall be as follows:

| Tract Area | Avg. Tract Depth | Min. Width of Entrance | Min. Depth of Entrance |
|------------|------------------|------------------------|------------------------|
| < 1 Acre   | 100 feet         | 15 feet                | 20 feet                |
| < 5 Acres  | 200 feet         | 20 feet                | 50 feet                |
| > 5 Acres  | > 200 feet       | 25 feet                | 75-100 feet            |

**LIMITATIONS**  
Selection of the construction entrance location is critical. To be effective, it must be used exclusively. Stabilized entrances are rather expensive considering that it must be installed in combination with one or more other sediment control techniques, but it may be cost effective compared to labor-intensive street cleaning.

**MAINTENANCE REQUIREMENTS**  
Construction entrances should be inspected regularly (at least as often as required by the TPDES Construction General Permit, Appendix A). When sediment has substantially clogged the void area between the rocks, the aggregate mat must be washed down or replaced. Periodic re-grading and top dressing with additional stone must be done to keep the efficiency of the entrance from diminishing.

If the stabilized construction entrance is not effectively removing sediment from wheels then a wheel wash should be considered.

**SPECIFICATION**  
Specifications for construction of this item may be found in the Standard Specifications for Public Works Construction - North Central Texas Council of Governments, Section 201.10 Stabilized Construction Entrance.

### Stabilized Construction Entrance

**Profile View**

**Plan View**

**DESCRIPTION**

- The location should be within the stabilized construction entrance so that the vehicle does not pick up additional sediment load by traversing disturbed areas.
- The size of the wheel wash facility should be sufficient so that all wash water and sediment is collected and drained to a sediment trapping device such as a sediment basin or stone outlet sediment trap.
- Suggested designs:
  - 4-inch thick asphalt pavement on an 8-inch base of crushed rock graded so that wash water drains to a swale; or
  - grate suitably designed to support construction vehicles installed over a swale.
- The facility should be designed so that it can be cleaned between uses.

**LIMITATIONS**  
Sediment trapping BMPs used in conjunction with wheel wash facilities must be carefully designed for the anticipated amount of wash water to be treated.

### Wheel Wash

**Applications**

- Perimeter Control
- Slope Protection
- Sediment Trapping
- Channel Protection
- Temporary Stabilization
- Permanent Stabilization
- Waste Management
- Housekeeping Practices

**Targeted Constituents**

- Sediment
- Nutrients Toxic Materials
- Oil & Grease
- Floatable Materials
- Other Construction Wastes

**Implementation Requirements**

- Capital Costs
- Maintenance
- Training
- Suitability for Slopes > 5%

**Legend**

- Significant Impact
- Medium Impact
- Low Impact
- Unknown or Questionable Impact

**Fe = N/A**

**S-10**

North Central Texas Council of Governments

**DESCRIPTION**  
The wheel wash is used in conjunction with a stabilized construction entrance to provide an area where truck wheels and undercarriages can be cleaned prior to traversing the stabilized construction entrance and entering the public road system. A wheel wash may consist of an impervious area or a grate over a swale. Wash water from hand held pressure washers or fixed nozzles is collected and drained to a sediment-trapping device such as a stone outlet sediment trap or sediment basin to provide for removal of sediment prior to discharge.

**PRIMARY USE**  
Wheel washes should be used on large jobs where there is significant truck traffic, on those sites where site conditions cause the stabilized construction entrance to be overloaded with sediment and become ineffective, and in those instances where contaminated solids might be present on site. They provide added protection and reduce the need to remove sediment from streets.

**APPLICATIONS**  
Wheel washes should be considered an ancillary component to the stabilized construction entrance.

**DESIGN CRITERIA**

- The location should be within the stabilized construction entrance so that the vehicle does not pick up additional sediment load by traversing disturbed areas.
- The size of the wheel wash facility should be sufficient so that all wash water and sediment is collected and drained to a sediment trapping device such as a sediment basin or stone outlet sediment trap.
- Suggested designs:
  - 4-inch thick asphalt pavement on an 8-inch base of crushed rock graded so that wash water drains to a swale; or
  - grate suitably designed to support construction vehicles installed over a swale.
- The facility should be designed so that it can be cleaned between uses.

**LIMITATIONS**  
Sediment trapping BMPs used in conjunction with wheel wash facilities must be carefully designed for the anticipated amount of wash water to be treated.

### Check Dams

**Applications**

- Perimeter Control
- Slope Protection
- Sediment Trapping
- Channel Protection
- Temporary Stabilization
- Permanent Stabilization
- Waste Management
- Housekeeping Practices

**Targeted Constituents**

- Sediment
- Nutrients Toxic Materials
- Oil & Grease
- Floatable Materials
- Other Construction Wastes

**Implementation Requirements**

- Capital Costs
- Maintenance
- Training
- Suitability for Slopes > 5%

**Legend**

- Significant Impact
- Medium Impact
- Low Impact
- Unknown or Questionable Impact

**Fe=0.40**

**S-7**

North Central Texas Council of Governments

**DESCRIPTION**  
Check dams are small barriers consisting of rock, sand bag or earth berms placed across a drainage swale or ditch. They reduce the velocity of small concentrated flows, provide a limited barrier for sediment and help disperse concentrated flows, reducing potential erosion.

**PRIMARY USE**  
Check dams are used for long drainage swales or ditches to reduce erosive velocities. They are typically used in conjunction with other channel protection techniques such as vegetation lining and turf reinforcement mats. Check dams provide limited treatment to sediment-laden flows. They are more useful in reducing flow to acceptable levels for other techniques.

**APPLICATIONS**  
Check dams are typically used early in construction in swales for long linear projects such as roadways. They can also be used in short swales with a steep slope to reduce unacceptable velocities. Check dams shall not be used in live stream channels.

**DESIGN CRITERIA**

- Check dams should be placed at a distance and height to allow small pools to form between each one. Typically, dam height should be between 18" and 36". Dams should be spaced such that the top of the downstream dam should be at the same elevation as the toe of the upstream dam.
- Major flows (greater than 2 year design storm) must pass the check dam without causing excessive upstream flooding.
- Check dams should be used in conjunction with other sediment reduction techniques prior to releasing flow offsite.
- Use geotextile filter fabric under check dams exceeding 18 inches in height. The fabric shall meet the material specified for the Stone Outlet Sediment Trap, S-5.

**Rock Check Dams**

- Stone shall be well graded with size range from 1-1/2 to 3-1/2 inches in diameter depending on expected flows.
- Rock check dams should be triangular in cross section with side slopes of 1:1 or flatter on the upstream side and 2:1 or flatter on the downstream side.

### Check Dams

**Sand Bag Dams**

- Sand bag check dams should have a maximum flow through rate of 0.1 cfs per square foot of surface with a minimum top width of 16 inches and bottom width of 48 inches. Bags should be filled with coarse sand, pea gravel, or filter stone that is clean and free of deleterious material.
- Bag length shall be 24-inches to 30-inches, width shall be 16-inches to 18-inches and thickness shall be 6-inches to 8-inches and having an approximate weight of 40-pounds.
- Bag material shall be polypropylene, polyethylene, polyamide or cotton burlap woven fabric, minimum unit weight 4-ounces-per-square-yard, Mullen burst strength exceeding 300-psi as determined by ASTM D3786 Standard Test Method for Hydraulic Bursting Strength of Textile Fabrics-Diaphragm Bursting Strength Tester Method, and ultraviolet stability exceeding 70-percent.
- PVC pipes may be installed through the sand bag dam near the top to allow for controlled flow through the dam. Pipe should be schedule 40 or heavier polyvinyl chloride (PVC) having a nominal internal diameter of 4 inches.

**LIMITATIONS**  
Minor ponding will occur upstream of the check dams. For heavy flows or high velocity flows, extensive maintenance or replacement of the dams will be required.

Care must be used when taking out rock check dams in order to remove as much rock as possible. Loose rock can create an extreme hazard during mowing operations once the area has been stabilized.

**MAINTENANCE REQUIREMENTS**  
Check dams should be inspected regularly (at least as often as required by the TPDES Construction General Permit, Appendix A). Silt must be removed when it reaches approximately 1/3 the height of the dam or 12", whichever is less.

**SPECIFICATION**  
Specifications for construction of this item may be found in the Standard Specifications for Public Works Construction - North Central Texas Council of Governments, Section 201.9 Rock Dam and Item 201.11 Sand Bag Dam.

### Check Dams


**View Looking Upstream**

**Section A - A**


**Spacing Between Check Dams**

**Source:** Stormwater Management Manual for Western Washington.


RECORD PLANS  
October 28, 2015

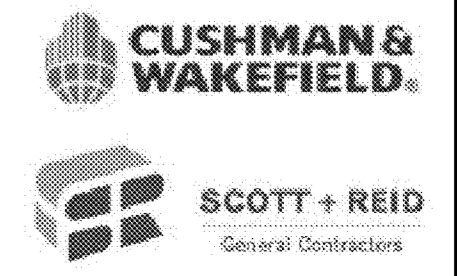

PREPARED BY:  
**WIER & ASSOCIATES, INC.**  
ENGINEERS SURVEYORS LAND PLANNERS  
2201 E. LAMAR BLVD., SUITE 200E ARLINGTON, TEXAS 76006 METRO (817)467-7700  
www.wierassociates.com

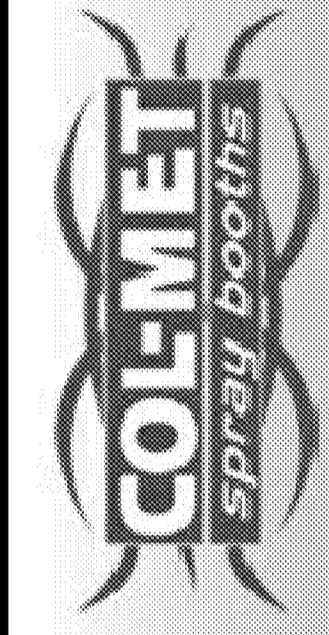

LOT 3, BLOCK B  
ROCKWALL TECHNOLOGY PARK PHASE I  
COL-MET SPRAY BOOTHS  
EROSION CONTROL DETAILS

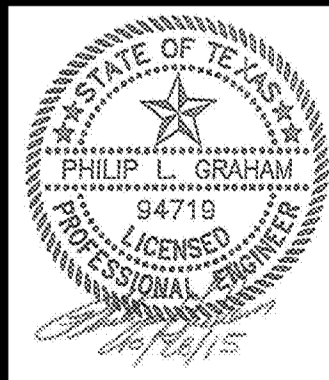

COPYRIGHT ©  
WIER & ASSOCIATES, INC.  
LAST SHEET EDIT  
DATE 10/28/2015  
WA# 14029  
SHEET NO.  
C-E201

PRINTED: 10/28/2015 5:17 AM FILE: WIER-EROSION-CONTROL-STB LAST SAVED: 10/28/2015 5:17 AM FILE: PHILIP EROSION-CONTROL-DETAILS-2-14029.DWG

### Inlet Protection

**DESCRIPTION**  
Inlet protection consists of a variety of methods of intercepting sediment at low point inlets through the use of stone, filter fabric, inlet inserts, and other materials. This is normally located at the inlet, providing either detention or filtration to reduce sediment and floatable materials in storm water.

**PRIMARY USE**  
Inlet protection should be considered a secondary defense in site erosion control due to the limited effectiveness and applicability of the technique. It is normally used in new developments that include new inlets or roads with new curb inlets or during major repairs to existing roadways.

**APPLICATIONS**  
Different inlet protection variations are used for different conditions as follows:

- Filter barrier protection (similar to a silt fence barrier around the inlet) is appropriate when the drainage area is less than one acre and the basin slope is less than five (5) percent. This type of protection is not applicable in paved areas.
- Block and gravel (crushed stone, recycled concrete is also appropriate) protection is used when flows exceed 0.5 c.f.s. and it is necessary to allow for overtopping to prevent flooding.
- Excavated impoundment protection around a drop inlet may be used for protection against sediment entering a storm drain system. With this method, it is necessary to install weep holes to allow the impoundment to drain completely. The impoundment shall be sized such that the volume of excavation shall be equal to 1800 to 3600 cubic feet per acre of disturbed area entering the inlet for full effectiveness.

|  |   |
|--|---|
| <b>Applications</b>  | <b>Targeted Constituents</b>  |
| <ul style="list-style-type: none"> <li>Perimeter Control</li> <li>Slope Protection</li> <li>Sediment Trapping</li> <li>Channel Protection</li> <li>Temporary Stabilization</li> <li>Permanent Stabilization</li> <li>Waste Management</li> <li>Housekeeping Practices</li> </ul> | <ul style="list-style-type: none"> <li>Sediment</li> <li>Nutrients Toxic Materials</li> <li>Oil &amp; Grease</li> <li>Floatable Materials</li> <li>Other Construction Wastes</li> </ul> |
| <b>Implementation Requirements</b>   | <b>Legend</b>   |
| <ul style="list-style-type: none"> <li>Capital Costs</li> <li>Maintenance</li> <li>Training</li> <li>Suitability for Slopes &gt; 5%</li> </ul>   | <ul style="list-style-type: none"> <li>● Significant Impact</li> <li>● Medium Impact</li> <li>○ Low Impact</li> <li>? Unknown or Questionable Impact</li> </ul>                         |
| <b>Varies</b>  | <b>Varies</b>   |
| <b>S-4</b>   | <b>S-4</b>  |

North Central Texas Council of Governments

### Inlet Protection

**DESIGN CRITERIA**

- Special caution must be exercised when installing inlet protection on publicly traveled streets or in developed areas. Ensure that inlet protection is properly designed, installed and maintained to avoid flooding of the roadway or adjacent properties and structures.
- Filter fabric protection shall be designed and maintained in a manner similar to silt fence.
- Where applicable, filter fabric, posts, and wire backing shall meet the material requirements specified in BMP Fact Sheet S-1, Silt Fence.
- Filter gravel shall be 3/4 inch (Block and Gravel Protection) or 1-1/2 to 2 inch (Excavated Impoundment Protection) washed stone containing no fines. Angular shaped stone is preferable to rounded shapes.
- Concrete blocks shall be standard 8" x 8" x 16" concrete masonry units.
- Maximum depth of flow shall be eight (8) inches or less.
- Positive drainage is critical in the design of inlet protection. If overflow is not provided for at the inlet, excess flows shall be routed through established swales, streets, or other watercourses to minimize damage due to flooding.
- Filter Barrier Protection**  
Silt Fence shall consist of nylon geotextile supported by wire mesh, W1.4 X W1.4, and galvanized steel posts set a minimum of 1 foot depth and spaced not more than 6 feet on center. A 6 inch wide trench is to be cut 6 inches deep at the toe of the fence to allow the fabric to be laid below the surface and backfilled with compacted earth or gravel. This entrenchment prevents any bypass of runoff under the fence.
- Block and Gravel Protection (Curb and Drop Inlets)**  
Concrete blocks are to be placed on their sides in a single row around the perimeter of the inlet, with ends abutting. Openings in the blocks should face outward, not upward. 1/2" x 1/2" wire mesh shall then be placed over the outside face of the blocks covering the holes. Filter stone shall then be piled against the wire mesh to the top of the blocks with the base of the stone being a minimum of 18 inches from the blocks. Alternatively, where loose stone is a concern (streets, etc.), the filter stone may be placed in appropriately sized geotextile fabric bags. Periodically, when the stone filter becomes clogged, the stone must be removed and cleaned in a proper manner or replaced with new stone and piled back against the wire mesh.
- Excavated Impoundment Protection**  
An excavated impoundment shall be sized to provide a storage volume of between 1800 and 3600 cubic feet per acre of disturbed area. The trap shall have a minimum depth of one foot and a maximum depth of 2 feet as measured from the top of the inlet and shall have sideslopes of 2:1 or flatter. Weep holes are to be installed in the inlet walls to allow for the complete dewatering of the trap. When the storage capacity of the impoundment has been reduced by one-half, the silt shall be removed and disposed in a proper manner.
- Inlet inserts are commercially available to remove sediment, constituents (pollutants) adsorbed to sediment, and oil and grease. Maintenance is required to remove sediment and debris that could clog the filters. Inlet inserts must have a bypass function to prevent flooding from clogging or high flows.

**LIMITATIONS**  
Special caution must be exercised when installing inlet protection on publicly traveled streets or in developed areas. Ensure that inlet protection is properly designed, installed and maintained to avoid flooding of the roadway or adjacent properties and structures.

Inlet protection is only viable at low point inlets. Inlets that are on a slope cannot be effectively protected because storm water will bypass the inlet and continue downstream, causing an overload condition at inlets downstream.

### Inlet Protection - Curb

### Inlet Protection - Drop Inlet

### Inlet Protection

**MAINTENANCE REQUIREMENTS**  
Inlet protection should be inspected regularly (at least as often as required by the TPDES Construction General Permit, Appendix A). When silt fence is used and the fabric becomes clogged, it should be cleaned or, if necessary, replaced. Also, sediment should be removed when it reaches approximately one-half the height of the inlet protection device. If a sump is used, sediment should be removed when the volume of the basin is reduced by 50%.

For systems using filter stone, when the filter stone becomes clogged with sediment, the stones must be pulled away from the inlet and cleaned or replaced. Since cleaning of stone at a construction site may be difficult, an alternative approach would be to use the clogged stone as fill material and put new stone around the inlet.

**SPECIFICATION**  
Specifications for construction of this item may be found in the Standard Specifications for Public Works Construction - North Central Texas Council of Governments, Section 201.15 Inlet Protection.

### Silt Fence

**DESCRIPTION**  
A silt fence consists of geotextile fabric supported by wire mesh netting or other backing stretched between metal posts with the lower edge of the fabric securely embedded six-inches in the soil. The fence is typically located downstream of disturbed areas to intercept runoff in the form of sheet flow. A silt fence provides both filtration and time for sediment setting by reducing the velocity of the runoff.

**PRIMARY USE**  
Silt fence is normally used as perimeter control located downstream of disturbed areas. It is only feasible for non-concentrated, sheet flow conditions. If it becomes necessary to place a silt fence where concentrated flows may be experienced (e.g. where two silt fences join at an angle, or across minor channels or gullies), it will be necessary to reinforce the silt fence at that area by a rock berm or sand bag berm, or other structural measures that will support the silt fence.

**APPLICATIONS**  
Silt fence is an economical means to treat overland, non-concentrated flows for all types of projects. Silt fences are used as perimeter control devices for both site developers and linear (roadway) type projects. They are most effective with coarse to silty soil types. Due to the potential of clogging and limited effectiveness, silt fences should be used with caution in areas that have predominantly clay soil types. In this latter instance a soils engineer or soil scientist should confirm the suitability of silt fence for that application.

**DESIGN CRITERIA**

- Fences are to be constructed along a line of constant elevation (along a contour line) where possible.
- Maximum drainage area shall be 0.25 acre per 100 linear feet of silt fence.
- Maximum flow to any 20 foot section of silt fence shall be 1 CFS.
- Maximum distance of flow to silt fence shall be 200 feet or less. If the slope exceeds 10 percent the flow distance shall be less than 50 feet.
- Maximum slope adjacent to the fence shall be 2:1.
- If 50% or less soil, by weight, passes the U.S. Standard sieve No. 200, select the apparent opening size (A.O.S.) to retain 85% of the soil.
- If 85% or more of soil by weight, passes the U.S. Standard sieve No. 200, silt fences shall not be used unless the soil mass is evaluated and deemed suitable by a soil scientist or geotechnical engineer concerning the erodibility of the soil mass, dispersive characteristics, and the potential grain-size characteristics of the material that is likely to be eroded.

|  |   |
|--|---|
| <b>Applications</b>  | <b>Targeted Constituents</b>  |
| <ul style="list-style-type: none"> <li>Perimeter Control</li> <li>Slope Protection</li> <li>Sediment Trapping</li> <li>Channel Protection</li> <li>Temporary Stabilization</li> <li>Permanent Stabilization</li> <li>Waste Management</li> <li>Housekeeping Practices</li> </ul> | <ul style="list-style-type: none"> <li>Sediment</li> <li>Nutrients Toxic Materials</li> <li>Oil &amp; Grease</li> <li>Floatable Materials</li> <li>Other Construction Wastes</li> </ul> |
| <b>Implementation Requirements</b>   | <b>Legend</b>   |
| <ul style="list-style-type: none"> <li>Capital Costs</li> <li>Maintenance</li> <li>Training</li> <li>Suitability for Slopes &gt; 5%</li> </ul>   | <ul style="list-style-type: none"> <li>● Significant Impact</li> <li>● Medium Impact</li> <li>○ Low Impact</li> <li>? Unknown or Questionable Impact</li> </ul>                         |
| <b>Fe=0.75</b>   | <b>S-1</b>  |

North Central Texas Council of Governments

### Silt Fence

- Stone overflow structures or other outlet control devices shall be installed at all low points along the fence or spaced at approximately 300 feet if there is no apparent low point.
- Filter stone for overflow structure shall be 1-1/2" washed stone containing no fines. Angular shaped stone is preferable to rounded shapes.
- Silt fence fabric must meet the following minimum criteria:
  - Tensile Strength, ASTM D4632 Test Method for Grab Breaking Load and Elongation of Geotextiles, 90-lbs.
  - Puncture Rating, ASTM D4833 Test Method for Index Puncture Resistance of Geotextiles, Geomembranes, and Related Products, 60-lbs.
  - Mullen Burst Rating, ASTM D3786 Standard Test Method for Hydraulic Bursting Strength of Textile Fabrics-Diaphragm Bursting Strength Tester Method, 280-psi.
  - Apparent Opening Size, ASTM D4751 Test Method for Determining Apparent Opening Size of a Geotextile, U.S. Sieve No. 70 (max) to No. 100 (min)
  - Ultraviolet Resistance, ASTM D4355, Minimum 70 percent.
- Fence posts shall be galvanized steel and may be T-section or L-section, 1.3 pounds per linear foot minimum, and 4 feet in length minimum. ~~Wood posts may be used depending on anticipated longevity and provided they are 4 feet in length minimum and have a minimum cross-section of 2 inches by 2 inches for pipe or 2 inches by 2 inches for horizontal.~~
- Silt fence shall be supported by galvanized steel wire fence fabric as follows:
  - 4" x 4" mesh size, W1.4/1.4, minimum 14-gauge wire fence fabric;
  - Hog wire, 12 gauge wire, small openings installed at bottom of silt fence;
  - Standard 2" x 2" chain link fence fabric; or
  - Other welded or woven steel fabrics consisting of equal or smaller spacing as that listed herein and appropriate gauge wire to provide support.
- A 8-inch wide trench is to be cut 6 inches deep at the toe of the fence to allow the fabric to be laid below the surface and backfilled with compacted earth or gravel to prevent bypass of runoff under the fence. Fabric shall overlap at abutting ends a minimum of 3 feet and shall be joined such that no leakage or bypass occurs.
- Sufficient room for the operation of sediment removal equipment shall be provided between the silt fence and other obstructions in order to properly maintain the fence.
- The ends of the fence shall be turned upstream to prevent bypass of storm water.

**LIMITATIONS**  
Minor ponding will likely occur at the upstream side of the silt fence, which could result in minor localized flooding. Silt fences are not intended for use as check dams in swales or low areas subject to concentrated flow. Silt fences shall not be used where soil conditions prevent a minimum toe-in depth of 6 inches or installation of support posts to a depth of 12 inches.

Silt fence can interfere with construction operations; therefore planning of access routes onto the site is critical. Silt fence can fail structurally under heavy storm flows, creating maintenance problems and reducing the effectiveness of the system.

**MAINTENANCE REQUIREMENTS**  
Silt fence should be inspected regularly (at least as often as required by the TPDES Construction General Permit, Appendix A) for buildup of excess sediment, undercutting, sagging, and other failures. Sediment should be removed when it reaches approximately one-half the height of the fence. In addition, determine the source of excess sediment and implement appropriate BMPs to control the erosion. If the fabric becomes damaged or clogged, it should be repaired or replaced as necessary.


**SPECIFICATION**  
Specifications for construction of this item may be found in the Standard Specifications for Public Works Construction - North Central Texas Council of Governments, Section 201.5 Silt Fence.

### Silt Fence & Stone Overflow Structure

**WIER & ASSOCIATES, INC.**  
**ENGINEERS SURVEYORS LAND PLANNERS**  
 2201 E. LAMAR BLVD., SUITE 200E ARLINGTON, TEXAS 76006 METRO (817)467-7700  
 www.wierassociates.com



**LOT 3, BLOCK B**  
**ROCKWALL TECHNOLOGY PARK PHASE II**  
**COL-MET SPRAY BOOTHS**  
**EROSION CONTROL DETAILS**

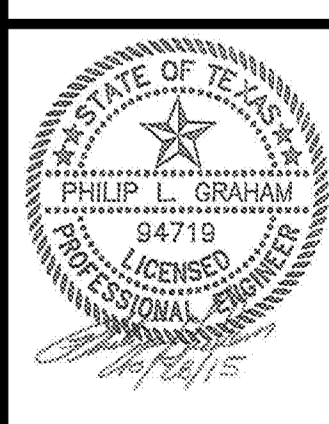

**RECORD PLANS**  
**October 28, 2015**



COPYRIGHT ©  
 WIER & ASSOCIATES, INC.  
 LAST SHEET EDIT  
 DATE 10/28/2015  
 WA# 14029  
**SHEET NO.**  
**C-E202**

PRINTED: 10/28/2015 10:28 AM STB FILE: WIER-EROSION-CONTROL-STB LAST SAVED: 10/28/2015 6:00 AM FILE: PHILIP.GRAPHIC FILE: EROSION-CONTROL-DETAILS-3-14029.DWG

### Triangular Sediment Filter Dike

**Applications**

- Perimeter Control
- Slope Protection
- Sediment Trapping
- Channel Protection
- Temporary Stabilization
- Permanent Stabilization
- Waste Management
- Housekeeping Practices

**Targeted Constituents**

- Sediment
- Nutrients Toxic Materials
- Oil & Grease
- Floatable Materials
- Other Construction Wastes

**Implementation Requirements**

- Capital Costs
- Maintenance
- Training
- Suitability for Slopes > 5%

**Legend**

- Significant Impact
- Medium Impact
- Low Impact
- Unknown or Questionable Impact

**Fe=0.75**

**S-3**

North Central Texas Council of Governments

**DESCRIPTION**  
A Triangular Sediment Filter Dike is a self-contained silt fence consisting of filter fabric wrapped around welded wire fabric shaped into a triangular cross section. While similar in use to a silt fence, the dike is reusable, sturdier, transportable, and can be used on paved areas or in situations where it is impractical to install embedded posts for support.

**PRIMARY USE**  
Triangular filter dikes are used in place of silt fence, treating sediment flow at the perimeter of construction areas and at the perimeter of the site. Also, the dikes can serve as stream protection devices by preventing sediment from entering the streams or as check dams in small swales.

Triangular sediment filter dikes are especially useful for construction areas surrounded by pavement, where silt fence, filter berm, or other BMP installation is impractical.

**APPLICATIONS**  
Triangular dikes are used to provide perimeter control by detaining sediment on a disturbed site with drainage that would otherwise flow onto adjacent properties. Triangular dikes also serve as sediment trapping devices when used in areas of sheet flow across disturbed areas or are placed along stream banks to prevent sediment-laden sheet flow from entering the stream. The dikes can be subjected to more concentrated flows and a higher flow rate than silt fence.

**DESIGN CRITERIA**

- Dikes can be used on a variety of surfaces ranging from disturbed earth to pavement.
- Dikes are to be installed along a line of constant elevation (along a contour line).
- Maximum drainage area shall be 0.25 acre per 100 linear feet of dike.
- Maximum flow to any 20 foot section of dike shall be 1 CFS.
- Maximum distance of flow to dike shall be 200 feet or less. If the slope exceeds 10 percent the flow distance shall be less than 50 feet.
- Maximum slope adjacent to the dike shall be 2:1.

### Triangular Sediment Filter Dike

- If 50% or less of soil, by weight, passes the U.S. Standard sieve No. 200, select the apparent opening size (A.O.S.) to retain 85% of the soil.
- If 85% or more of soil, by weight, passes the U.S. Standard Sieve No. 200, triangular sediment dike shall not be used due to clogging.
- The filter fabric shall meet the material requirements specified in BMP Fact Sheet S-1, Silt Fence.
- The internal support for the dike structure shall be 6 gauge 6" x 6" wire mesh folded into triangular form eighteen (18) inches on each side.
- Filter material shall lap over ends six (6) inches to cover dike-to-dike junction; each junction shall be secured by shoat rings.
- Tie-in to the existing grade should be accomplished by (i) embedding the fabric six-inches below the top of ground on the upslope side, (ii) extending the fabric to form a 12-inch skirt on the upstream slope and covering it with 3 to 5 inches of crushed rock, or (iii) entrenching the base of the triangular dike four-inches below ground. For (ii) above, the skirt and the upslope portion of the triangular dike skeleton should be anchored by metal staples on two-foot centers, driven a minimum of six inches into the ground (except where crossing pavement or exposed limestone).
- Sand bags or large rock should be used as ballast inside the triangular dike section to stabilize the dike against the effects of high flows.
- Sufficient room for the operation of sediment removal equipment shall be provided between the dike and other obstructions in order to properly remove sediment.
- The ends of the dike shall be turned up grade to prevent bypass of storm water.

**LIMITATIONS**  
Effects of ponding caused by the dikes should be evaluated for effects on adjacent areas. Triangular sediment filter dikes are not effective for conditions where there are substantial concentrated flows or when they are not constructed along a contour line due to the potential for flow concentration and overtopping.

**MAINTENANCE REQUIREMENTS**  
Triangular sediment filter dikes should be inspected regularly (at least as often as required by the TPDES Construction General Permit, Appendix A). Sediment should be removed when it reaches approximately 6 inches in depth. If the fabric becomes clogged, it should be cleaned or, if necessary, replaced. If structural deficiencies are found, the dike should be immediately repaired or replaced.

As with silt fence, integrity of the filter fabric is important to the effectiveness of the dike. Overlap between dike sections must be checked on a regular basis and repaired if deficient.

**SPECIFICATION**  
Specifications for construction of this item may be found in the Standard Specifications for Public Works Construction – North Central Texas Council of Governments, Section 201.8 Triangular Sediment Filter Dike.

### Triangular Sediment Filter Dike

**Cross Section Of Installation Options**

- Toe-in 6" Min.
- Fabric Skirt Weighted With Rock
- Trenched In 4"

6'x6' Welded Wire Mesh Structure  
Geotextile Fabric  
Fabric Skirt (Option 2)  
6'x1'x6' Anchors Every Two Feet (Option 2)

### Vegetation

**Applications**

- Perimeter Control
- Slope Protection
- Sediment Trapping
- Channel Protection
- Temporary Stabilization
- Permanent Stabilization
- Waste Management
- Housekeeping Practices

**Targeted Constituents**

- Sediment
- Nutrients Toxic Materials
- Oil & Grease
- Floatable Materials
- Other Construction Wastes

**Implementation Requirements**

- Capital Costs
- Maintenance
- Training
- Suitability for Slopes > 5%

**Legend**

- Significant Impact
- Medium Impact
- Low Impact
- Unknown or Questionable Impact

**Fe=0.90**

**E-4**

North Central Texas Council of Governments

**DESCRIPTION**  
Vegetation, as a Best Management Practice, is the sowing or sodding of annual grasses, small grains, or legumes to provide interim and permanent vegetative stabilization for disturbed areas.

**PRIMARY USE**  
Vegetation is used as a temporary or permanent stabilization technique for areas disturbed by construction. As a temporary control, vegetation is used to stabilize stockpiles and barren areas that are inactive for long periods of time. As a permanent control, grasses and other vegetation provide good protection from erosion along with some filtering for overland runoff. Subjected to acceptable runoff velocities, vegetation can provide a positive method of permanent storm water management as well as a visual amenity to the site.

Other BMPs may be required to assist during the establishment of vegetation. These other techniques include erosion control matting, swales, and dikes to direct flow around newly seeded areas and proper grading to limit runoff velocities during construction.

**APPLICATIONS**  
Vegetation effectively reduces erosion in swales, stockpiles, berms, mild to medium slopes, and along roadways. Vegetative strips can provide some protection when used as a perimeter control for utility and site development construction.

In many cases, the initial cost of temporary seeding may be high compared to tarps or covers for stockpiles or other barren areas subject to erosion. This initial cost should be weighed with the amount of time the area is to remain inactive, since maintenance cost for vegetated areas is much less than most structural controls.

**DESIGN CRITERIA**

*Surface Preparation*

- Interim or final grading must be completed prior to seeding or sodding.
- Install all necessary erosion structures such as dikes, swales, diversions, etc. prior to seeding or sodding.
- When establishing vegetation from seed, groove or furrow slopes steeper than 3:1 on the contour line before seeding.

### Vegetation

- Provide 4-6 inches of topsoil over rock, gravel or otherwise unsuitable soils. Poor quality topsoil should be amended with compost before applying seed or sod. Amendment should be three parts of topsoil to one part compost by volume thoroughly blended.
- Seed bed should be well pulverized, loose and uniform.

*Plant Selection, Fertilization and Seeding*

- Use only high quality, USDA certified seed.
- Use an appropriate species or species mixture adapted to local climate, soil conditions and season as shown below, or consult with the local office of the Natural Resource Conservation Service (NRCS) or Engineering Extension service as necessary for selection of proper species and application technique in this area.
- Seeding rate should be in accordance with the table below or as recommended by the NRCS or Engineering Extension service.
- Fertilizer shall be applied according to the manufacturer's recommendation with proper spreader equipment. Typical application rate for 10-10-10 grade fertilizer is 10 lbs. per 1,000 ft<sup>2</sup>.
- If hydro-seeding is used, do not mix seed and fertilizer more than 30 minutes before application.
- Evenly apply seed using cyclone seeder, seed drill, cultipacker, terraseeding, or hydroseeder.
- Provide adequate water to aid in establishment of vegetation.
- Use appropriate mulching techniques where necessary, especially during cold periods of the year.

*Sodding*

- Sod shall be St. Augustine grass, common bermudagrass, buffalograss, an approved hybrid of common Bermudagrass or an approved zoysiagrass.
- The sod should be mowed prior to sod cutting so that the height of the grass shall not exceed 2-inches and should not be harvested or planted when its moisture condition is so excessively wet or dry that its survival shall be affected.
- Sod shall be planted within 3-days after it is excavated.
- In areas subject to direct sunlight, pre-moisten prepared sod bed by watering immediately prior to placing sod.
- Sodded areas shall be thoroughly watered immediately after they are planted.

**ADDITIONAL GUIDANCE**

- Establishing a good vegetative cover is dependent of the season of the year. Projects that commence in the fall of the year may not be candidates for vegetation used as a BMP.
- Where vegetation is used in swales and channels it may be necessary to use sod, rather than seeding, to establish an erosion resistant surface to accommodate rainfall runoff flows.
- Where vegetation is used for perimeter control, the use of sod is necessary for a fifteen-foot width.
- Mulch should be used to enhance vegetative growth, in that mulch protects seeds from heat, prevents soil moisture loss, and provides erosion protection until the vegetation is established.
- Fertilizers have both beneficial and adverse effects. Fertilizers provide nutrients to the vegetation, but also fertilizers are a source of nutrients to streams and lakes. In this latter regard they are a pollutant. The use of native vegetation rather than exotics reduces the need of fertilizer. Organic fertilizers are generally preferred over chemical fertilizers from the standpoint of environmental conditions.
- Steep slopes represent a problem for establishing vegetation. Bonded Fiber Matrix or Mechanically Bonded Fiber Matrix products applied with a tackifier are useful for establishing vegetation on slopes.

**TEMPORARY VEGETATION**  
The table on the following page lists recommended plant species for the North Central Texas region depending on the season for planting.

### Vegetation

**RECOMMENDED GRASS MIXTURE FOR TEMPORARY EROSION CONTROL:**

| SEASON          | COMMON NAME         | RATE (LBS/ACRE) |
|-----------------|---------------------|-----------------|
| Aug 15 - Nov 30 | Tall Fescue         | 4.0             |
|                 | Western Wheat Grass | 5.0             |
|                 | Wheat (Red, Winter) | 30.0            |
| May 1 - Aug 31  | Foxtail Millet      | 30.0            |
| Feb 15 - May 31 | Annual Rye          | 20.0            |
| Sep 1 - Dec 31  |                     |                 |

**PERMANENT VEGETATION**  
Grass seed for permanent vegetation can be sown at the same time as seeding for temporary (annual) vegetation. Drought tolerant native vegetation is recommended rather than exotics as a long-term water conservation measure. Native grasses can be planted as seed or placed as sod. Buffalo 609, for example, is a hybrid grass that is placed as sod. Fertilizers are not normally used to establish native grasses, but mulching is effective in retaining soil moisture for the native plants.

**RECOMMENDED NATIVE GRASSES FOR PERMANENT EROSION CONTROL**


| GRASS           |                                | RATE              |
|-----------------|--------------------------------|-------------------|
| Buffalo Grass   | Full Turf Application          | 3-4 lbs/1000 sqft |
| Blue Grama      | Full Turf Application          | 2 lbs/1000 sqft   |
| Side Oats Grama | Applied with other native seed | 1/4 lb/1000 sqft  |

**LIMITATIONS**  
Vegetation is not appropriate for areas subjected to heavy pedestrian or vehicular traffic. As a temporary technique, vegetation may be costly when compared to other techniques. Vegetation may require a period of days to weeks before becoming established. Lack of water and lack of or improper use of soil amendments (compost, fertilizer, etc.) will usually result in poor turf establishment. Alternate erosion control (e.g. mulching, sodding vegetative strips, etc.) should be used until vegetation can be established.



Vegetation is not appropriate for rock, gravel or coarse-grained soils unless 4 to 6 inches of topsoil is applied.

**MAINTENANCE REQUIREMENTS**  
Protect newly seeded areas from excessive runoff and traffic until vegetation is established. A watering and fertilizing schedule will be required as part of the SWPPP to assist in the establishment of the vegetation. Vegetation should be inspected regularly (at least as often as required by the TPDES Construction General Permit, Appendix A) to ensure that the plant material is established properly and remains healthy. Bare spots shall be reseeded and/or protected from erosion by mulch or other BMP. Accumulated sediment deposited by runoff should be removed to prevent smothering of the vegetation. In addition, determine the source of excess sediment and implement appropriate BMPs to control the erosion.

PREPARED BY:  
**WIER & ASSOCIATES, INC.**  
**ENGINEERS SURVEYORS LAND PLANNERS**  
 2201 E. LAMAR BLVD., SUITE 200E ARLINGTON, TEXAS 76006 METRO (817)467-7700  
 www.wierassociates.com

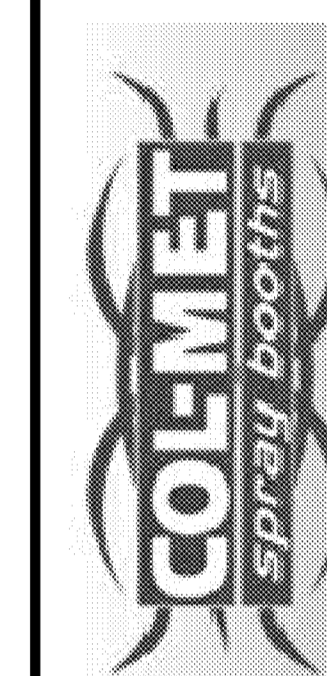

**LOT 3, BLOCK B**  
**ROCKWALL TECHNOLOGY PARK PHASE II**  
**COL-MET SPRAY BOOTHS**  
**EROSION CONTROL DETAILS**

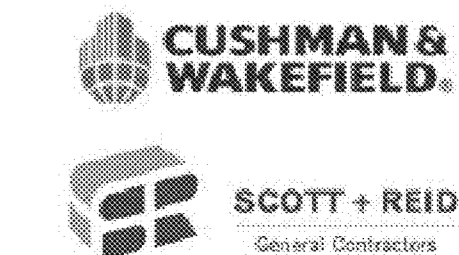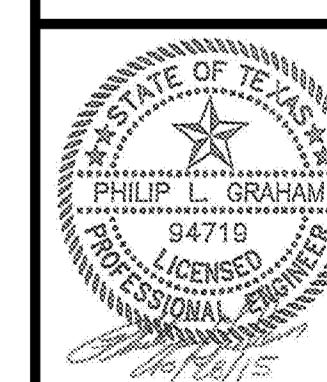

**RECORD PLANS**  
**October 28, 2015**

COPYRIGHT ©  
 WIER & ASSOCIATES, INC.  
 LAST SHEET EDIT  
 DATE 10/28/2015  
 WA# 14029  
**SHEET NO.**  
**C-E203**