
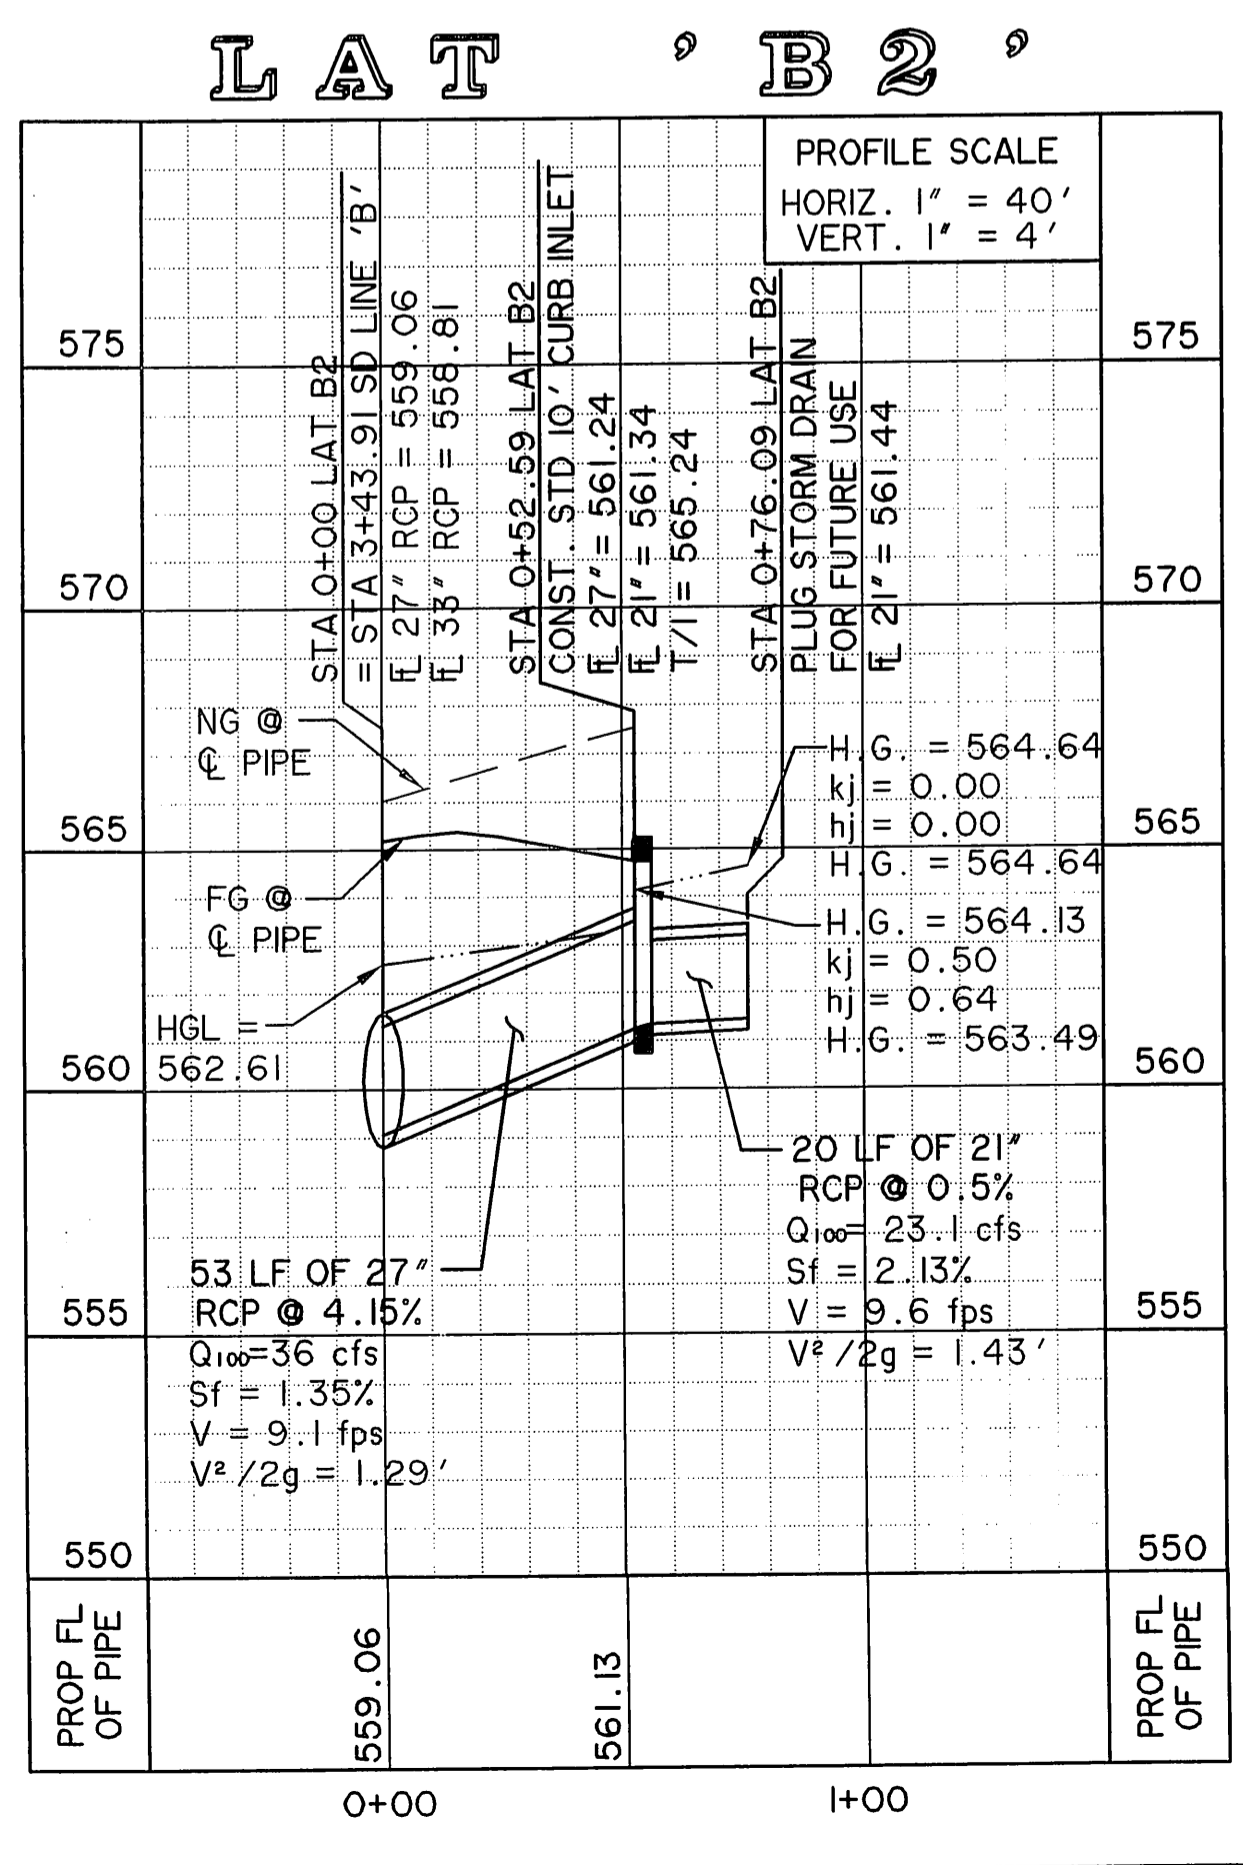
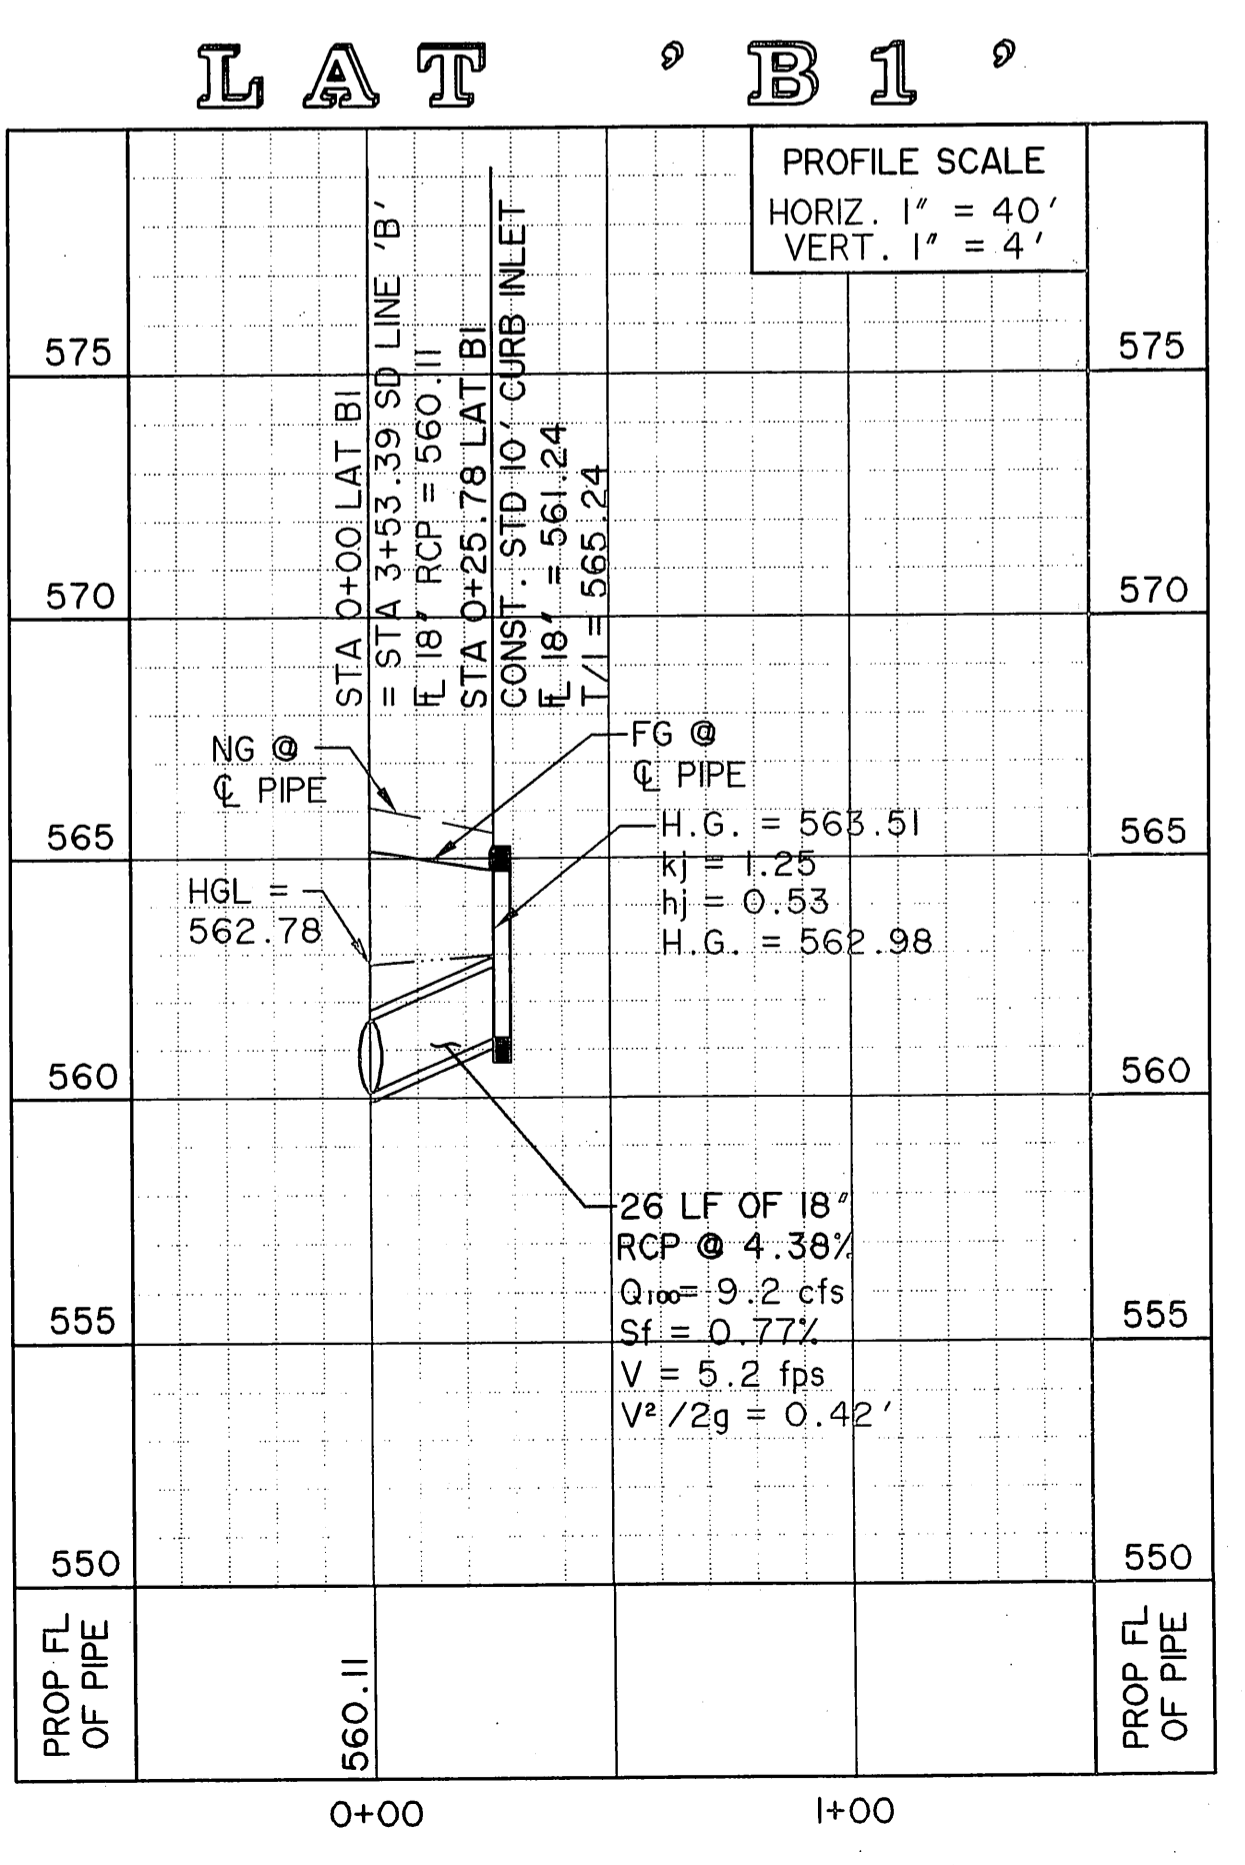
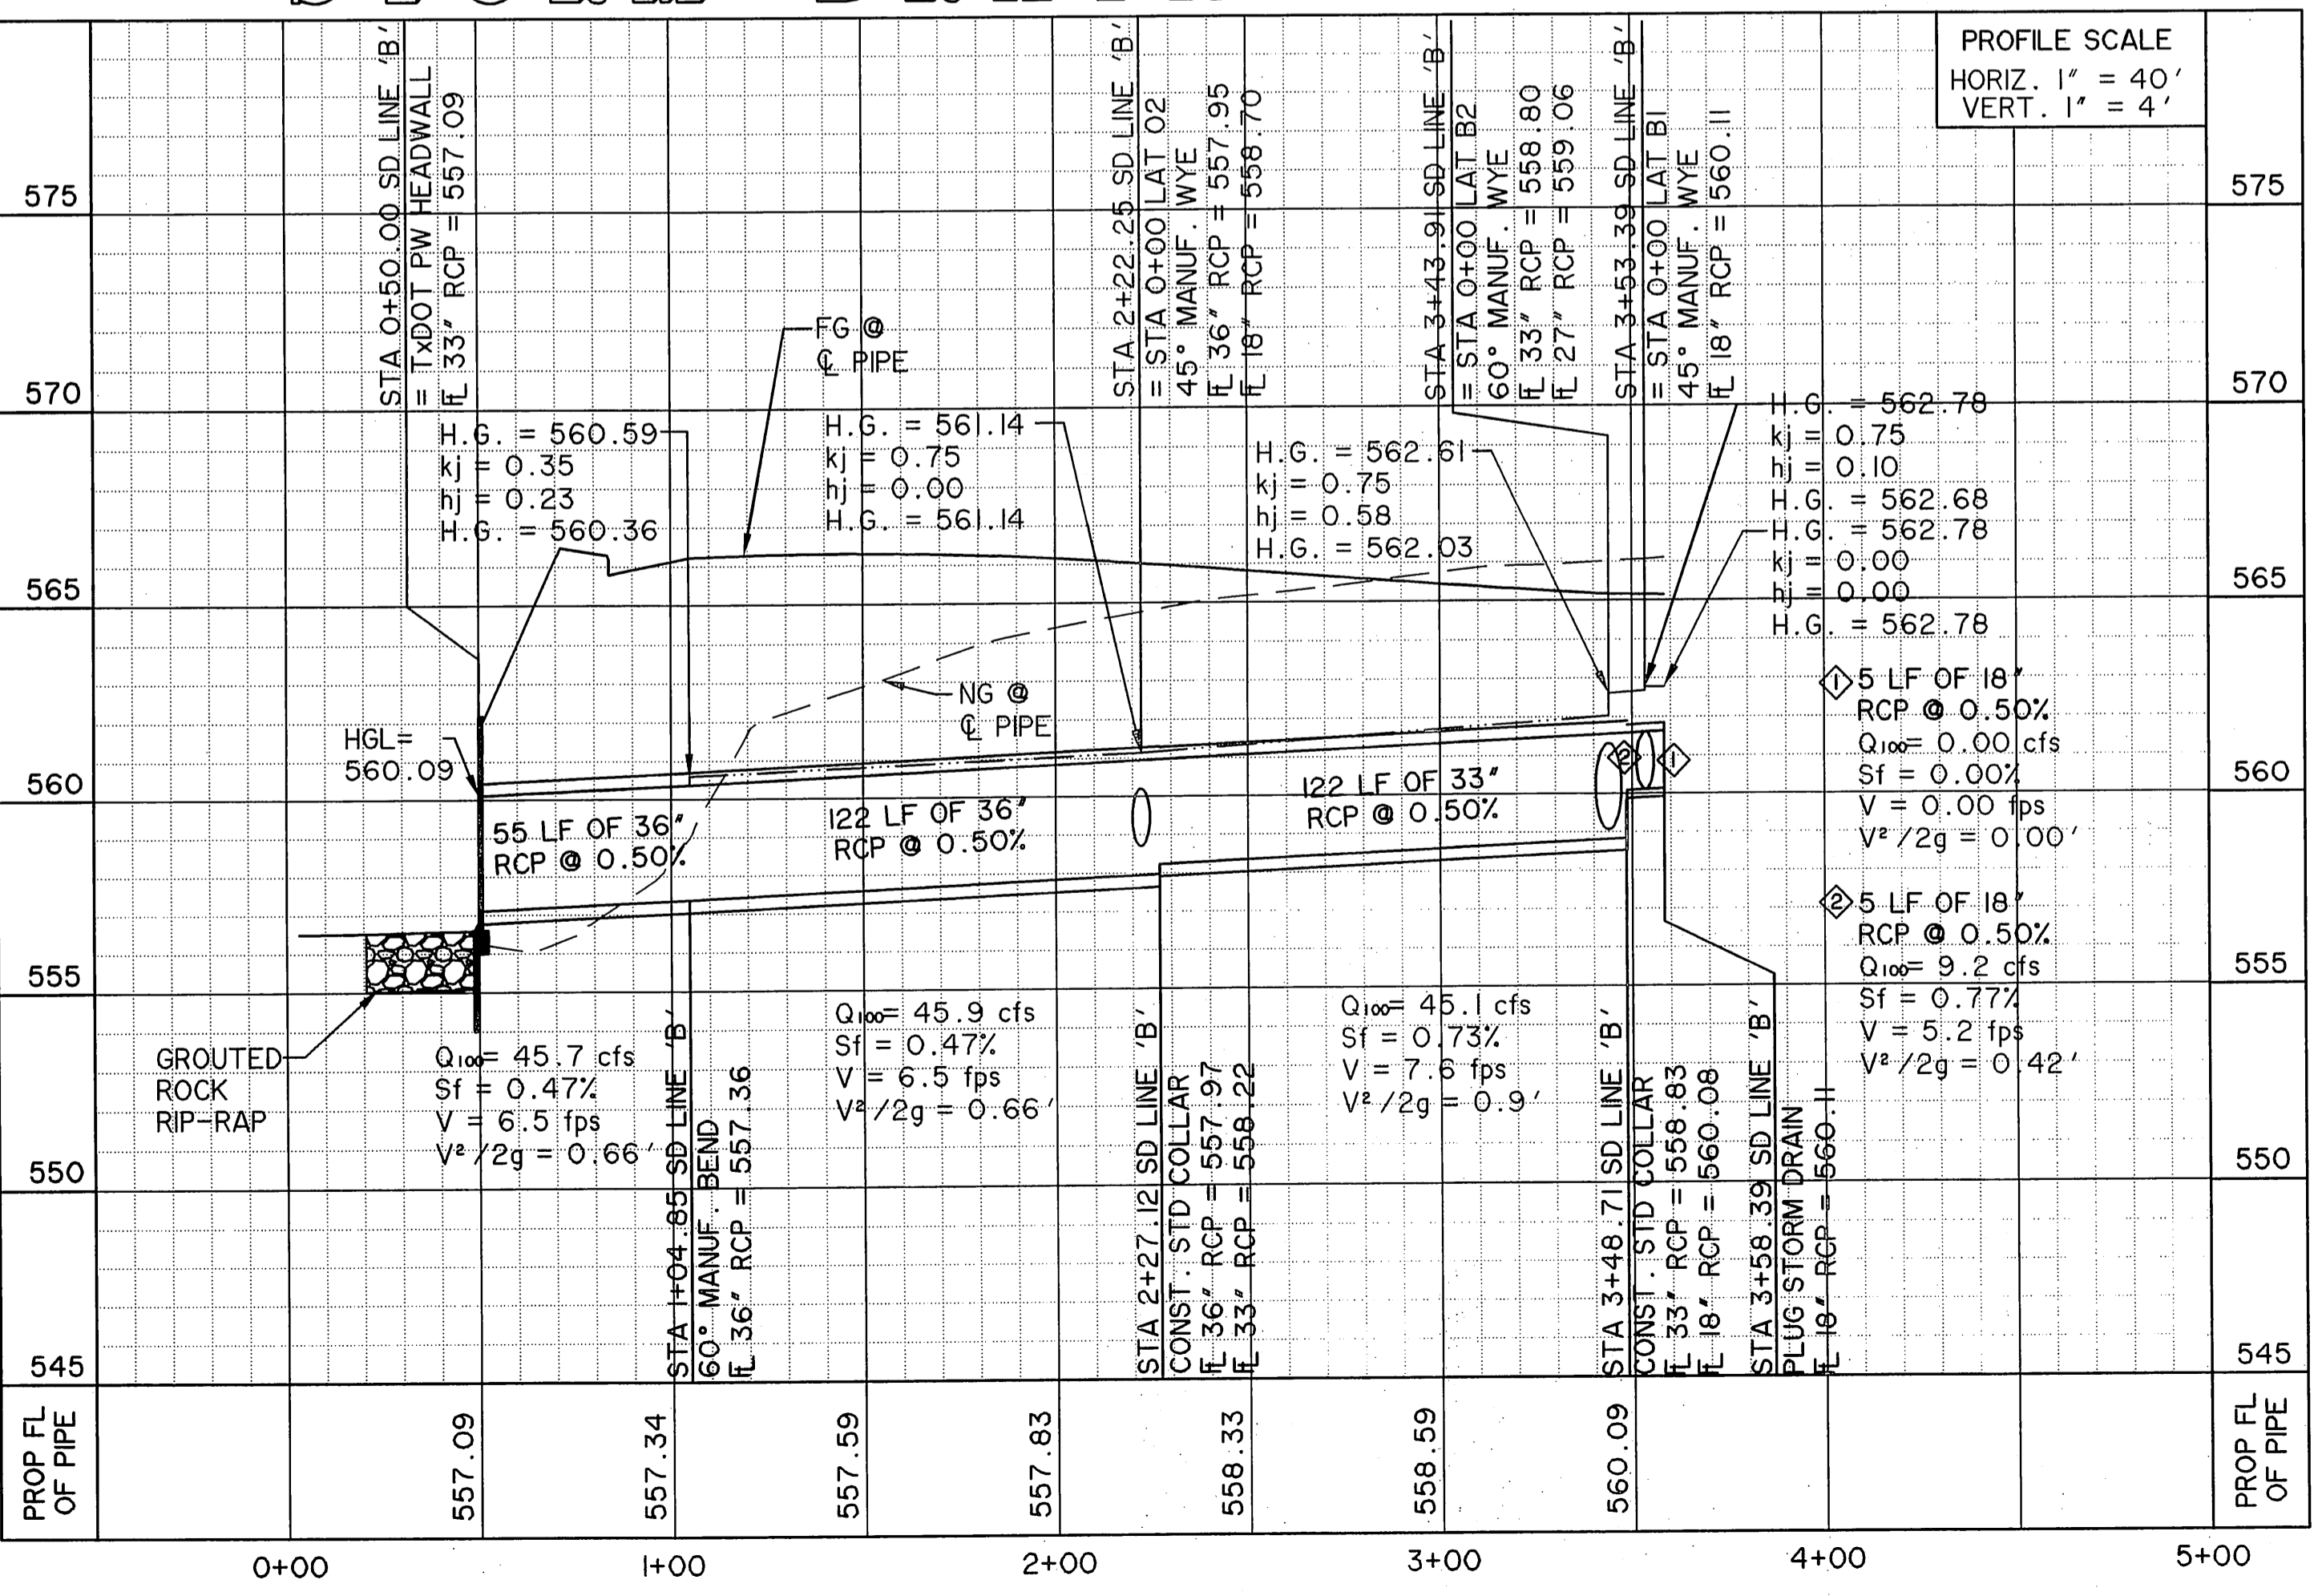


TIME 12.12 FILE: D302-SD-LN-B\_98041.10.dwg

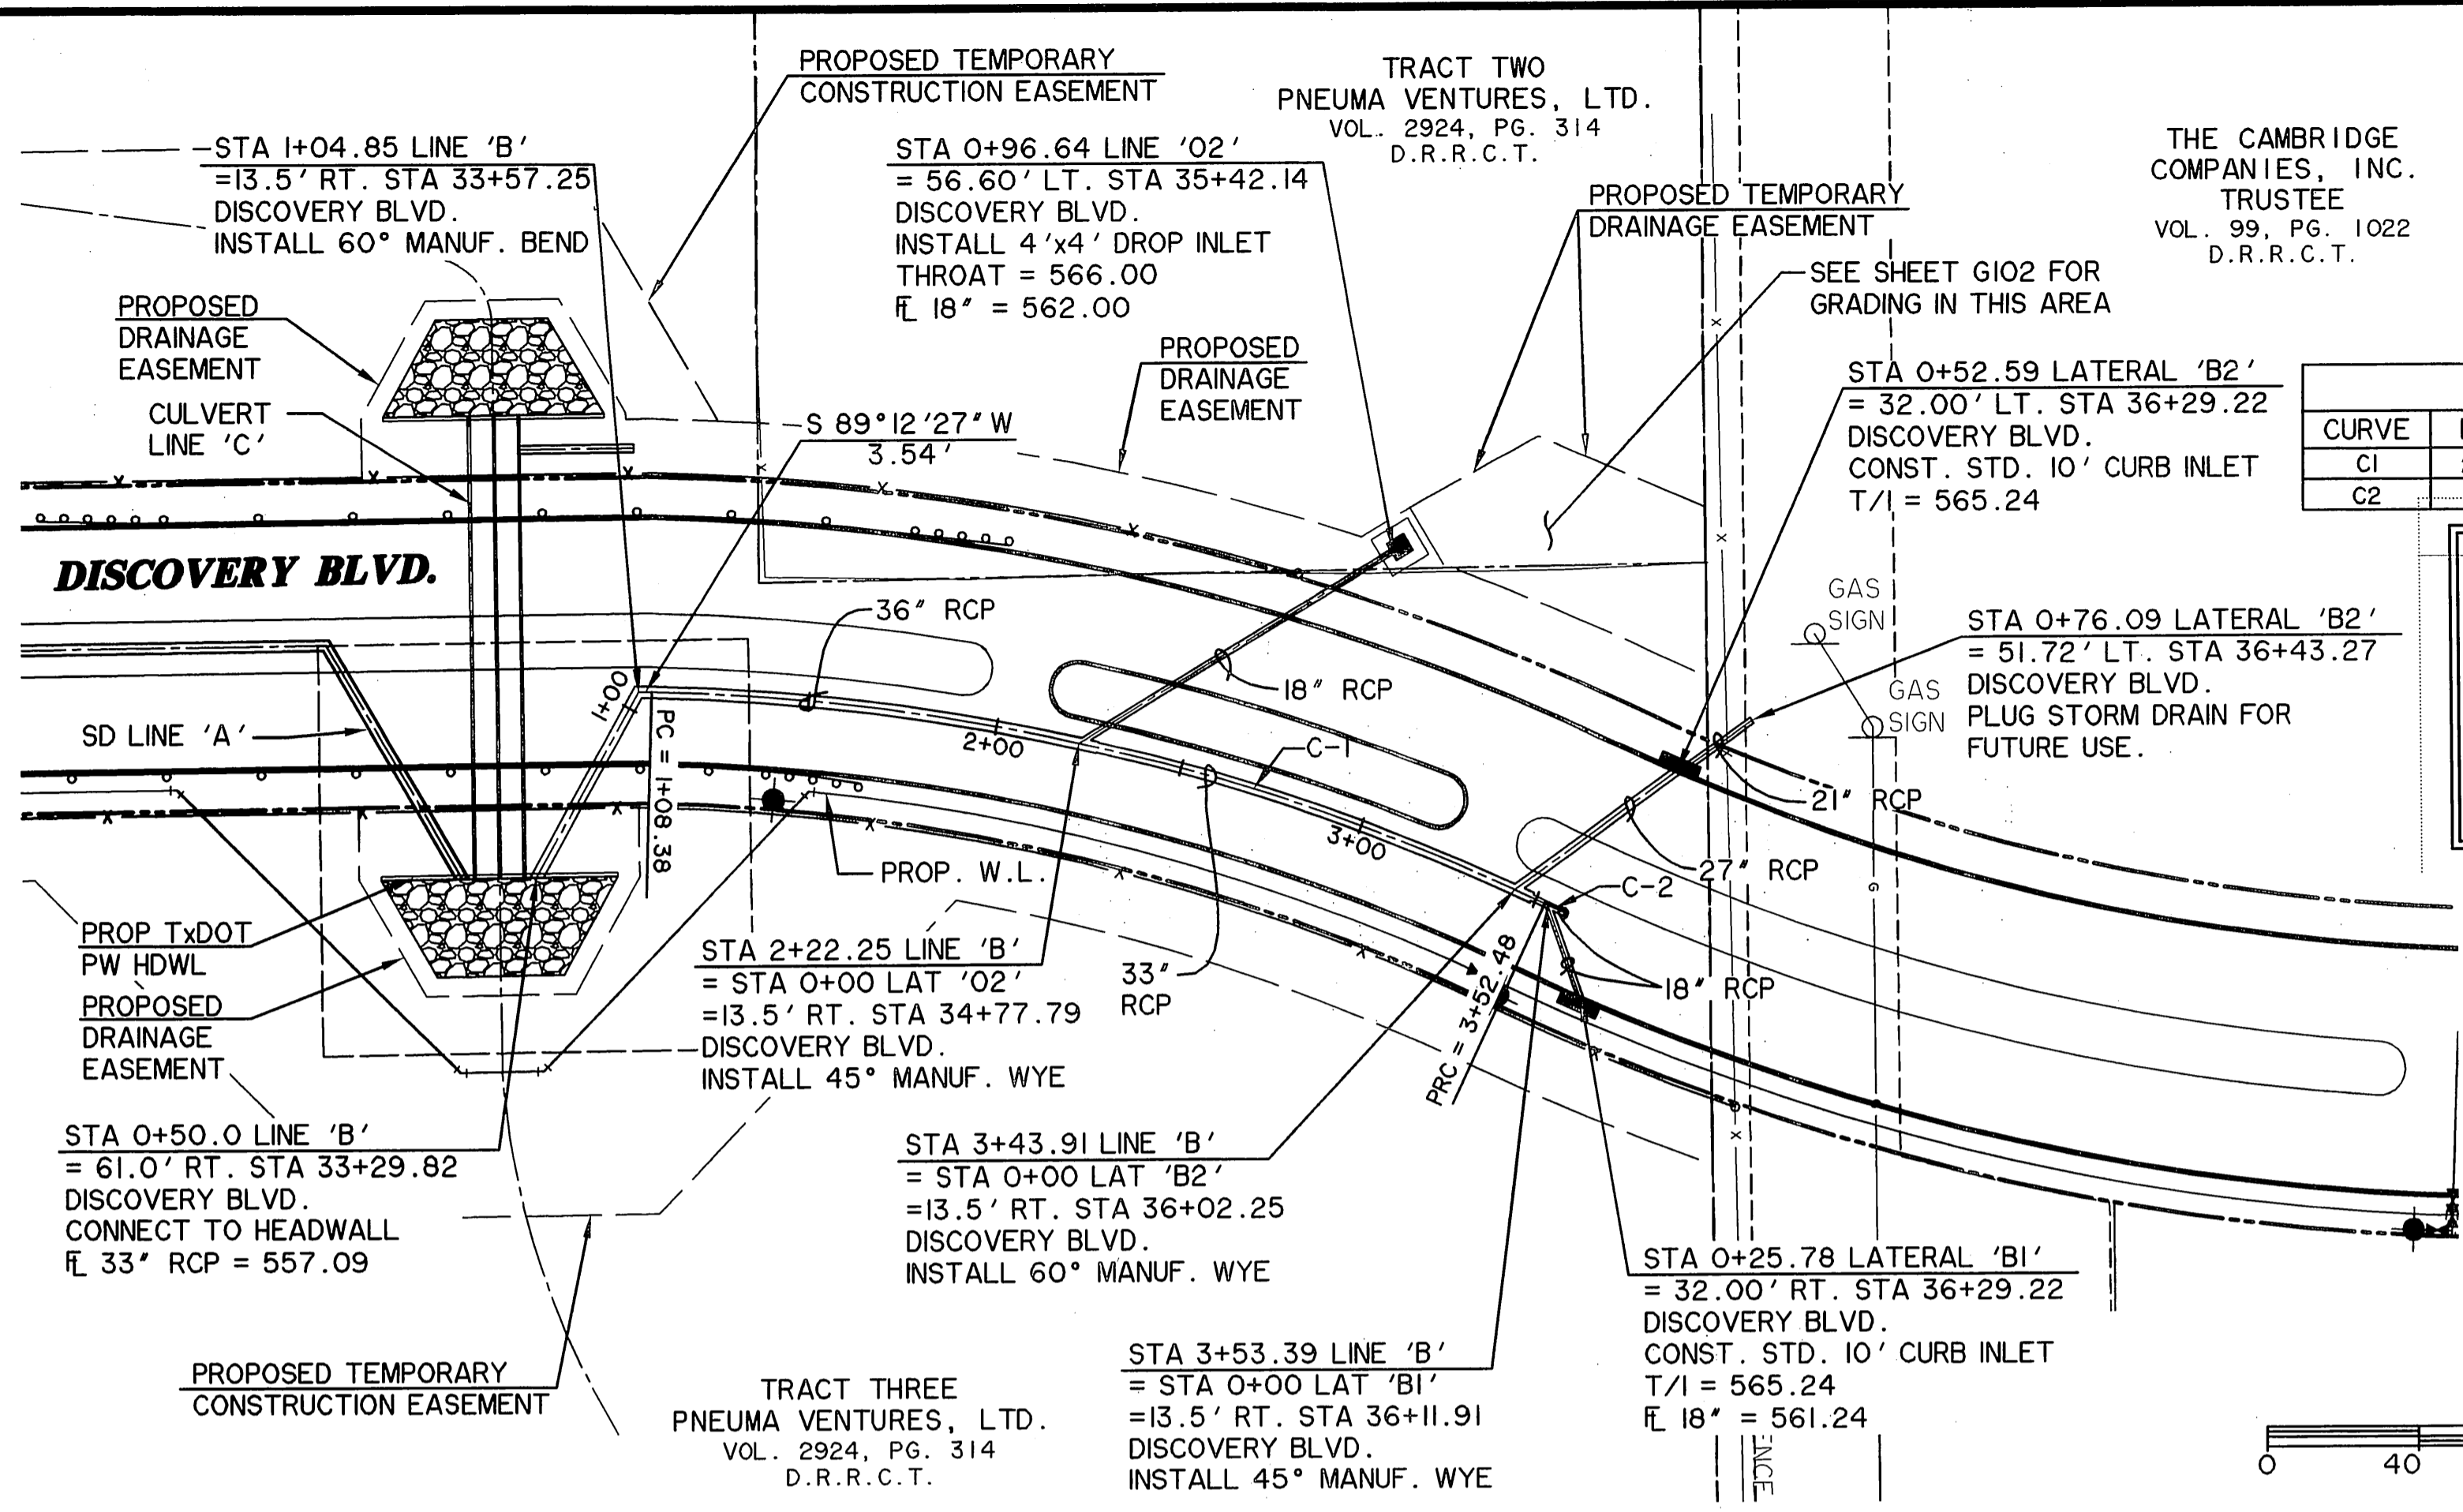

PREPARED BY:  
**WIER & ASSOCIATES, INC.**  
ENGINEERS SURVEYORS LAND PLANNERS  
701 HIGHLANDER BLVD., SUITE 300 ARLINGTON, TEXAS 76015 METRO (817)467-7700  
6849 ELM STREET FRISCO, TEXAS 75004 METRO (214)367-8000  
www.WierAssociates.com  
Texas Firm Registration No. F-2776

**DISCOVERY BLVD. EXTENSION TO JOHN KING BLVD.**

**STORM DRAIN PLAN AND PROFILE LINE 'B'**

STATE OF TEXAS  
RONALD RAMIREZ  
REGISTERED PROFESSIONAL ENGINEER  
81821  
Copyright © WIER & ASSOCIATES, INC.  
LAST SHEET EDIT DATE 07-24-2009  
WA# 98041.10  
SHEET NO. D302