


CONSTRUCTION PLANS FOR EZ-FLO WAREHOUSE LOT 4, BLOCK A ROCKWALL TECHNOLOGY PARK

*J.M. ALLEN SURVEY, ABSTRACT No. 2,
CITY OF ROCKWALL, ROCKWALL COUNTY, TEXAS*

FOR
ALLIANCE ARCHITECTS
1600 NORTH COLLINS BLVD., SUITE 1000
RICHARDSON, TEXAS 75080
(972)233-0400

PREPARED BY

 **Pacheco Koch Consulting Engineers**
8350 N CENTRAL EXPWY SUITE 1000 DALLAS, TEXAS 75206 972.235.3031

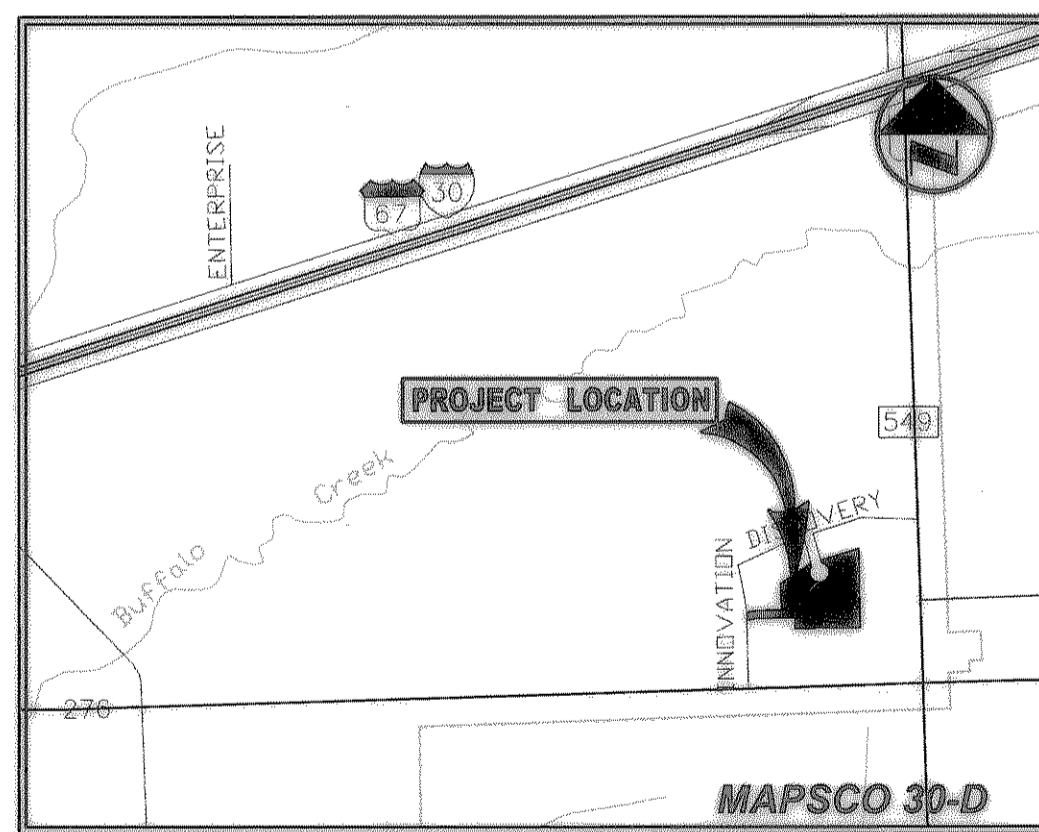

VICINITY MAP

DRAWING SHEET INDEX

| SHEET | DESCRIPTION |
|-------|--------------------------------|
| - | REPLAT |
| C1.1 | DIMENSIONAL CONTROL PLAN |
| C3.1 | EXISTING DRAINAGE AREA MAP |
| C3.2 | STORM SEWER PLAN |
| C3.3 | STORM SEWER PROFILES |
| C3.4 | DETENTION POND PLAN |
| C4.1 | WATER & SANITARY SEWER PLAN |
| C5.1 | PAVING PLAN & DETAILS |
| C6.1 | EROSION CONTROL PLAN & DETAILS |

RECORD DRAWING

THIS DRAWING HAS BEEN REVISED TO REFLECT CONSTRUCTION RECORDS MAINTAINED AND PROVIDED BY THE CONTRACTOR FOR THIS PROJECT.

CONTRACTOR: PRECEPT BUILDERS
DATE REVISED: 10/31/2003



THE SEAL APPEARING ON THIS DOCUMENT WAS AUTHORIZED BY STEVEN A. MARKUSSEN, P.E. 70090 ON 12/20/02 - ALTERATION OF A SEALED DOCUMENT WITHOUT PROPER NOTIFICATION TO THE RESPONSIBLE ENGINEER IS AN OFFENSE UNDER THE TEXAS ENGINEERING PRACTICE ACT.