

CITY OF ROCKWALL, TEXAS

CONSTRUCTION PLANS

FOR

PAVING, DRAINAGE, WATER, & SEWER IMPROVEMENTS

TO SERVE

EMPHYSIS

KEN JONES - MAYOR

COUNCIL MEMBERS:

TIM McCALLUM - Mayor Pro Tem

BOB COTTI


STEPHEN STRAUGHAN

JOHN KING

TERRY RAULSTON

BILL CECIL


JULIE COUCH - City Manager

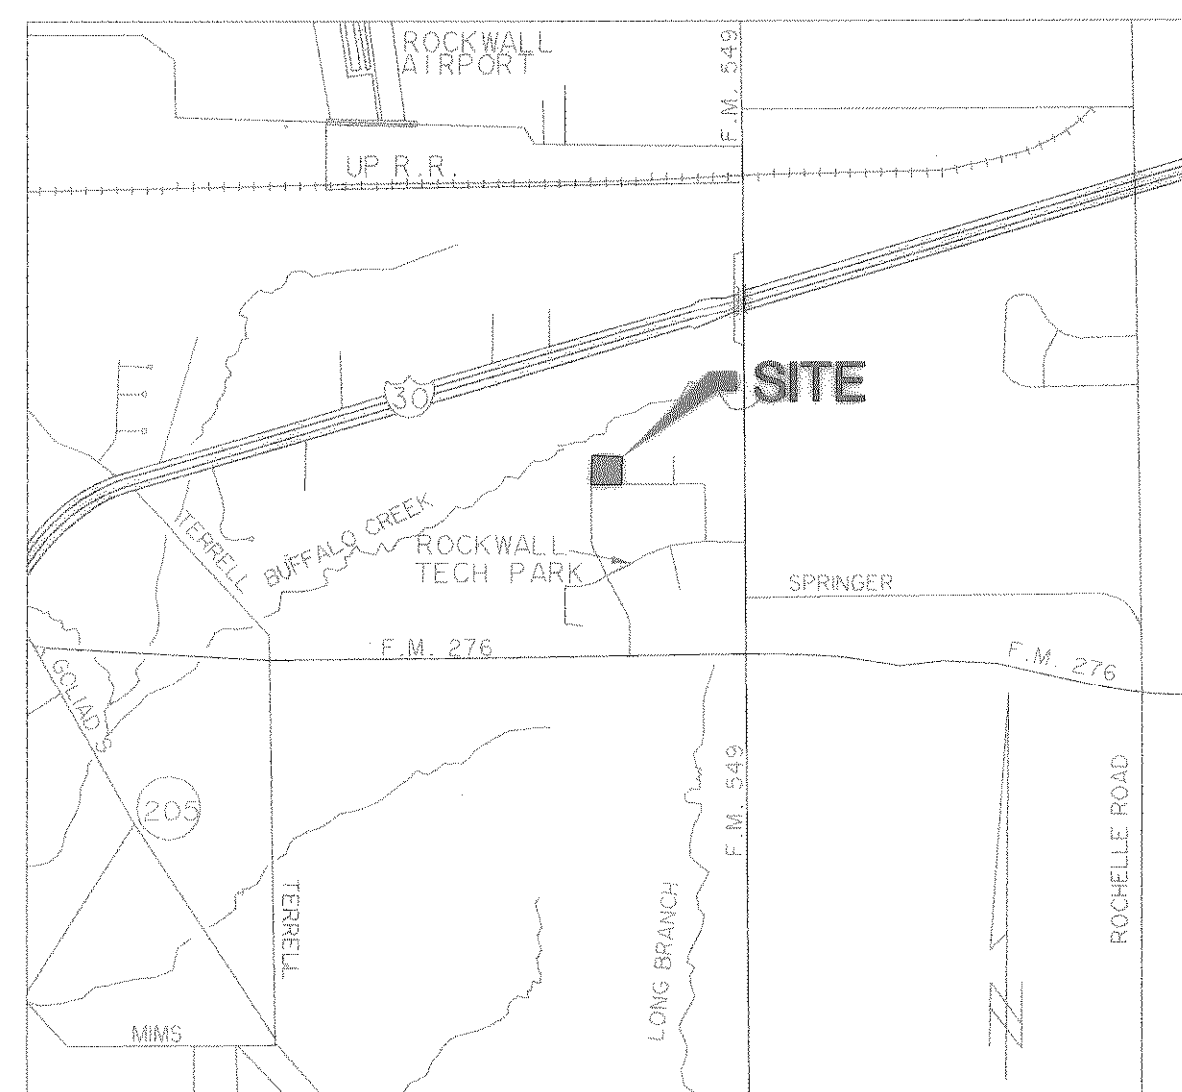


VICINITY MAP
N.T.S.

INDEX OF DRAWINGS

- COVER SHEET
 - AMENDED REPLAT (1 OF 2)
 - AMENDED REPLAT (2 OF 2)
 - GENERAL NOTES
 - A100 PAVING & DIMENSIONAL CONTROL PLAN
 - P301 PRIVATE ON-SITE PAVING DETAILS
 - P302 PRIVATE ON-SITE HANDICAP DETAILS
 - P303 PRIVATE ON-SITE SIDEWALK DETAILS
 - G101 GRADING & STORM DRAIN PLAN
 - D101 DRAINAGE AREA MAP
 - U101 WATER & SANITARY SEWER PLAN
 - E001 EROSION CONTROL\SWP3 (STORM WATER POLLUTION PREVENTION PLAN) NOTES (1 OF 3)
 - E002 EROSION CONTROL\SWP3 NOTES (2 OF 3)
 - E003 EROSION CONTROL\SWP3 NOTES (3 OF 3)
 - E101 EROSION CONTROL\SWP3 PLAN
 - E201 EROSION CONTROL\SWP3 DETAILS
- REFERENCE
- 17 DRAINAGE AREA MAP - ROCKWALL TECHNOLOGY PARK
 - 24-B POND & DETENTION ANALYSIS - ROCKWALL TECHNOLOGY PARK

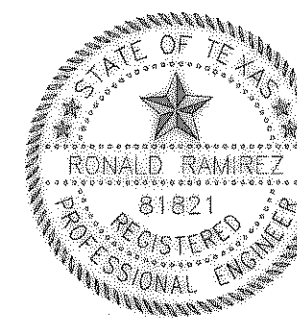

Ron Ramirez
11/3/06

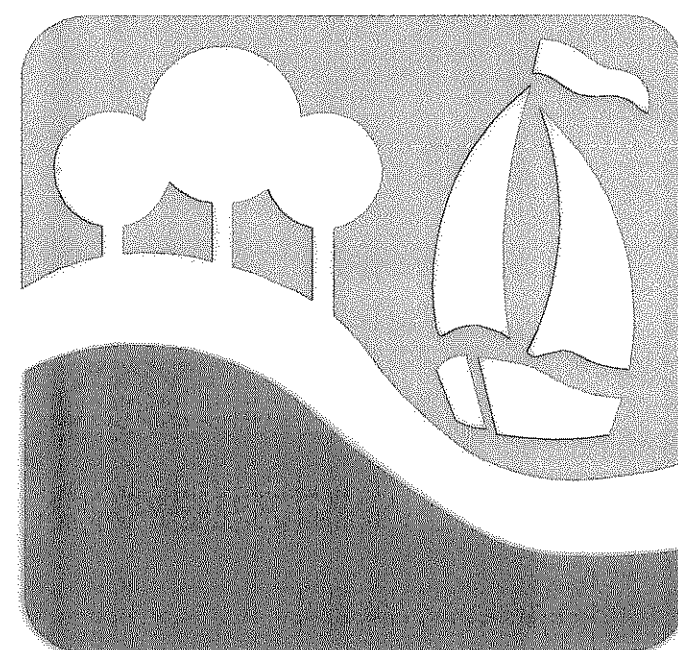

"THE NEW HORIZON"

MARCH 2005

RECORD DRAWING
12/21/05

Emphasis