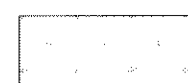
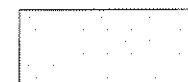



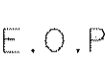



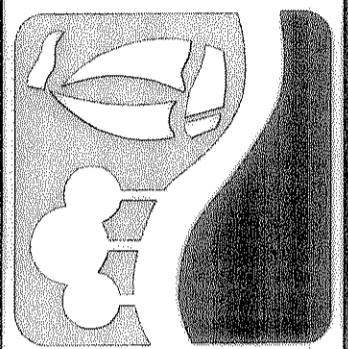
CAUTION !!!
UNDERGROUND UTILITIES

EXISTING UTILITIES AND UNDERGROUND FACILITIES INDICATED ON THESE PLANS HAVE BEEN LOCATED FROM REFERENCE INFORMATION SUPPLIED BY VARIOUS OWNERS OF THE FACILITIES. THE ENGINEER DOES NOT ACCEPT THE RESPONSIBILITY FOR THE UTILITY LOCATIONS SHOWN. IT SHALL BE THE RESPONSIBILITY OF THE CONTRACTOR TO VERIFY BOTH HORIZONTALLY AND VERTICALLY THE LOCATION OF ALL EXISTING UTILITIES AND UNDERGROUND FACILITIES PRIOR TO CONSTRUCTION, TO TAKE NECESSARY PRECAUTIONS IN ORDER TO PROTECT ALL FACILITIES ENCOUNTERED, AND TO NOTIFY THE ENGINEER PROMPTLY OF ALL CONFLICTS OF THE WORK WITH EXISTING FACILITIES. THE CONTRACTOR SHALL PRESERVE AND PROTECT ALL EXISTING UTILITIES FROM DAMAGE DURING CONSTRUCTION. ANY DAMAGE BY THE CONTRACTOR TO EXISTING UTILITIES SHALL BE REPAIRED BY THE CONTRACTOR AT HIS EXPENSE.

LEGEND

-  PROPOSED LANDSCAPE SEEDING AREAS
-  4" - 3000 PSI CONC. W/ #3 BARS 24" O.C.E.W.
-  5" - 3600 PSI CONC. (LIGHT DUTY)
-  6" - 3600 PSI CONC. (HEAVY DUTY)
-  (11) PARKING STALL COUNT
-  E.O.P. EDGE OF PAVEMENT
-  IRRIGATION SLEEVE


PREPARED BY:
VIA WIER & ASSOCIATES, INC.
ENGINEERS SURVEYORS LAND PLANNERS
4300 BELLMAN PLACE SUITE 130 ARLINGTON, TEXAS 76018 METRO (817)467-7700
1380 U.S. HIGHWAY 287 N. SUITE 101 WANSFELD, TEXAS 76663 METRO (817)477-8700
6849 ELM STREET FRESCO, TEXAS 75034 METRO (214)387-8000
www.viawier.com




CITY OF
ROCKWALL
EMPHYSIS

PAVING &
DIMENSIONAL CONTROL
PLAN

STATE OF TEXAS
RODOLFO RAMIREZ
REGISTERED PROFESSIONAL ENGINEER
8182
COPYRIGHT
WIER & ASSOCIATES, INC.
LAST SHEET EDIT
DATE 12-21-2005
WA# 98041.02
SHEET NO.
P101

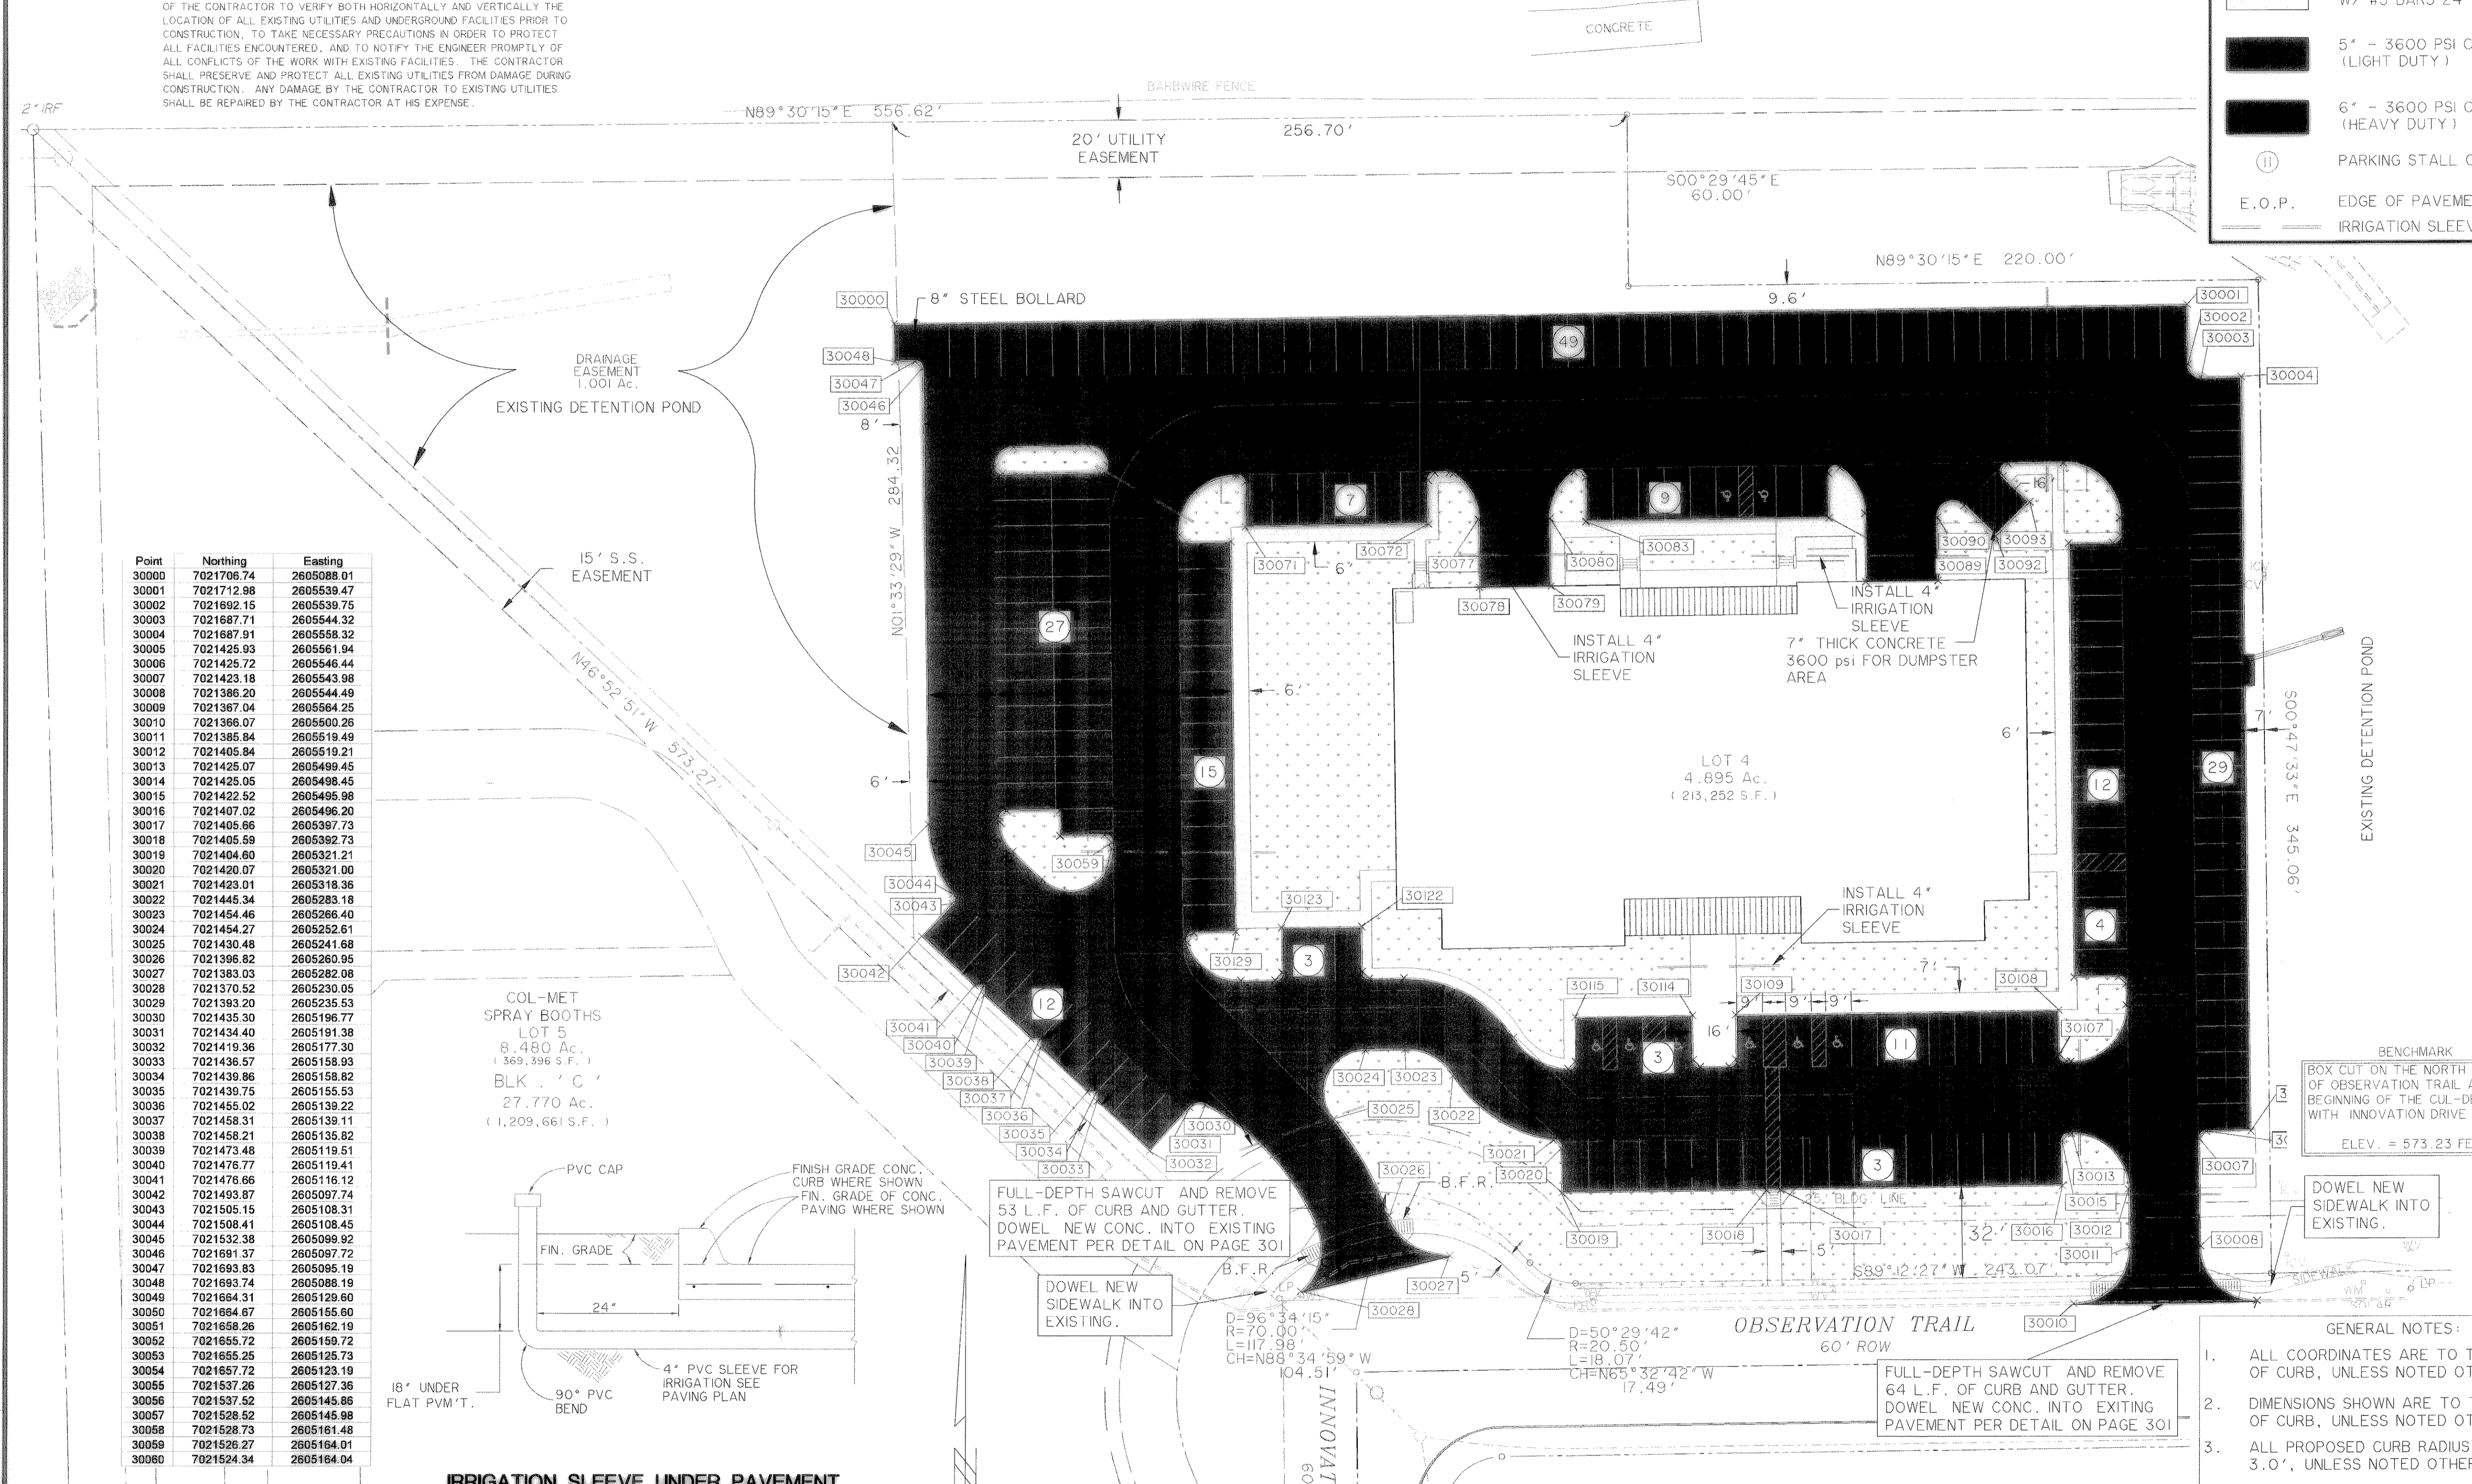

Point	Northing	Easting
30000	7021706.74	2605088.01
30001	7021712.98	2605539.47
30002	7021692.15	2605539.75
30003	7021687.71	2605544.32
30004	7021687.71	2605558.32
30005	7021425.93	2605561.94
30006	7021425.72	2605546.44
30007	7021423.18	2605543.98
30008	7021386.20	2605544.49
30009	7021367.04	2605564.25
30010	7021366.07	2605500.26
30011	7021365.84	2605519.49
30012	7021405.84	2605519.21
30013	7021425.07	2605499.45
30014	7021425.05	2605498.45
30015	7021422.52	2605495.98
30016	7021407.02	2605496.20
30017	7021405.66	2605397.73
30018	7021405.59	2605392.73
30019	7021404.60	2605321.21
30020	7021420.07	2605321.00
30021	7021423.01	2605318.36
30022	7021445.34	2605283.18
30023	7021454.46	2605266.40
30024	7021454.27	2605252.61
30025	7021430.48	2605241.68
30026	7021396.82	2605260.95
30027	7021383.03	2605282.08
30028	7021370.52	2605230.05
30029	7021393.20	2605235.53
30030	7021435.30	2605196.77
30031	7021434.40	2605191.38
30032	7021419.36	2605177.30
30033	7021436.57	2605158.93
30034	7021439.86	2605158.82
30035	7021439.75	2605155.53
30036	7021455.02	2605139.22
30037	7021458.31	2605139.11
30038	7021458.21	2605135.82
30039	7021473.48	2605119.51
30040	7021476.77	2605119.41
30041	7021476.66	2605116.12
30042	7021493.87	2605097.74
30043	7021505.15	2605108.31
30044	7021508.41	2605108.45
30045	7021532.38	2605099.92
30046	7021591.37	2605097.72
30047	7021693.83	2605095.19
30048	7021693.74	2605088.19
30049	7021664.31	2605129.60
30050	7021664.67	2605155.60
30051	7021658.26	2605162.19
30052	7021655.72	2605159.72
30053	7021655.25	2605125.73
30054	7021657.72	2605123.19
30055	7021537.26	2605127.36
30056	7021537.52	2605145.86
30057	7021528.52	2605145.98
30058	7021528.73	2605161.48
30059	7021526.27	2605164.01
30060	7021524.34	2605164.04

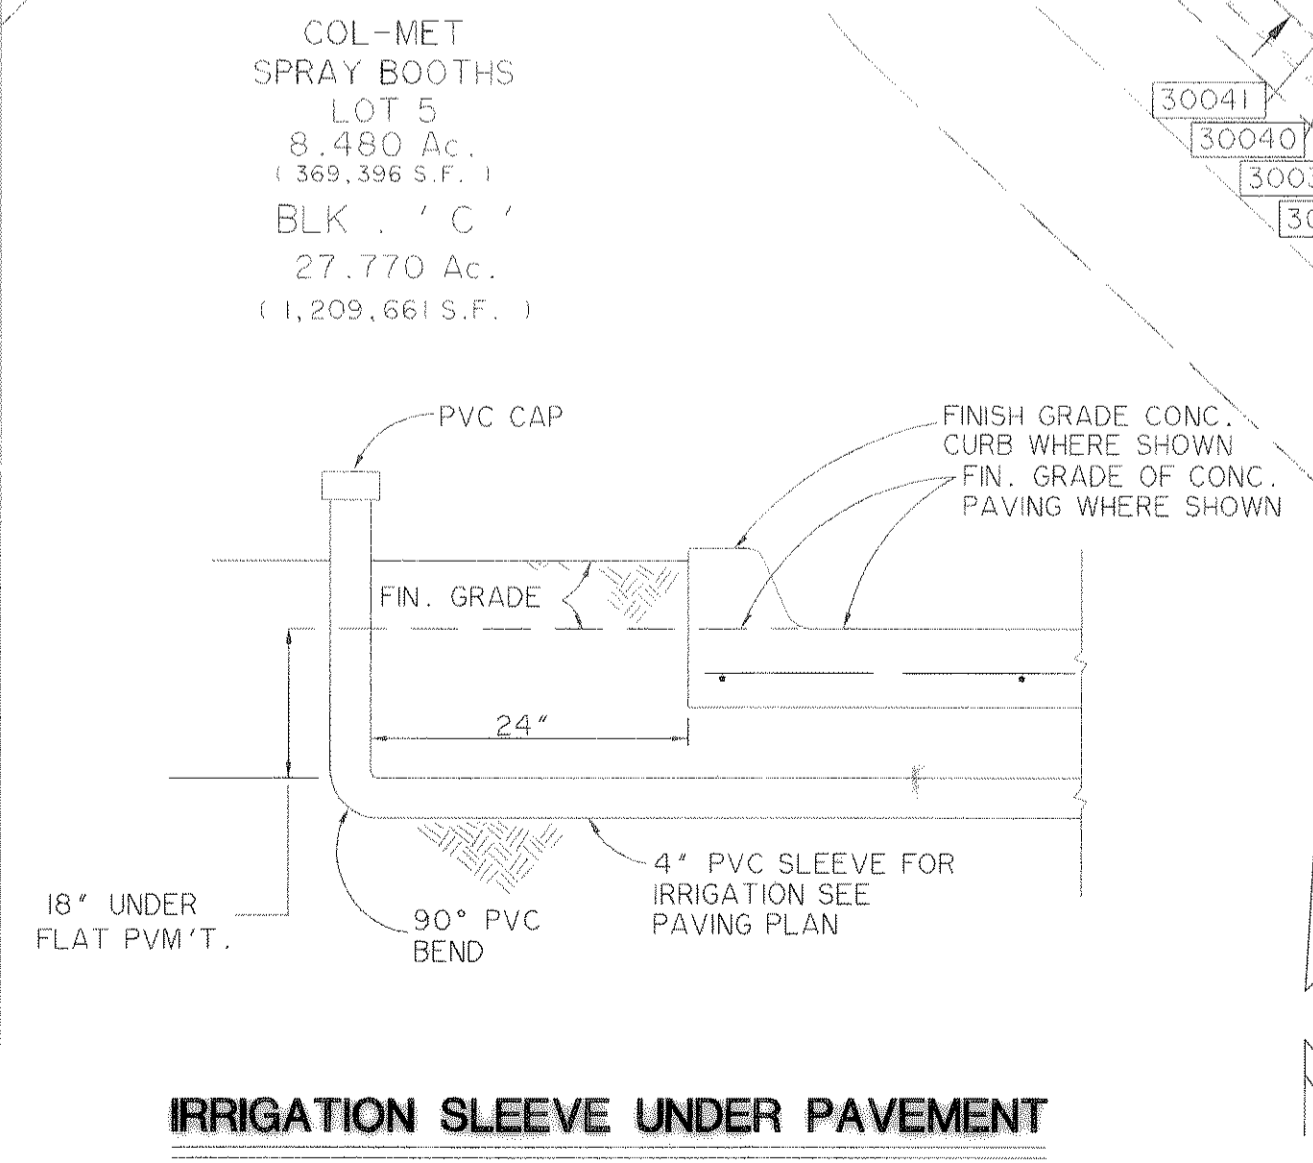

FULL-DEPTH SAWCUT AND REMOVE 53 L.F. OF CURB AND GUTTER. DOWEL NEW CONC. INTO EXISTING PAVEMENT PER DETAIL ON PAGE 301

DOWEL NEW SIDEWALK INTO EXISTING.

FULL-DEPTH SAWCUT AND REMOVE 64 L.F. OF CURB AND GUTTER. DOWEL NEW CONC. INTO EXISTING PAVEMENT PER DETAIL ON PAGE 301

- GENERAL NOTES:
- ALL COORDINATES ARE TO THE BACK OF CURB, UNLESS NOTED OTHERWISE.
 - DIMENSIONS SHOWN ARE TO THE FACE OF CURB, UNLESS NOTED OTHERWISE.
 - ALL PROPOSED CURB RADIUS ARE 3.0', UNLESS NOTED OTHERWISE.
 - SEE ARCHITECTURAL PLANS FOR BLDG. DIMENSIONS.
 - ALL CONCRETE PAVEMENT SHALL HAVE 6" CURBS UNLESS OTHERWISE NOTED.
 - FIRE LANE SHALL STATE "NO PARKING FIRE LANE" EVERY 25'. W/ WHITE 4" LETTERS ON 6" RED BACKGROUND

RECORD DRAWING
12/21/05



TIME: 9:43 FILE: PAVE-98041.02.dwg