


CAUTION !!!
UNDERGROUND UTILITIES

EXISTING UTILITIES AND UNDERGROUND FACILITIES INDICATED ON THESE PLANS HAVE BEEN LOCATED FROM REFERENCE INFORMATION SUPPLIED BY VARIOUS OWNERS OF THE FACILITIES. THE ENGINEER DOES NOT ACCEPT THE RESPONSIBILITY FOR THE UTILITY LOCATIONS SHOWN. IT SHALL BE THE RESPONSIBILITY OF THE CONTRACTOR TO VERIFY BOTH HORIZONTALLY AND VERTICALLY THE LOCATION OF ALL EXISTING UTILITIES AND UNDERGROUND FACILITIES PRIOR TO CONSTRUCTION, TO TAKE NECESSARY PRECAUTIONS IN ORDER TO PROTECT ALL FACILITIES ENCOUNTERED, AND TO NOTIFY THE ENGINEER PROMPTLY OF ALL CONFLICTS OF THE WORK WITH EXISTING FACILITIES. THE CONTRACTOR SHALL PRESERVE AND PROTECT ALL EXISTING UTILITIES FROM DAMAGE DURING CONSTRUCTION. ANY DAMAGE BY THE CONTRACTOR TO EXISTING UTILITIES SHALL BE REPAIRED BY THE CONTRACTOR AT HIS EXPENSE.

NOTE: USE CURB AND TOE WALL IN VICINITY OF EXISTING SHRUBS AS NECESSARY TO PREVENT LOSS OF SHRUBS

RECORD DRAWING
12/21/05



PREPARED BY:
WIER & ASSOCIATES, INC.
ENGINEERS SURVEYORS LAND PLANNERS
4300 BELTWAY PLACE SUITE 130 ARLINGTON, TEXAS 76018 METRO (817)467-7700
1380 U.S. HIGHWAY 287 N. SUITE 101 WANSFORD, TEXAS 76063 METRO (817)477-9700
8648 ELM STREET FROSTO, TEXAS 75024 METRO (214)387-8000
www.wierassociates.com

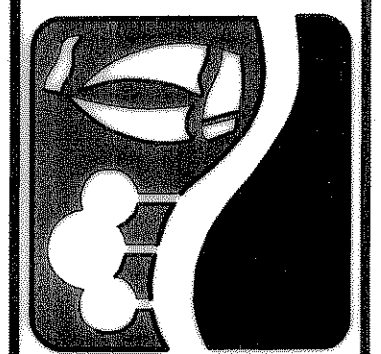




CITY OF
ROCKWALL
EMPHYSIS

GRADING &
STORM DRAIN
PLAN


STATE OF TEXAS
REGISTERED PROFESSIONAL ENGINEER
RONALD RAMIREZ
81821
COPYRIGHT ©
WIER & ASSOCIATES, INC.
LAST SHEET EDIT
DATE 12-29-2005
WA# 96041-02
SHEET NO.
G101

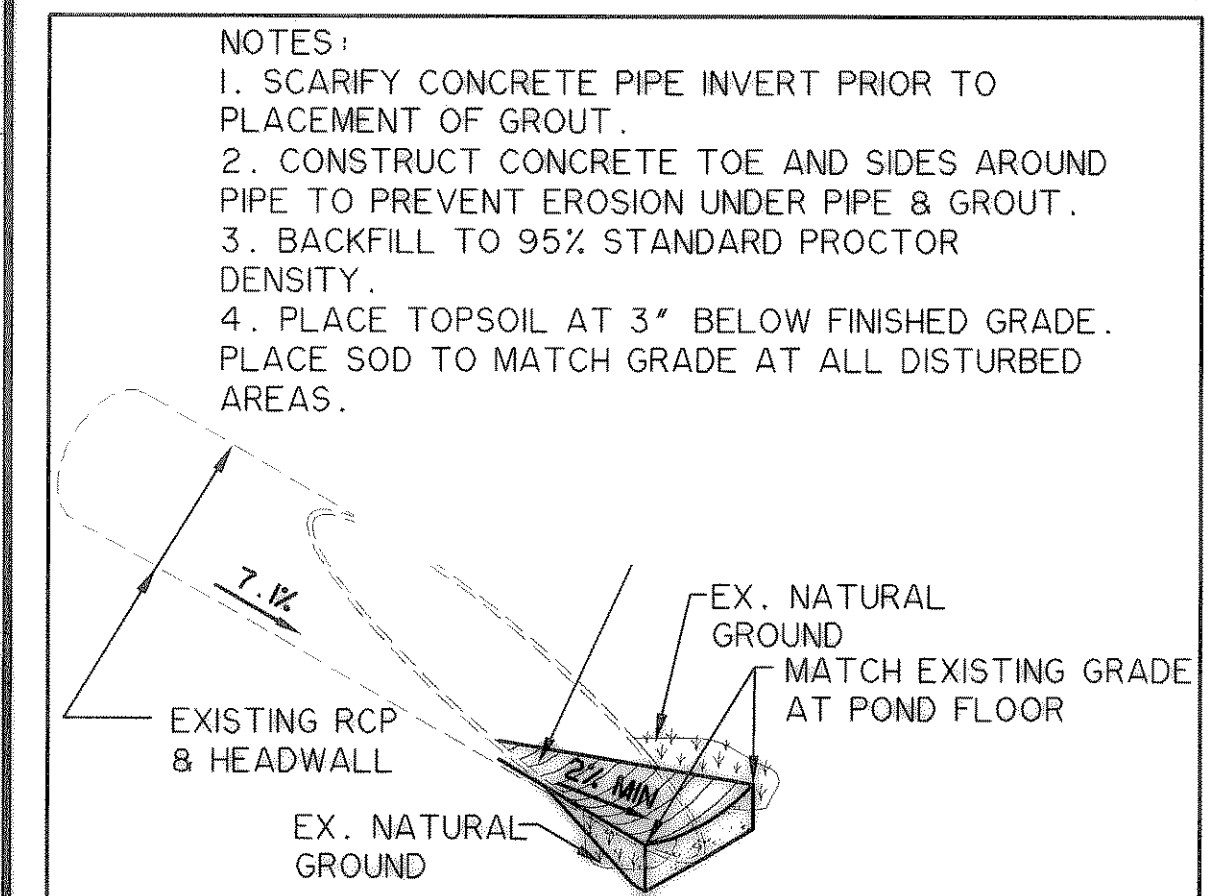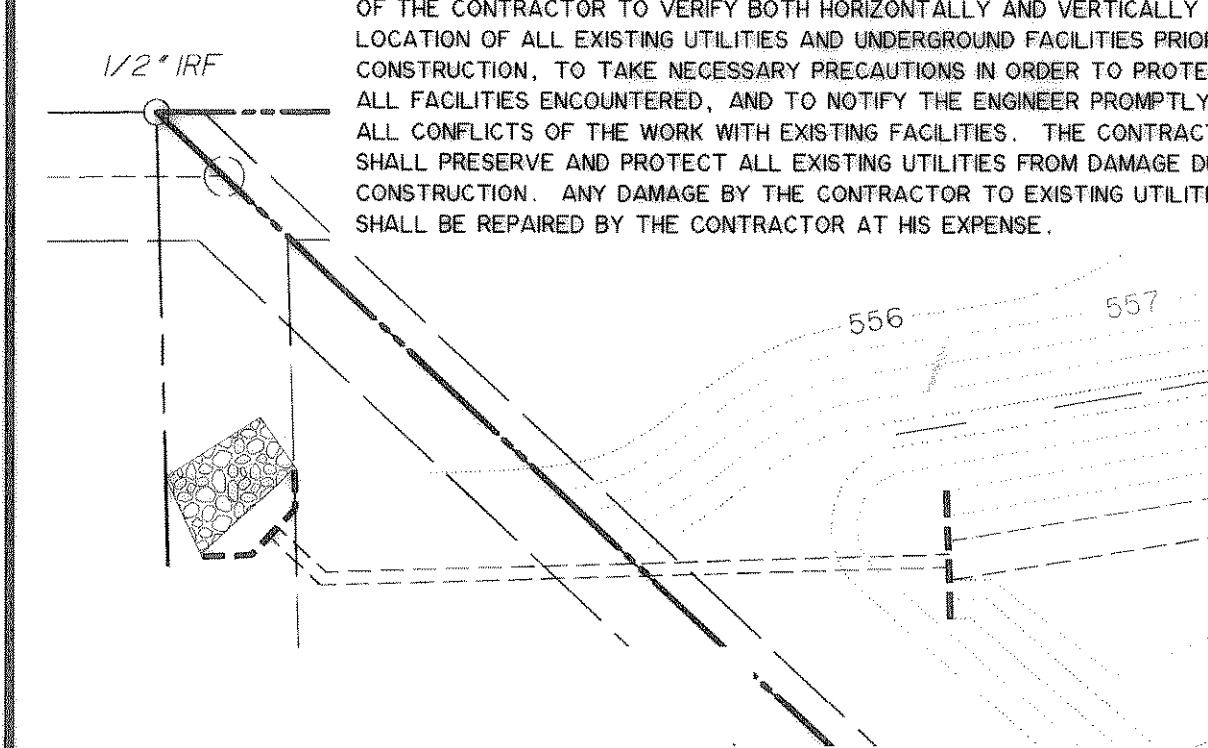

DETAIL 'C'
N.T.S.

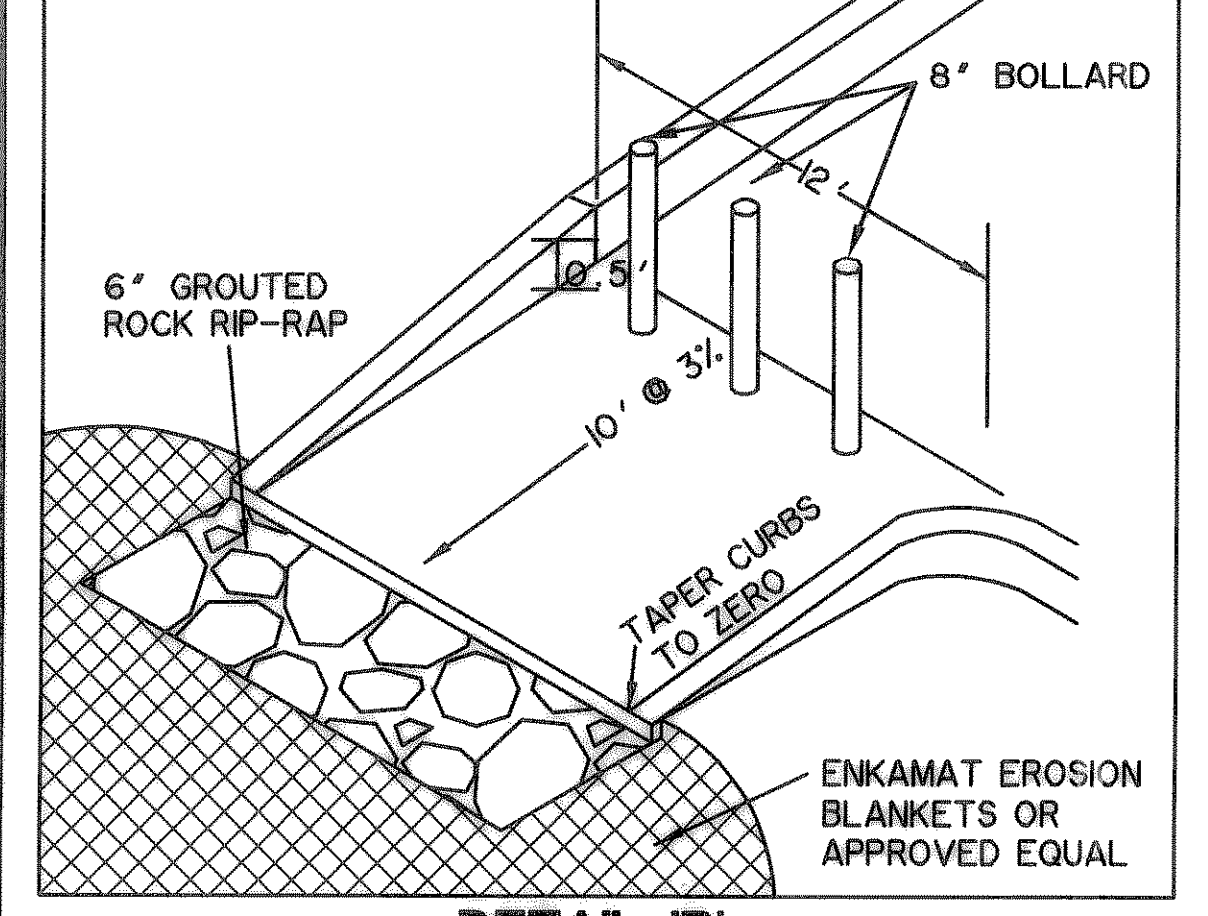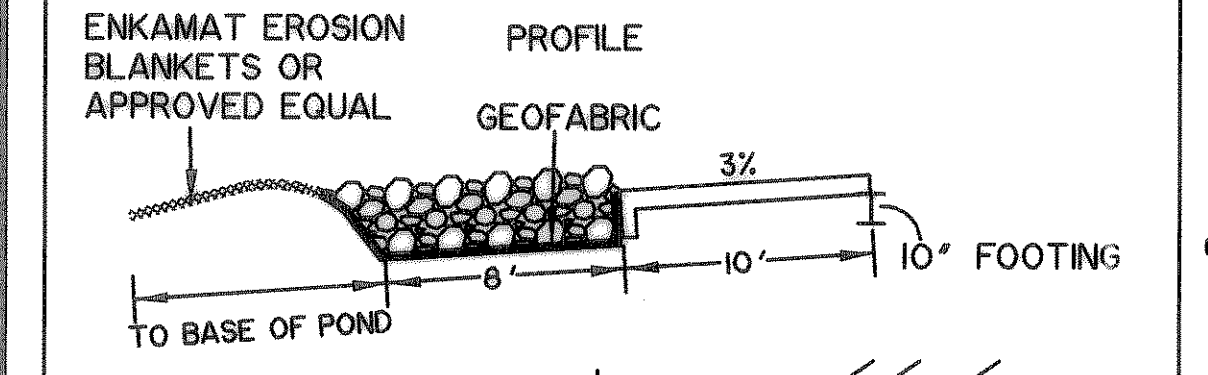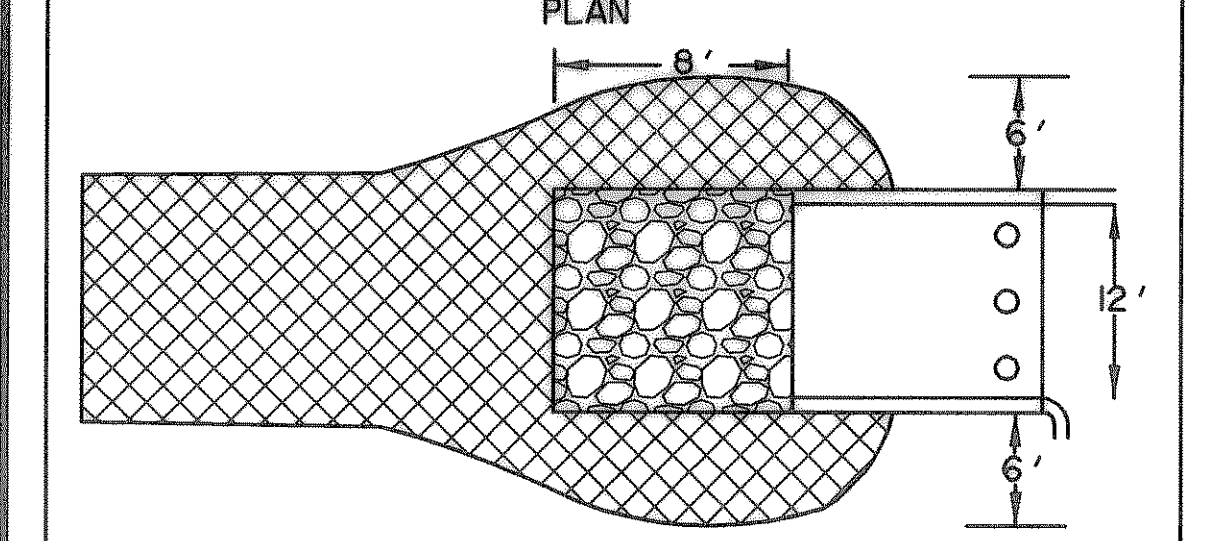


DETAIL 'B'
N.T.S.

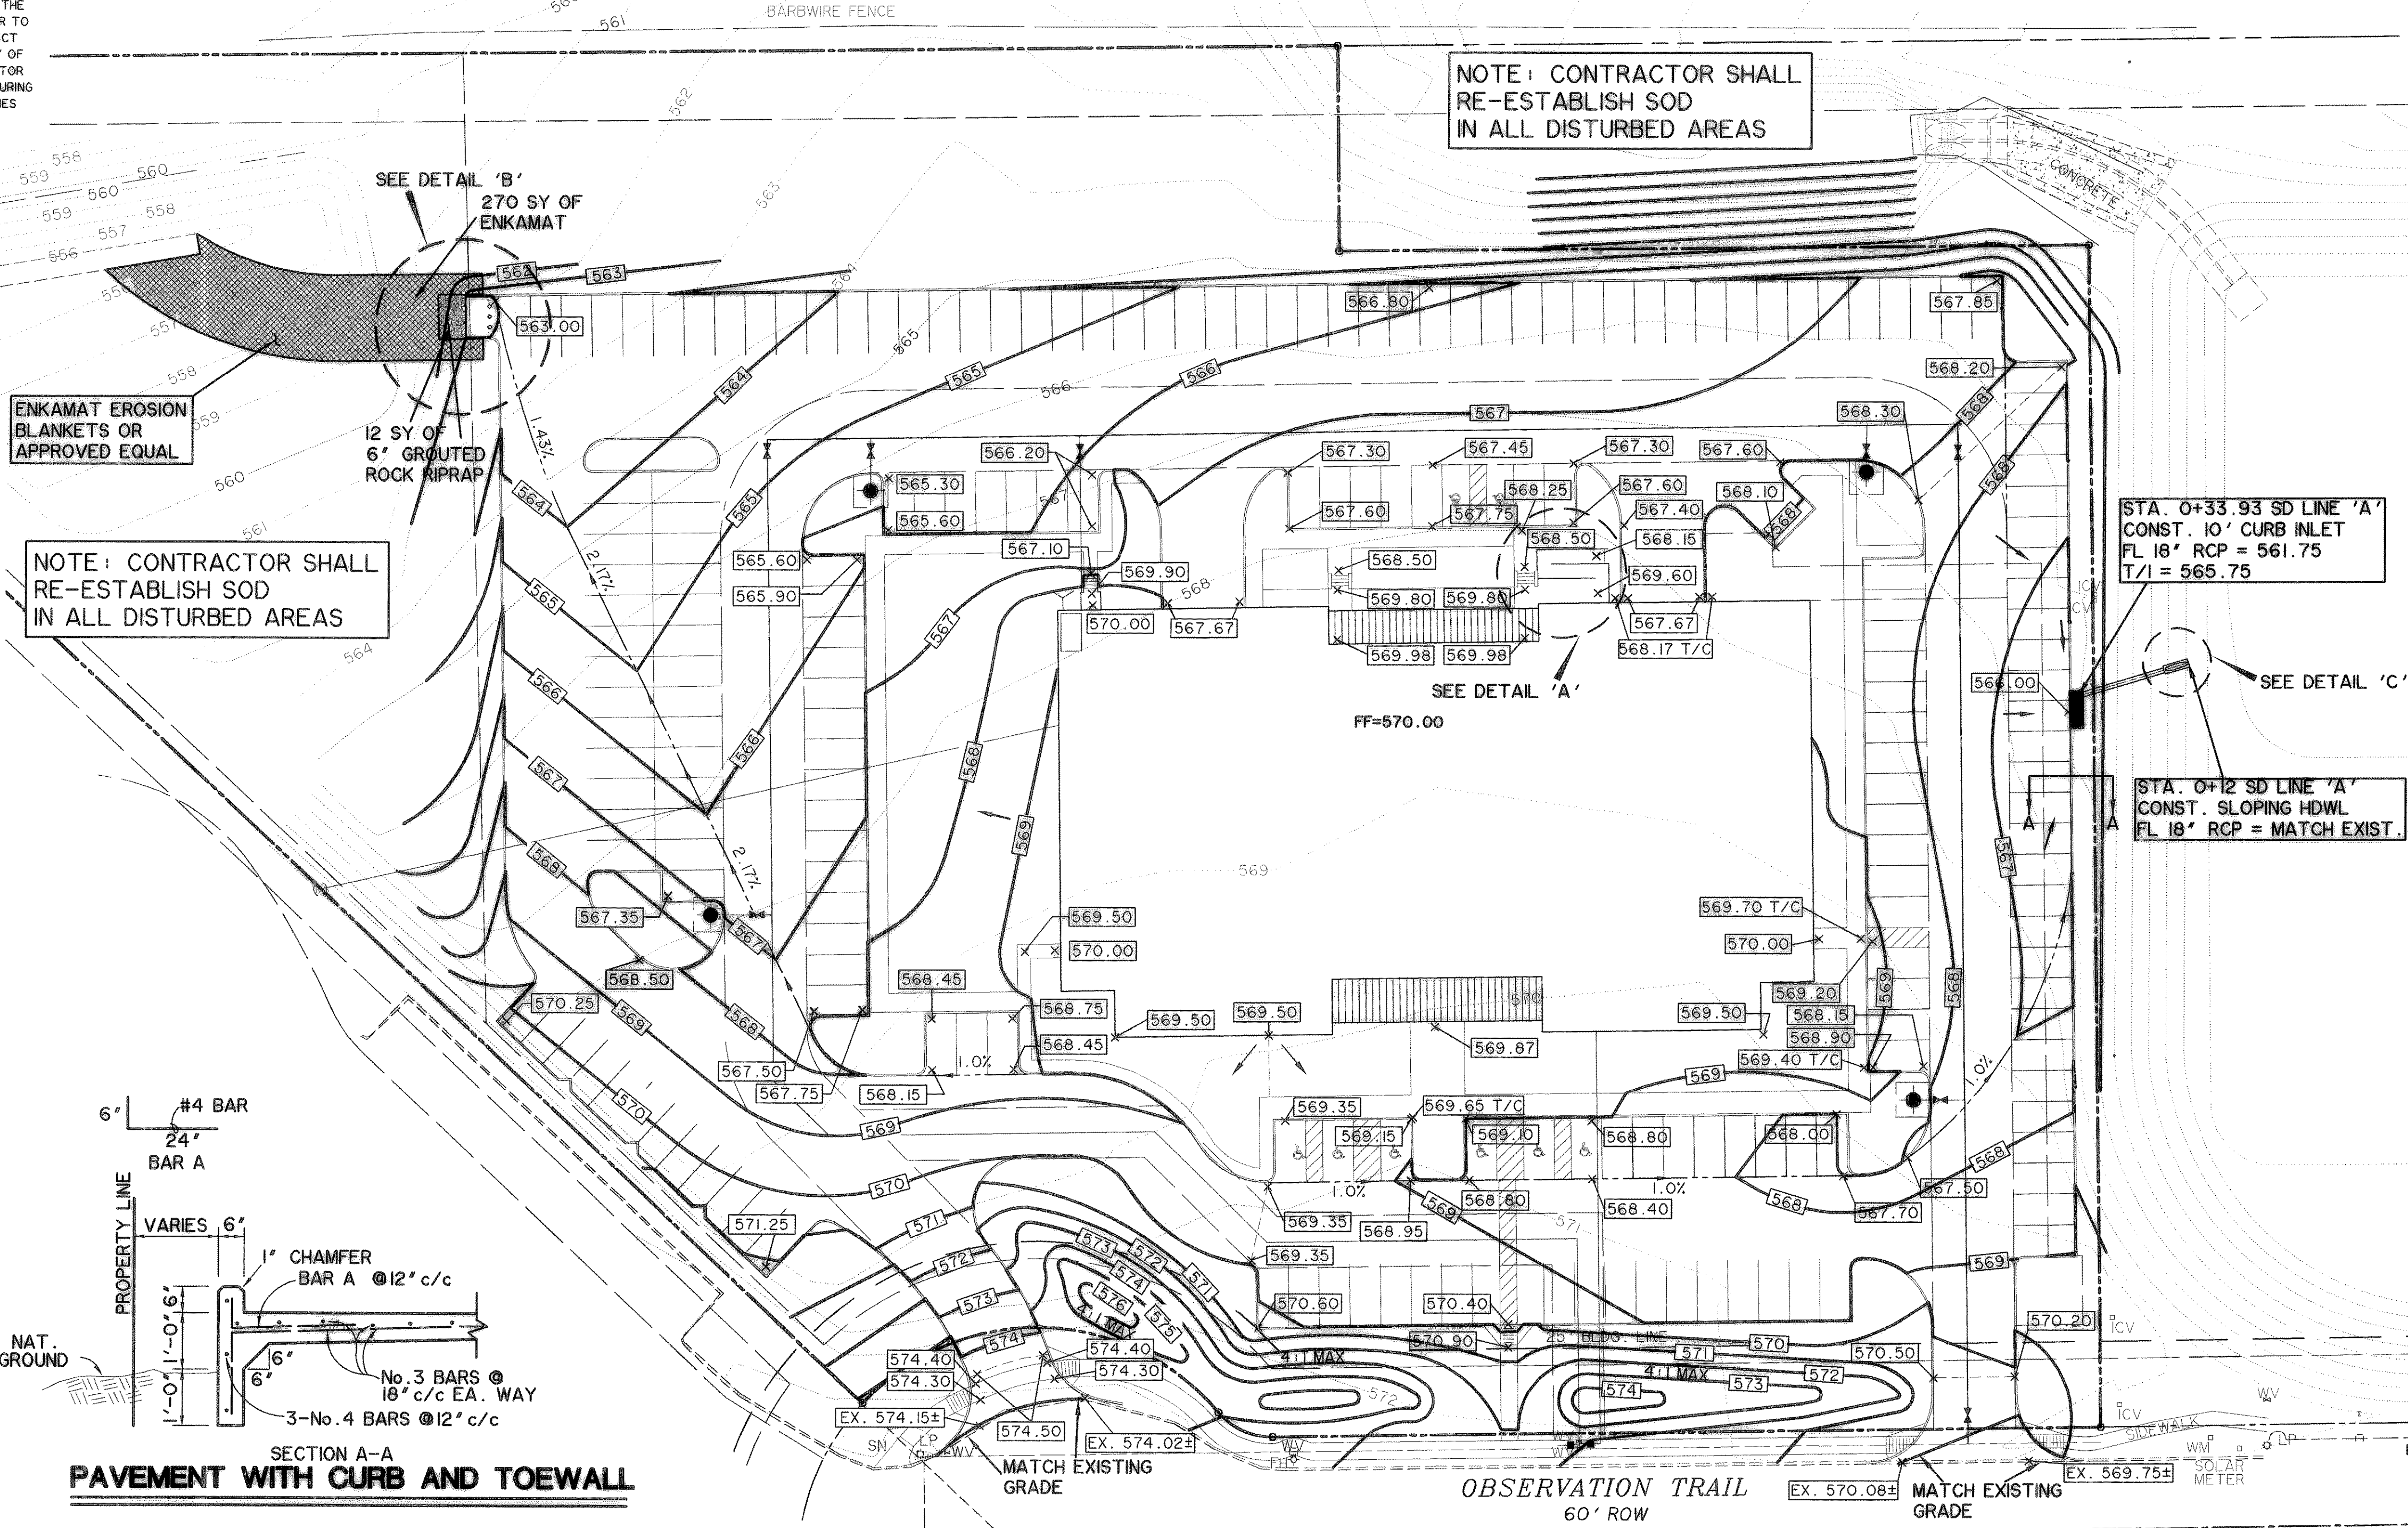

SECTION A-A
PAVEMENT WITH CURB AND TOEWALL


FLOW CALCULATIONS FOR 12' CURB OPENING

Q=CIA	Capacity of 12' CURB OPENING
C=0.7	USING MANNING'S EQUATION
$I_{100}=9.8$	$Q_{cap}=(1.49/n)(A)(S^{1/2})(R^{2/3})$
A=2.41 AC	WHERE
Q= 16.5 cfs USE 17 cfs	n=0.013
Q=VA	A=0.33' * 12'
V=4.5 fps (Desired)	S=0.03
A=Depth of flow * L	R=(3.96/12.66)=0.3128
LET DEPTH="4" OR 0.33'	$Q_{cap}=(1.49/0.013)(3.96)(0.03^{1/2})(0.3128^{2/3})$
17cfs=(4 ft/s)(0.33 * L)	$Q_{cap} = 36.5cfs > 16 cfs \Rightarrow$ O.K.
LENGTH = 12'	

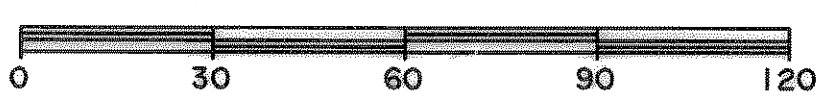

LEGEND

---	R.O.W. LINE
---	STORM DRAIN LINE
---	STORM DRAIN INLET
---	MATCH LINE
---	LOT LINE
---	EXIST. MAJOR CONTOUR
---	EXIST. MINOR CONTOUR
---	FLOW DIRECTION
H.P.	HIGH POINT
XX	PROPOSED CONTOUR
TC	TOP OF CURB
TP	TOP OF PAVEMENT
FF	FINISHED PAD

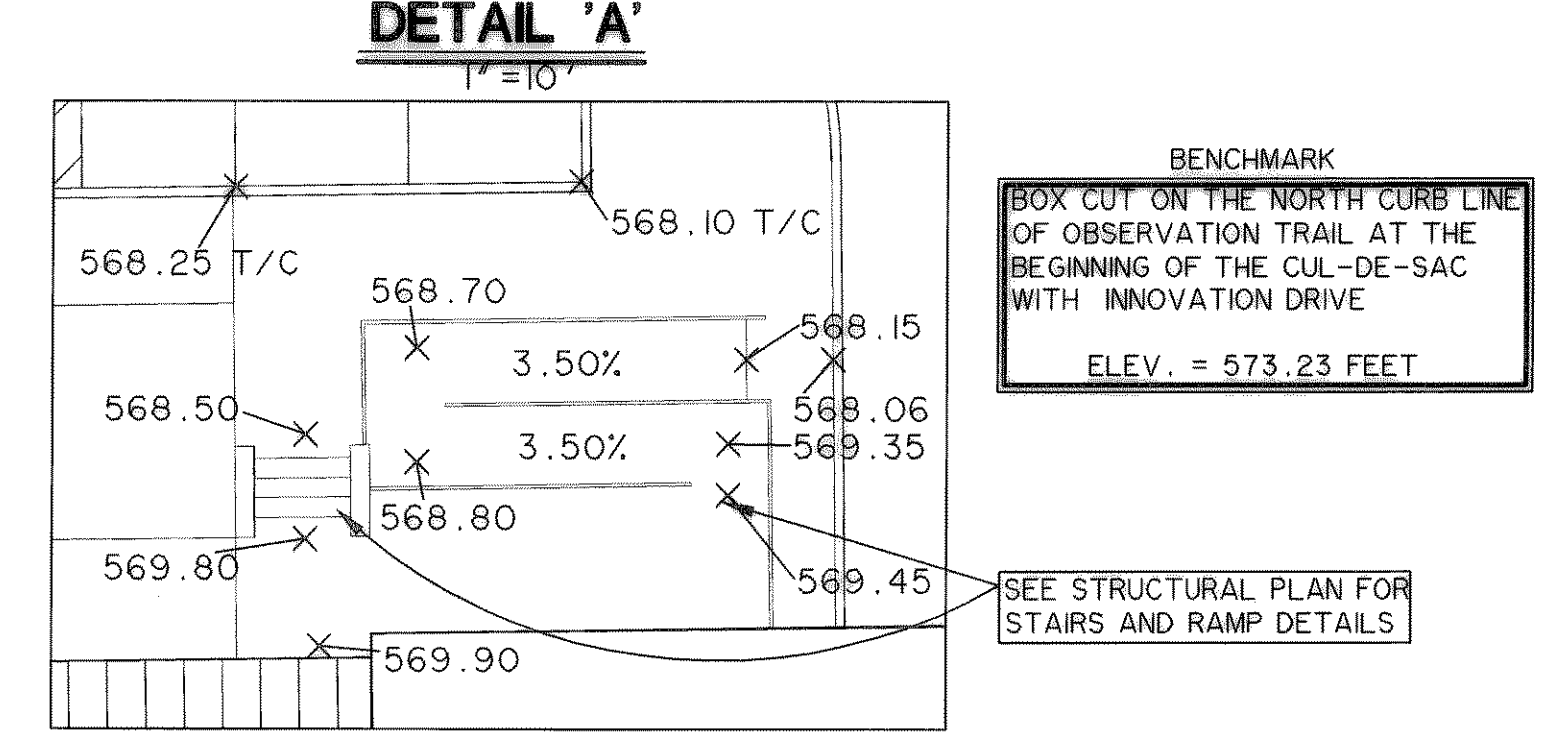

FILE: GRADE1-96041_02.dwg
TIME: 11:28