
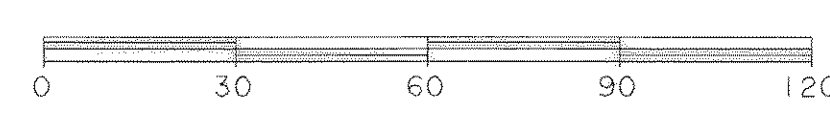


FILE : WATER-98041.02.dwg

TIME 11:13

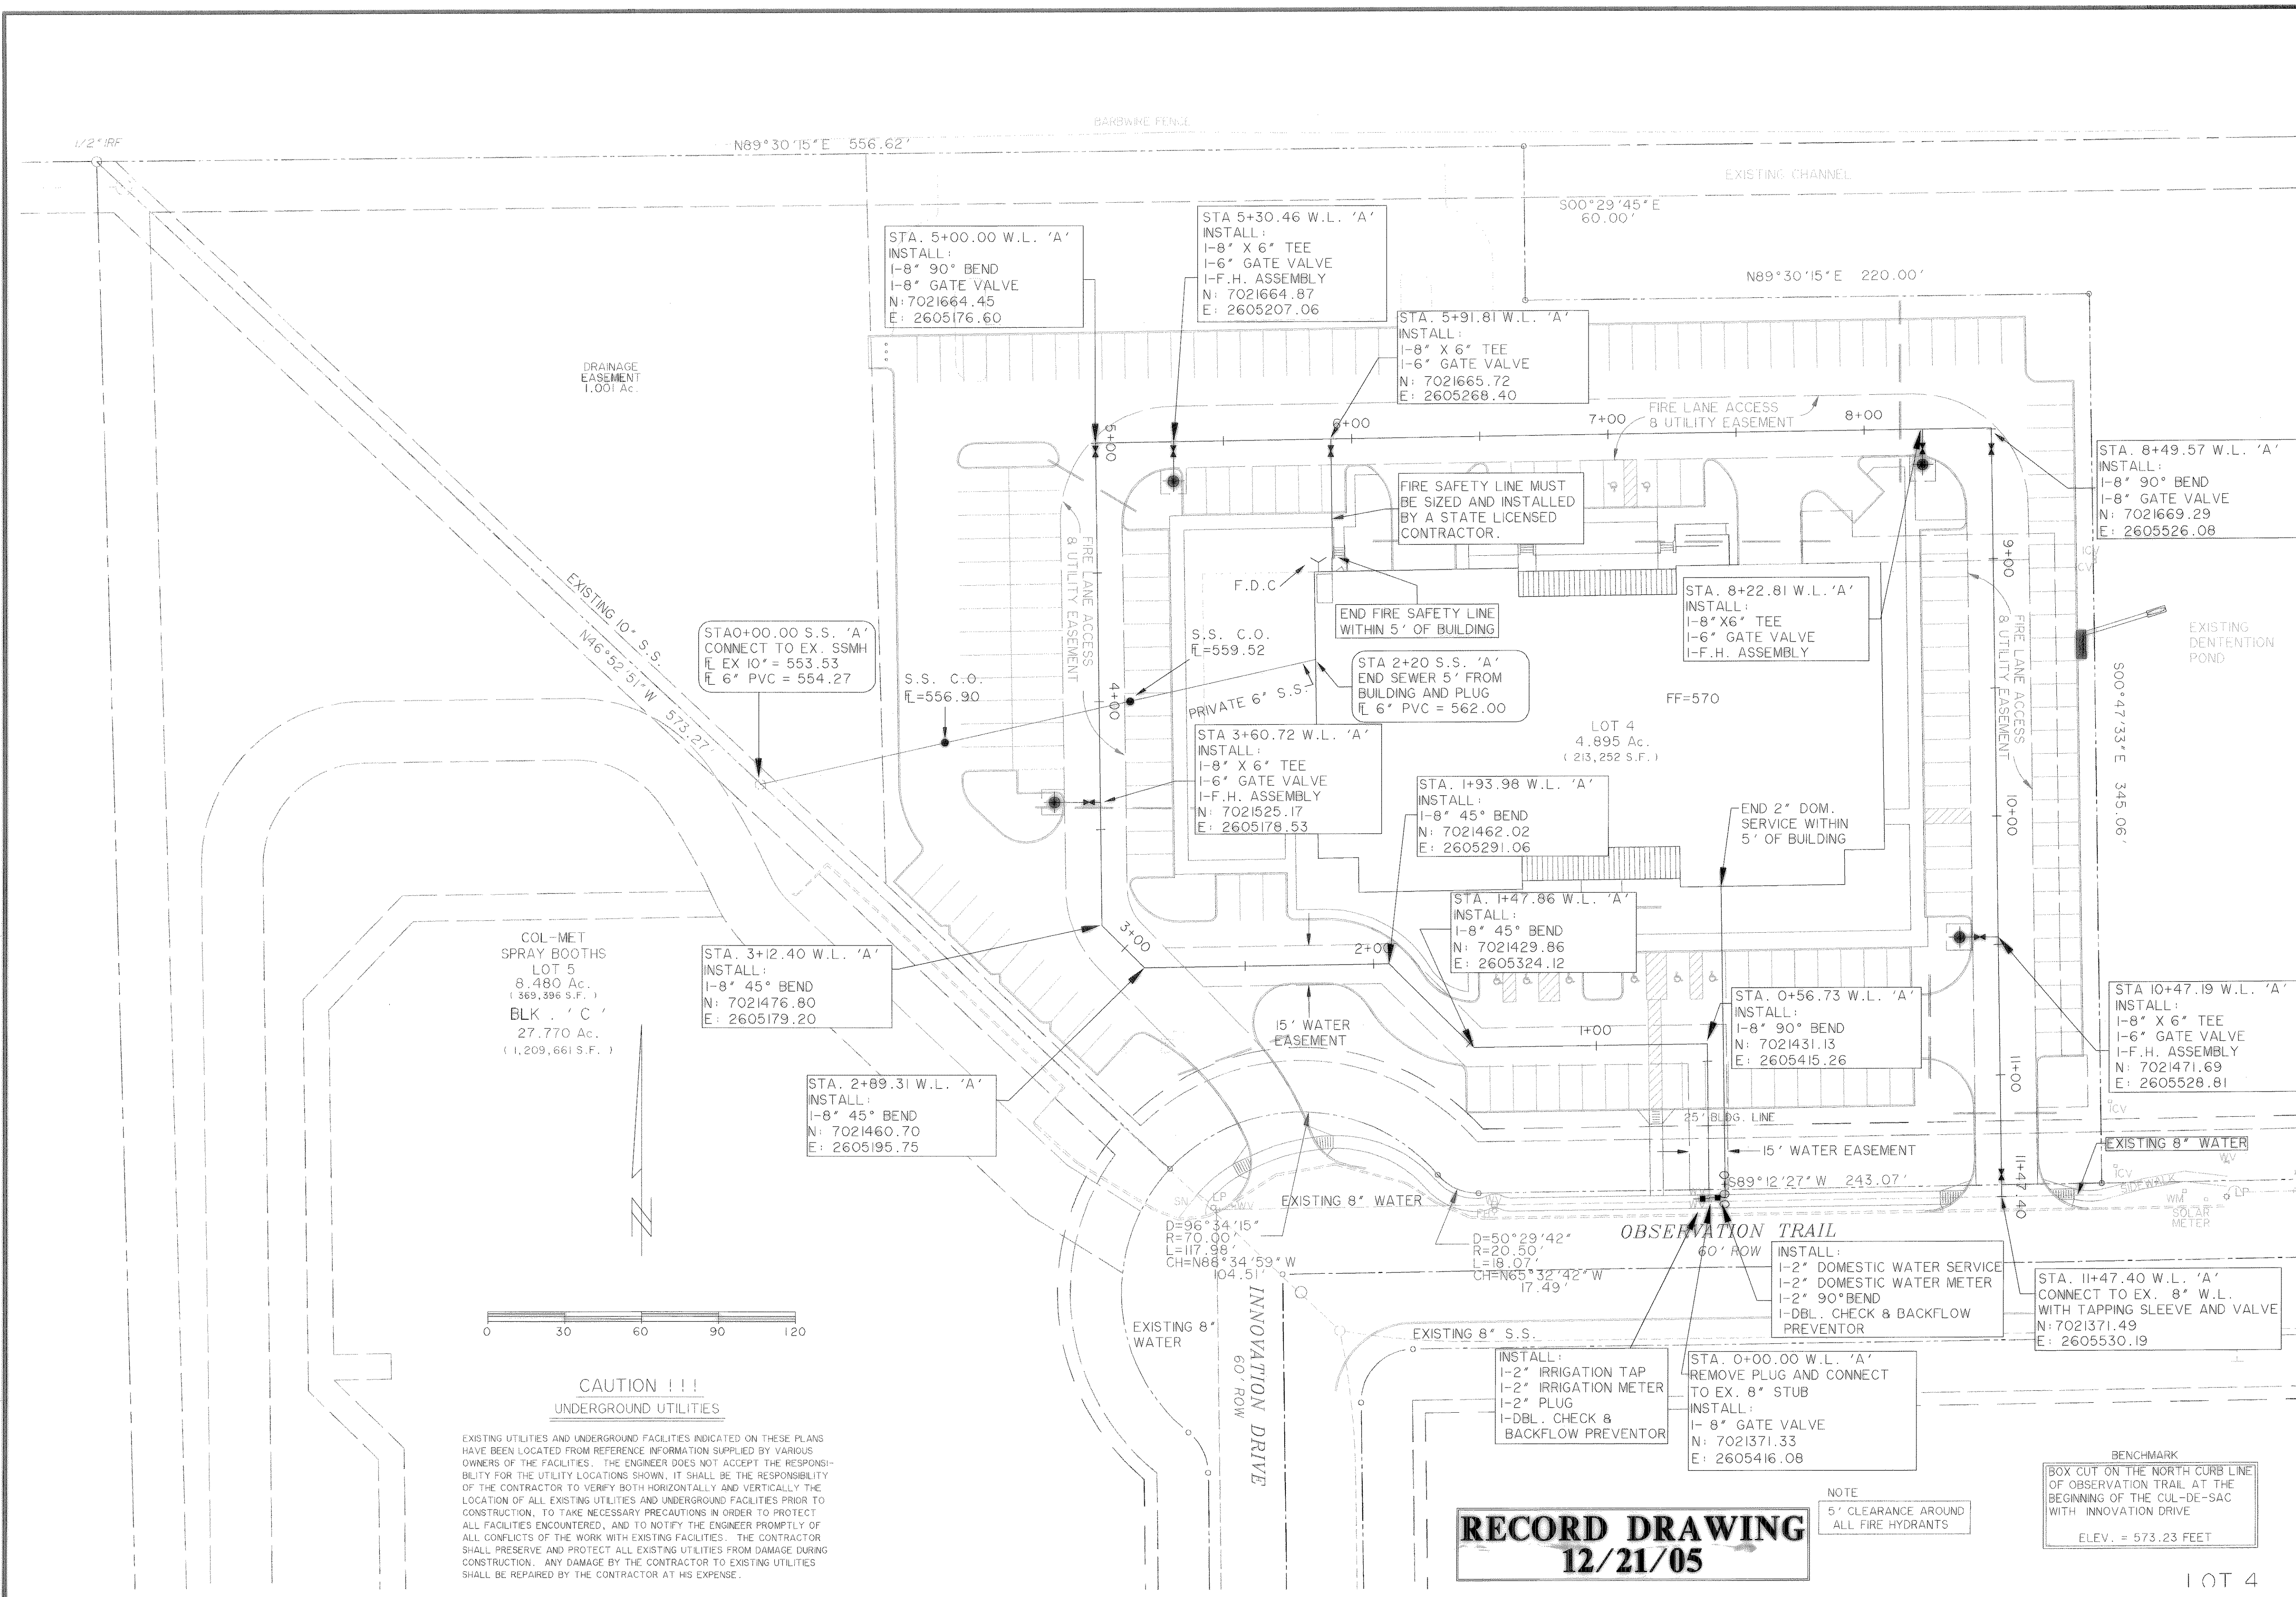

**CAUTION !!!**  
UNDERGROUND UTILITIES


EXISTING UTILITIES AND UNDERGROUND FACILITIES INDICATED ON THESE PLANS HAVE BEEN LOCATED FROM REFERENCE INFORMATION SUPPLIED BY VARIOUS OWNERS OF THE FACILITIES. THE ENGINEER DOES NOT ACCEPT THE RESPONSIBILITY FOR THE UTILITY LOCATIONS SHOWN. IT SHALL BE THE RESPONSIBILITY OF THE CONTRACTOR TO VERIFY BOTH HORIZONTALLY AND VERTICALLY THE LOCATION OF ALL EXISTING UTILITIES AND UNDERGROUND FACILITIES PRIOR TO CONSTRUCTION, TO TAKE NECESSARY PRECAUTIONS IN ORDER TO PROTECT ALL FACILITIES ENCOUNTERED, AND TO NOTIFY THE ENGINEER PROMPTLY OF ALL CONFLICTS OF THE WORK WITH EXISTING FACILITIES. THE CONTRACTOR SHALL PRESERVE AND PROTECT ALL EXISTING UTILITIES FROM DAMAGE DURING CONSTRUCTION. ANY DAMAGE BY THE CONTRACTOR TO EXISTING UTILITIES SHALL BE REPAIRED BY THE CONTRACTOR AT HIS EXPENSE.

**RECORD DRAWING**  
**12/21/05**

NOTE  
 5' CLEARANCE AROUND ALL FIRE HYDRANTS


BENCHMARK  
 BOX CUT ON THE NORTH CURB LINE OF OBSERVATION TRAIL AT THE BEGINNING OF THE CUL-DE-SAC WITH INNOVATION DRIVE  
 ELEV. = 573.23 FEET

PREPARED BY:  
**VIA WIER & ASSOCIATES, INC.**  
 ENGINEERS SURVEYORS LAND PLANNERS  
 4300 BELTWAY PLACE SUITE 130 ARLINGTON, TEXAS 76018 METRO (817)467-7700  
 1380 U.S. HIGHWAY 287 N. SUITE 101 WANSFELD, TEXAS 76063 METRO (817)477-8700  
 8849 ELM STREET FRISCO, TEXAS 75034 METRO (214)387-8000  
 www.ViaWier.com

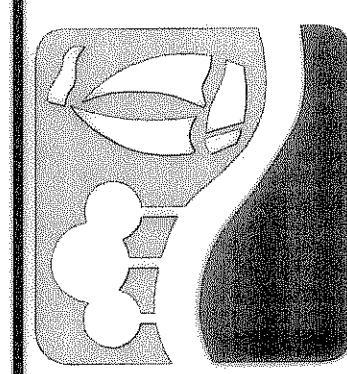

CITY OF  
**ROCKWALL**  
 EMPHYSIS

INSTALLED AS DRAWN  
 WATER & SANITARY  
 SEWER  
 PLAN

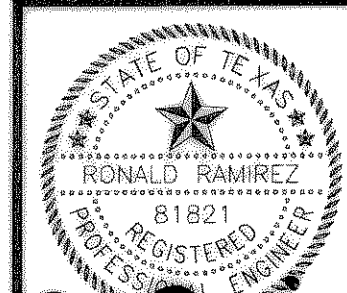

COPYRIGHT ©  
 WIER & ASSOCIATES, INC.  
 LAST SHEET EDIT  
 DATE 12-29-2005  
 WA# 98041.02  
**SHEET NO.**  
 U101

LOT 4