


CONSTRUCTION PLANS
FOR
FALCON FINE WIRE COMPANY
ROCKWALL TECHNOLOGY PARK

**J.M. ALLEN SURVEY, ABSTRACT NO. 2,
CITY OF ROCKWALL, ROCKWALL COUNTY, TEXAS**

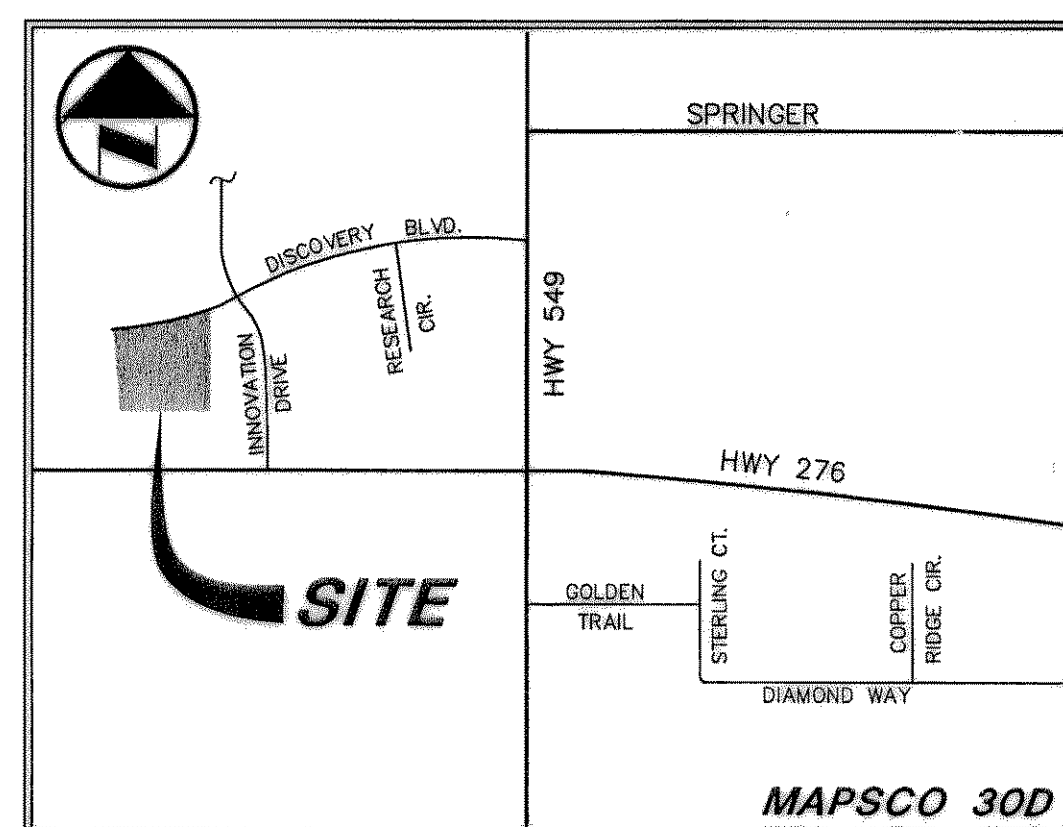

VICINITY MAP

PREPARED BY

PACHECO KOCH Consulting Engineers, Inc. 9401 LBJ Freeway, Suite 300
Dallas, Texas 75243 (972) 235-3031

FOR

VANTAGE COMPANIES 1231 W. CAMPBELL ROAD
RICHARDSON, TEXAS 75080

DRAWING SHEET INDEX

FOR
FALCON FINE WIRE CO.

SHEET	DESCRIPTION
C-1.0	DIMENSIONAL CONTROL PLAN
C-2.0	GRADING PLAN
C-3.0	DRAINAGE PLAN
C-4.0	WATER & SEWER PLAN
C-5.0	PAVING PLAN
C-6.0	EROSION CONTROL PLAN



THE SEAL APPEARING ON THIS DOCUMENT WAS AUTHORIZED BY STEVEN A. MARKUSSEN P.E. 70090 ON 10/27/99. ALTERATION OF A SEALED DOCUMENT WITHOUT PROPER NOTIFICATION TO THE RESPONSIBLE ENGINEER IS AN OFFENSE UNDER THE TEXAS ENGINEERING PRACTICE ACT.

RECORD DRAWING

THIS DRAWING HAS BEEN REVISED TO REFLECT CONSTRUCTION RECORDS MAINTAINED AND PROVIDED BY THE CONTRACTOR FOR THIS PROJECT.

CONTRACTOR: VANTAGE COMPANIES
1231 W. CAMPBELL ROAD
RICHARDSON, TX 75080

DATE REVISED: JULY 21, 2000