



**PAVING PLAN**  
NTS


- LEGEND**
- DRIVE & PARKING AREAS  
5" CONCRETE PAVEMENT  
3000 PSI - CLASS A
  - TRUCK LANES & DOCK AREAS  
6" CONCRETE PAVEMENT  
3600 PSI - CLASS C  
(8 SACK CONC. IF MACHINE  
6-1/2 SACK CONC. IF  
HAND POURED)

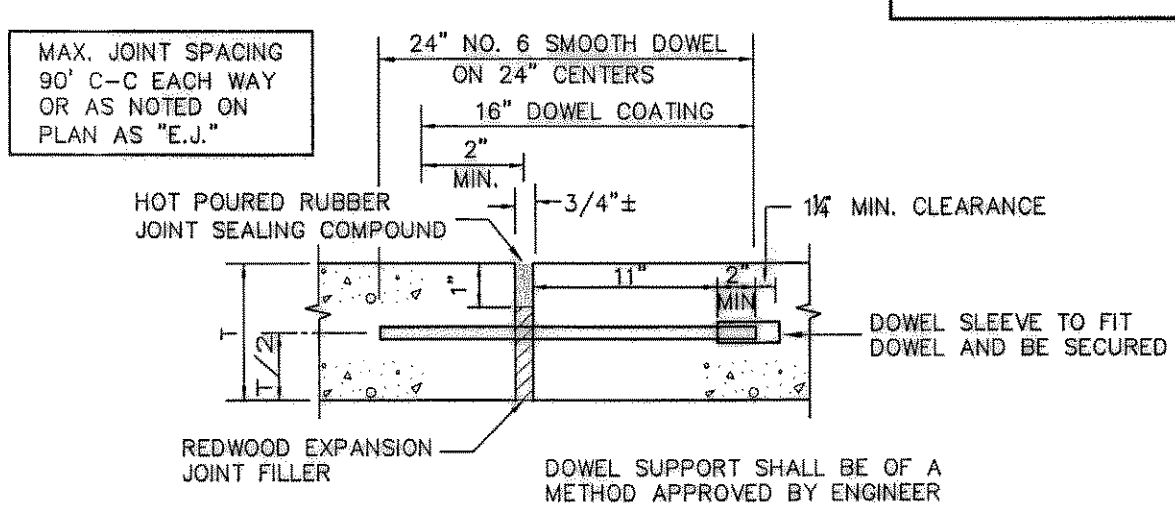


**5 Expansion Joint**  
NOT TO SCALE

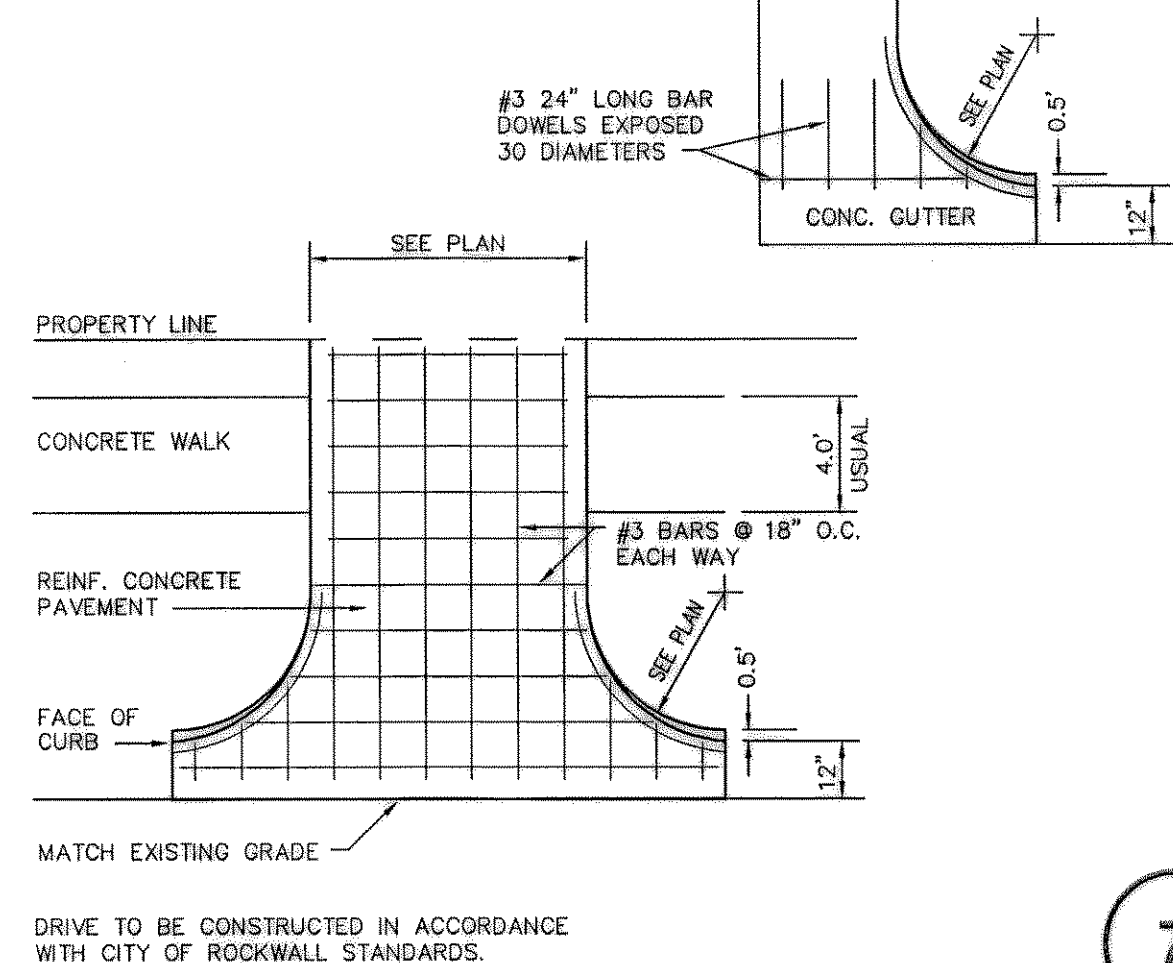


**6 Driveway Approach**  
NOT TO SCALE

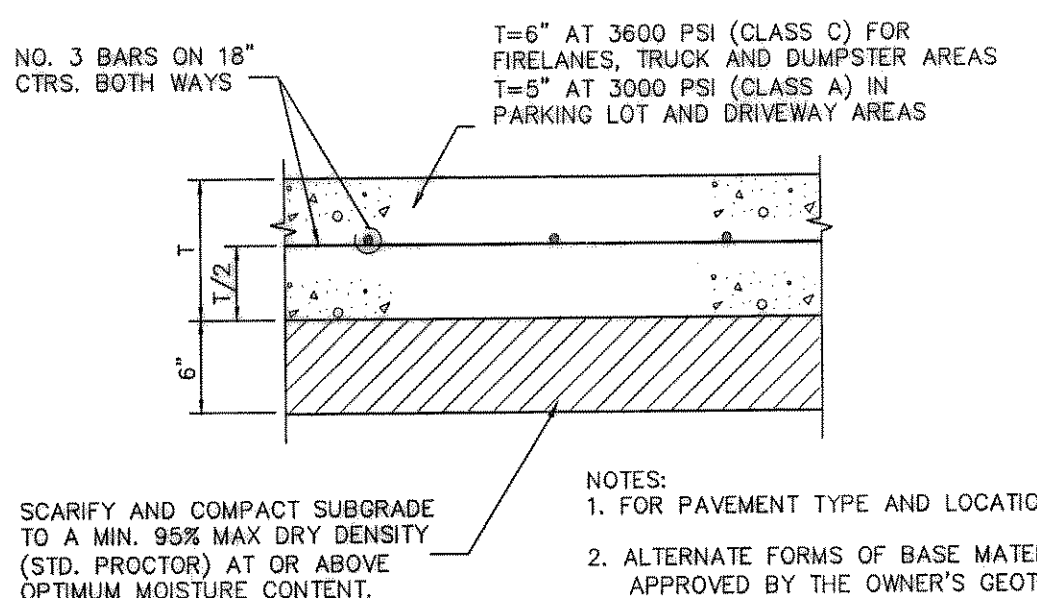


**1 Pavement Section**  
NOT TO SCALE

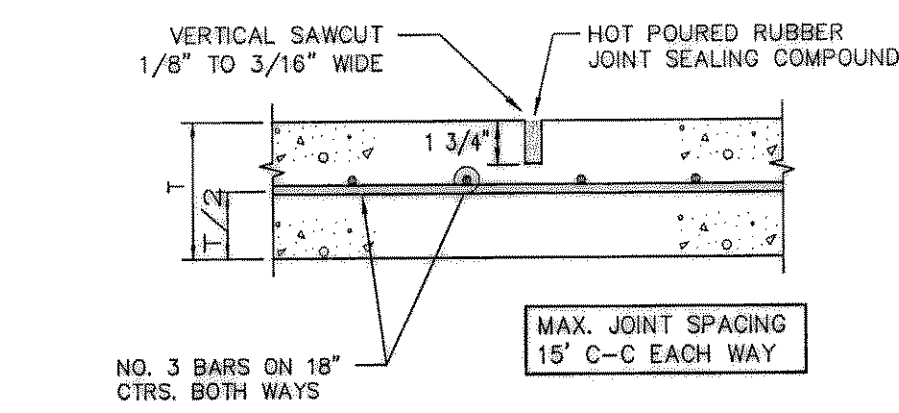


**3 Sowed Dummy Joint**  
NOT TO SCALE

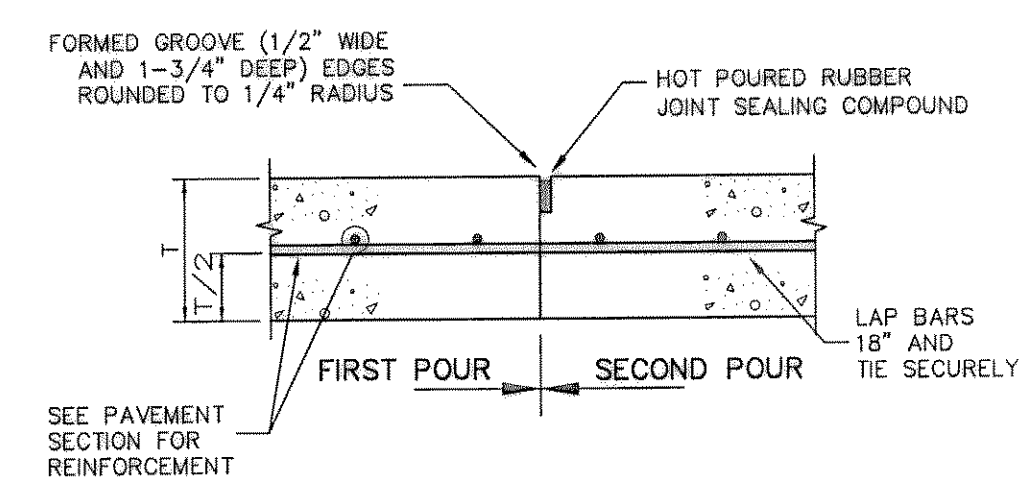


**2 Construction Joint**  
NOT TO SCALE

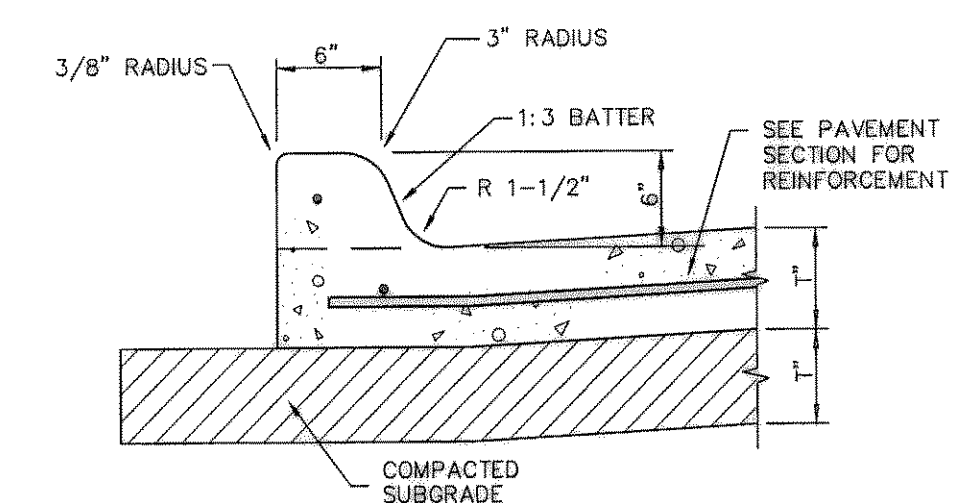


**4 Integral Curb**  
NOT TO SCALE

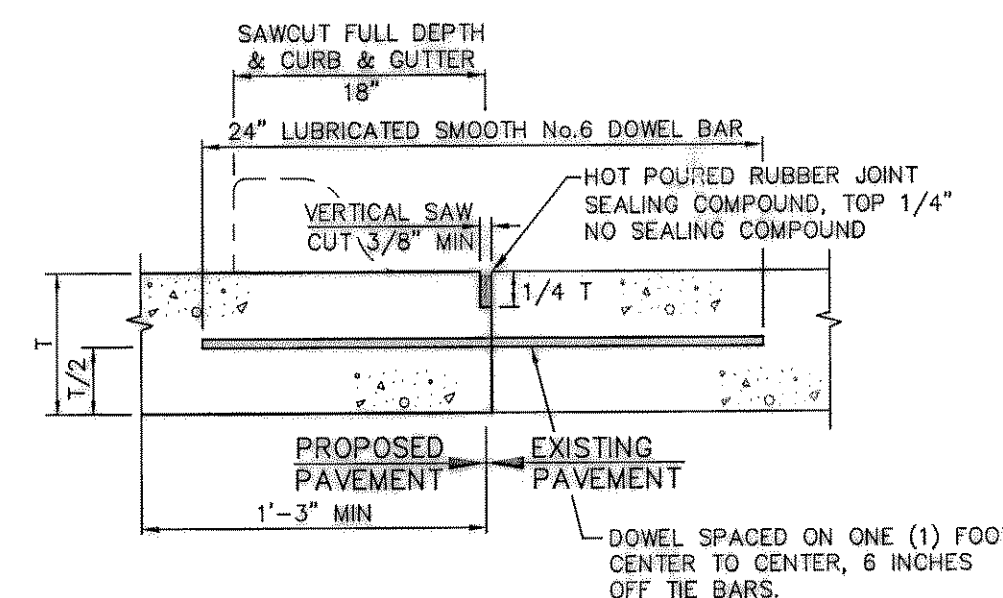


**7 Pavement Connection**  
NOT TO SCALE

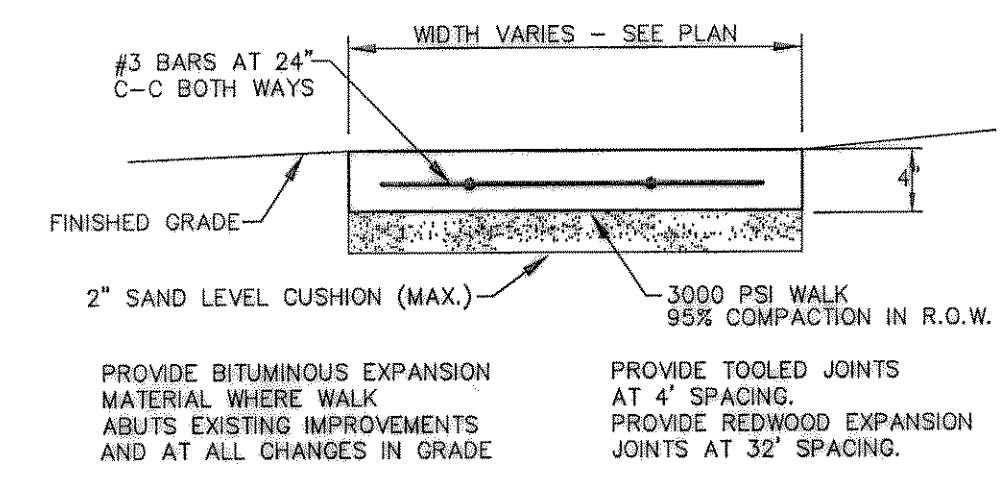

**8 Concrete Walk**  
NOT TO SCALE

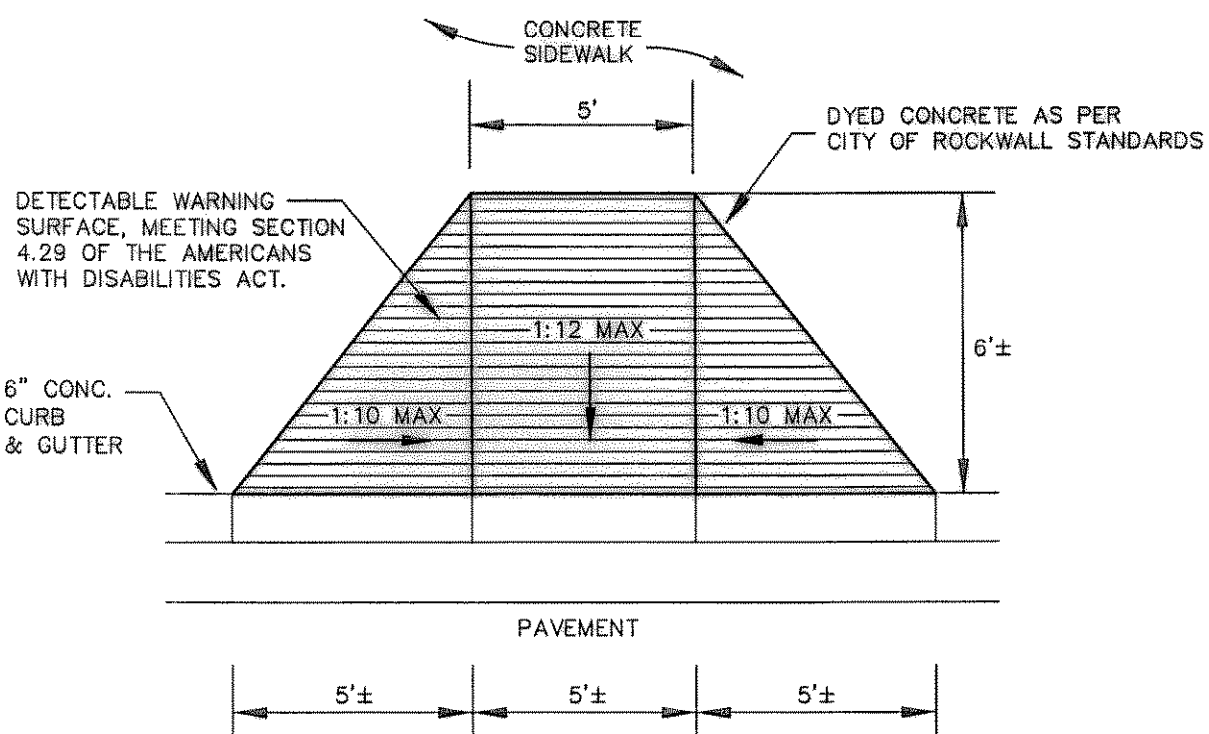


**9 Plan at Flare Side Handicapped Ramp**  
NOT TO SCALE

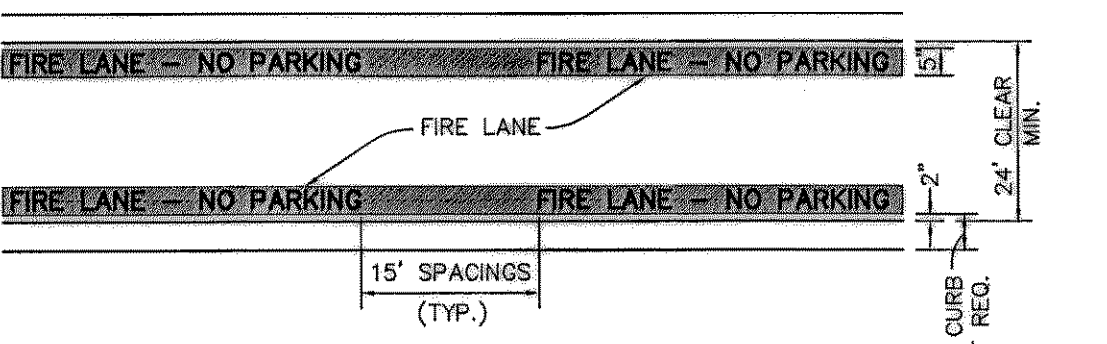


- STRIPING DETAIL**
- A. PAINT:**
- STRIPE SHALL BE FIVE (5) INCHES WIDE PAINTED WITH AN EXTERIOR ACRYLIC LATEX PAINT.
    - A. COLOR SHALL BE "TRAFFIC RED" GULDEN NO. 63251 OR EQUAL.
    - B. COLOR SHALL BE "TRAFFIC WHITE" GULDEN NO. 563245 OR EQUAL.
  - LETTERS SHALL BE FOUR (4) INCHES HIGH PAINTED WITH AN EXTERIOR ACRYLIC LATEX PAINT.
- B. APPLICATION:**
- STRIPE MAY BE BRUSHED OR SPRAYED, ONE COAT TO FINISH.
  - LETTERS SHALL BE STENCIL FORMED, BRUSH APPLIED AND SPACED AS DETAILED ON THIS SHEET.

**10 Firelane Striping Detail**  
NOT TO SCALE

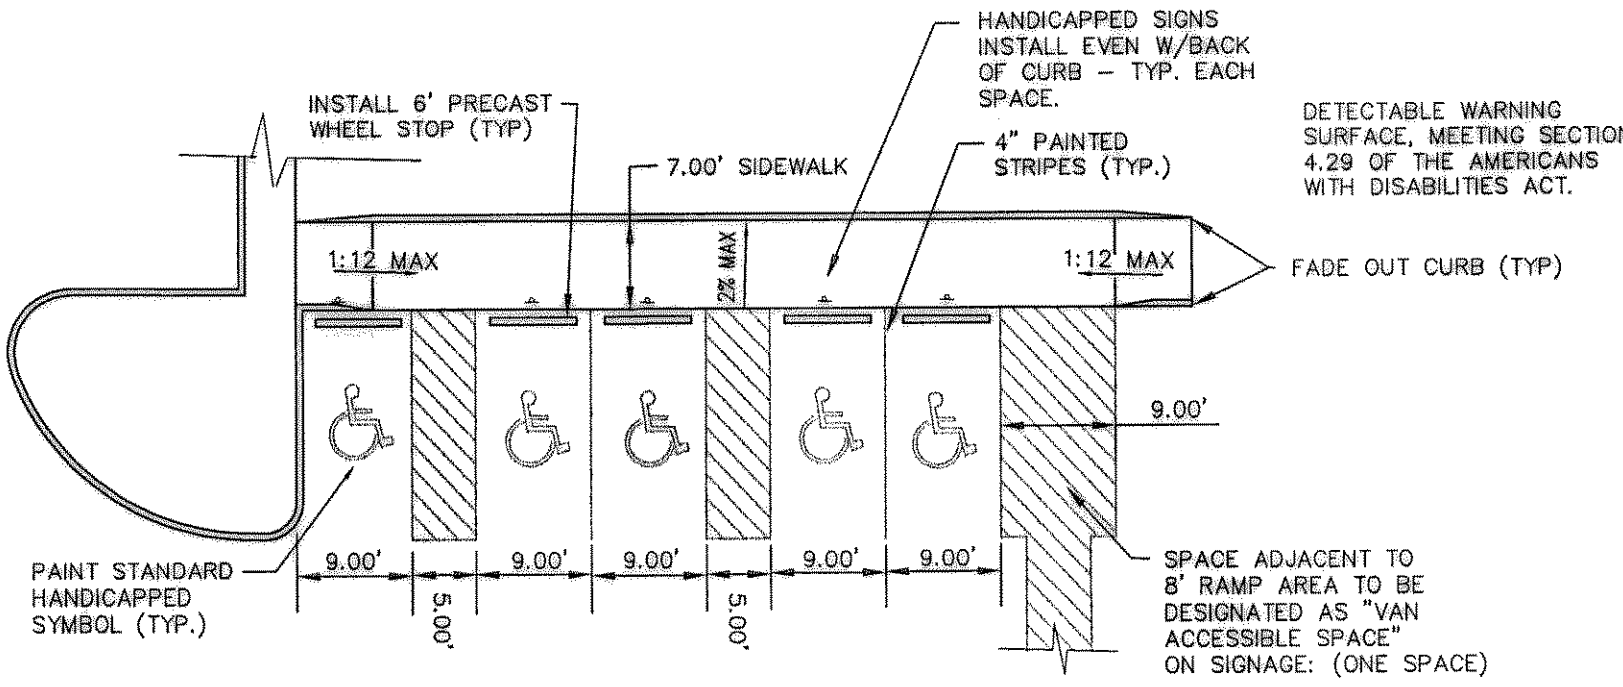

**11 Handicap Parking Detail**  
NOT TO SCALE

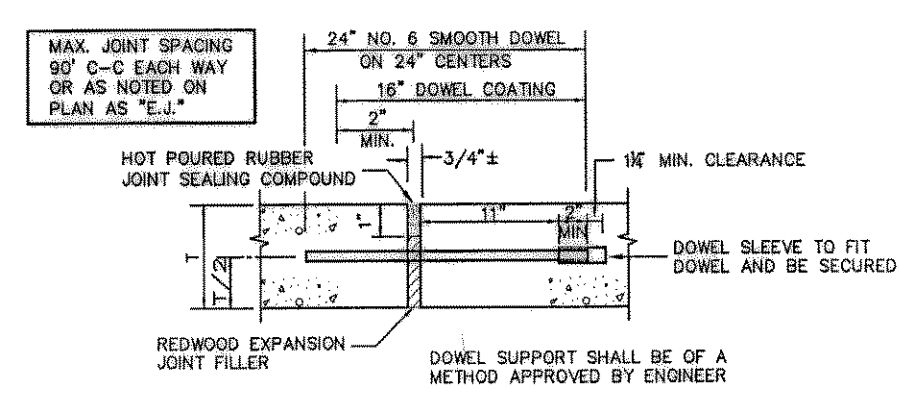

**12 Expansion Joint**  
NOT TO SCALE

**RECORD DRAWING**

THIS DRAWING HAS BEEN REVISED TO REFLECT CONSTRUCTION RECORDS MAINTAINED AND PROVIDED BY THE CONTRACTOR FOR THIS PROJECT.

CONTRACTOR: VANTAGE COMPANIES  
1231 W. CAMPBELL ROAD  
RICHARDSON, TX 75080

DATE REVISED: JULY 21, 2000



THIS DOCUMENT IS RELEASED FOR THE PURPOSE OF INTERIM REVIEW UNDER THE AUTHORITY OF STEVEN A. MARKUSSEN, P.E. 70090 ON 10/06/99. IT IS NOT TO BE USED FOR CONSTRUCTION, BIDDING OR PERMIT PURPOSES.

- REVISION 07/21/00
- REVISION 11/12/99

**Pacheco Koch Consulting Engineers**  
9401 LBJ FREEWAY SUITE 300 DALLAS, TEXAS 75243 972.235.3031

**PAVING PLAN**  
FALCON FINE WIRE CO.  
SITE IMPROVEMENTS  
ROCKWALL TECHNOLOGY PARK  
CITY OF ROCKWALL, TEXAS

DESIGN	DRAWN	DATE	SCALE	NOTES	FILE	NO.
SAM	WMH	OCT 1999	N.T.S.			C-5.0